

CERTIFIED LAND CORNER RESTORATION

Index No. **V 9**

State of Wisconsin }  
County of Forest } ss.


I Thomas R. Arnett, do hereby certify that on the 2nd day of June, 1976, I found evidence of the section corner of sections 28, 29, 32 & 33 Township 37, North, Range 15 E, Fourth Principal Meridian, as described hereon; and that from this evidence I established a new monument and accessories as described hereon to perpetuate the original location of this corner.

Resident witnesses:

Glenn Barker

Herbert Wagoner

FORM 985 H. C. MILLER CO., MILWAUKEE

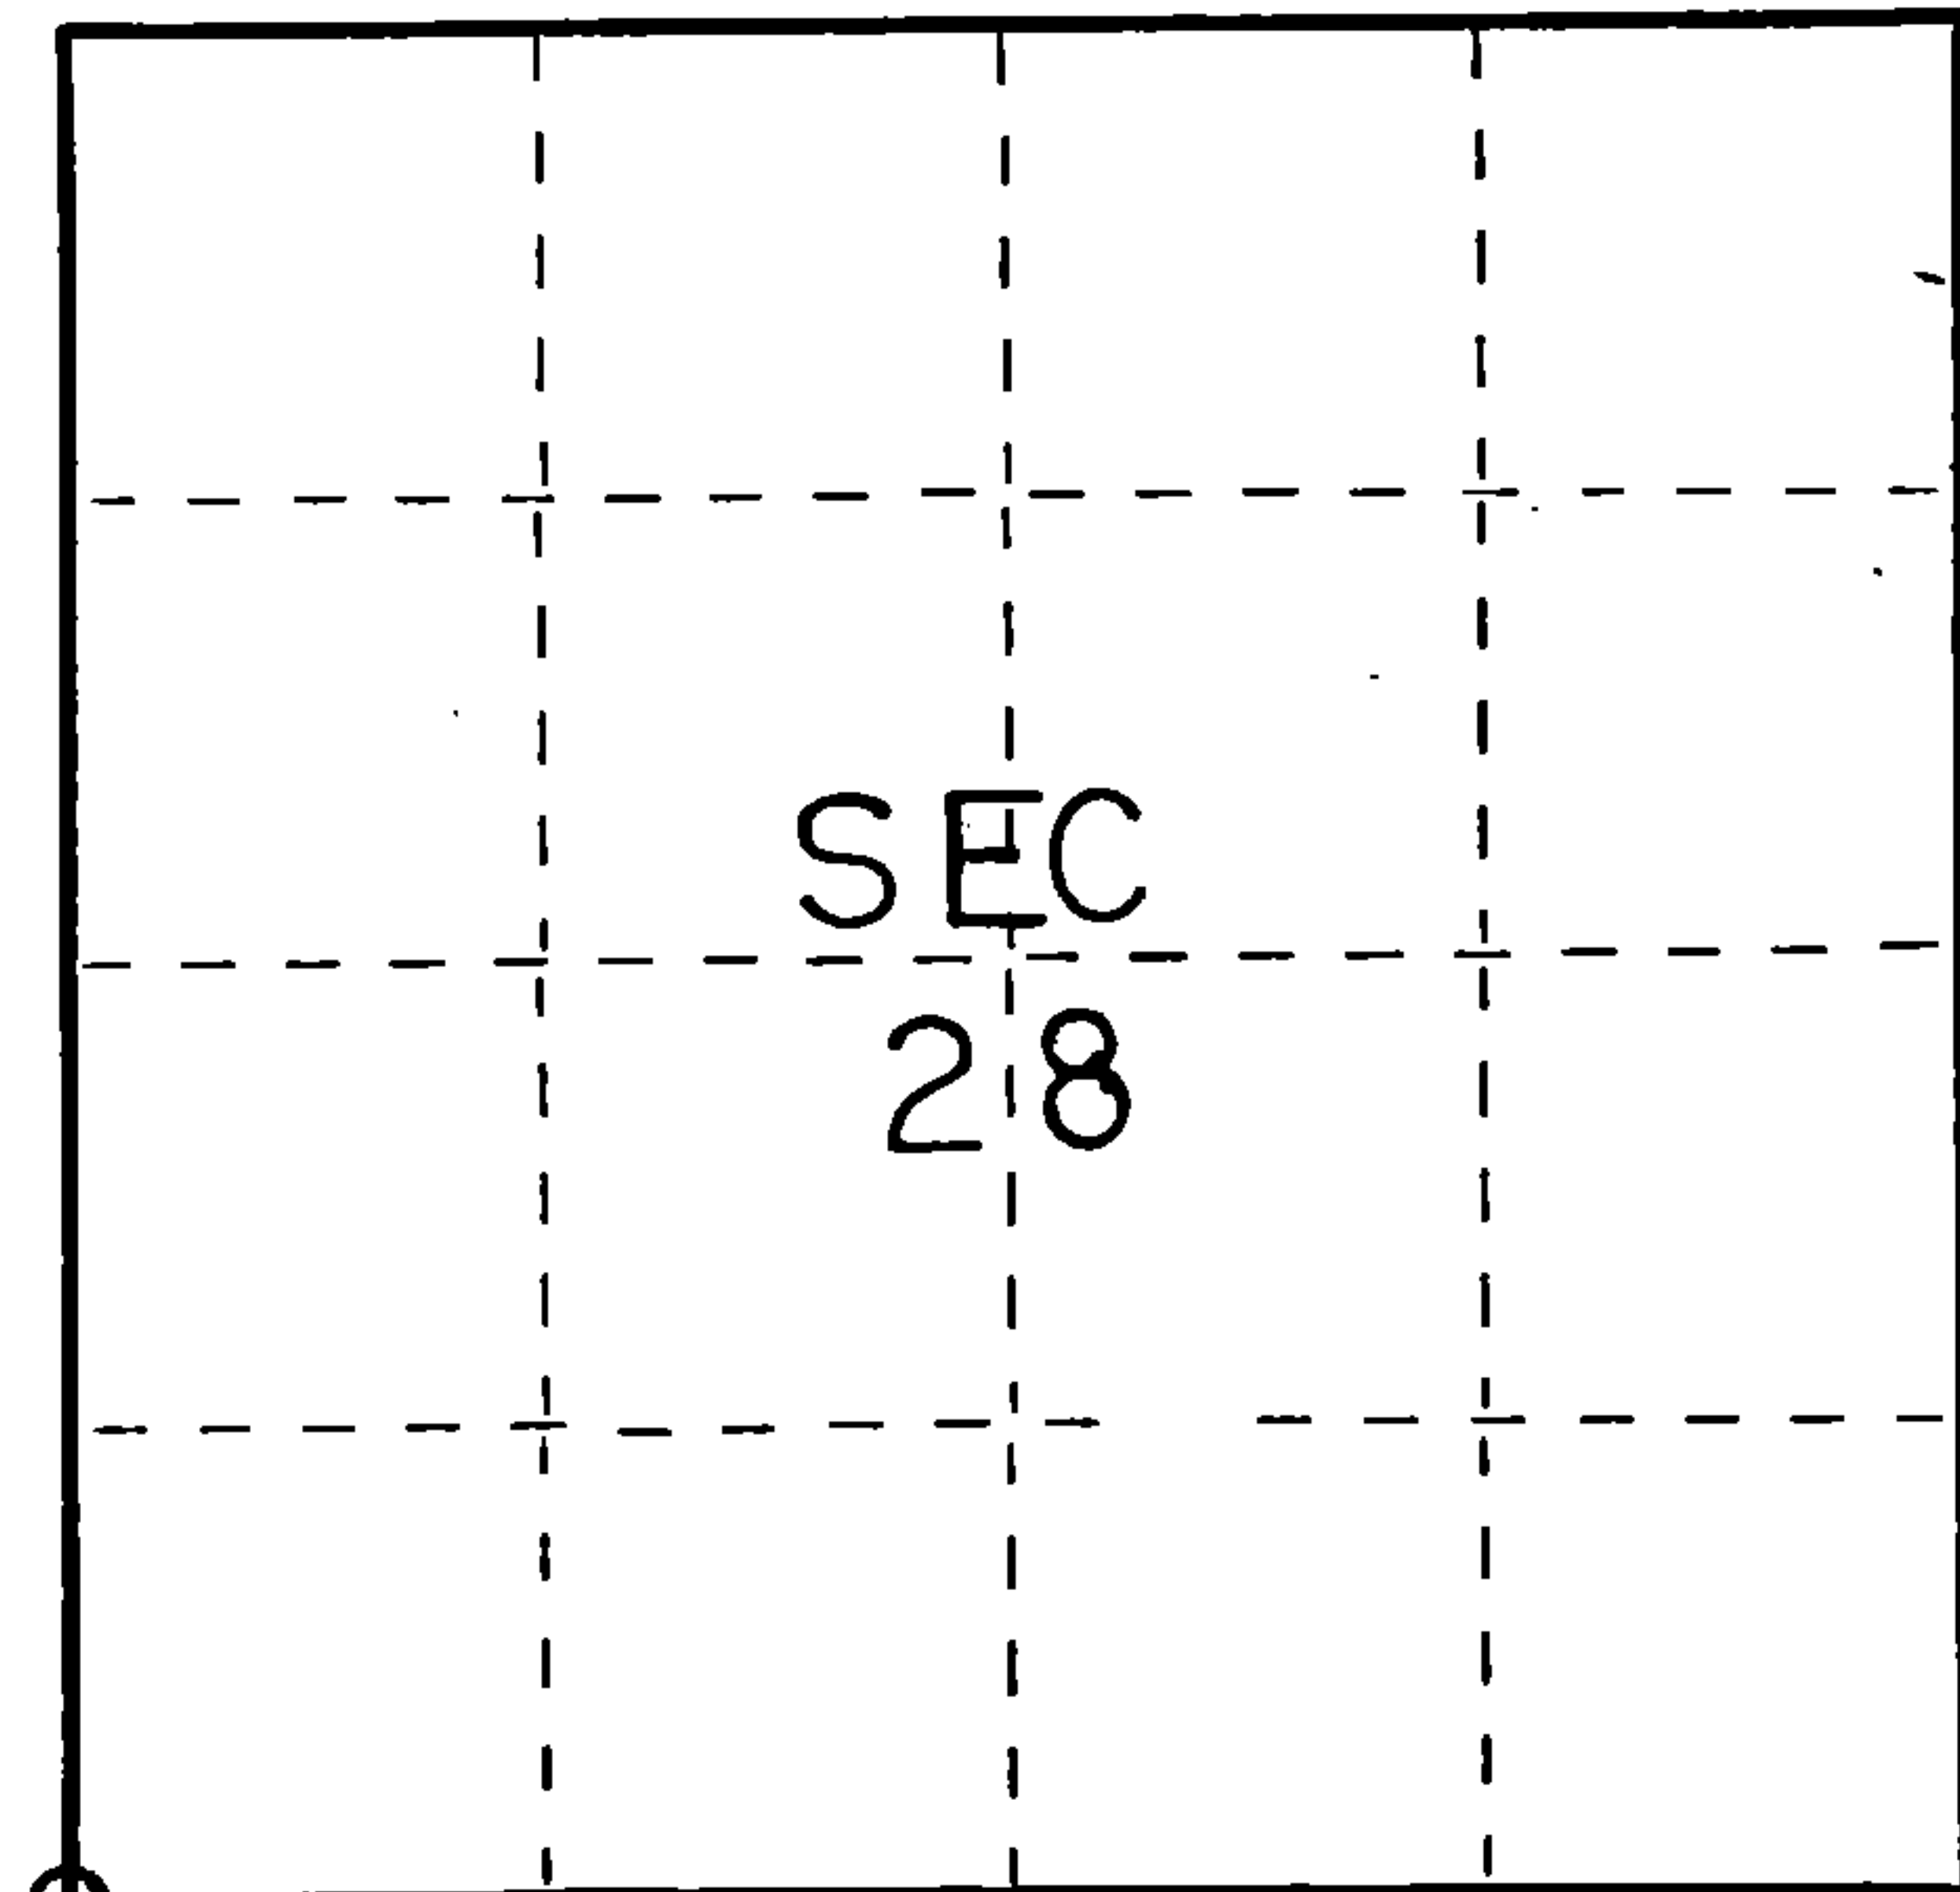

○ = Corner monument restored.

History of original corner establishment:

Original Subdivision by James Nowlin 7 Aug - 18 Aug, 1865

Aspen 12 N21W 75 Lks.  
W. Pine 20 N5E 100 Lks.

Description of corner evidence found:

RR Spike found in center of road



Description of monument and accessories I established to perpetuate the original location of this corner.  
Replaced rr spike with 1 1/4" iron pipe

Ties:

North rail of Soo line tracks	South	28.05 feet
Telephone pole (1400)	N56W	35.40 feet
Forest County aluminum monument	N41E	45.51 feet

Dated at Crandon, Wis., this 11th day of June, 1976.

Signature Thomas Arnett Title Surveyor Registration No. S-887  
(County Surveyor, Registered Land Surveyor, or other duly authorized official)

Office of Register of Deeds, County of Forest, I hereby certify that the within instrument was filed in this office for record on the 11th day of June, 1976 at 3 o'clock P. M.

EUGENE STATEZNY

(Register of Deeds)

Document Number **109436**

By Eileen Schmidt Deputy

43715 29 0000