


U. S. PUBLIC LAND SURVEY MONUMENT RECORD

INSTRUCTIONS:

This record shall show the location of the corner and shall include all of the following nine elements (a through i).

- (a) Identify the corner by reference to the U.S. public land survey system.
- = Corner monument restored.

Quarter Corner Common to Sections 4 and 9,
Township 37 North, Range 16 East, Forest County,
State of Wisconsin.

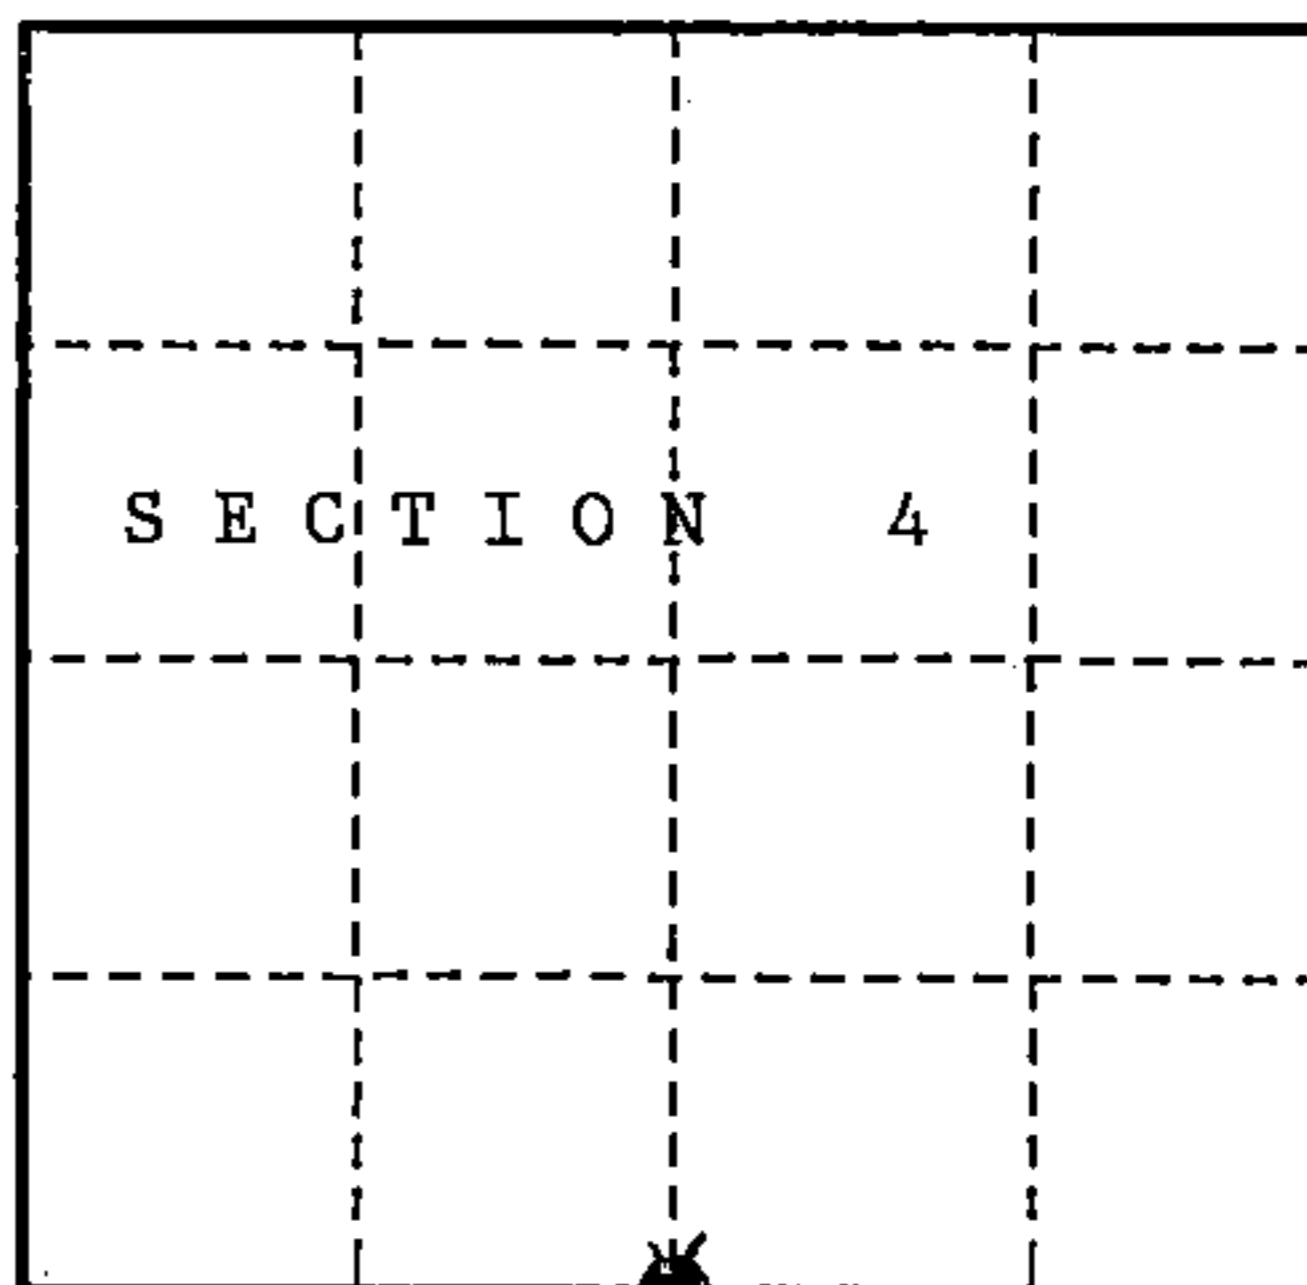

- (b) Describe any record evidence, monument evidence, occupational evidence, testimonial evidence or any other material evidence you considered, and whether the monument was found or placed.


In 1859, James McBride set a wooden post at the corner and the following bearing trees:
Hemlock 12" S25°E, 33 lks. Hemlock, 14" N36°W, 43 lks.

In 1982, Kim Pritzlaff recovered corner position by the following bearing trees:
Hemlock stump 14" bears N36°W, 43 lks. Hemlock stump 12" bears S25°E, 38 lks.
Set a 2" dia. driveable aluminum Berntsen monument at the corner position and
the following corner references: Maple 7" bears S68°E, 12.96 ft.
Maple 8" bears S02°W, 24.81 ft.
Steel post bears S45°W, 2.0 ft.

In 1990, John Schulke recovered monument in place and the following corner references:
Sugar Maple 8" bears S02°W, 24.82 ft.
Sugar Maple 9" bears S65°E, 12.94 ft.
Steel sign post bears SW, 2.1 ft.
The following new corner references: Basswood 13" bears S86°W, 39.37 ft.
F.S. road is approximately 60 ft. East of the monument.

- (c) In the plan view drawing below, provide reference ties to at least 4 witness monuments, or, if the location is within a municipality, to at least 2 witness monuments. (witness monuments shall be made of concrete, natural stone, iron or other equally durable material.)
- (d) Show a plan view drawing depicting the relevant monuments and reference ties which is sufficient in detail to enable accurate relocation of the corner monument if the corner monument is disturbed. Indicate north.

1. 2" dia. aluminum monument stamped to identify the corner.
2. Sugar Maple 8" S02°W 24.82 ft.
3. Sugar Maple 9" S65°E 12.94 ft.
4. Basswood 13" S86°W 39.37 ft.
5. Steel sign post SW 2.1 ft.

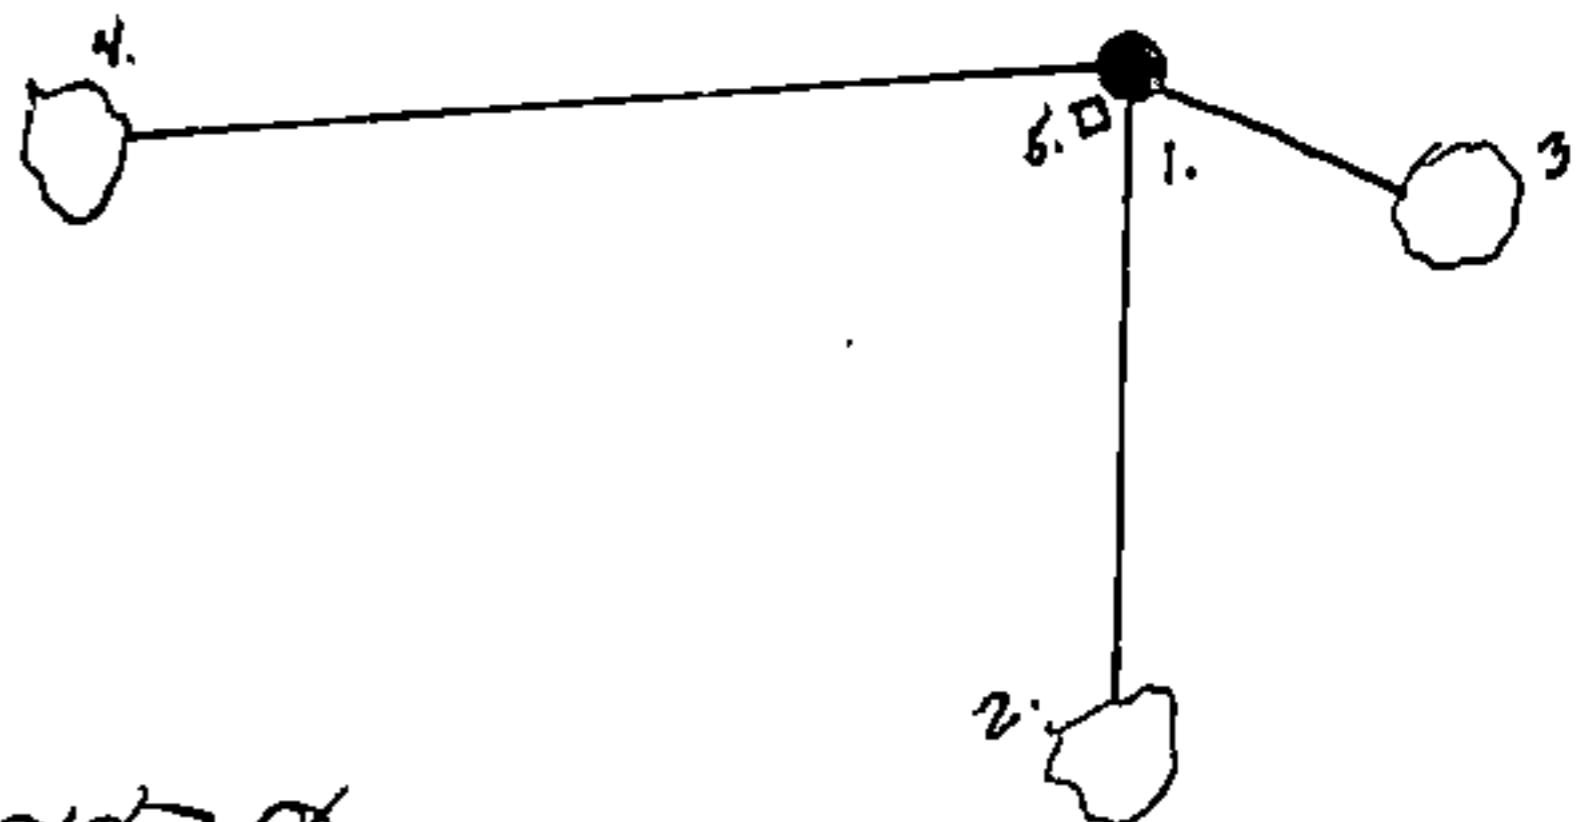

REGISTER'S OFFICE }
Forest County, Wis.

Received for record this 19th day
of December, A.D., 1990 at
8:45 o'clock A.M. and recorded
in Vol. Corner Restorations
page F-11

43716040020

Register of Deeds

(e) Describe any material discrepancy between the location of the corner as restored or reestablished and the location of that corner as previously restored or reestablished by distance and direction. Show the discrepancy on the plan view drawing under (d), above. Show the distances between the corner as previously restored or reestablished and (1) the corner as restored or reestablished, and (2) to at least 2 of the witness monuments shown on the drawing in (d), above.

NONE.


(f) Was the corner restored through acceptance of (1) an obliterated evidence location, or, (2) a found perpetuated location?

(2) found perpetuated location.

(g & h) Was the corner reestablished through lost corner proportionate methods? If so, show the method, including the directions and distances to other public land survey corners used as evidence or used for proportioning in determining the corner location?

NO.

(1) I, John Schulke a Register Land Surveyor
(type or print name) certify that the corner location shown on this record was determined by me or under my direction and control and that this U.S. Public Land Survey Monument Record is correct and complete to the best of my knowledge and belief.

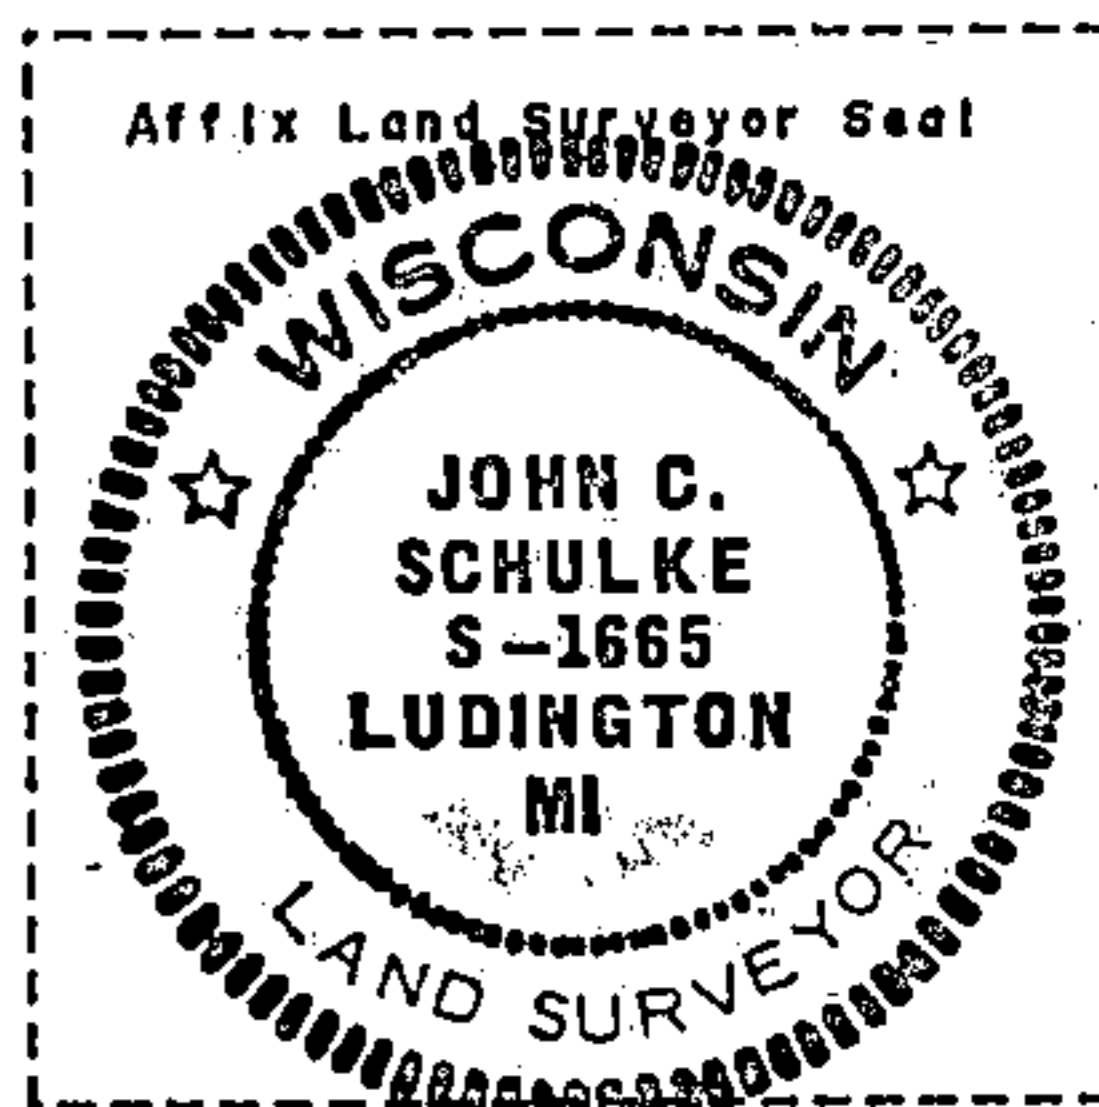

John Schulke
Signature

10/23/90
Date

CERTIFICATE READY FOR FILING:

Dale B. Stage
District Ranger