

CERTIFIED LAND CORNER RESTORATION

State of Wisconsin

County of Forest

ss.

I Jean F. Resvick, do hereby certify that on the 17th day of May, 1973, I found evidence of the south quarter corner of Section 5 Township 37 north, Range 16 east, Fourth Principal Meridian, as described hereon; and that from this evidence I established a new monument and accessories as described hereon to perpetuate the original location of this corner:

Description of original monument and accessories and subsequent restorations:

Survey in 1859 by James McBride 39.96 chains west corrected between Sections 5 and 8, set post.
Sugar, 8 ins., bears N57W, 9 lks.
Sugar, 8 ins., bears S77E, 13 lks.


Description of corner evidence found:

1. Remains of Hemlock post
2. Maple stump evidence bears S77E, 13 lks.
3. Maple 18 inches with open blaze and rusted location poster, bears N57°W, 9 lks.


Description of monument and accessories I established to perpetuate the location of this corner:

Replaced Hemlock post remains with a 2 inch inside diameter, galvanized pipe, 3 feet long filled with concrete with a brass cap marked: T37N, R16E, 1/4; S5, S8, 1974, S-802:

From which the following blazed and scribed new bearing trees bear:
Maple, 9 inches, bears N55E, 21.64 ft.
Maple, 9 inches, bears S10W, 40.13 ft.
Maple, 18 inches, bears N57W, 6.00 ft.
Steel post, S.W. 1.0 ft.

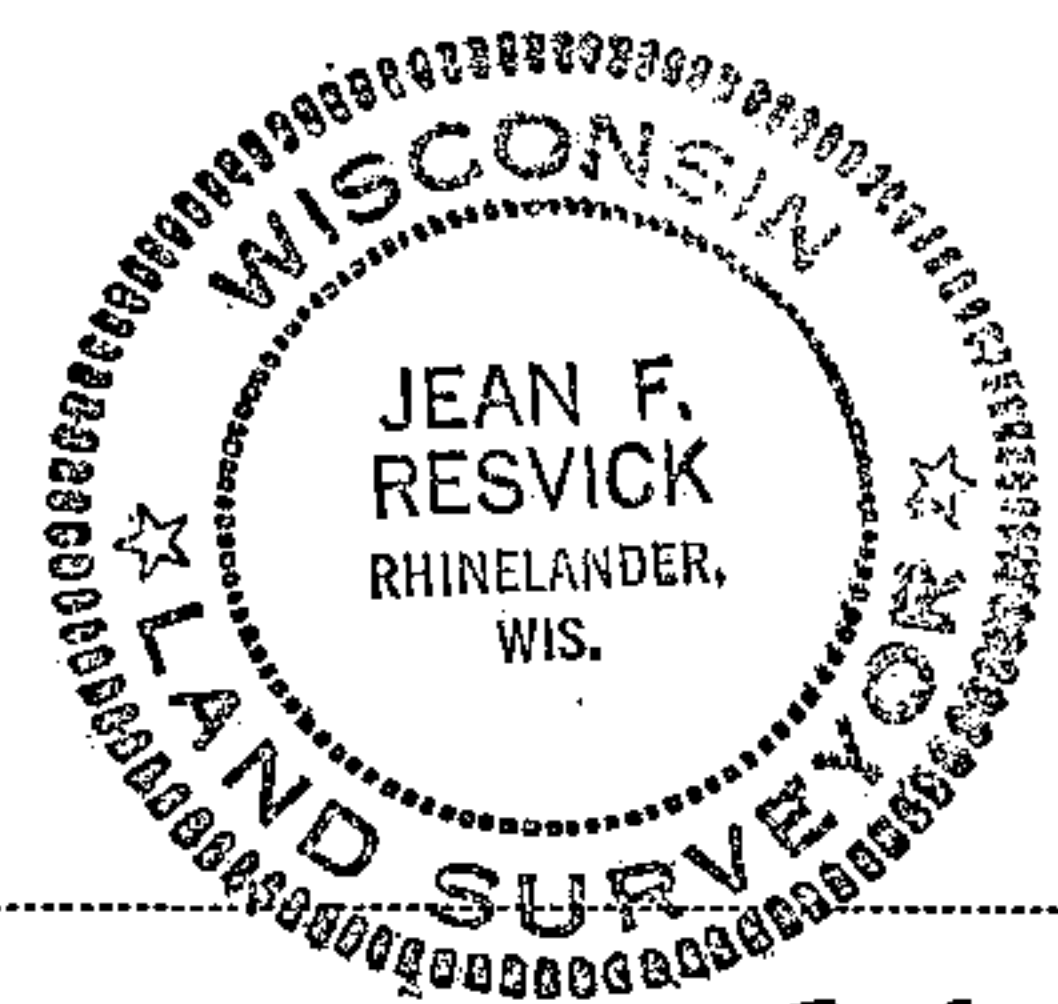

43716050020

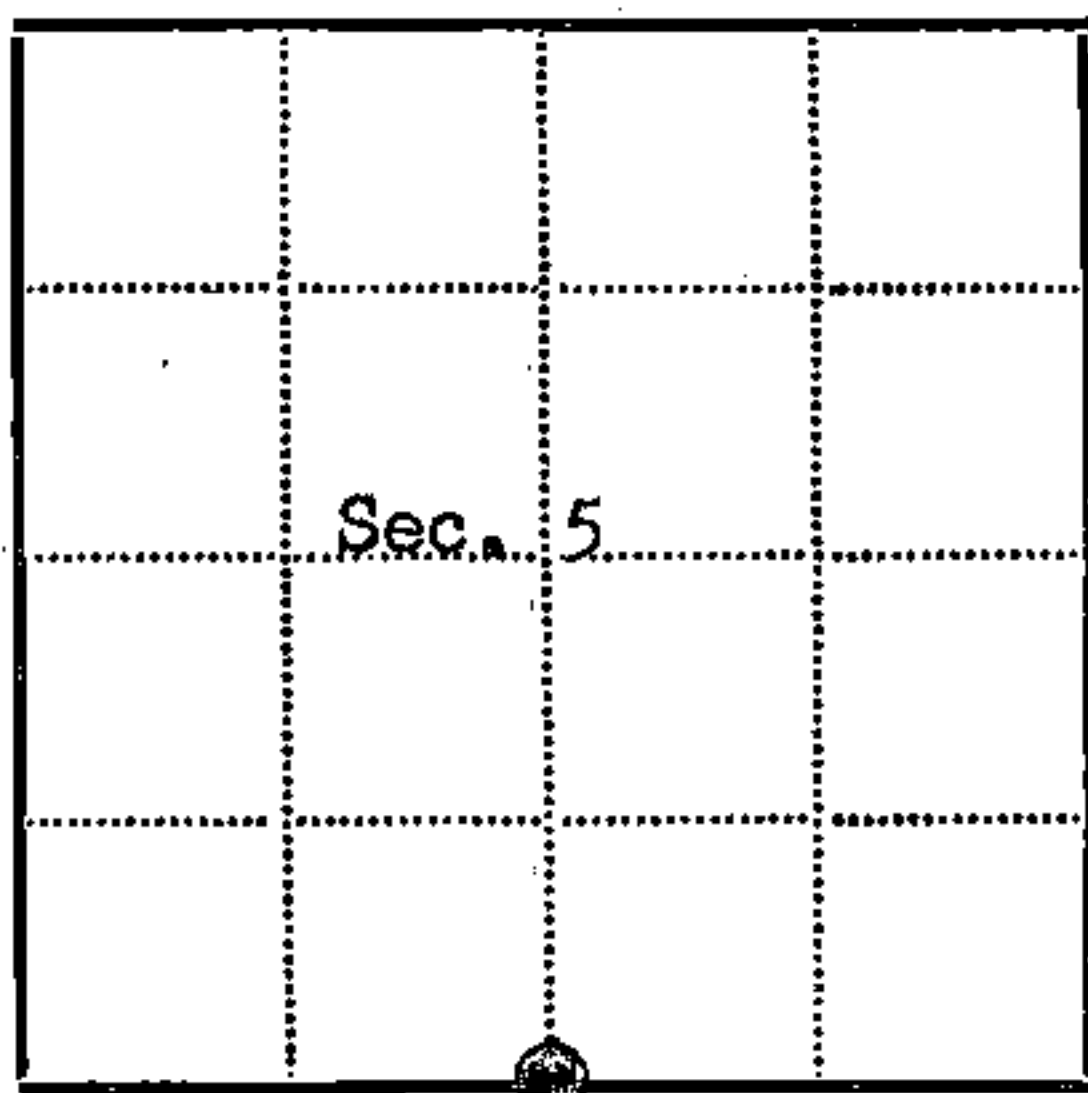

● = Corner monument restored

□ =

Resident witnesses

Dated at Rhineland Wisconsin, this 21 day of Feb. 1974.

Signature Jean F. Resvick Title Land Surveyor
(County Surveyor, Registered Land Surveyor, or other duly authorized official)

Surveyors Registration No. S-802 DOCUMENT NUMBER 105101

Office of Register of Deeds County of Forest

I hereby certify that the within instrument was filed in this office for record on the 5th day of April, 1974, and was filed in Book No. _____ Page No. _____ of County Records.

Signature Eugene Stangor Title Register of Deeds

Township 37 north, Range 16 east, Section 5, Index No. E-7, Page No. 11