

CERTIFIED LAND CORNER RESTORATION

State of Wisconsin }
County of Forest } ss.

I Jean F. Resvick, do hereby certify that on the 17 day of May, 1973, I found evidence of the West quarter corner of Section 5 Township 37 north, Range 16 east, Fourth Principal Meridian, as described hereon; and that from this evidence I established a new monument and accessories as described hereon to perpetuate the original location of this corner:

Description of original monument and accessories and subsequent restorations:

Survey in 1859 by James McBride 41.20 South corrected between Sections 5 and 6 set post Cedar 8 inches bears S81E 7 lks. Spruce 6 inches bears N70W 3 lks.


Description of corner evidence found:

Scribed squared post
Cedar stump remains bear S81E, 7 lks.
Spruce stump bears N70W, 3 lks.
Cedar bears S60W, 5.72 ft., scribed
Cedar bears N77E, 12.22 ft., scribed


Description of monument and accessories I established to perpetuate the location of this corner:

Replaced post with 2 inch inside diameter galvanized iron pipe 5 ft. long filled with concrete with a brass cap marked: T37N, R16E, 1/4, S5, S6, 1974, S-802:

From which the following blazed and scribed new bearing trees bear:
Cedar 8 inches bears S37E, 26.98 ft.
Cedar 11 inches bears N4W 31.55 ft.
Steel post, NW, 1.0 ft.

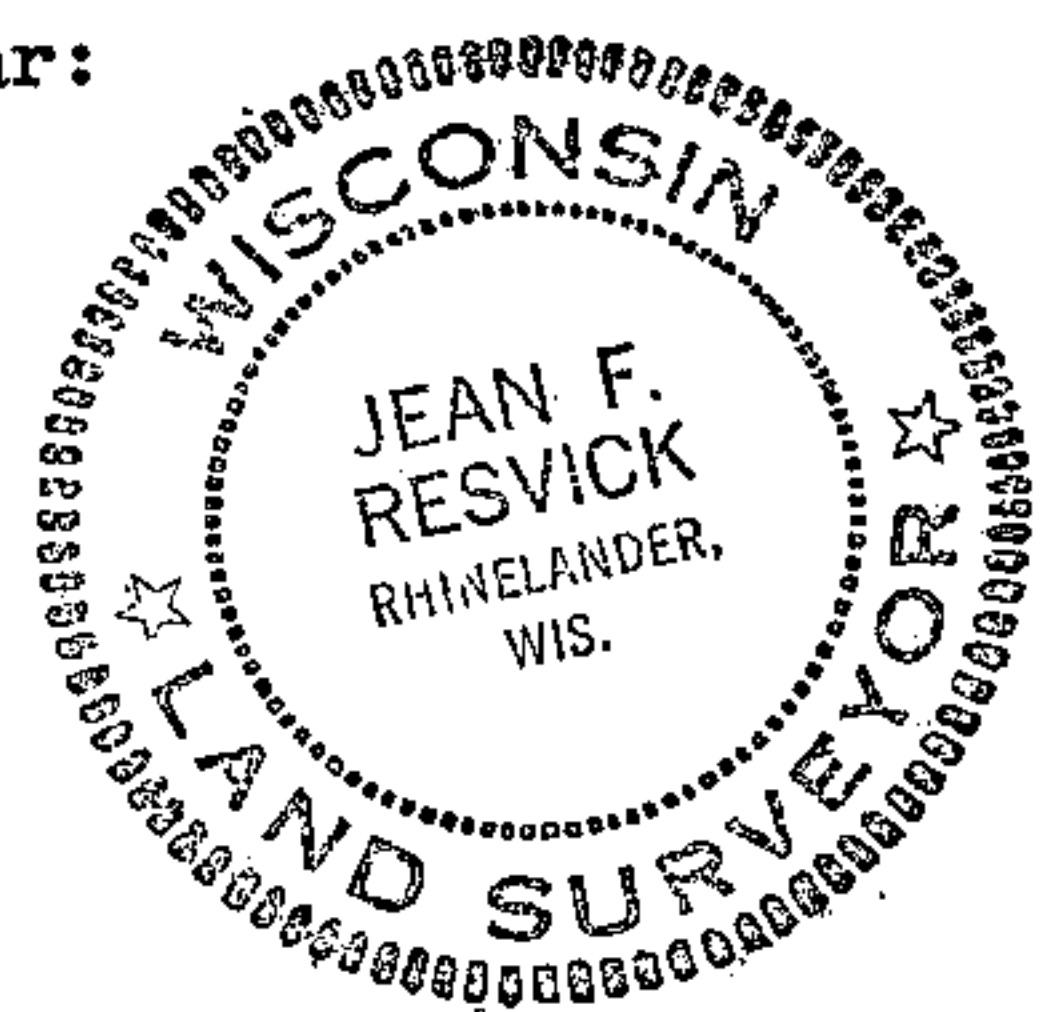

43116062000

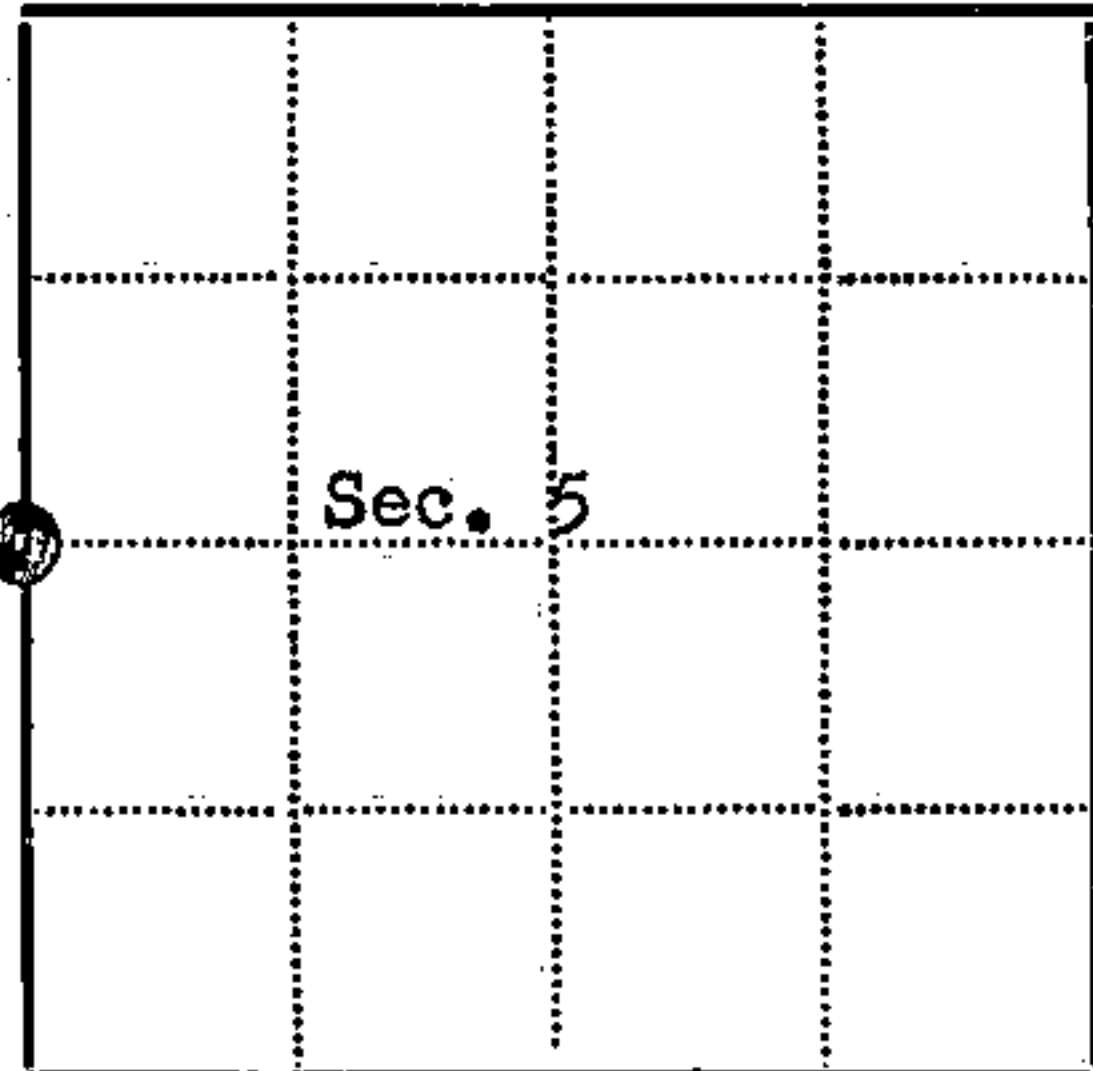

● - Corner monument restored
□ -

Resident witnesses.....

Dated at Rhinelander Wisconsin, this 28 day of Feb. 1974.

Signature Jean F. Resvick Title Land Surveyor
(County Surveyor, Registered Land Surveyor, or other duly authorized official)

Surveyors Registration No. S-802 DOCUMENT Number 105097

Office of Register of Deeds County of Forest

I hereby certify that the within instrument was filed in this office for record on the 5th day of April 1974, and was filed in Book No. Page No. of County Records.

Signature Eugene Stetson Title Register of Deeds

Township 37 north, Range 16 east, Section 5, Index No. C-5, Page No.

65