

CERTIFIED LAND CORNER RESTORATION

State of Wisconsin }
County of Forest } ss.

I Jean F. Resvick, do hereby certify that on the 22 day of August, 1973, I found evidence of the South quarter corner of Section 10 Township 37 north, Range 16 east, Fourth Principal Meridian, as described hereon; and that from this evidence I established a new monument and accessories as described hereon to perpetuate the original location of this corner:

Description of original monument and accessories and subsequent restorations:

Survey in 1859 by James McBride
39.75 chains west corrected between sections 10 and 15, set post.
Sugar 12, S30W, 18 lks.
Birch 10, N18E, 60 lks.
Survey by F.R. Wincentzen in 1954 located corner by proportional measurement, set iron pipe with brass cap and the following bearing trees.
Spruce 5, N5E, 37.8 lks.
Balsam 4, N87E, 46.0 lks.

Description of corner evidence found:


In 1966 I found the iron pipe and brass cap as set by F.R. Wincentzen. On October 13, 1971 I was shown the corner area and the monument had been removed and a small balsam planted in the hole. On August 22, 1973 having obtained a copy of survey as done by F.R. Wincentzen I found the bearing trees as scribed by Mr. Wincentzen. At a point S5W, 25 feet from Spruce Bearing Tree and N87W, 30.4 feet from Balsam found evidence of hole where monument had been set below small Balsam.

Description of monument and accessories I established to perpetuate the location of this corner:

Using the above bearing trees set a 2 inch inside diameter, galvanized iron pipe, filled with concrete, 3 feet long with brass cap stamped T37N, R16E, 1/4, S10, S15, 1973, S#802 Blazed and scribed a Spruce, 5 inch diameter, bearing N43W, 27.32 feet from corner set steel sign post 1 foot NW of monument. Monument is set with only 3 inches above ground.



43716100020

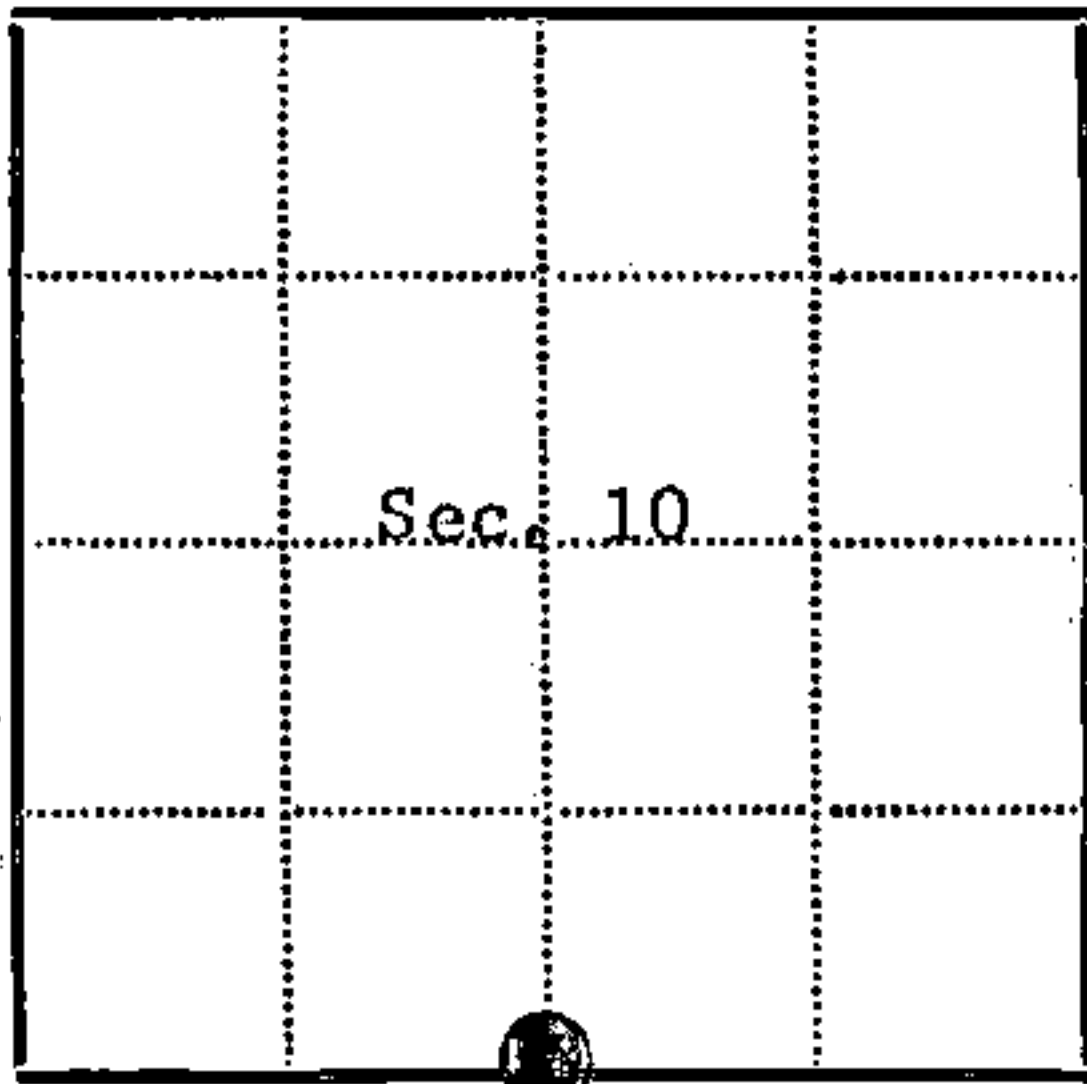

● - Corner monument restored
□ -

Resident witnesses.....

Dated at Rhinelander Wisconsin, this 25th day of Sept. 1973.

Signature Jean F. Resvick Title Land Surveyor
(County Surveyor, Registered Land Surveyor, or other duly authorized official)

Surveyors Registration No. S-802 DOCUMENT NUMBER 104445

Office of Register of Deeds County of Forest

I hereby certify that the within instrument was filed in this office for record on the 13th day of November 1973, and was filed in Book No. J-15 of County Records.

Signature Eugene Stutzny Title Register of Deeds

Township 37 North, Range 16 East, Section 10, Index No. J-15, Page No.

7 15


U. S. PUBLIC LAND SURVEY MONUMENT RECORD

INSTRUCTIONS:

This record shall show the location of the corner and shall include all of the following nine elements (a through i).

- (a) Identify the corner by reference to the U.S. public land survey system.
○ = Corner monument restored.

Quarter Corner Common to Sections 10 and 15,
Township 37 North, Range 16 East,
Forest County, State of Wisconsin

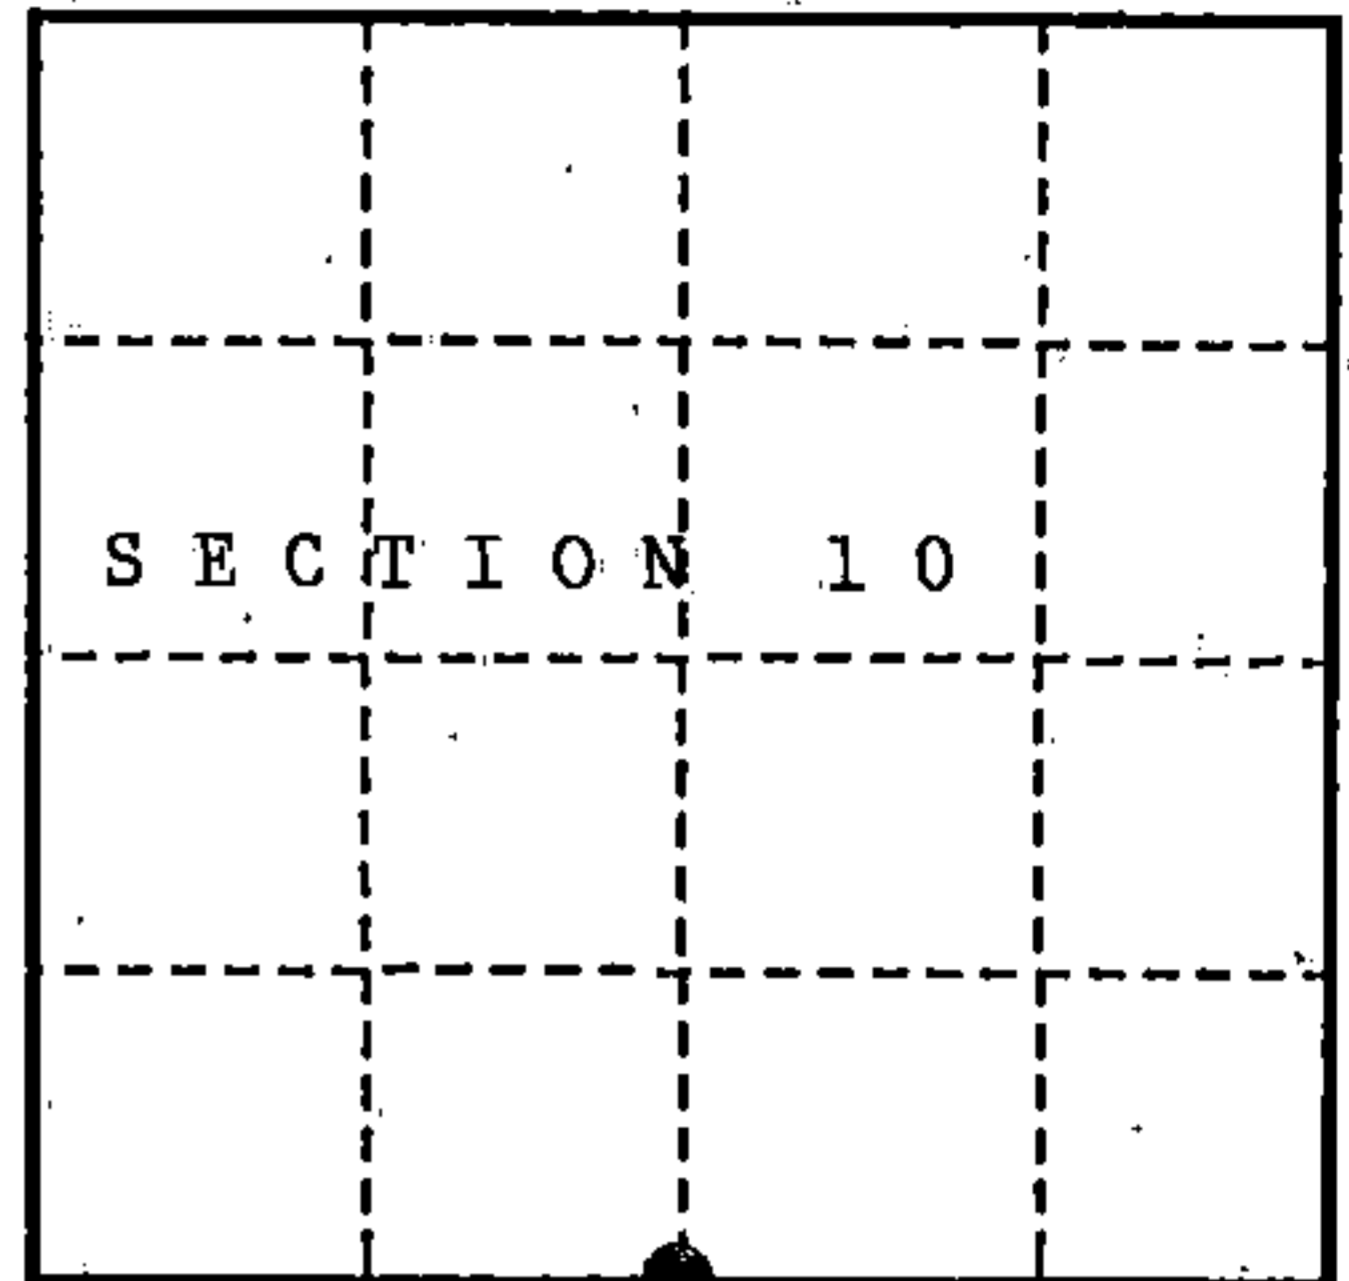

- (b) Describe any record evidence, monument evidence, occupational evidence, testimonial evidence or any other material evidence you considered, and whether the monument was found or placed.

In 1859, James McBride set a wood post and selected the following bearing trees:

Sugar 12" S30°W 18 lks. Birch 10" N18°E 60 lks.

In 1954, F.R. Wincentsen reestablished corner by proportionate measurement and set an iron pipe with brass cap stamped to identify the corner.

Selected the following bearing trees;

Spruce 5" N05°E 37.8 lks. Balsam 4" N87°E 46 lks.

In 1973, Jean Resvick recovered hole where the monument had been set and the following bearing trees: Spruce N05°E 25 ft. Balsam S87°E 30.4 ft.

Set a 2" dia. galvanized iron pipe, filled with concrete, with a brass cap stamped to identify the corner. Recorded Certified Land Corner Restoration form filed in Forest Co. Register of Deed's Office, Document #104445.

In 1982, Kim Pritzlaff recovered monument in place and the following corner references;

Spruce 5" N43°W 27.32 ft. Balsam 4" N37°W 30.40 ft.

Set a steel sign post NW a distance of 1.0 ft. from the monument.

In 1990, John Schulke recovered monument in place and the following corner references;

W. Spruce 6" N43°W 27.37 ft. W. Spruce 9" N05°E 24.99 ft.


Dead Balsam 5" S86°E 30.5 ft. SSP NW 1.0 ft.

The following new corner references: Red Maple 7" S44°W 33.61 ft.

- (c) In the plan view drawing below, provide reference ties to at least 4 witness monuments, or, if the location is within a municipality, to at least 2 witness monuments. (witness monuments shall be made of concrete, natural stone, iron or other equally durable material.)

- (d) Show a plan view drawing depicting the relevant monuments and reference ties which is sufficient in detail to enable accurate relocation of the corner monument if the corner monument is disturbed. Indicate north.

1. 2" dia. galvanized iron pipe, with a brass cap stamped to identify the corner.
2. W. Spruce 9" N05°E 24.99 ft.
3. Red Maple 7" S44°W 33.61 ft.
4. W. Spruce 6" N43°W 27.37 ft.
5. SSP NW 1.0 ft.

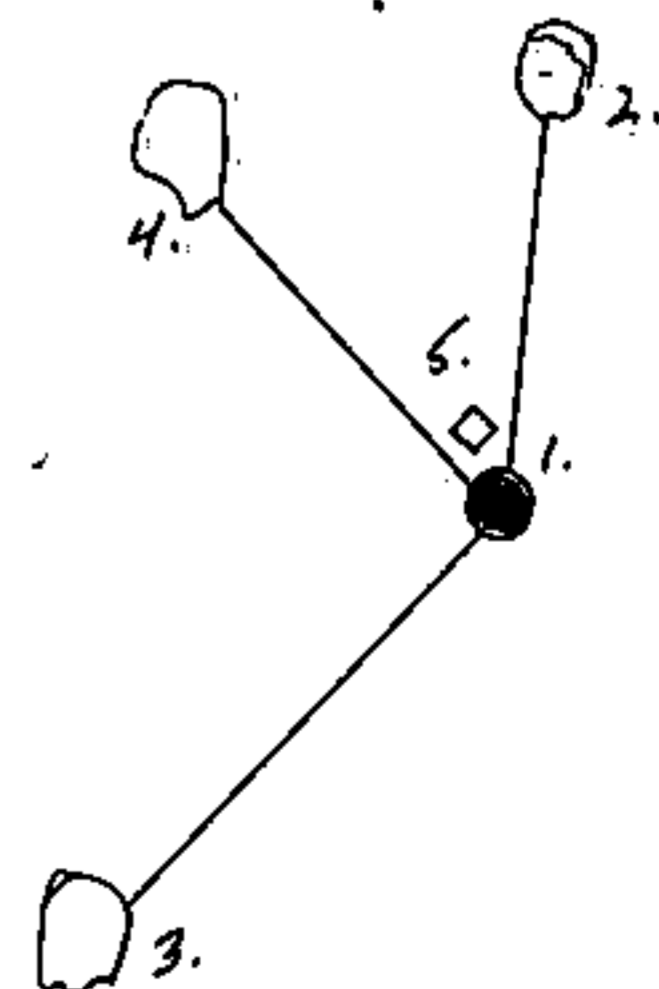

REGISTER'S OFFICE }
Forest County, Wis. }

Received for record this 19th day
of December A.D., 1990 at
8:15 o'clock A.M. and recorded
in Vol. Corner Restorations
page J-15

Paul Ackland
Register of Deeds

43716100020

(e) Describe any material discrepancy between the location of the corner as restored or reestablished and the location of that corner as previously restored or reestablished by distance and direction. Show the discrepancy on the plan view drawing under (d), above. Show the distances between the corner as previously restored or reestablished and (1) the corner as restored or reestablished, and (2) to at least 2 of the witness monuments shown on the drawing in (d), above.

None.

(f) Was the corner restored through acceptance of (1) an obliterated evidence location, or, (2) a found perpetuated location?


(2) a found perpetuated location

(g & h) Was the corner reestablished through lost corner proportionate methods? If so, show the method, including the directions and distances to other public land survey corners used as evidence or used for proportioning in determining the corner location?

No.

(1) I, John Schulke (Register Land Surveyor)

(type or print name) certify that the corner location shown on this record was determined by me or under my direction and control and that this U.S. Public Land Survey Monument Record is correct and complete to the best of my knowledge and belief.

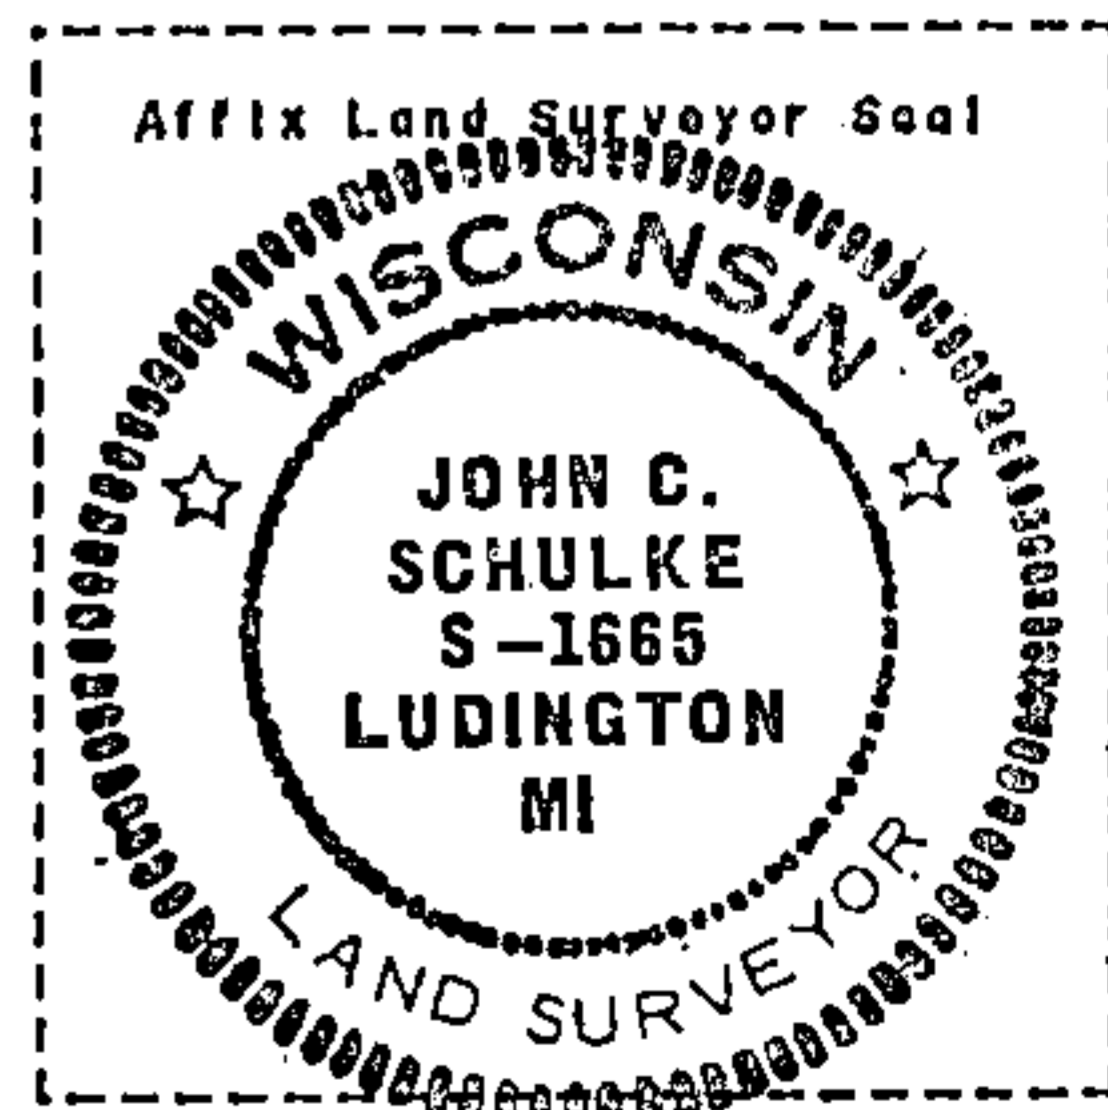

John Schulke
Signature

10/30/190
Date

CERTIFICATE READY FOR FILING:

Dale S. Starg
District Ranger