

CERTIFIED LAND CORNER RESTORATION


Index No. **R15**

State of Wisconsin }
County of Forest } ss.

I Thomas Arnott, do hereby certify that on the 9th day of April, 1976, I found evidence of the 1/4 corner of sections 22 and 27 Township 37, North, Range 16 E, Fourth Principal Meridian, as described hereon; and that from this evidence I established a new monument and accessories as described hereon to perpetuate the original location of this corner.

Resident witnesses:

.....
.....
.....

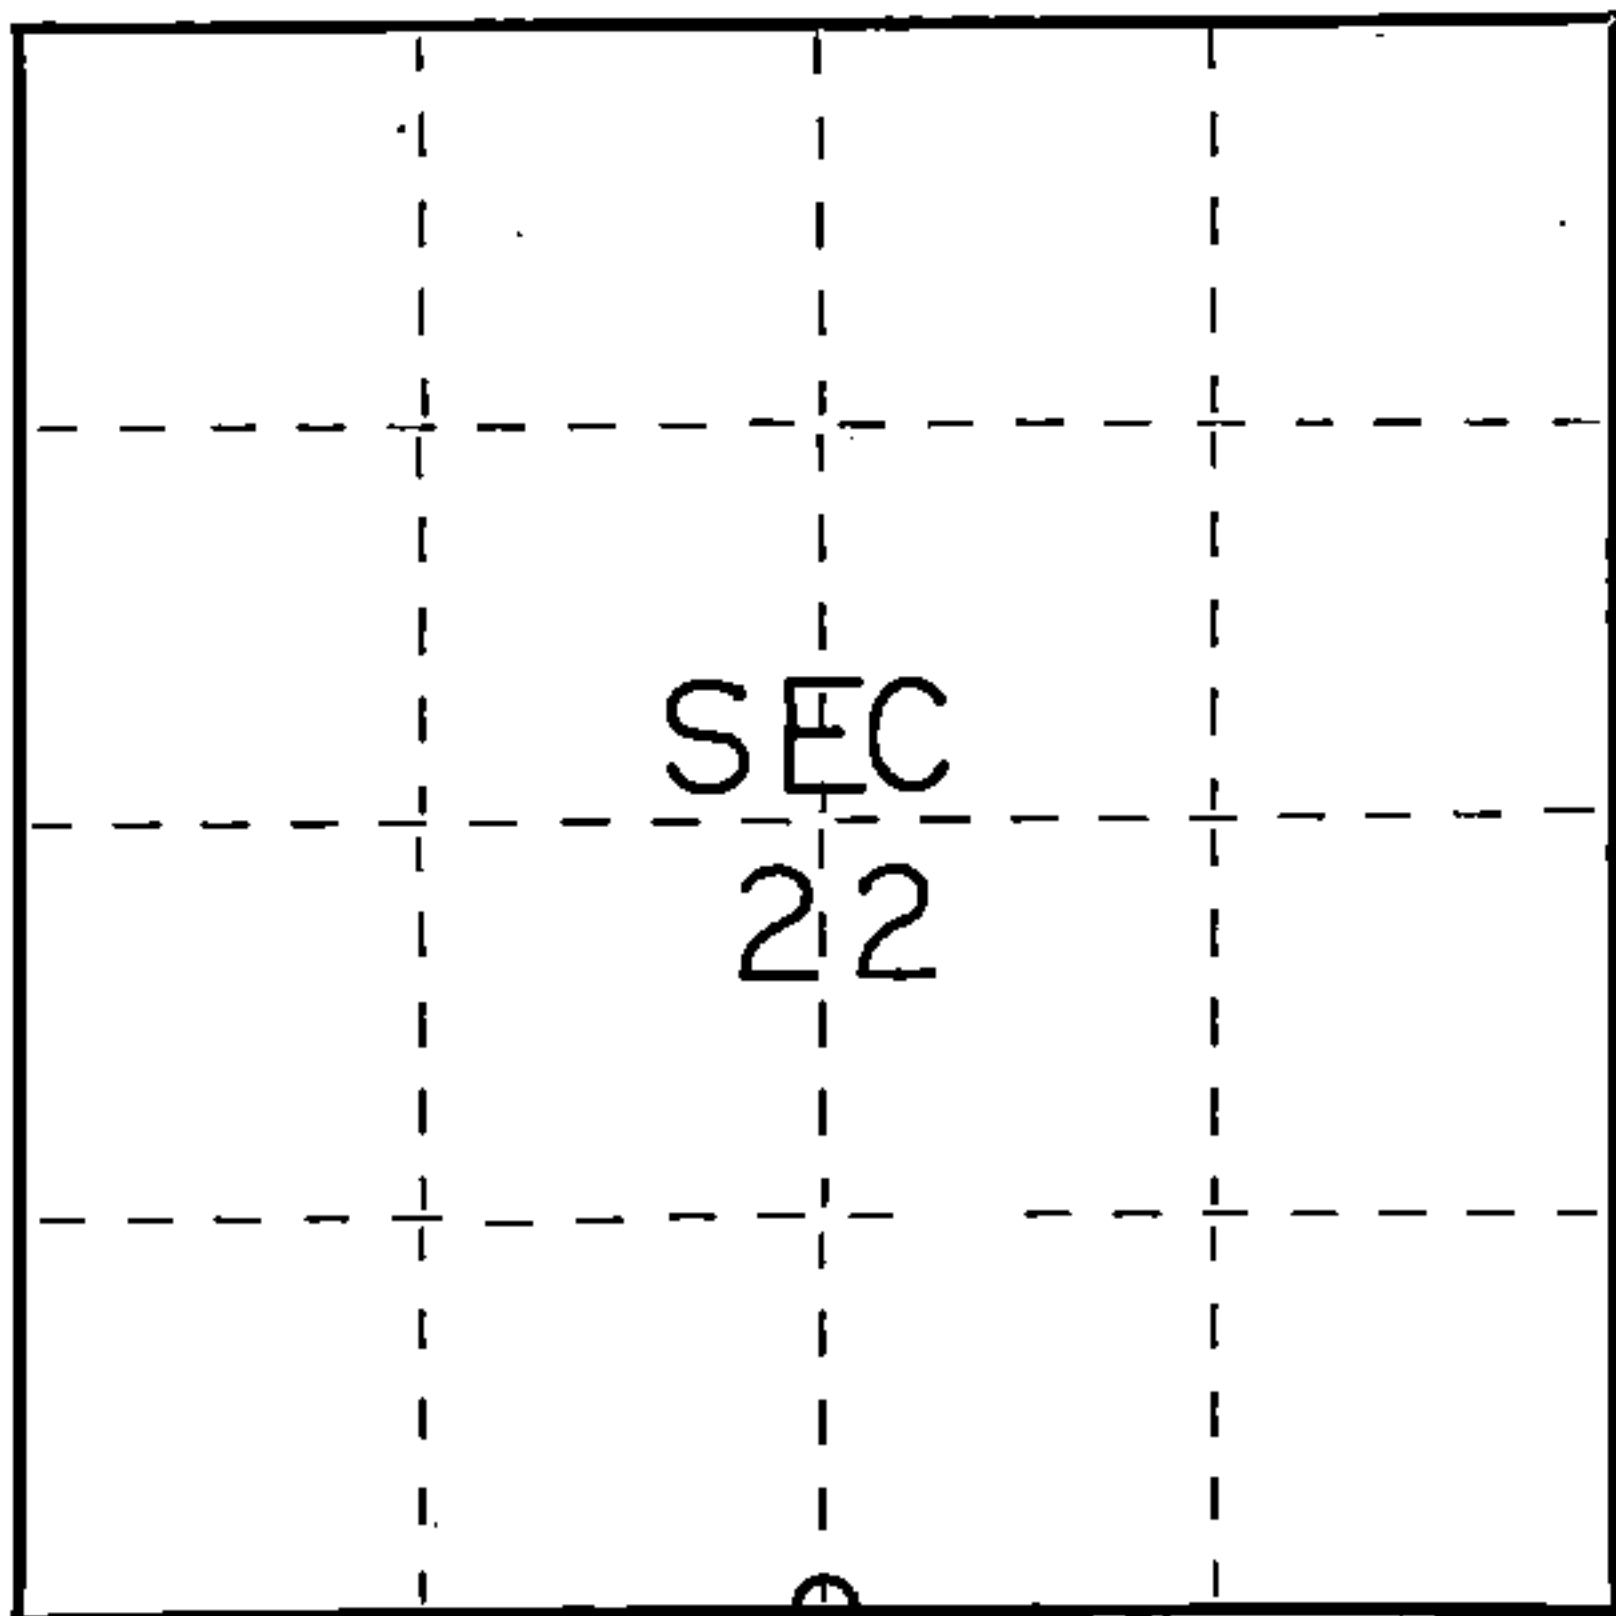

○ = Corner monument restored.


History of original corner establishment:

Original subdivision by James McBride 11 JULY - 16 JULY, 1859

Hemlock 10 N21E 17 lks.
Fir 8 S48W 24 lks.

Description of corner evidence found:

r.r. spike found

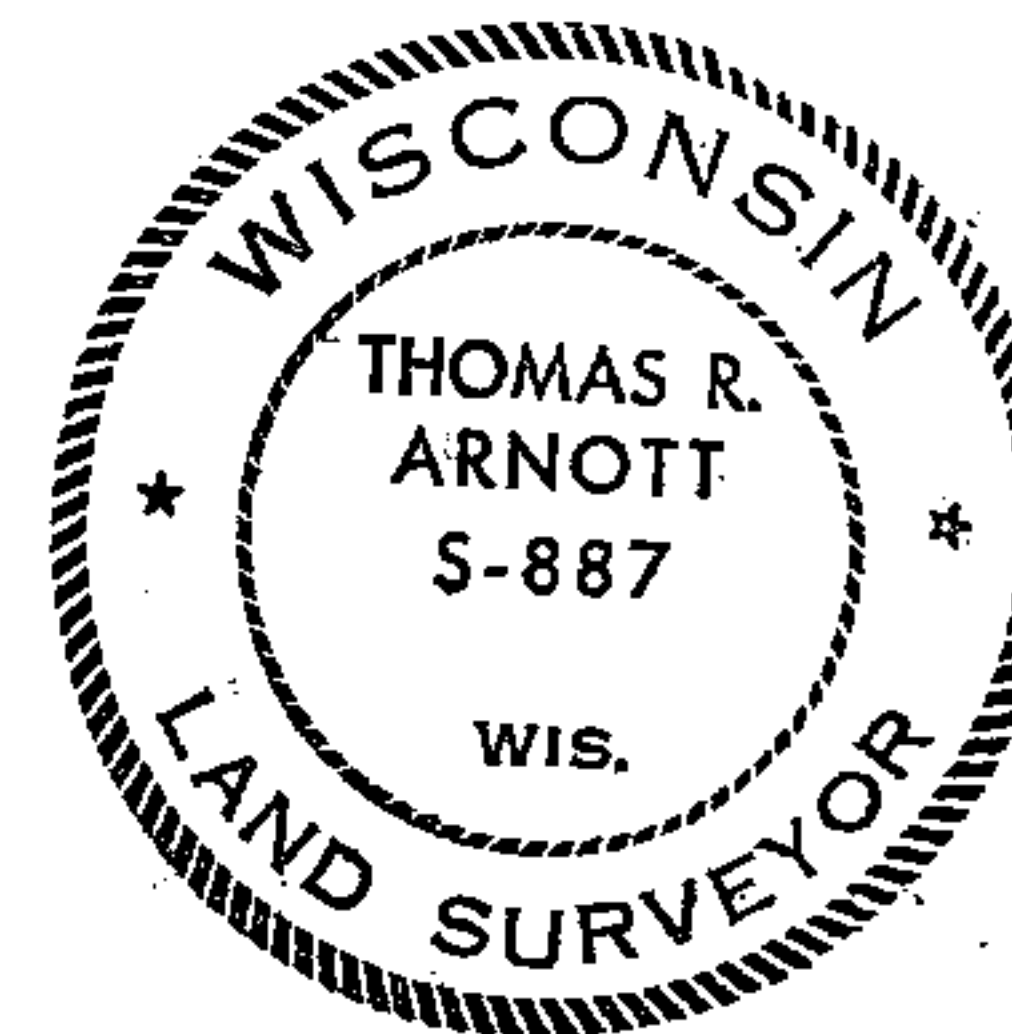

Description of monument and accessories I established to perpetuate the original location of this corner.

left RR spike in place

Ties:

Forest Co. Aluminum monument N42E 39.23 feet
Power Pole (3716-27W10) S85W 23.22 feet

Dated at Grandon, Wis., this 13th day of May, 1976.

Signature Thomas R. Arnott Title Surveyor Registration No. S-887
(County Surveyor, Registered Land Surveyor, or other duly authorized official)

Office of Register of Deeds, County of Forest, I hereby certify that the within instrument was filed in this office for record on the 14th day of May, 1976 at 3 o'clock P.M.

Kyrene Stutzman Document No. **109216**
(Register of Deeds)

By..... Deputy

FORM 985 H. C. MILLER CO., MILWAUKEE

43716220020