

# CERTIFIED LAND CORNER RESTORATION


Index No. **P25**

State of Wisconsin }  
County of Forest } ss.

I, Thomas R. Arnott, do hereby certify that on the 22nd day of June, 19 76, I found evidence of the 1/4 corner of sections 24 & 19 Township 37, North, Range 16-17 E, Fourth Principal Meridian, as described hereon; and that from this evidence I established a new monument and accessories as described hereon to perpetuate the original location of this corner.

Resident witnesses:

\_\_\_\_\_  
\_\_\_\_\_  
\_\_\_\_\_

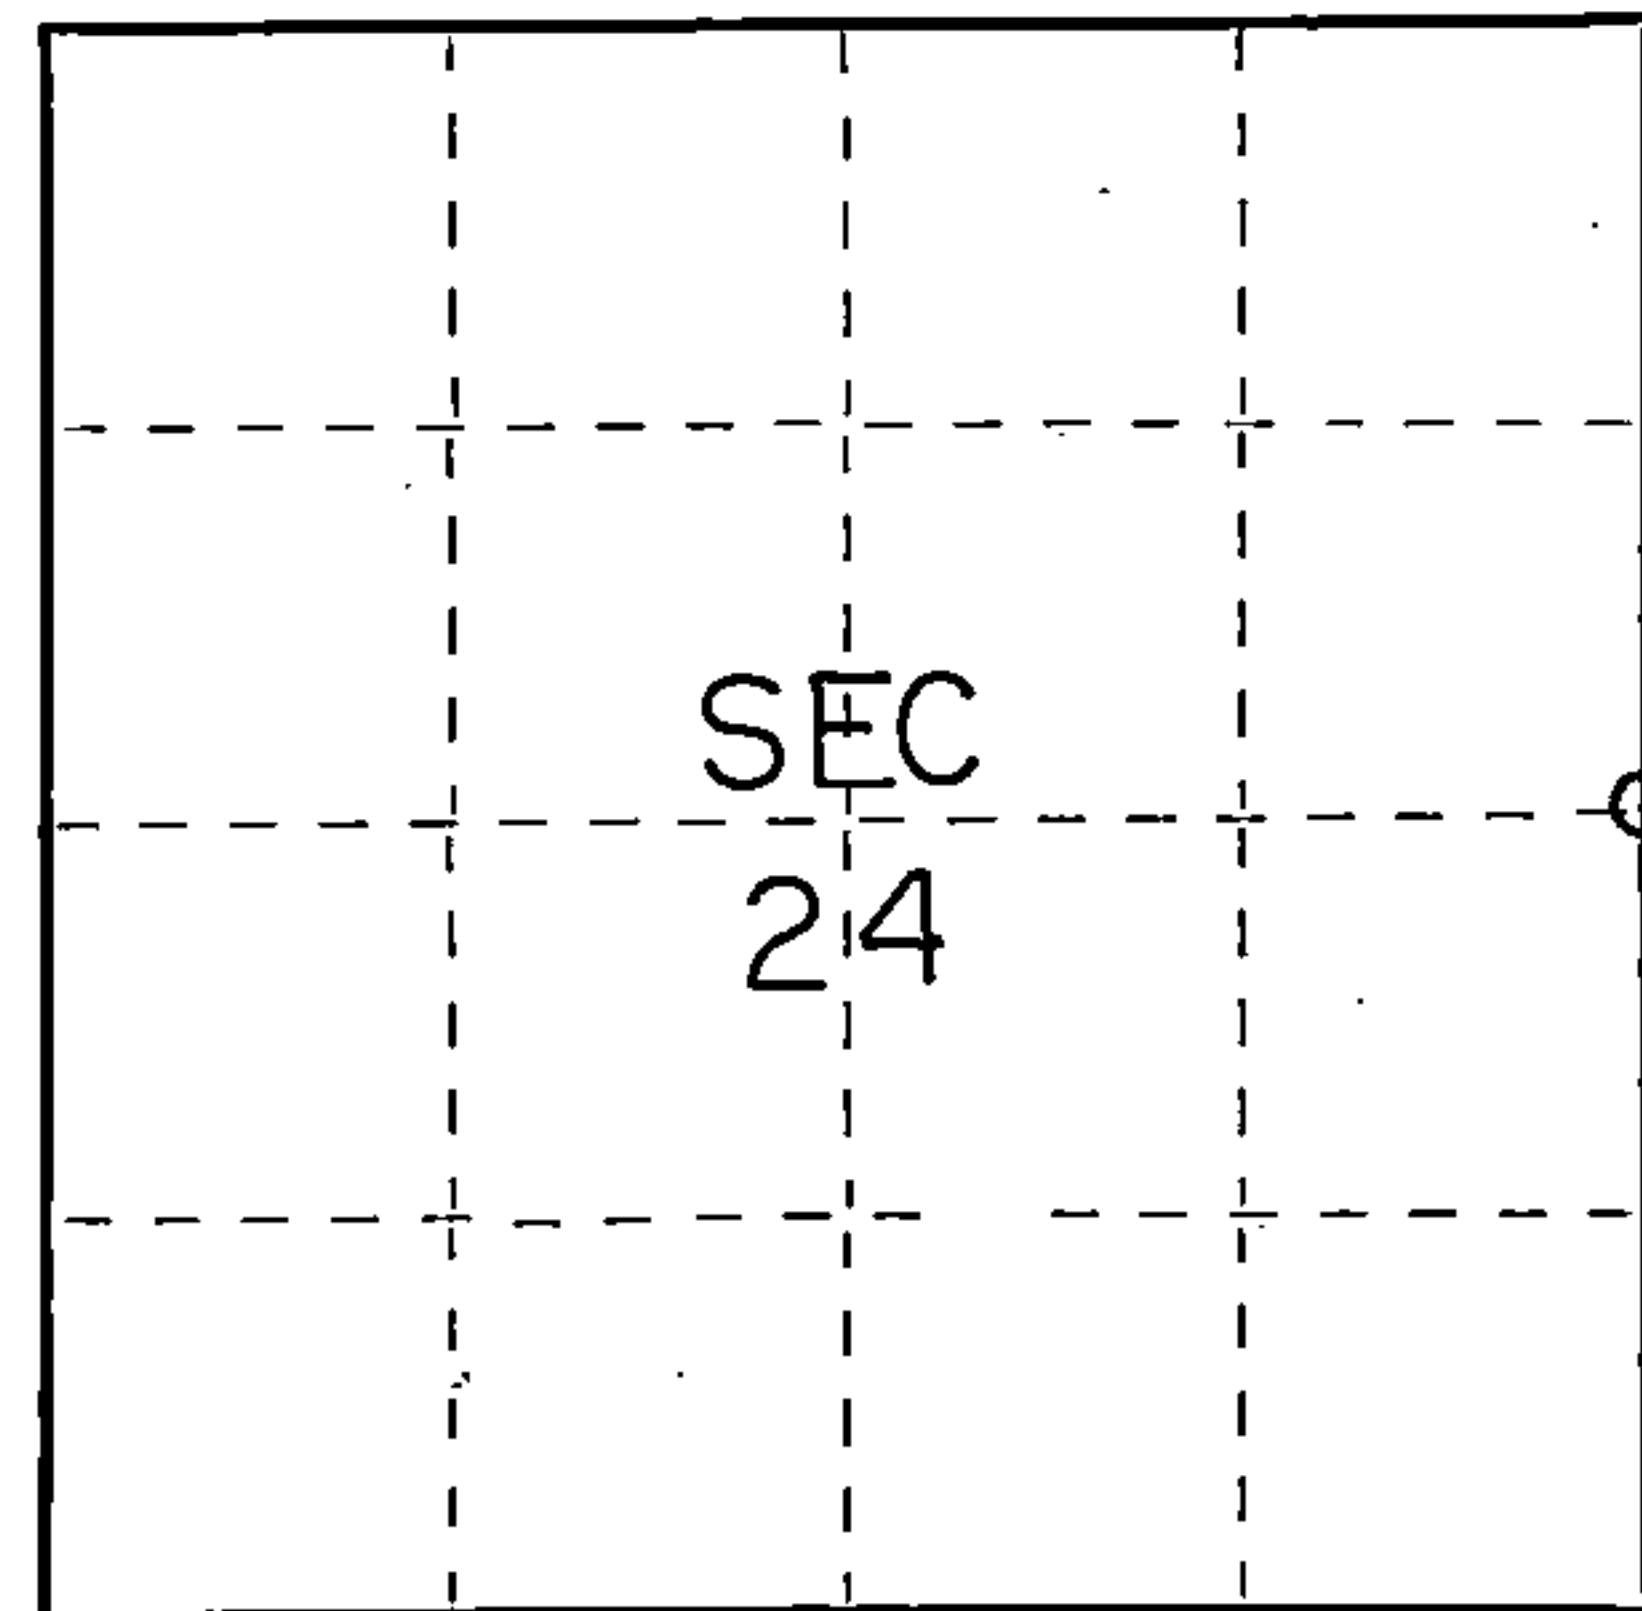

○ = Corner monument restored.

History of original corner establishment:

Original line by Astemus Curtis 1857

Sugar	14	N85E	46 lks.
Sugar	10	S33W	32 lks.

Description of corner evidence found:

Found 1" iron pipe 10" below road surface:



Description of monument and accessories I established to perpetuate the original location of this corner.

Left 1" iron pipe:

Ties:

Forest County aluminum monument	N34W	58.66 feet
Maple 16 notch cut	N71W	36.24 feet
2" iron pipe	West	35.69 feet

Dated at Grandon, Wis., this 23rd day of June, 19 76.

Signature Thomas R. Arnott Title Surveyor Registration No. S-887  
(County Surveyor, Registered Land Surveyor, or other duly authorized official)

Office of Register of Deeds, County of Forest, I hereby certify that the within instrument was filed in this office for record on the 23rd day of June, 19 76 at 3 o'clock P M.

Eugene Stutzman Document Number **109513**  
(Register of Deeds)

By \_\_\_\_\_ Deputy

43716242000