

CERTIFIED LAND CORNER RESTORATION

Index No. T 25


State of Wisconsin }
County of Forest } ss.

I Thomas R. Arnott, do hereby certify that on the 22nd day of June, 1976, I found evidence of the 1/4 corner of sections 25 & 30 Township 37, North, Range 16*17 E, Fourth Principal Meridian, as described hereon; and that from this evidence I established a new monument and accessories as described hereon to perpetuate the original location of this corner.

Resident witnesses:

.....
.....
.....

FORM 985 W. G. MILLER CO., MILWAUKEE

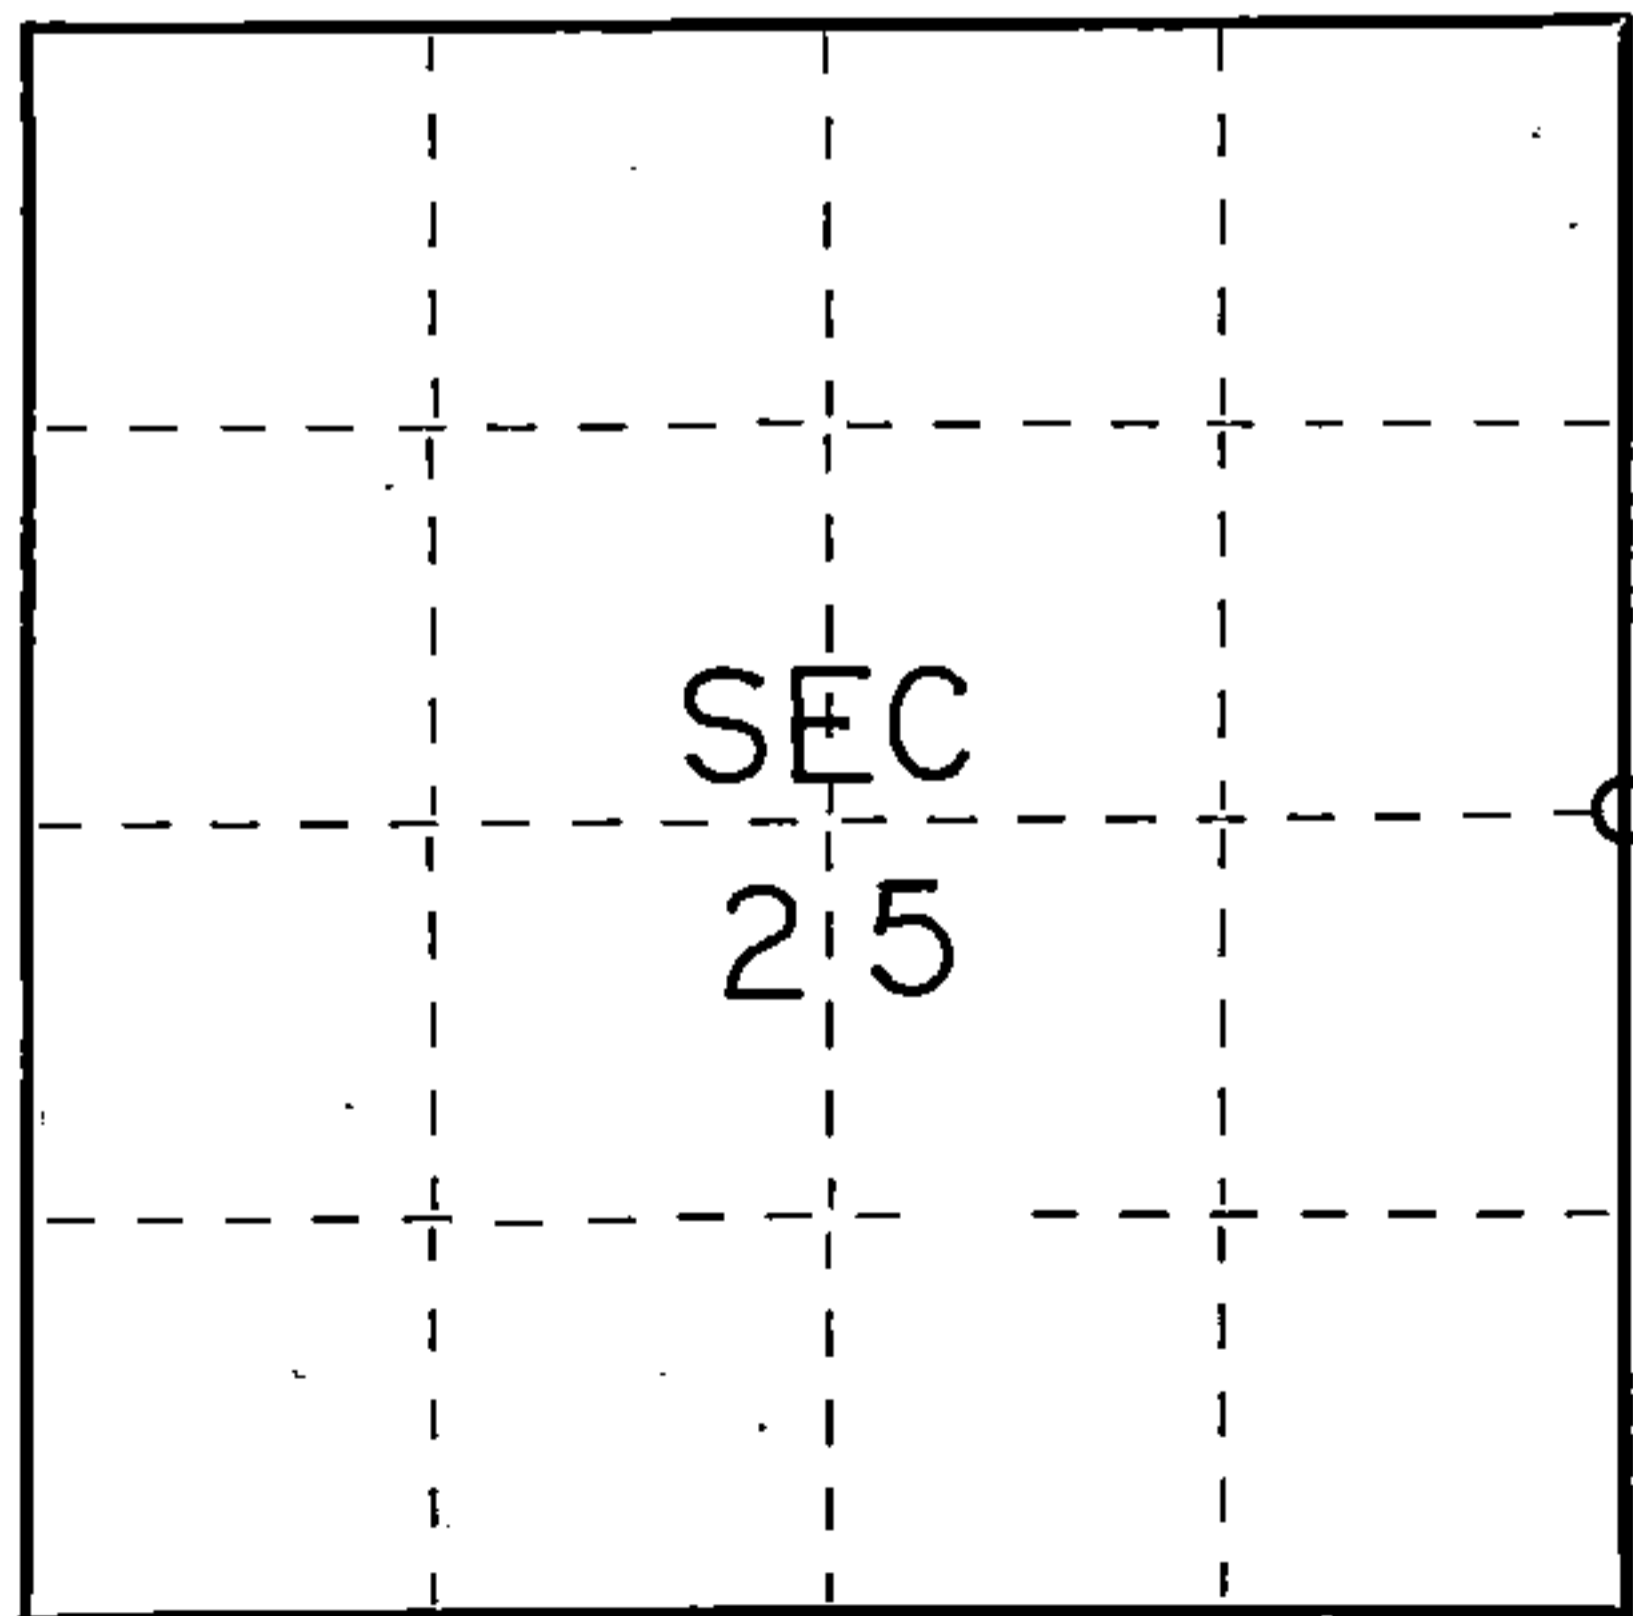

○ = Corner monument restored.


History of original corner establishment:

Original line by Astemus Curtis 1857

Hemlock 12 S30W 9 lks.
Hemlock 10 N53E 37 lks.

Description of corner evidence found:

Found 2" iron pipe with brass cap marked G. E. Co. 1953

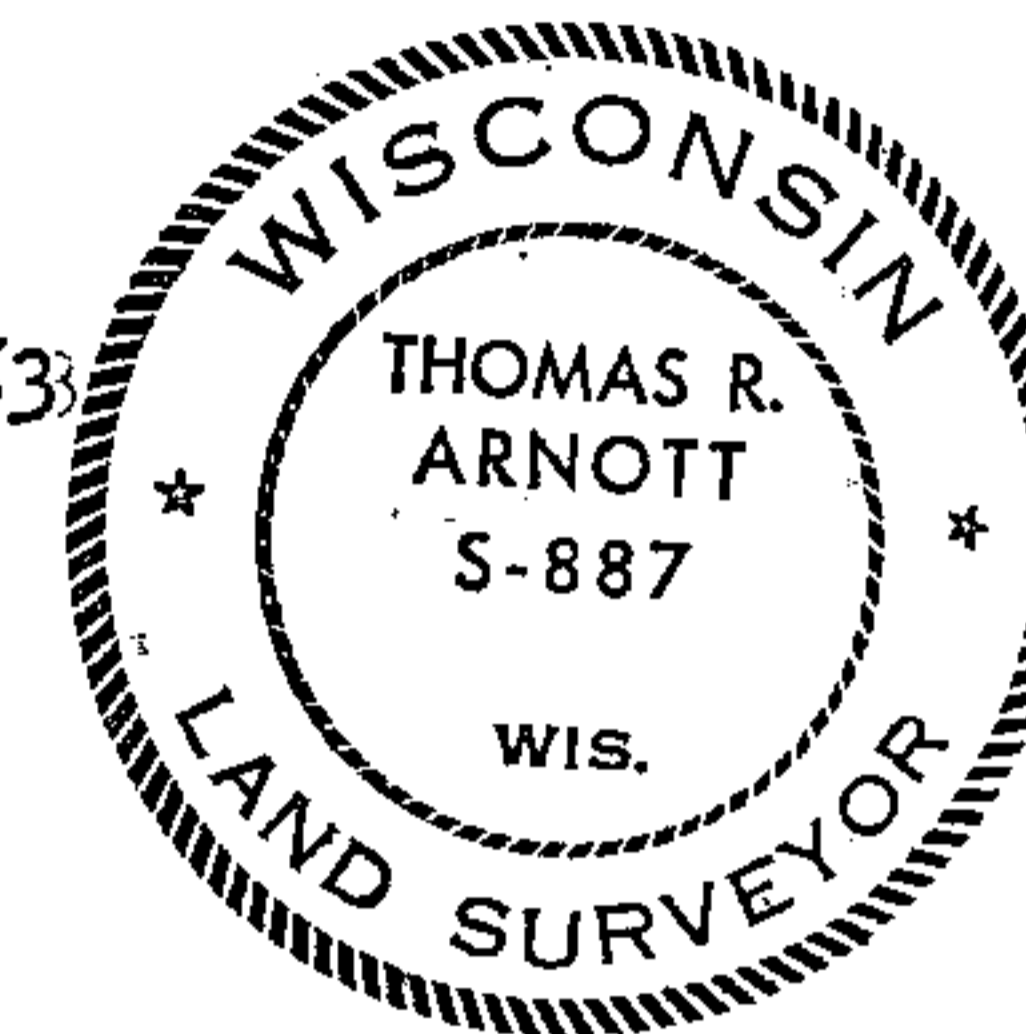

43716252000

Description of monument and accessories I established to perpetuate the original location of this corner.

Left 2" iron pipe with brass cap

Ties:

Power pole (3717-30W7) N11E 26.82 feet
Telephone junction box S78E 33.53 feet
Tag west side Forest County sign South 14.04 feet

Dated at Crandon, Wis., this 23rd day of June, 1976

Signature Thomas R. Arnott Title Surveyor Registration No. S-887
(County Surveyor, Registered Land Surveyor, or other duly authorized official)

Office of Register of Deeds, County of Forest, I hereby certify that the within instrument was filed in this office for record on the 23rd day of June, 1976 at 3 o'clock P. M.

Eugene Stutzman Document Number 109514
(Register of Deeds)

By..... Deputy