

U. S. PUBLIC LAND SURVEY MONUMENT RECORD

INSTRUCTIONS:


This record shall show the location of the corner and shall include all of the following nine elements (a through i).

- (a) Identify the corner by reference to the U.S. public land survey system.
 O = Corner monument restored.

Corner common to Sections 34 and 35, T37N-R16E,
 and Sections 2 and 3, T36N-R16E

Index Number A-17 (T36N-R16E)

Forest County, Wisconsin

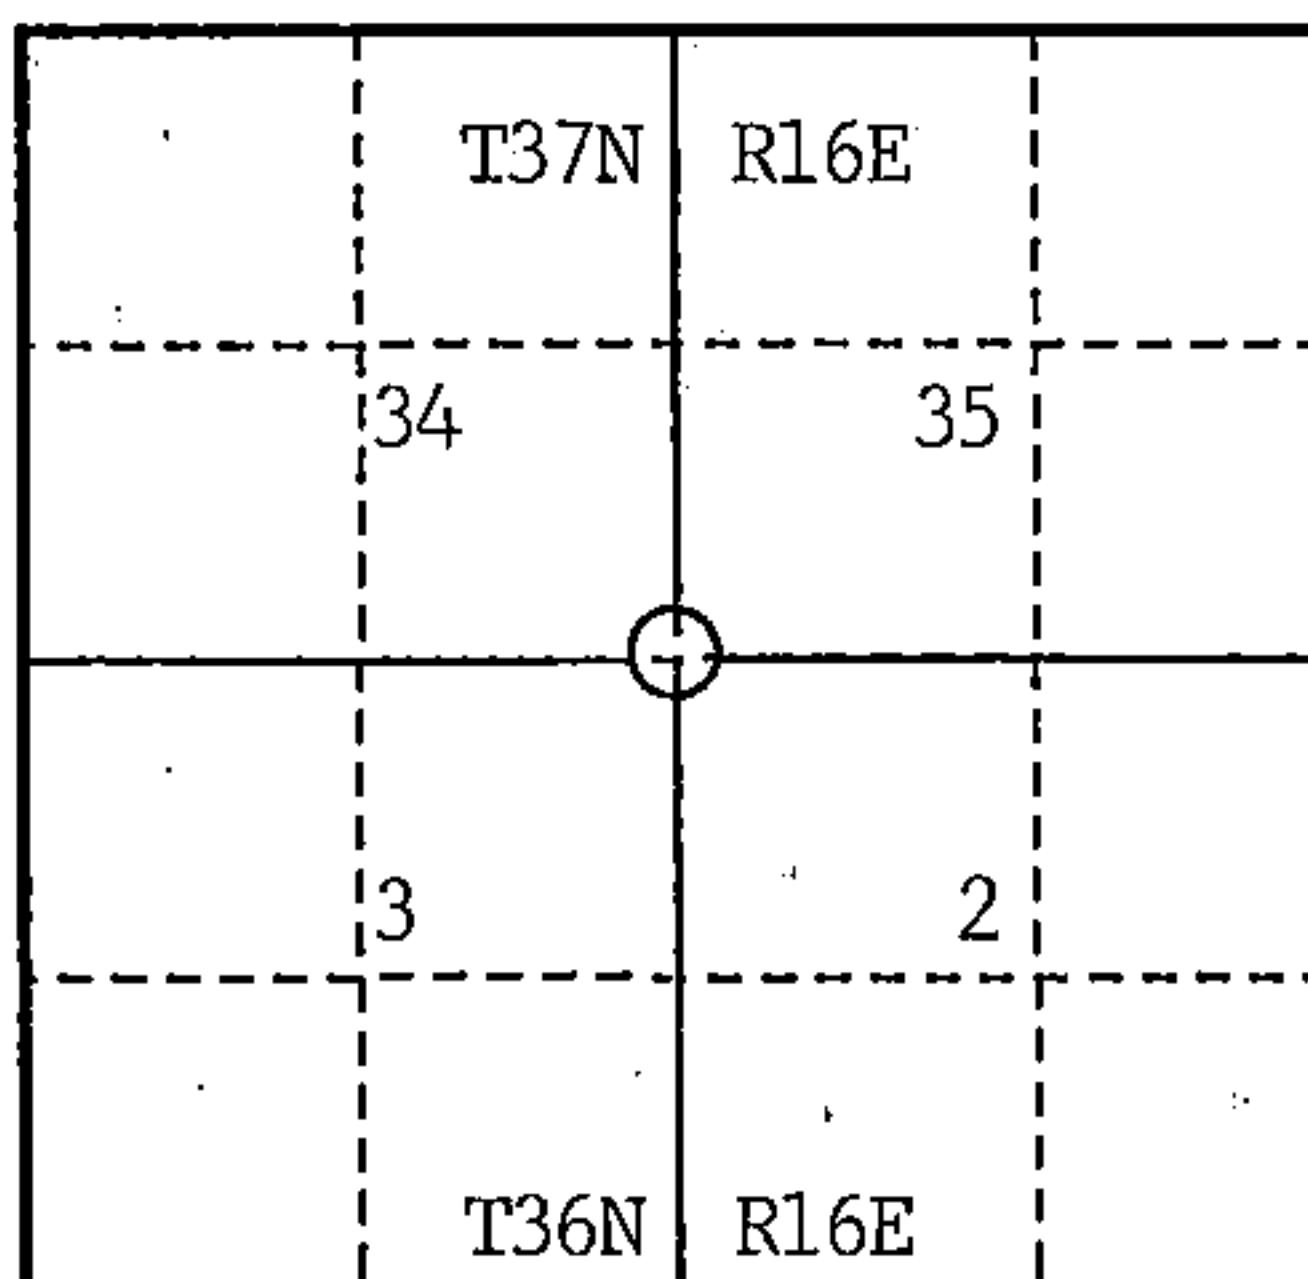

- (b) Describe any record evidence, monument evidence, occupational evidence, testimonial evidence or any other material evidence you considered, and whether the monument was found or placed.

1857 - Original wood post set by Artemas Curtis, witnessed by 15 Tamarack N83W 96 lks.; 14 Tamarack N08E 86 lks.; 14 Tamarack S75W 23 lks.

1930 - Notes of Goodman Lumber Co. indicate quarter corner common to Sections 2 and 3 was set by proportionate method between section corners $\frac{1}{2}$ -mile to North and South. No record given for corner on town line, but is assumed to have been monumented at that time.


1934 - CCC (Forest Service) record by J.W. White as existing stake north and west of creek. No recovery of OBTs or marking of NBTs was noted.

1991 - Found 2" x 5' iron pipe 15" below surface in beaver marsh at edge of 5' wide June stream; pipe is similar to other Goodman monuments recovered. Position is substantially in line with corners $\frac{1}{2}$ -mile and 1 mile South in agreement with Goodman proportionate measure. Position is 7.3 feet North and 11.8 feet West of midpoint between section corners 1 mile to East and West. Accepted monument as most probable position of true corner.

- (c) In the plan view drawing below, provide reference ties to at least 4 witness monuments, or, if the location is within a municipality, to at least 2 witness monuments. (Witness monuments shall be made of concrete, natural stone, iron or other equally durable material.)

- (d) Show a plan view drawing depicting the relevant monuments and reference ties which is sufficient in detail to enable accurate relocation of the corner monument if the corner monument is disturbed. Indicate north.

1. 2 $\frac{1}{2}$ " x 120" Aluminum monument with location stamped on cap.
2. Black Spruce 9" S62°E 136.32 feet.
3. White Birch 7" S44°E 147.62 feet.
4. Black Spruce 4" N65°W 106.28 feet.
5. Tamarack 8" N19°W 99.90 feet.
6. Steel sign post North 2.00 feet.

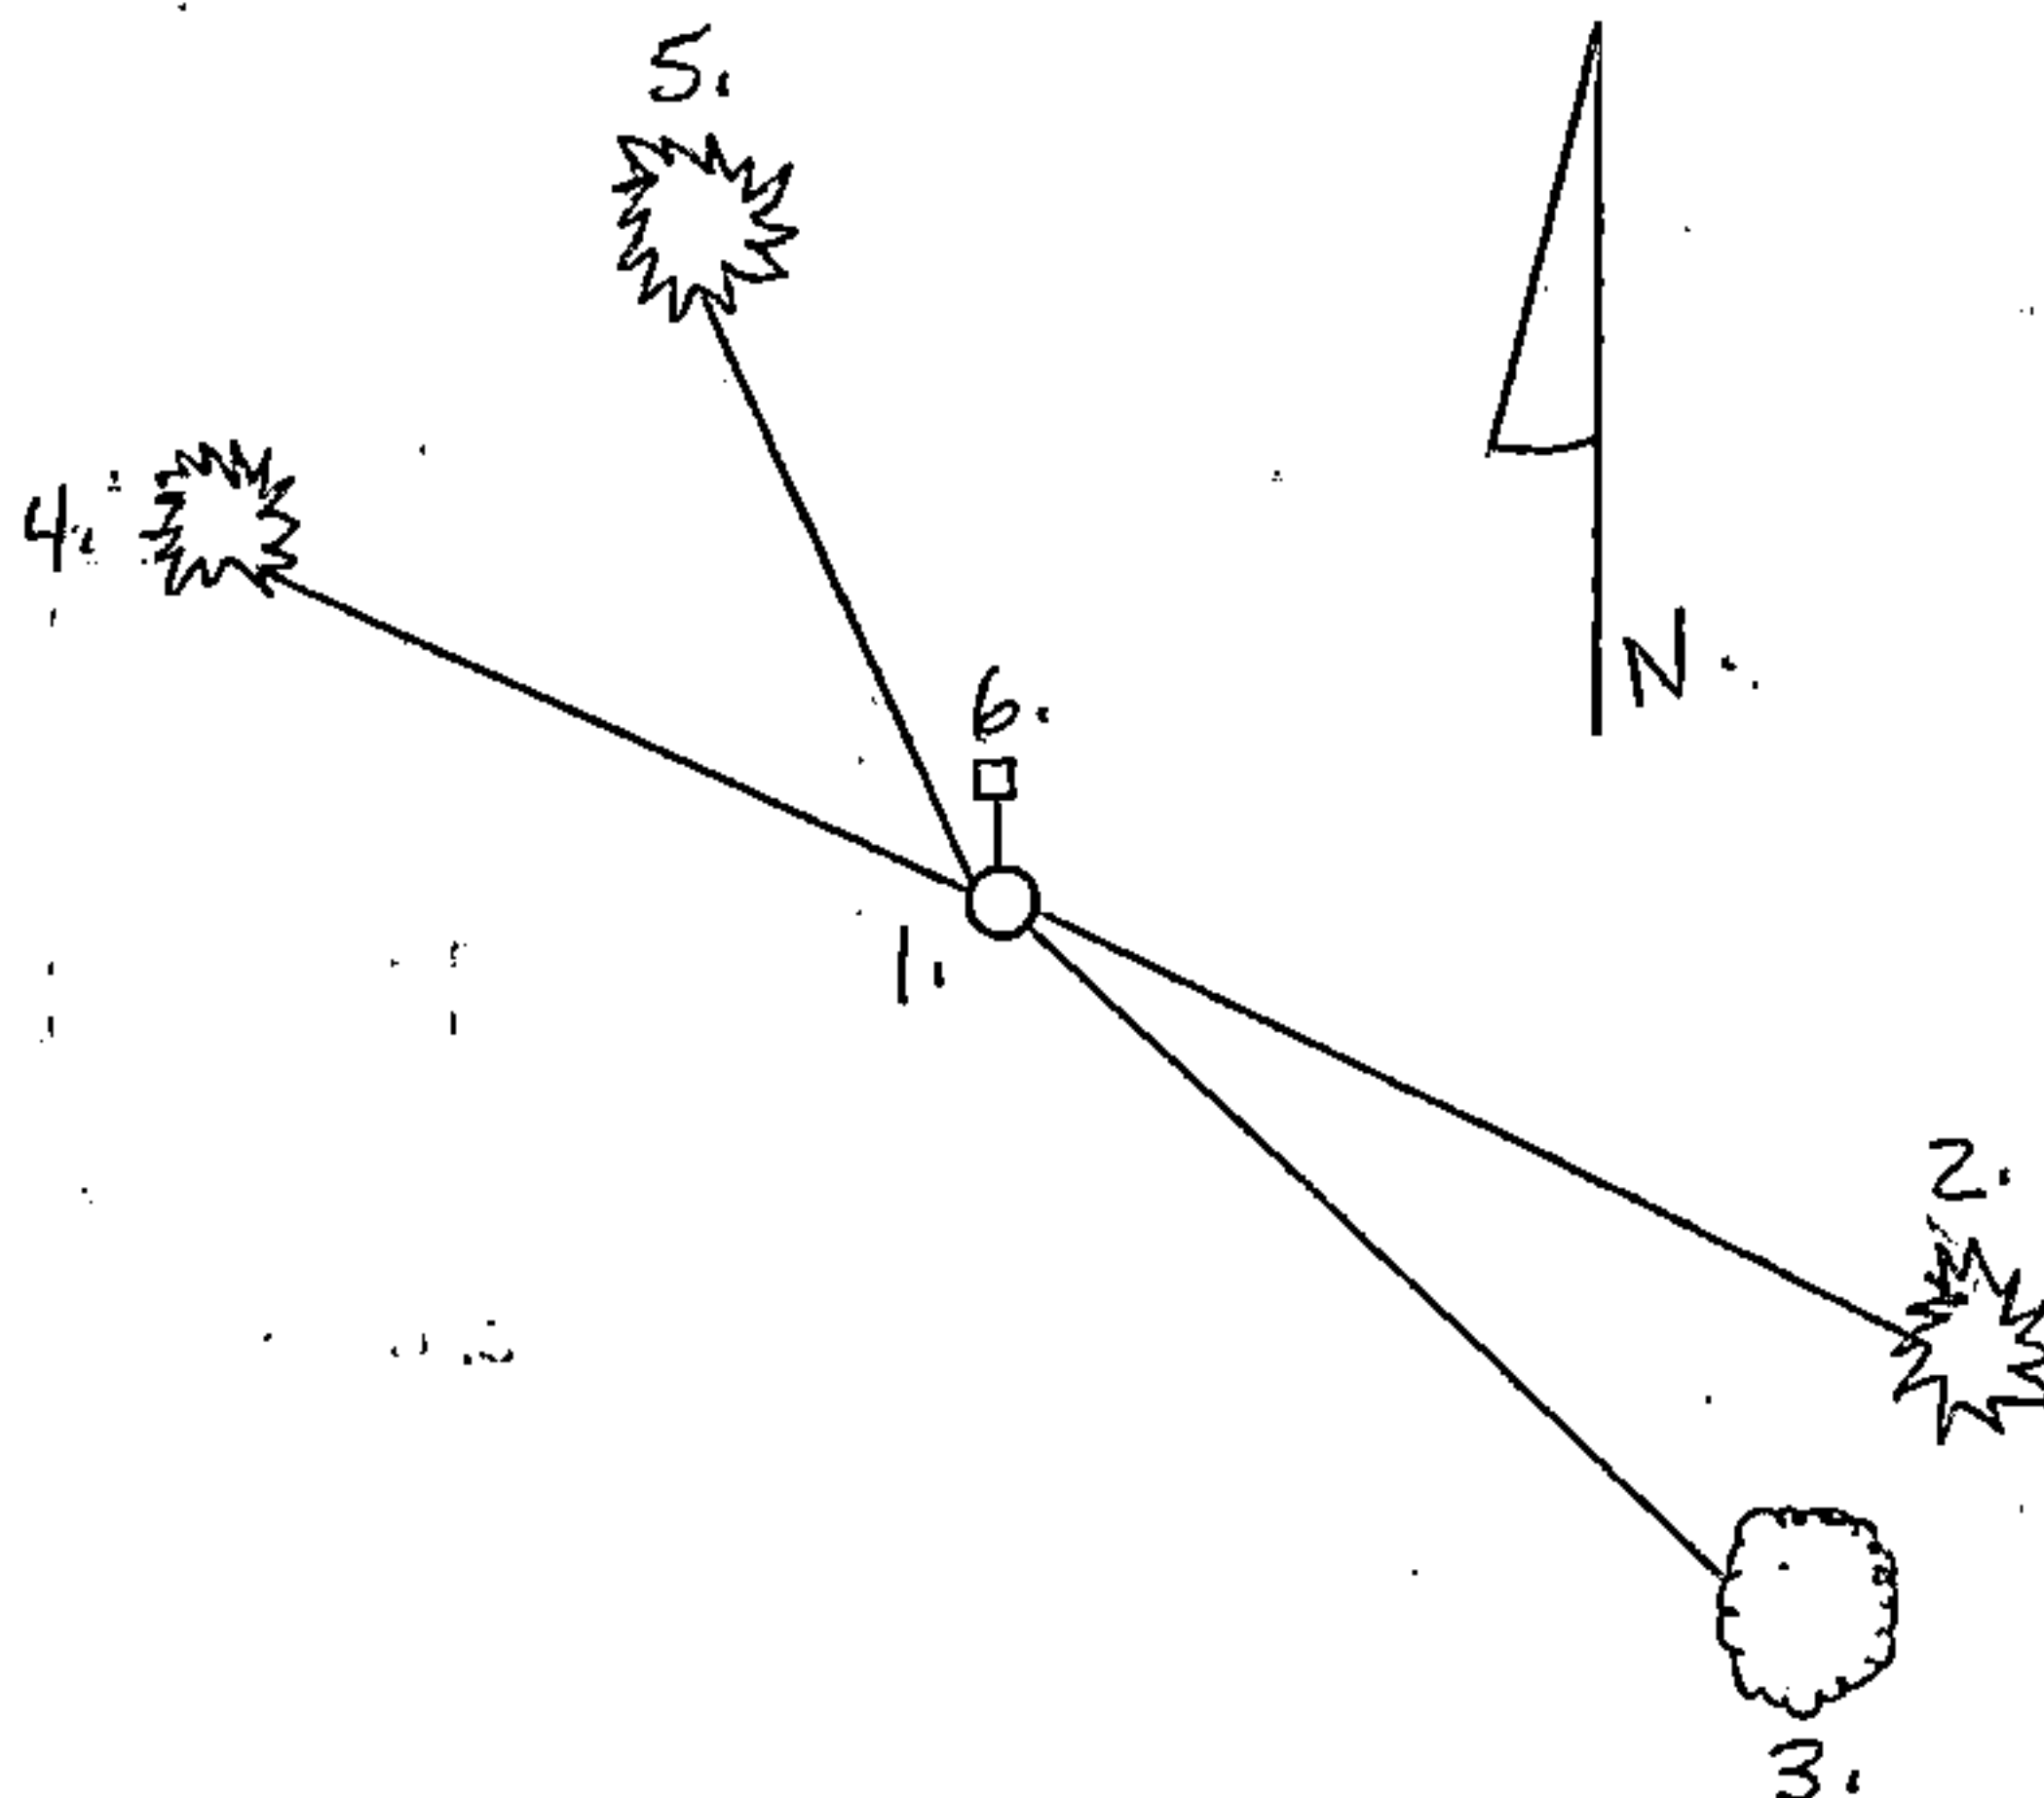

REGISTER'S OFFICE
 Forest County, Wis.

Received for record this 8th day
 of October A.D., 1997 at
2:00 o'clock P.M. and recorded
 in Vol. Corner Restorations
 page A-17

Register of Deeds

43716340000

A-17

A-17

- (e) Describe any material discrepancy between the location of the corner as restored or reestablished and the location of that corner as previously restored or reestablished by distance and direction. Show the discrepancy on the plan view drawing under (d), above. Show the distances between the corner as previously restored or reestablished and (1) the corner as restored or reestablished, and (2) to at least 2 of the witness monuments shown on the drawing in (d), above.

Accepted position of monument found as true corner.

- (f) Was the corner restored through acceptance of (1) an obliterated evidence location, or, (2) a found perpetuated location?

(2) Found perpetuated location.

- (g & h) Was the corner reestablished through lost corner proportionate methods? If so, show the method, including the directions and distances to other public land survey corners used as evidence or used for proportioning in determining the corner location?

No.

(1) I, Charles F. Clark, RLS 1767
COLEMAN ENGINEERING COMPANY

(type or print name) certify that the corner location shown on this record was determined by me or under my direction and control and that this U.S. Public Land Survey Monument Record is correct and complete to the best of my knowledge and belief.

Signature

August 24, 1991

Date

CERTIFICATE READY FOR FILING:

Darrell E. Richards
Acting District Ranger

