

CERTIFIED LAND CORNER RESTORATION

State of Wisconsin }
County of Forest } ss.

I, Jean F. Resvick, do hereby certify that on the 12 day of March, 1974, I found evidence of the South quarter corner of Section 14 Township 38 north, Range 12 east, Fourth Principal Meridian, as described hereon; and that from this evidence I established a new monument and accessories as described hereon to perpetuate the original location of this corner:

Description of original monument and accessories and subsequent restorations:

Dependent Resurvey in 1937 by Wesson Cook

At proportionate distance set an iron post, 3 ft. long, 2 ins. diam., 24 ins. in the ground for 1/4 sec. corner with a brass cap marked: 1/4, S14, S23, 1937

From which:

- Y. Birch, 10" bears S6° 30'E, 7 lks.
- Maple, 18", bears N7° 30'W, 67 lks.

Description of corner evidence found:



Iron post monument as described above in place
Y. Birch, 18", S6°E, 7 lks.

Maple bearing tree was removed and destroyed by road construction.

Description of monument and accessories I established to perpetuate the location of this corner:

Blazed and scribed the following new bearing tree:

- Y. Birch 17", N75°W, 34.49 ft.
- Set a steel sign post, south east, 0.50 ft.

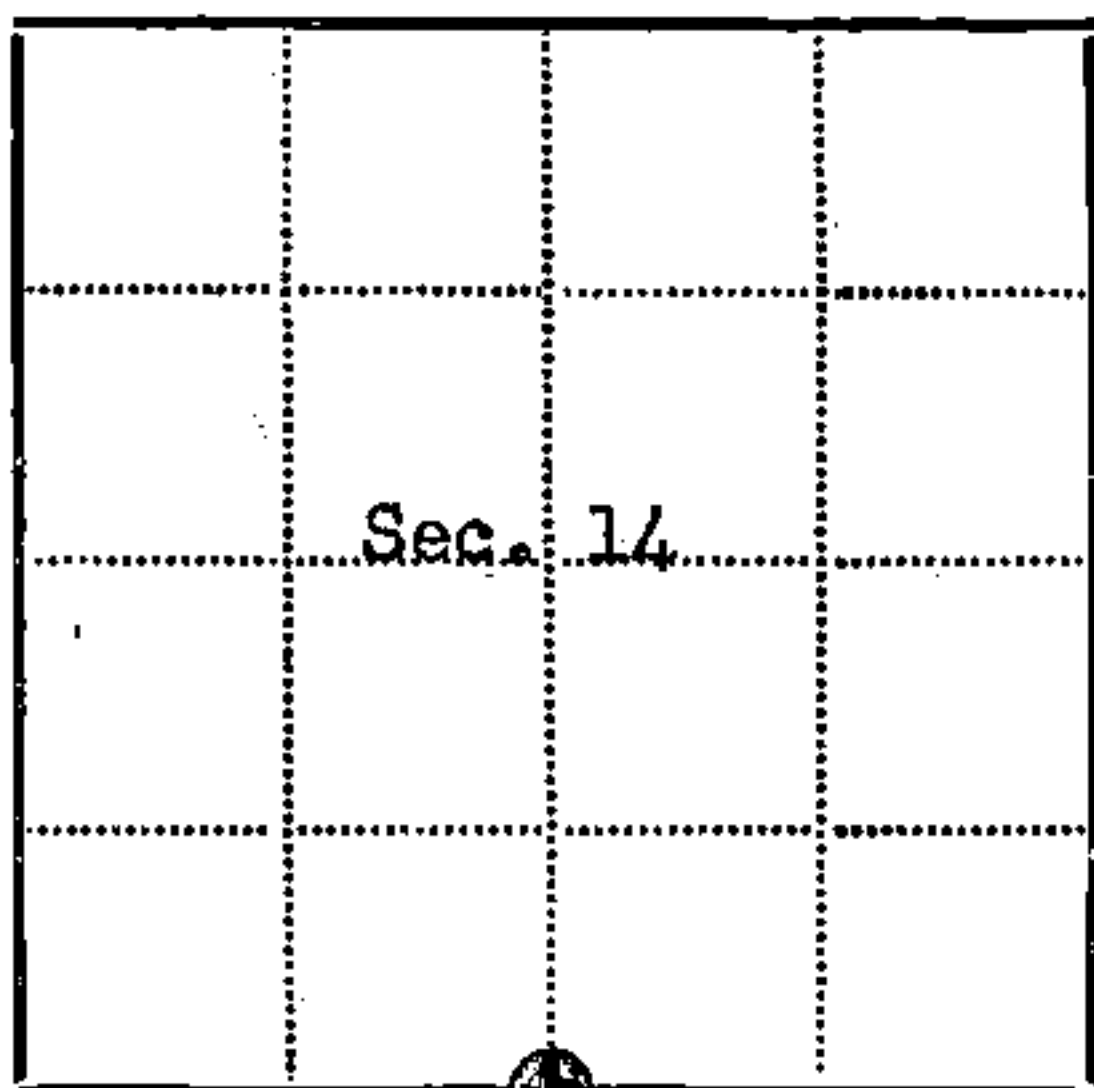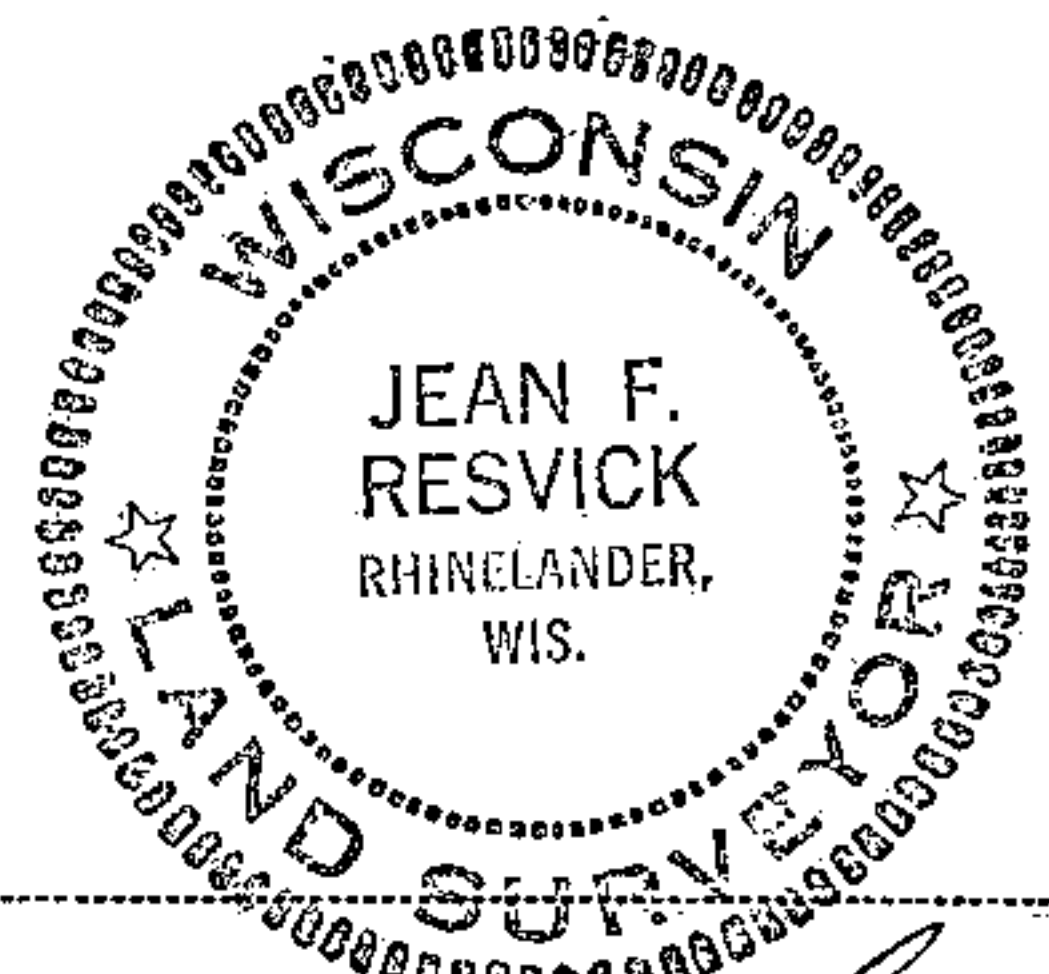

- - Corner monument restored
- -

Resident witnesses.....

Dated at Rhinelander Wisconsin, this 17 day of May 1974.....

Signature Jean F. Resvick Title Land Surveyor
(County Surveyor, Registered Land Surveyor, or other duly authorized official)

Surveyors Registration No. S-802 DOCUMENT NUMBER 105812

Office of Register of Deeds County of Forest

I hereby certify that the within instrument was filed in this office for record on the 8th day of August 1974, and was filed in Book No. Corner Restorations Page No. N-19 of County Records.

Signature Eugene Staszynski Title

Township 38 north, Range 12 east, Section 14, Index No. N-19, Page No.

43812140020

N19