

CERTIFIED LAND CORNER RESTORATION

State of Wisconsin

County of Forest

ss.

I, Jean F. Resvick, do hereby certify that on the 28th day of September, 1965, I found evidence of the west quarter corner of Section 17 Township 38 north, Range 12 east, Fourth Principal Meridian, as described hereon; and that from this evidence I established ~~a new monument and~~ accessories as described hereon to perpetuate the original location of this corner:

Description of original monument and accessories and subsequent restorations:

Dependent resurvey by Wesson Cook in 1937.

From remains of original bearing trees set an iron post, 3 ft. long, 2 ins. diam., 26 ins. in the ground, with brass cap marked

 $\frac{1}{4}$, S17, S16, 1937 from which the following bear

W. pine, 24" stump, S 83°W, 16 lks.


Birch, 14" stump, N 84°E, 15 lks.

Hemlock 10", S53°45' E, 69 lks.

Hemlock 12", N67°30'W, 74 lks.

Description of corner evidence found:

Monument found as described above with brass cap marked:

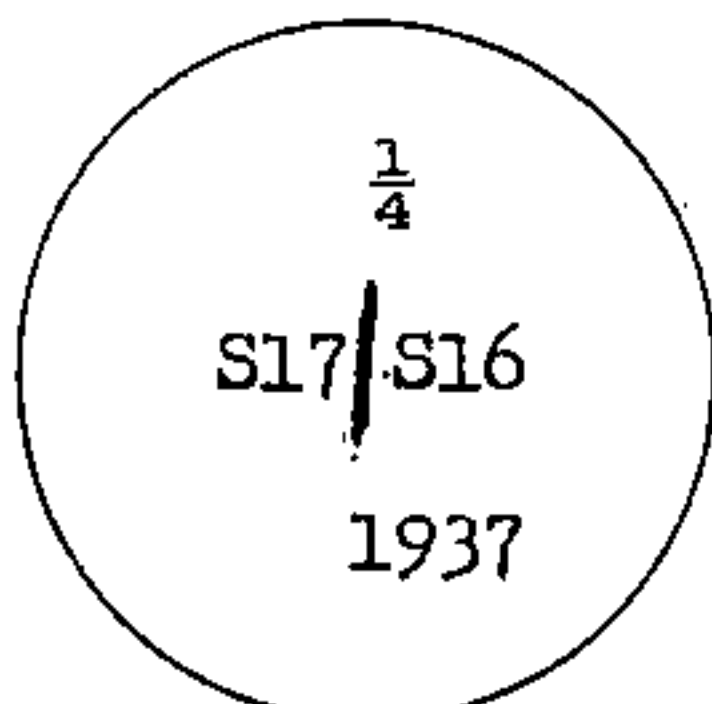


from which a w. pine, 24" stump bears S 83° W, 10.6 ft.
a hemlock 15", bears S 53° 45' E, 45.5 ft.

Description of ~~monument and~~ accessories I established to perpetuate the original location of this corner:

Blazed and scribed the following new bearing tree

Cedar 6", bears S 52° 30'W, 25.44 feet or 38.55 lks.

Center line of roads bears N 42°W, 43 feet or 65.15 lks.

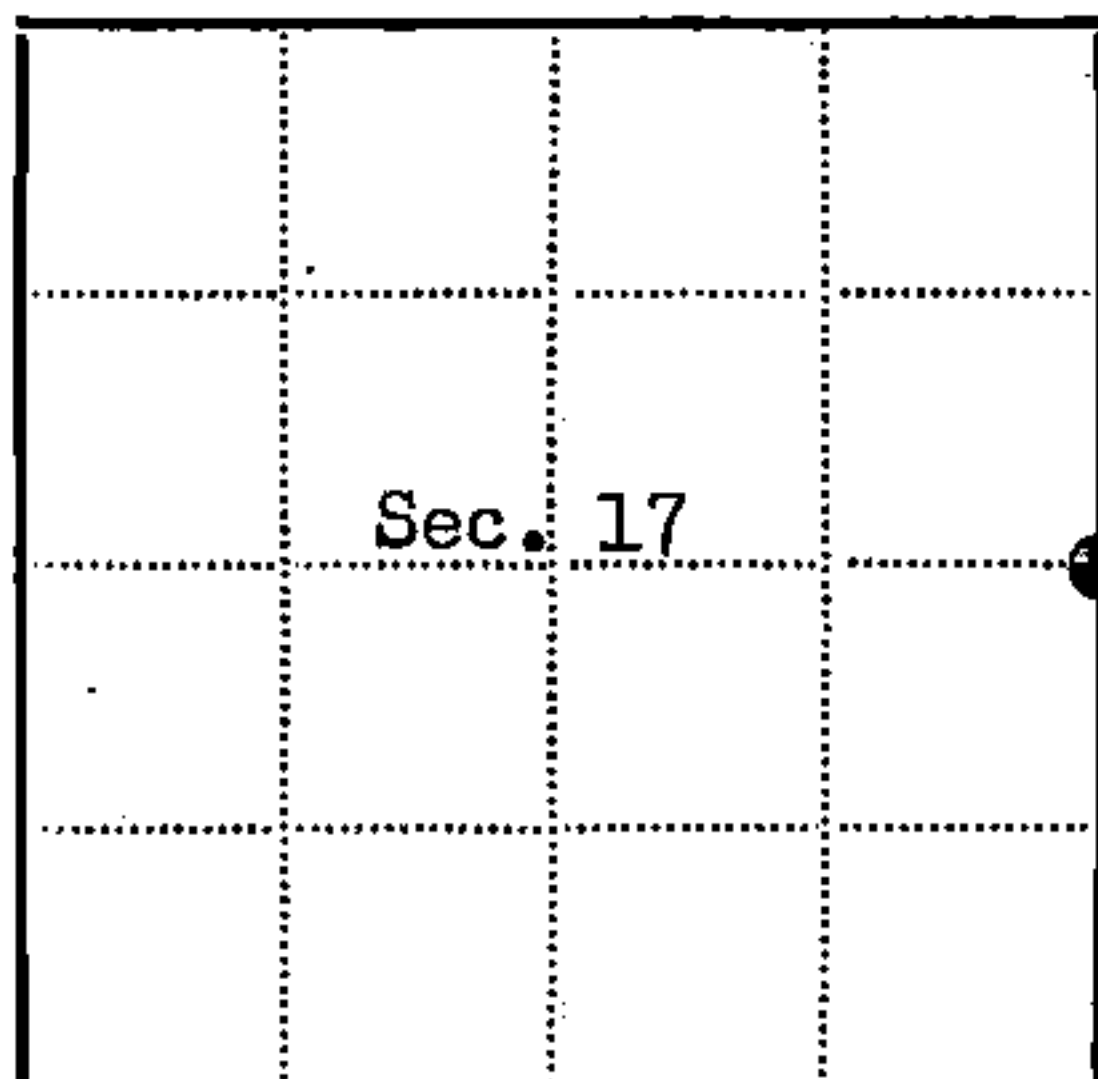

● = Corner monument restored

□ =

Resident witnesses

Dated at Rhineland Wisconsin, this 7th day of Jan., 1966.Signature Jean F. Resvick Title Cadastral Surveyor
(County Surveyor, Registered Land Surveyor, or other duly authorized official)Surveyors Registration No. S-80291351Office of Register of Deeds County of ForestI hereby certify that the within instrument was filed in this office for record on the 13 day of April, 1966, and was filed in Book No. _____ Page No. _____ of County Records.Signature Anna Peterson Title Register of DeedsTownship 38 north, Range 12 east, Section 17, Index No. L-9, Page No. _____4381217 2000