


U.S. PUBLIC LAND SURVEY MONUMENT RECORD

Index No. A-9

State of Wisconsin }
County of Forest } ss.

I, John C. Schulke, do hereby certify that on the 30th day of June, 1986, I found evidence of the Northwest Section corner of Section 4 Township 37 North, Range 12 East, Fourth Principal Meridian, as described hereon; and that from this evidence I established a new monument and accessories as described hereon to perpetuate the original location of this corner.

Resident witnesses:

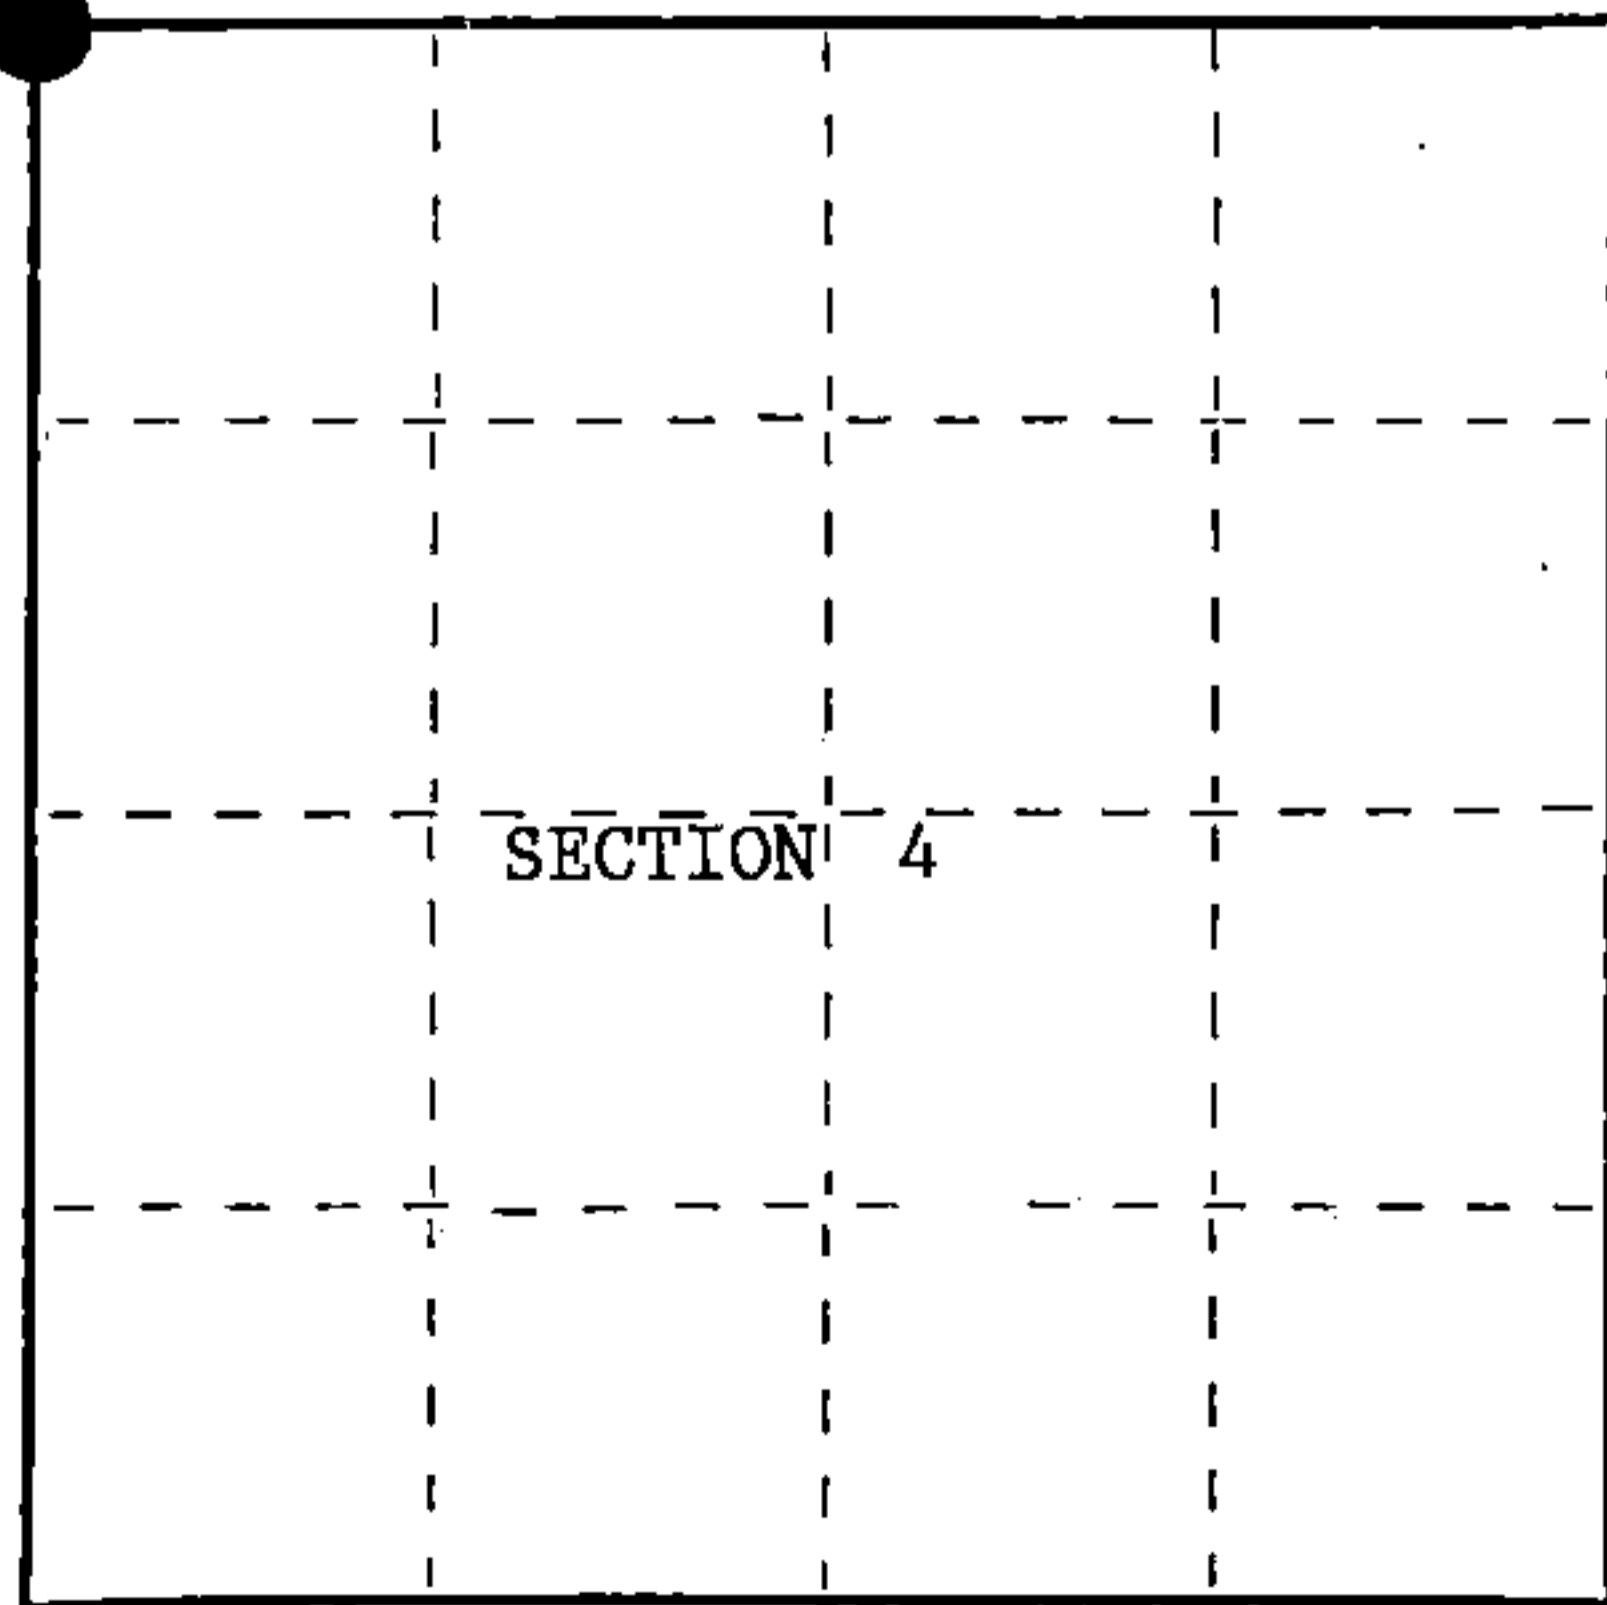

○ = Corner monument restored.

History of original corner establishment:

Original Government Survey in 1858 by Alfred Millard

Corner references recovered in Dependent Resurvey by Wesson Cook of T38N, R12E in 1937-38 for the General Land Office (BLM). Set a concrete monument, 24 in. long, 6 in. in diameter, 20 in. in the ground.

Description of corner evidence found:
Found BLM monument in place, with a brass tablet marked for identification of the corner. Square wooden post marked with metal tags also found beside the monument.

Description of monument and accessories I established to perpetuate the original location of this corner.

From the recovered corner monument established the following new references:

- Spruce 4" N28°E 50.98 feet
- Tamarack 3" N35°E 38.76 feet
- Spruce 5" N32°W 69.78 feet
- Steel sign post set 0.7 feet Northeast
- Center of Wisconsin Highway 32 S20°W 310 feet (Highway bears N70°W).
- The above bearing trees all blazed, scribed and tagged.

Dated at Ludington, Michigan, this fifth day of January, 1987.

Signature: John C. Schulke Title: Land Surveyor Registration No. 1665
(County Surveyor, Registered Land Surveyor, or other duly authorized official)

Office of Register of Deeds, County of Forest, I hereby certify that the within instrument was filed in this office for record on the 24th day of February, 1987 at 2:00 o'clock P. M.

Paul Achenbrenner
(Register of Deeds)

By _____ Deputy

REGISTER'S OFFICE
Forest County, Wis.

Received for record this 24th day of February, A.D., 1987 at 2:00 o'clock P.M. and recorded in Vol. CORNER RESTORATIONS page 4-9

Paul Achenbrenner
Register of Deeds

FORM NO. 985-A

M.C. Miller Company

Stock No. 26273

DOCUMENT NUMBER
132168

43812320000


(e) Describe any material discrepancy between the location of the corner as restored or reestablished and the location of that corner as previously restored or reestablished by distance and direction. Show the discrepancy on the plan view drawing under (d), above. Show the distances between the corner as previously restored or reestablished and (1) the corner as restored or reestablished, and (2) to at least 2 of the witness monuments shown on the drawing in (d), above.

None. found corner

(f) Was the corner restored through acceptance of (1) an obliterated evidence location, or, (2) a found perpetuated location?

Restored through acceptance of a found perpetuated location.

(g&h) Was the corner reestablished through lost corner proportionate methods? If so, show the method, including the directions and distances to other public land survey corners used as evidence or used for proportioning in determining the corner location?

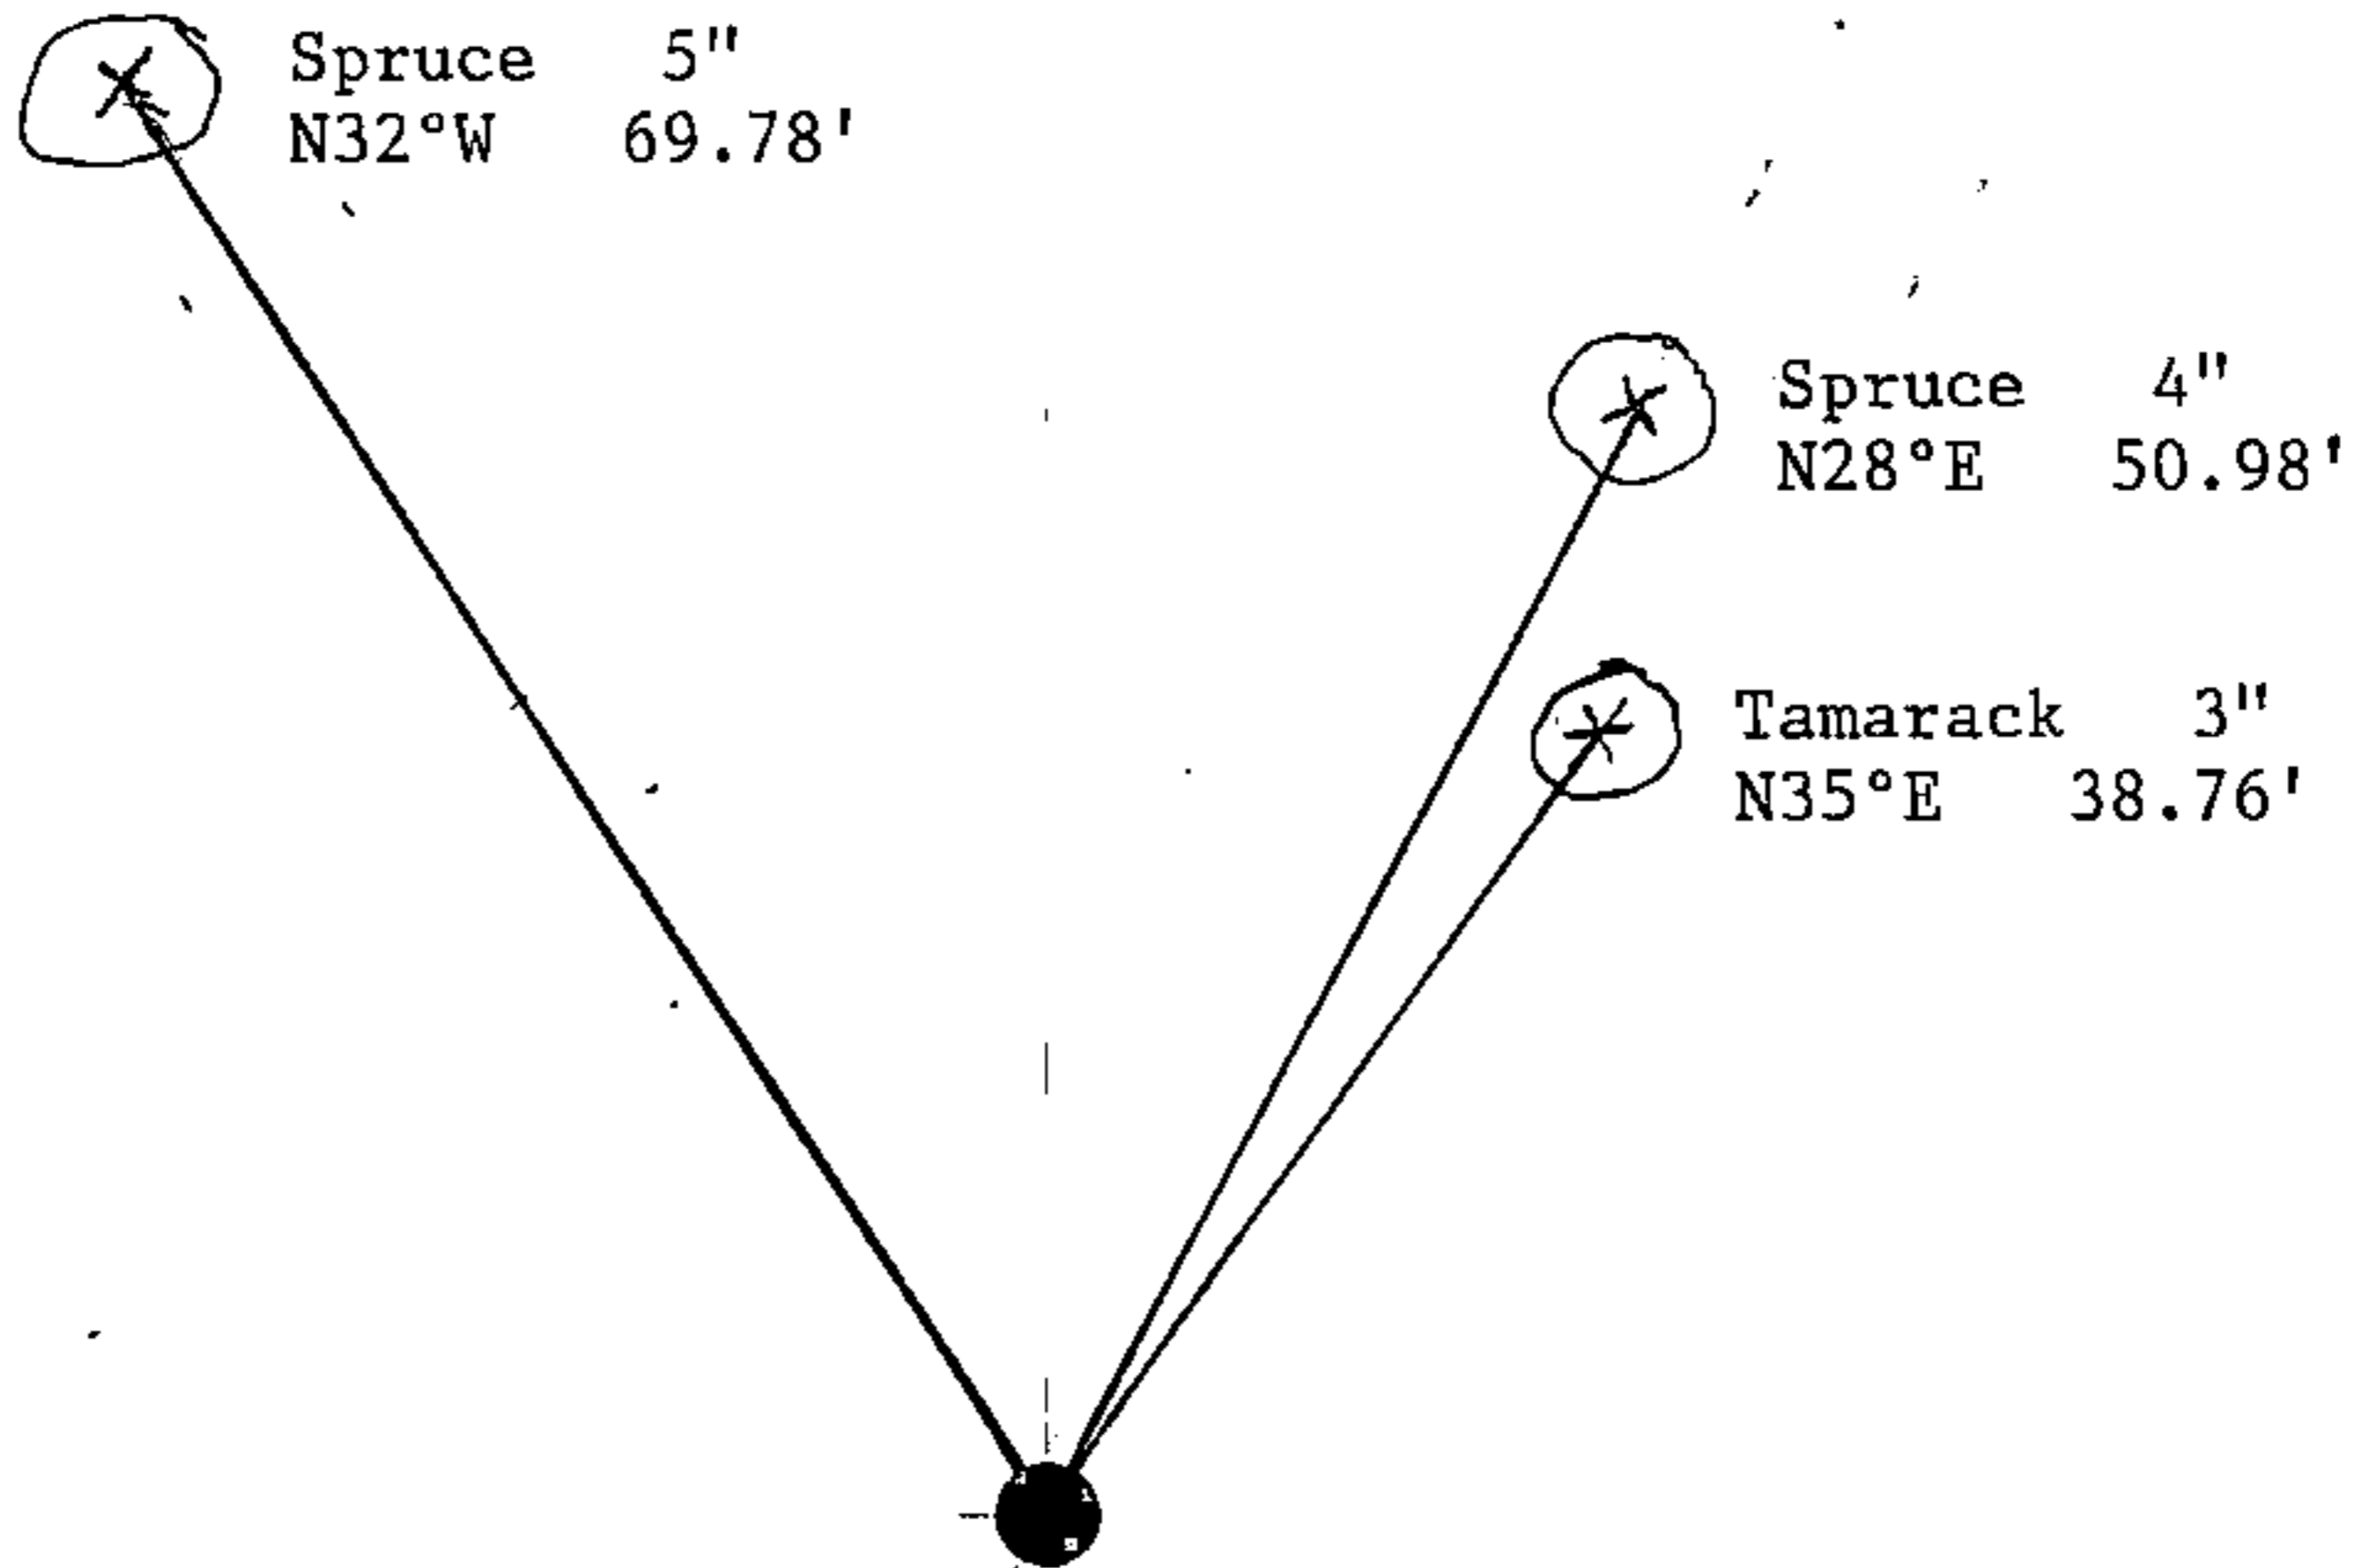

(i) I, John C. Schulke
(type or print name) certify that the corner location shown on this record was determined by me or under my direction and control and that this U.S. Public Land Survey Monument Record is correct and complete to the best of my knowledge and belief.

John C. Schulke Jan 5th, 1987
Signature Date

Certificate Ready for Filing: Dale B. Staeg 2/24/87
District Ranger Date