

U.S. PUBLIC LAND SURVEY MONUMENT RECORD


Index No. A-15

State of Wisconsin }  
County of FOREST } ss.

I, John Schulke, do hereby certify that on the 28th day of August, 1989, I found evidence of the North Quarter corner of Section 3 Township 37 North, Range 12 East, Fourth Principal Meridian, as described hereon; and that from this evidence I established a new monument and accessories as described hereon to perpetuate the original location of this corner.

Resident witnesses:

.....  
.....  
.....

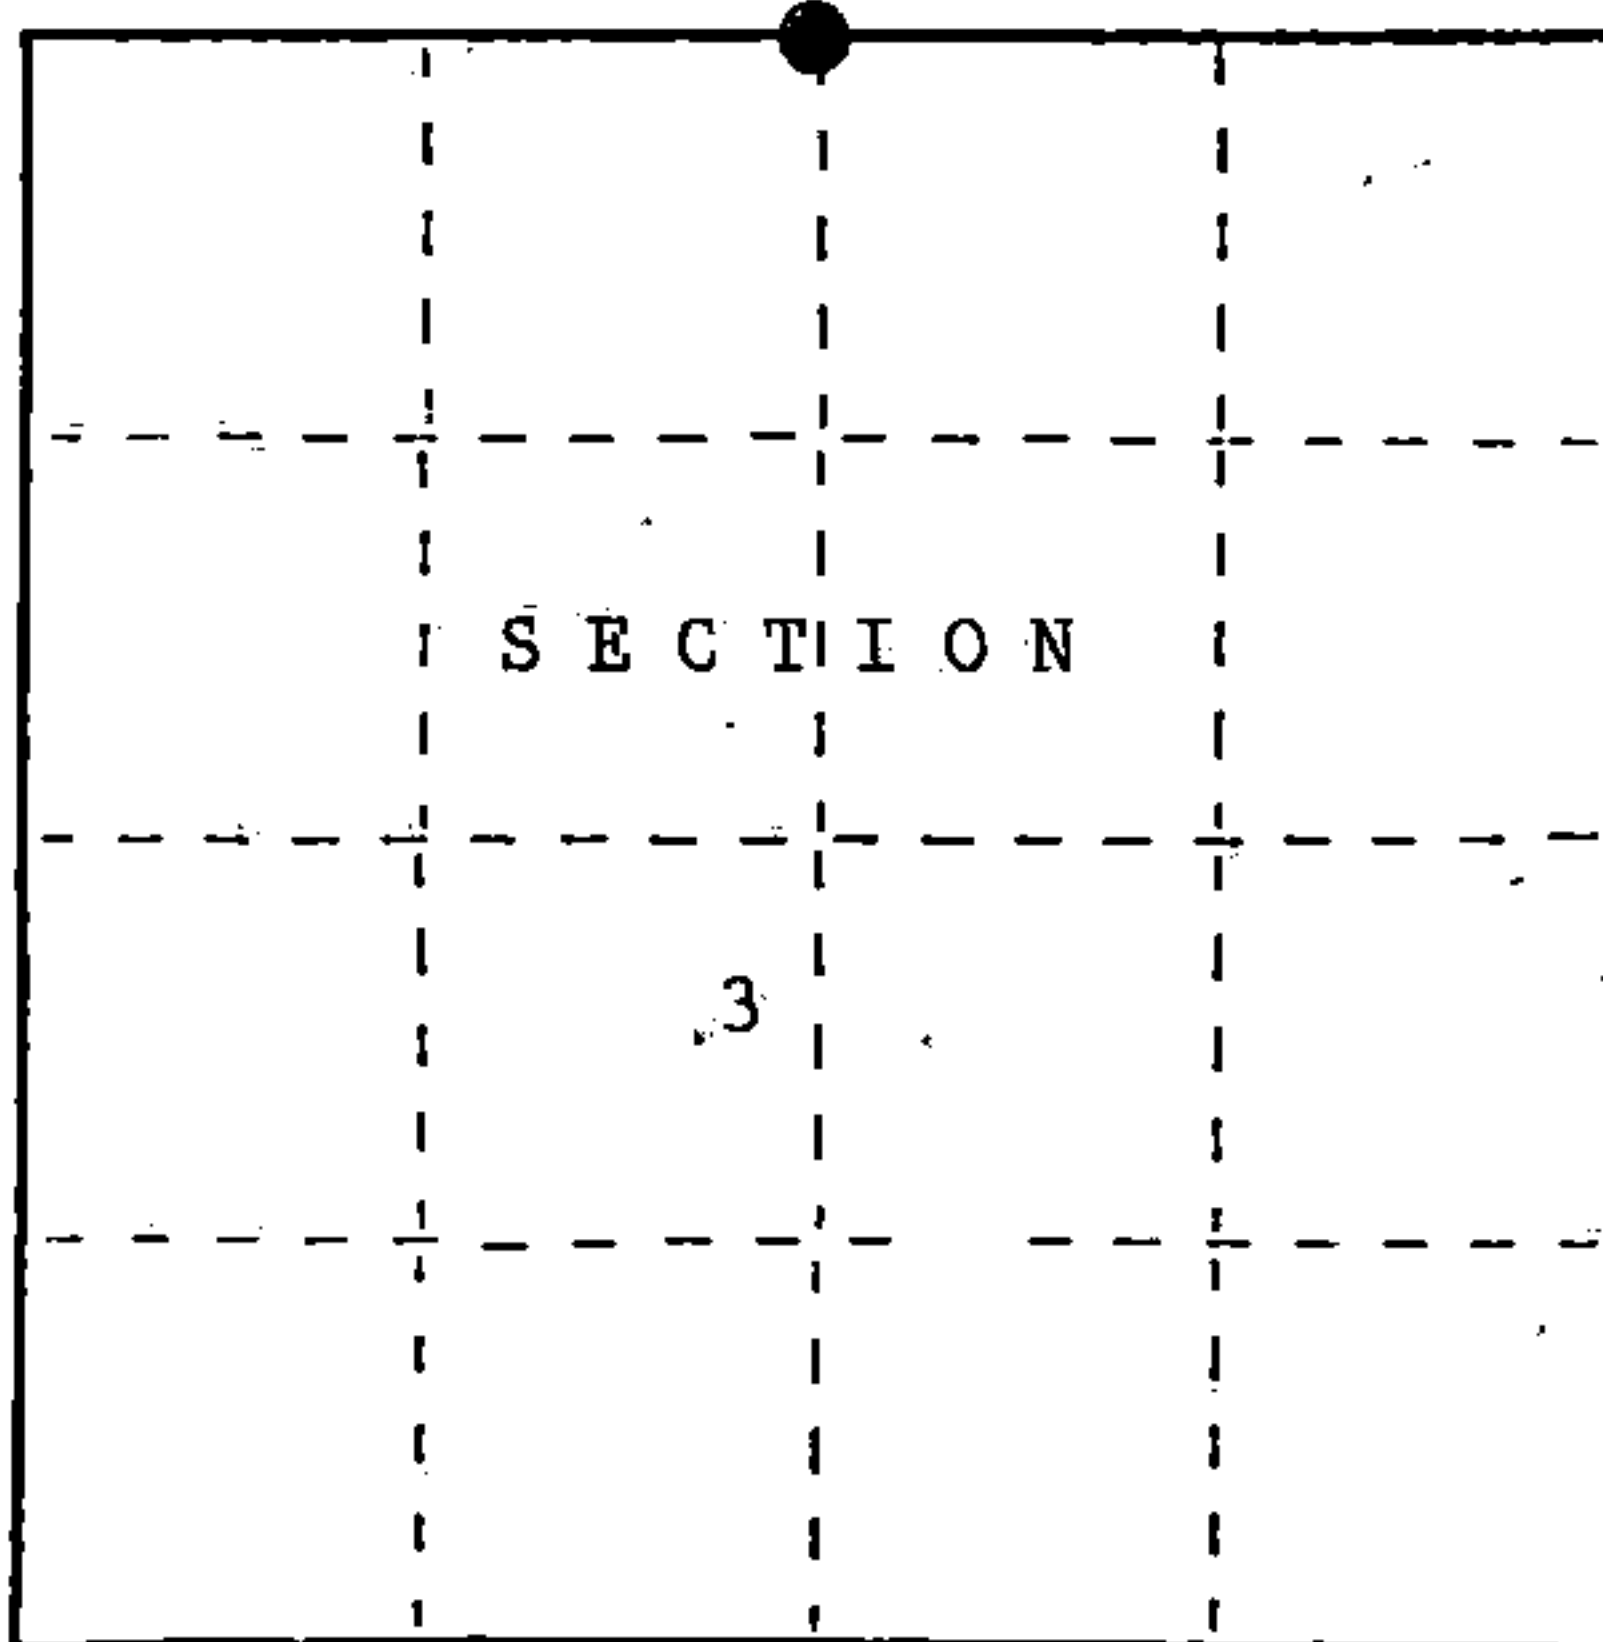

● = Corner monument restored.

History of original corner establishment:

In 1858, Alfred Millard set a wood post with the following corner references:  
Spruce 7" N54°W 4 lks. Spruce S37°E 23 lks.

Description of corner evidence found:

In 1937, GLO surveyors found no evidence of the original corner. Proportionate measurement. Set an iron post, in the marsh, for the witness to the 1/4 corner with a brass cap stamped to identify the location of the corner. Tamarack post alongside the iron post. No other accessories available.  
In 1989, John Schulke recovered monument in place.

Description of monument and accessories I established to perpetuate the original location of this corner.  
Set and tied steel sign post alongside the monument. No available ties in marsh.

Dated at Wabeno, Wis., this 25th day of October, 1989.

Signature John C Schulke Title Register Land Surveyor Registration No. S-1665  
(County Surveyor, Registered Land Surveyor, or other duly authorized official)

Office of Register of Deeds, County of Forest I hereby certify that the within instrument was filed in this office for record on the 8th day of March, 1990 at 1:00 o'clock P. M.

Paul Achenbrenner  
(Register of Deeds)

By \_\_\_\_\_ Deputy

FORM NO. 985-A

H.C. Miller Company

Stock No. 26273

DOCUMENT NUMBER

139248

A3812390820

(e) Describe any material discrepancy between the location of the corner as restored or reestablished and the location of that corner as previously restored or reestablished by distance and direction. Show the discrepancy on the plan view drawing under (d), above. Show the distances between the corner as previously restored or reestablished and (1) the corner as restored or reestablished, and (2) to at least 2 of the witness monuments shown on the drawing in (d), above.



No.

(f) Was the corner restored through acceptance of (1) an obliterated evidence location, or, (2) a found perpetuated location?

Neither

(g&h) Was the corner reestablished through lost corner proportionate methods? If so, show the method, including the directions and distances to other public land survey corners used as evidence or used for proportioning in determining the corner location?

No.

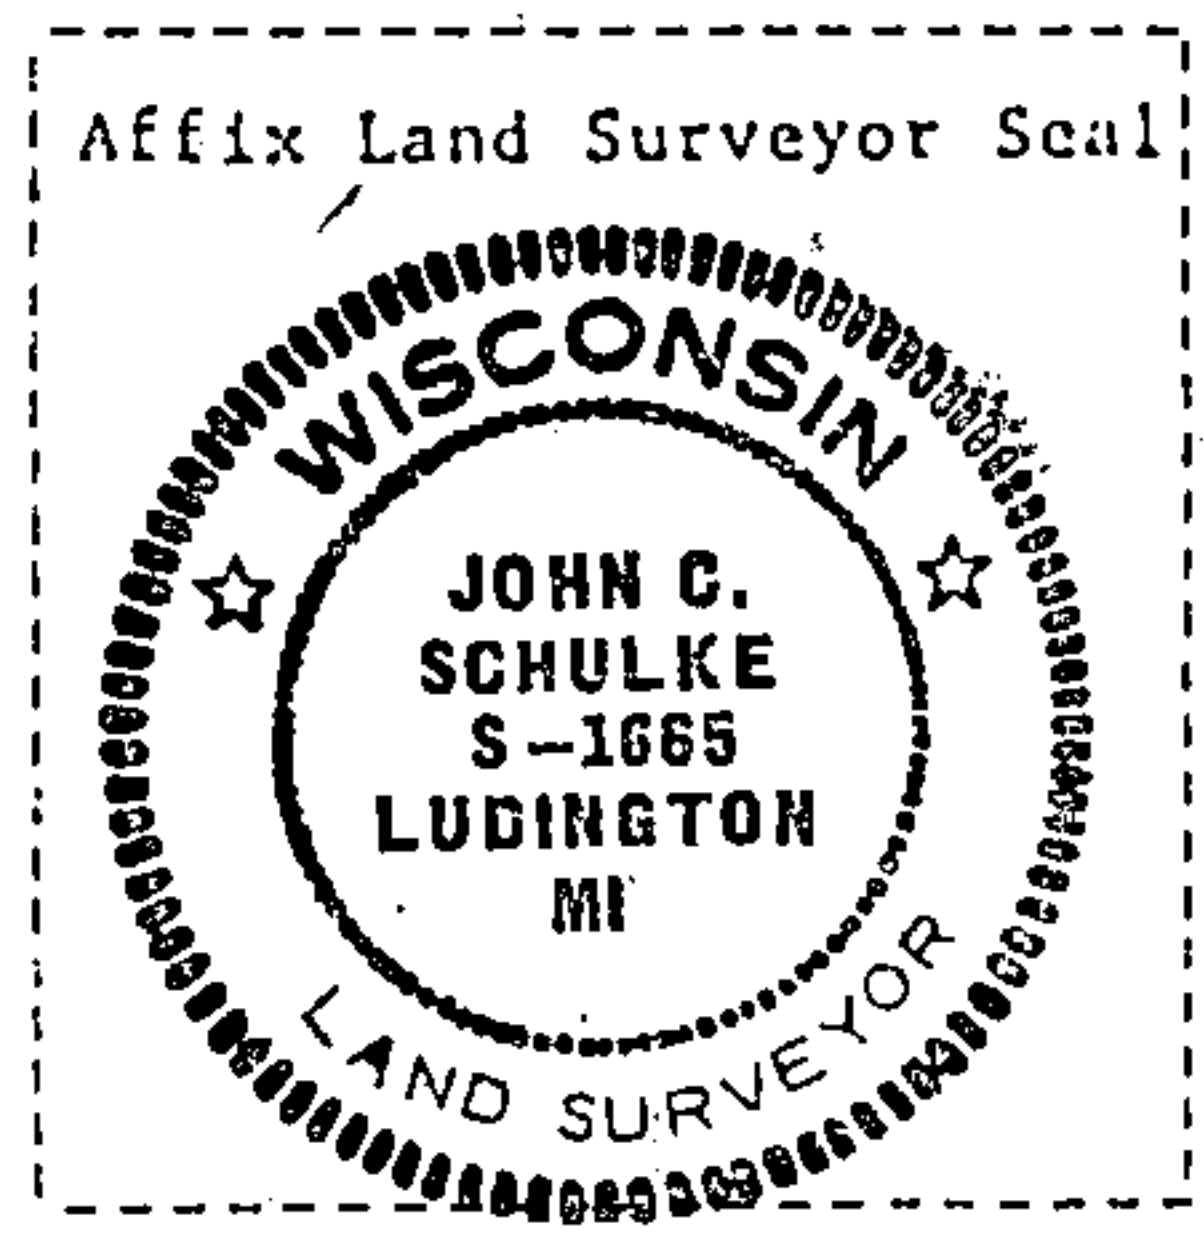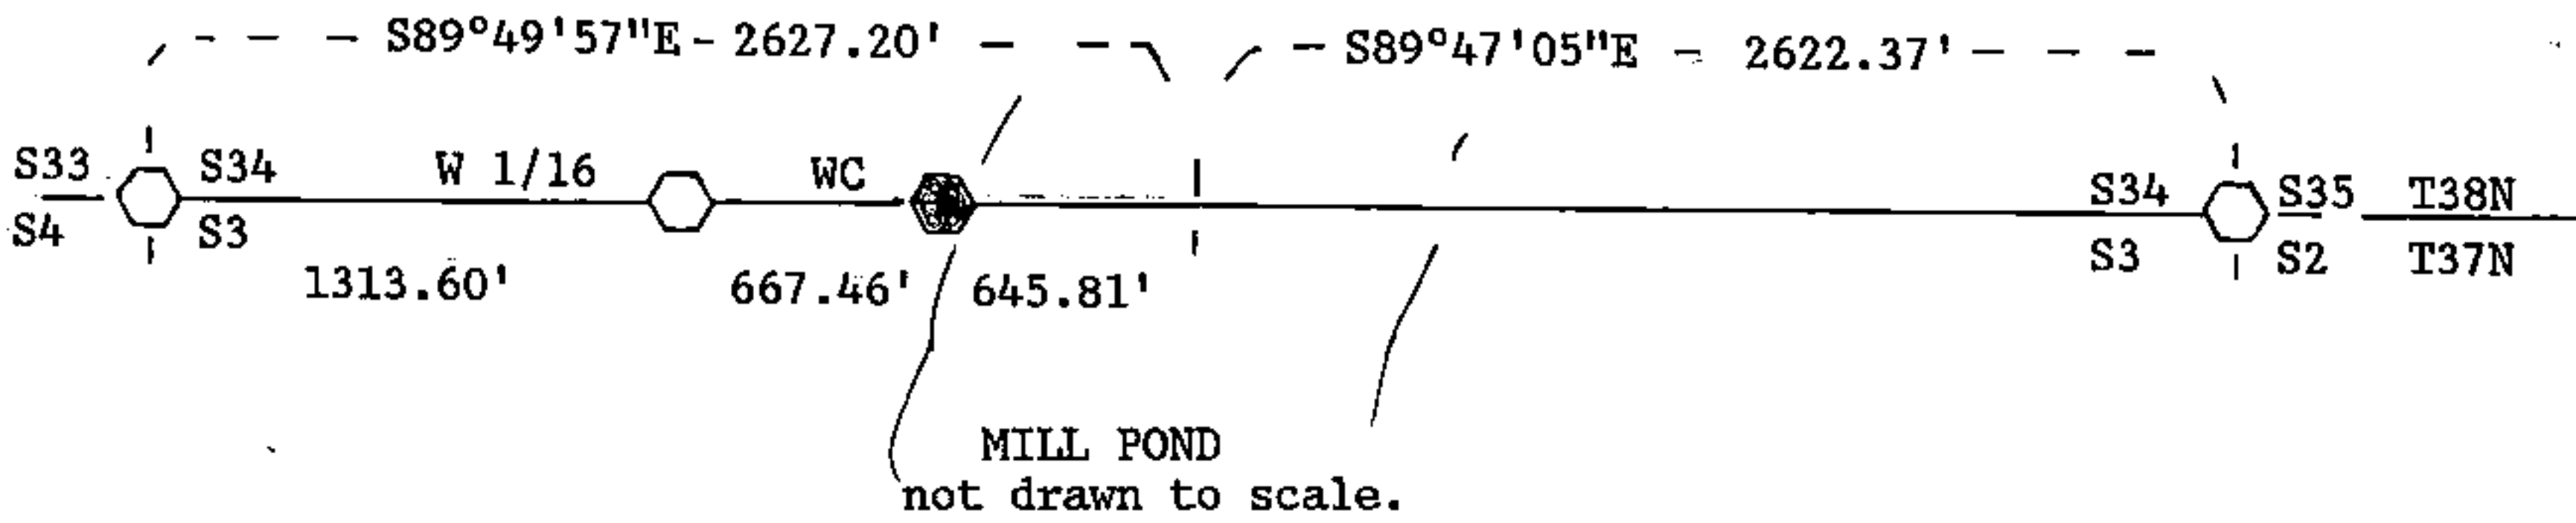

(i) I, John Schulke (RLS-1665) certify that the corner location shown on this record was determined by me or under my direction and control and that this U.S. Public Land Survey Monument Record is correct and complete to the best of my knowledge and belief.

John C. Schulke Signature Oct 25, 1989 Date

Survey requested by: Dale S. Stage District Ranger 1989 Date