

U.S. PUBLIC LAND SURVEY MONUMENT RECORD

Index No. A-19

State of Wisconsin }
 County of FOREST } ss.


I, John Schulke, do hereby
 certify that on the 24th day
 of July, 1989, I found
 evidence of the North Quarter
 corner of Section 2
 Township 37, North, Range
12 East, Fourth Principal Meridian,
 as described hereon; and that from this evidence
 I established a new monument and accessories
 as described hereon to perpetuate the original
 location of this corner.

Resident witnesses:

.....

.....

.....

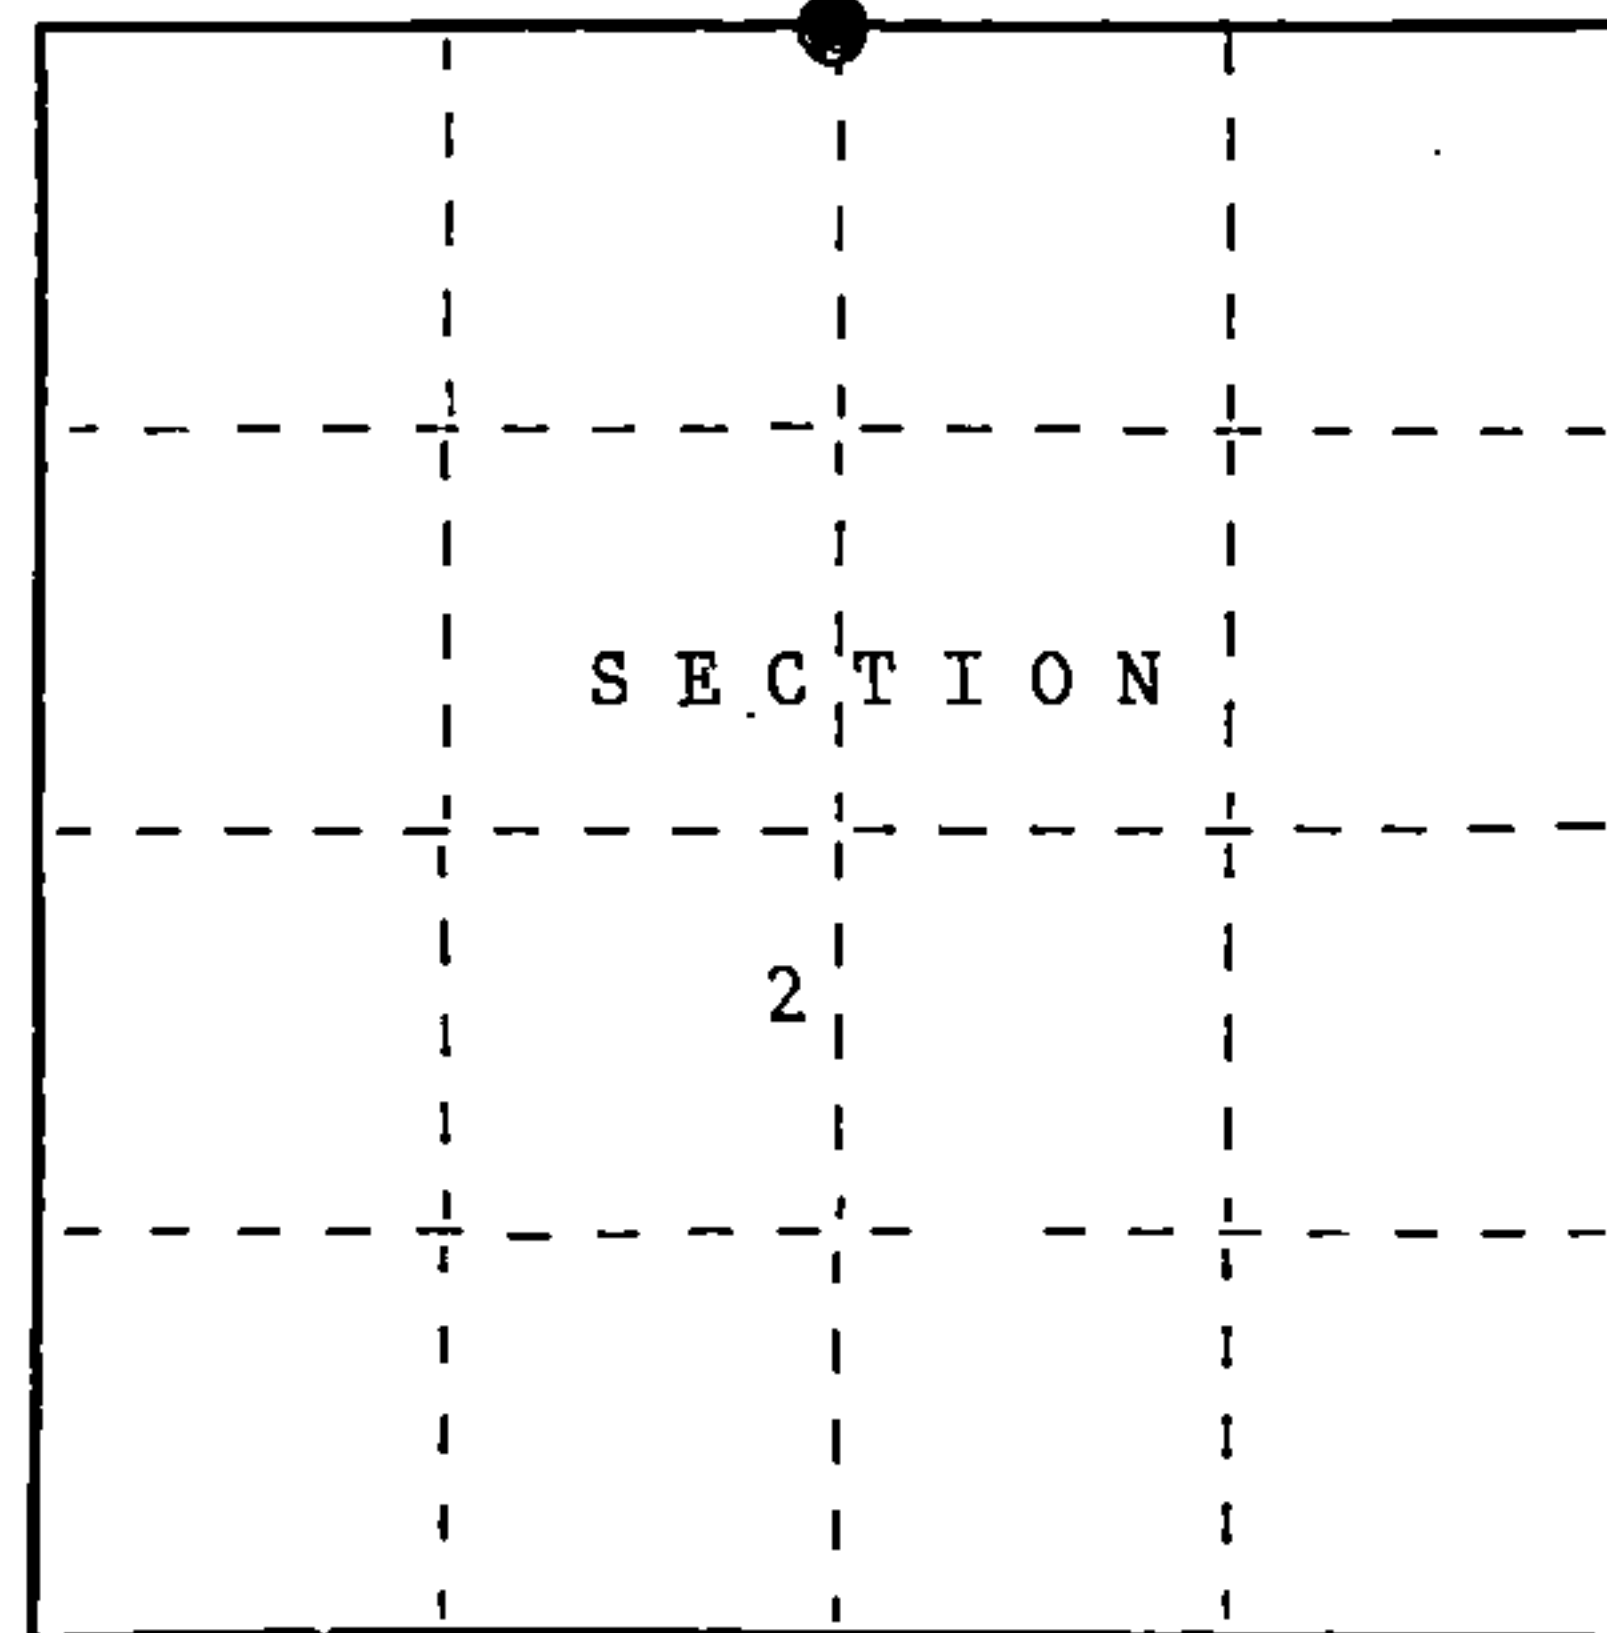

● = Corner monument restored.

History of original corner establishment:

In 1858, Alfred Millard set a wood post with the following corner references:
 Sugar 14" N24°W 35 lks. Sugar 12" N80°E 27 lks.

Description of corner evidence found:

In 1937, GLO surveyors found no evidence of original corner. Proportionate measurement.
 Set an iron post with a brass cap stamped to identify the corner. The following
 corner references: Maple 7" N46½°E 6 lks.
 Maple 12" S44°W 13 lks.

In 1989, John Schulke recovered monument in place with the following corner references:
 Maple 13" S43°W 8.59 ft.
 stump hole N56°E 3.6 ft.

Monument in a mound of stones.

Description of monument and accessories I established to perpetuate the original location of this corner.

Set a steel sign post 1.6 feet Northwest of the monument. Blazed, scribed, tagged
 and painted the following new corner references:

Maple 10" N07°W 9.21 ft.
 Maple 14" S69°E 41.76 ft.
 Maple 9" S87°W 60.62 ft.

Dated at Waubaesa, Wis., this 25th day of October, 1989

Signature John C. Schulke Title Register Land Surveyor Registration No. S-1665
 (County Surveyor, Registered Land Surveyor, or other duly authorized official)

Office of Register of Deeds, County of Forest, I hereby certify that the within
 instrument was filed in this office for record on the 8th day of March, 1990
 at 1:00 o'clock P. M.

Paul Achalroner
 (Register of Deeds)

By _____ Deputy

FORM NO. 985-A

HC Miller Company
 Surveyors' Edition

Stock No. 26273

DOCUMENT NUMBER

139244

43812350020

e) Describe any material discrepancy between the location of the corner as restored or reestablished and the location of that corner as previously restored or reestablished by distance and direction. Show the discrepancy on the plan view drawing under (d), above. Show the distances between the corner as previously restored or reestablished and (1) the corner as restored or reestablished, and (2) to at least 2 of the witness monuments shown on the drawing in (d), above.

No.

(f) Was the corner restored through acceptance of (1) an obliterated evidence location, or, (2) a found perpetuated location?


Neither

(g&h) Was the corner reestablished through lost corner proportionate methods? If so, show the method, including the directions and distances to other public land survey corners used as evidence or used for proportioning in determining the corner location?

No.


QUARTER CORNER

S35	T38N
S2	T37N

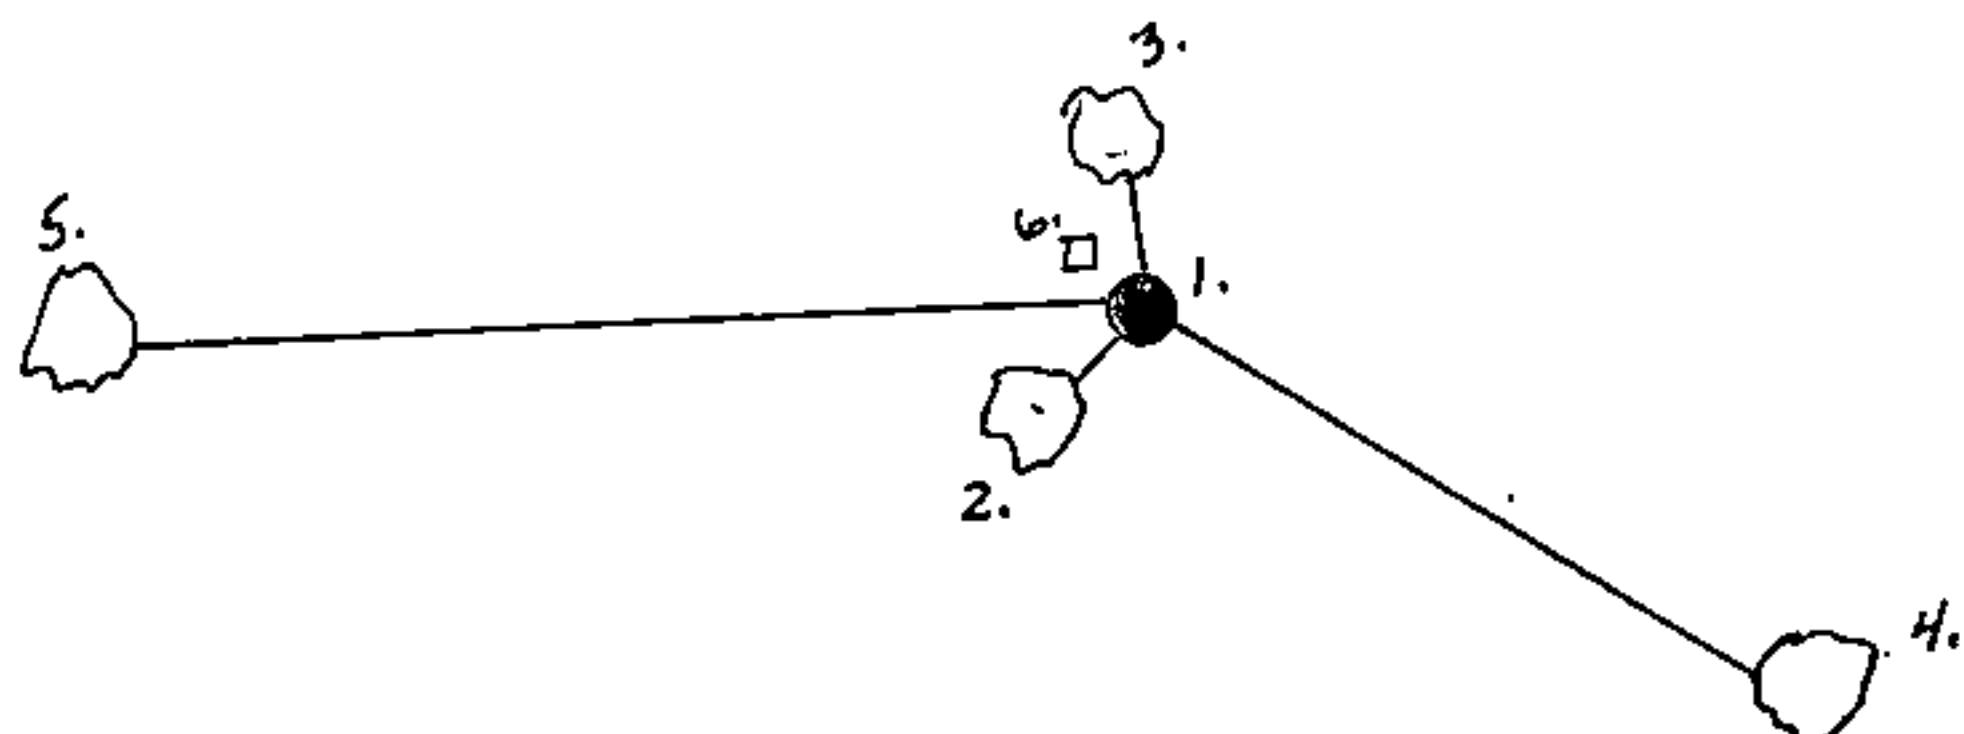

- | | | | |
|--------------------|-----|-------|-----------|
| 1. Monument. | | | |
| 2. Maple | 13" | S43°W | 8.59 ft. |
| 3. Maple | 10" | N07°W | 9.21 ft. |
| 4. Maple | 14" | S69°E | 41.76 ft. |
| 5. Maple | 9" | S87°W | 60.62 ft. |
| 6. Steel sign post | | NW | 1.6 ft. |

Affix Land Surveyor Seal

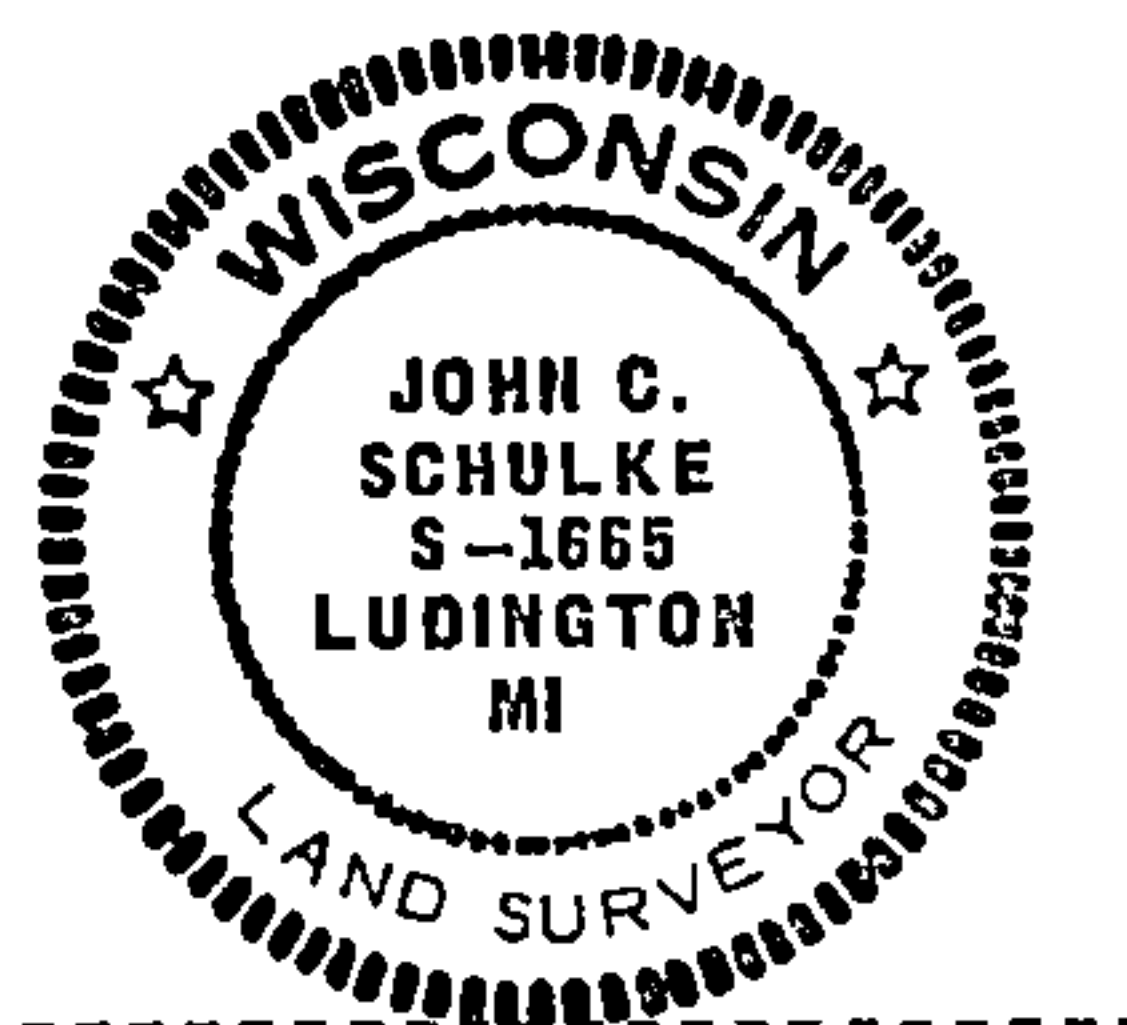

(i) I, John Schulke (RLS-1665)
(type or print name) certify that the corner location shown on this record was determined by me or under my direction and control and that this U.S. Public Land Survey Monument Record is correct and complete to the best of my knowledge and belief.

John C. Schulke Oct. 25th, 1989
Signature Date

Survey requested by: Dale S. Stange 1989
District Ranger Date