

CERTIFIED LAND CORNER RESTORATION

State of Wisconsin }
County of Forest } ss.

I Jean F. Resvick, do hereby certify that on the 15th day of June, 1971, I found evidence of the Southwest Section corner of Section 6 Township 38 North, Range 14 East, Fourth Principal Meridian, as described hereon; and that from this evidence I established a new monument and accessories as described hereon to perpetuate the original location of this corner:

Description of original monument and accessories and subsequent restorations:


- 80 chains North between Sections 7 and 17
- Set post.
- Yellow Birch 8, N58W, 17 lks.
- Yellow Birch 9, N28E, 19 lks.
- Yellow Birch 22, S35E, 35 lks.
- Yellow Birch 10, S22W, 17 lks.

Description of corner evidence found:

- Post in mound of rock.
- From a point N46W, 6 lks. from post in mound of rock
- Yellow Birch 15, bears N28E, 19 lks.
- Yellow Birch stump bears S35E, 35 lks.
- Yellow Birch 19, dead, bears N58W, 17 lks.

Description of monument and accessories I established to perpetuate the original location of this corner:


At the recorded distances from the original bearing trees set a 2 inch inside diameter galvanized iron pipe 5 feet long, filled with concrete, flanged at bottom with brass cap stamped.

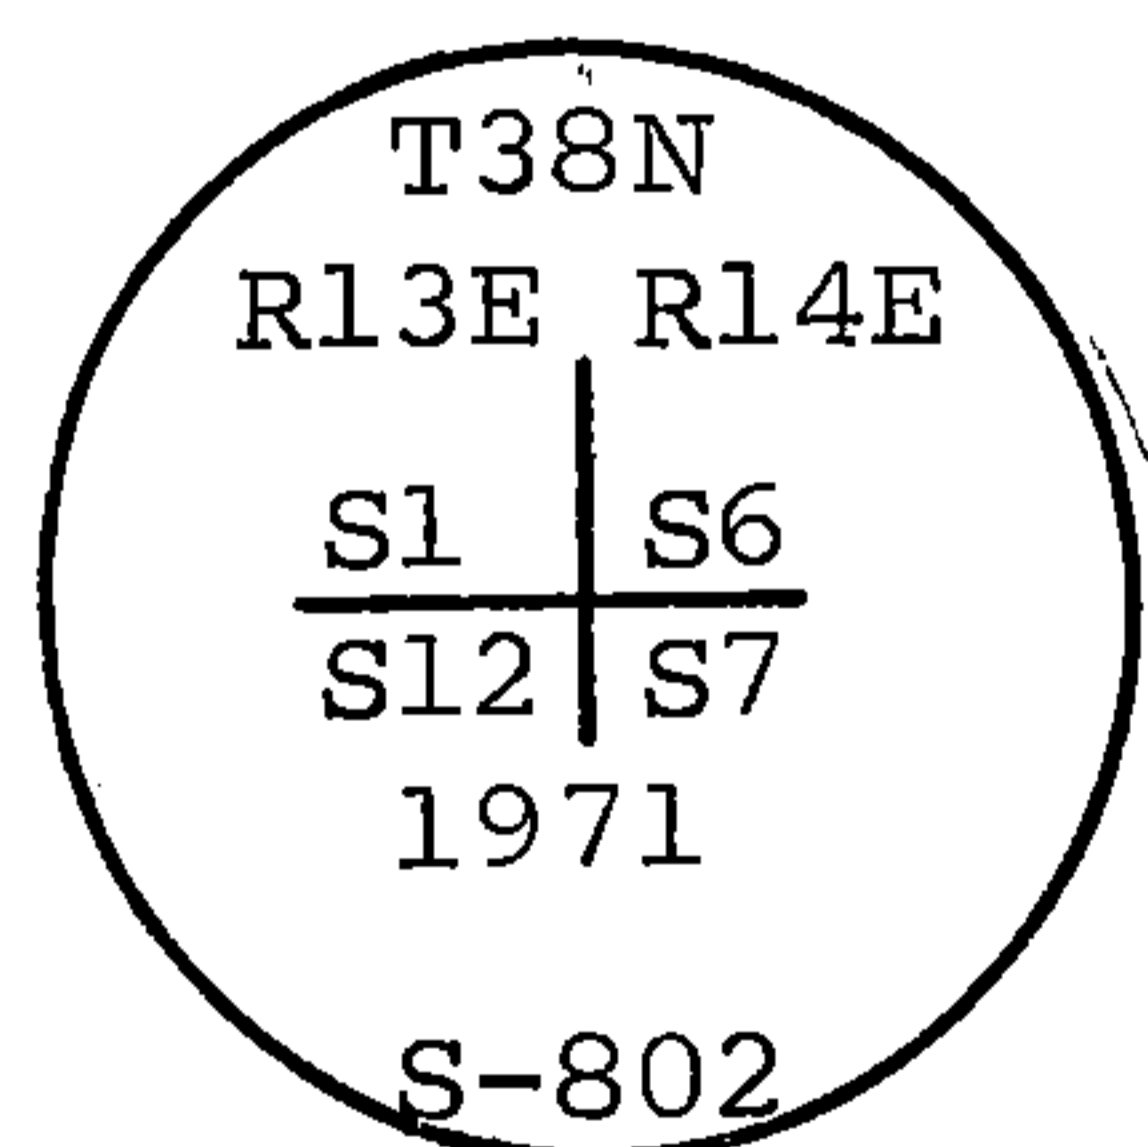

Blazed and scribed the following new bearing trees:

- Maple 5, N15E, 30.77 feet
- Maple 5, S70E, 10.49 feet
- Maple 7, S37W, 13.70 feet
- Maple 4, N40W, 33.09 feet

Set steel post with signs SW, 1 foot from monument

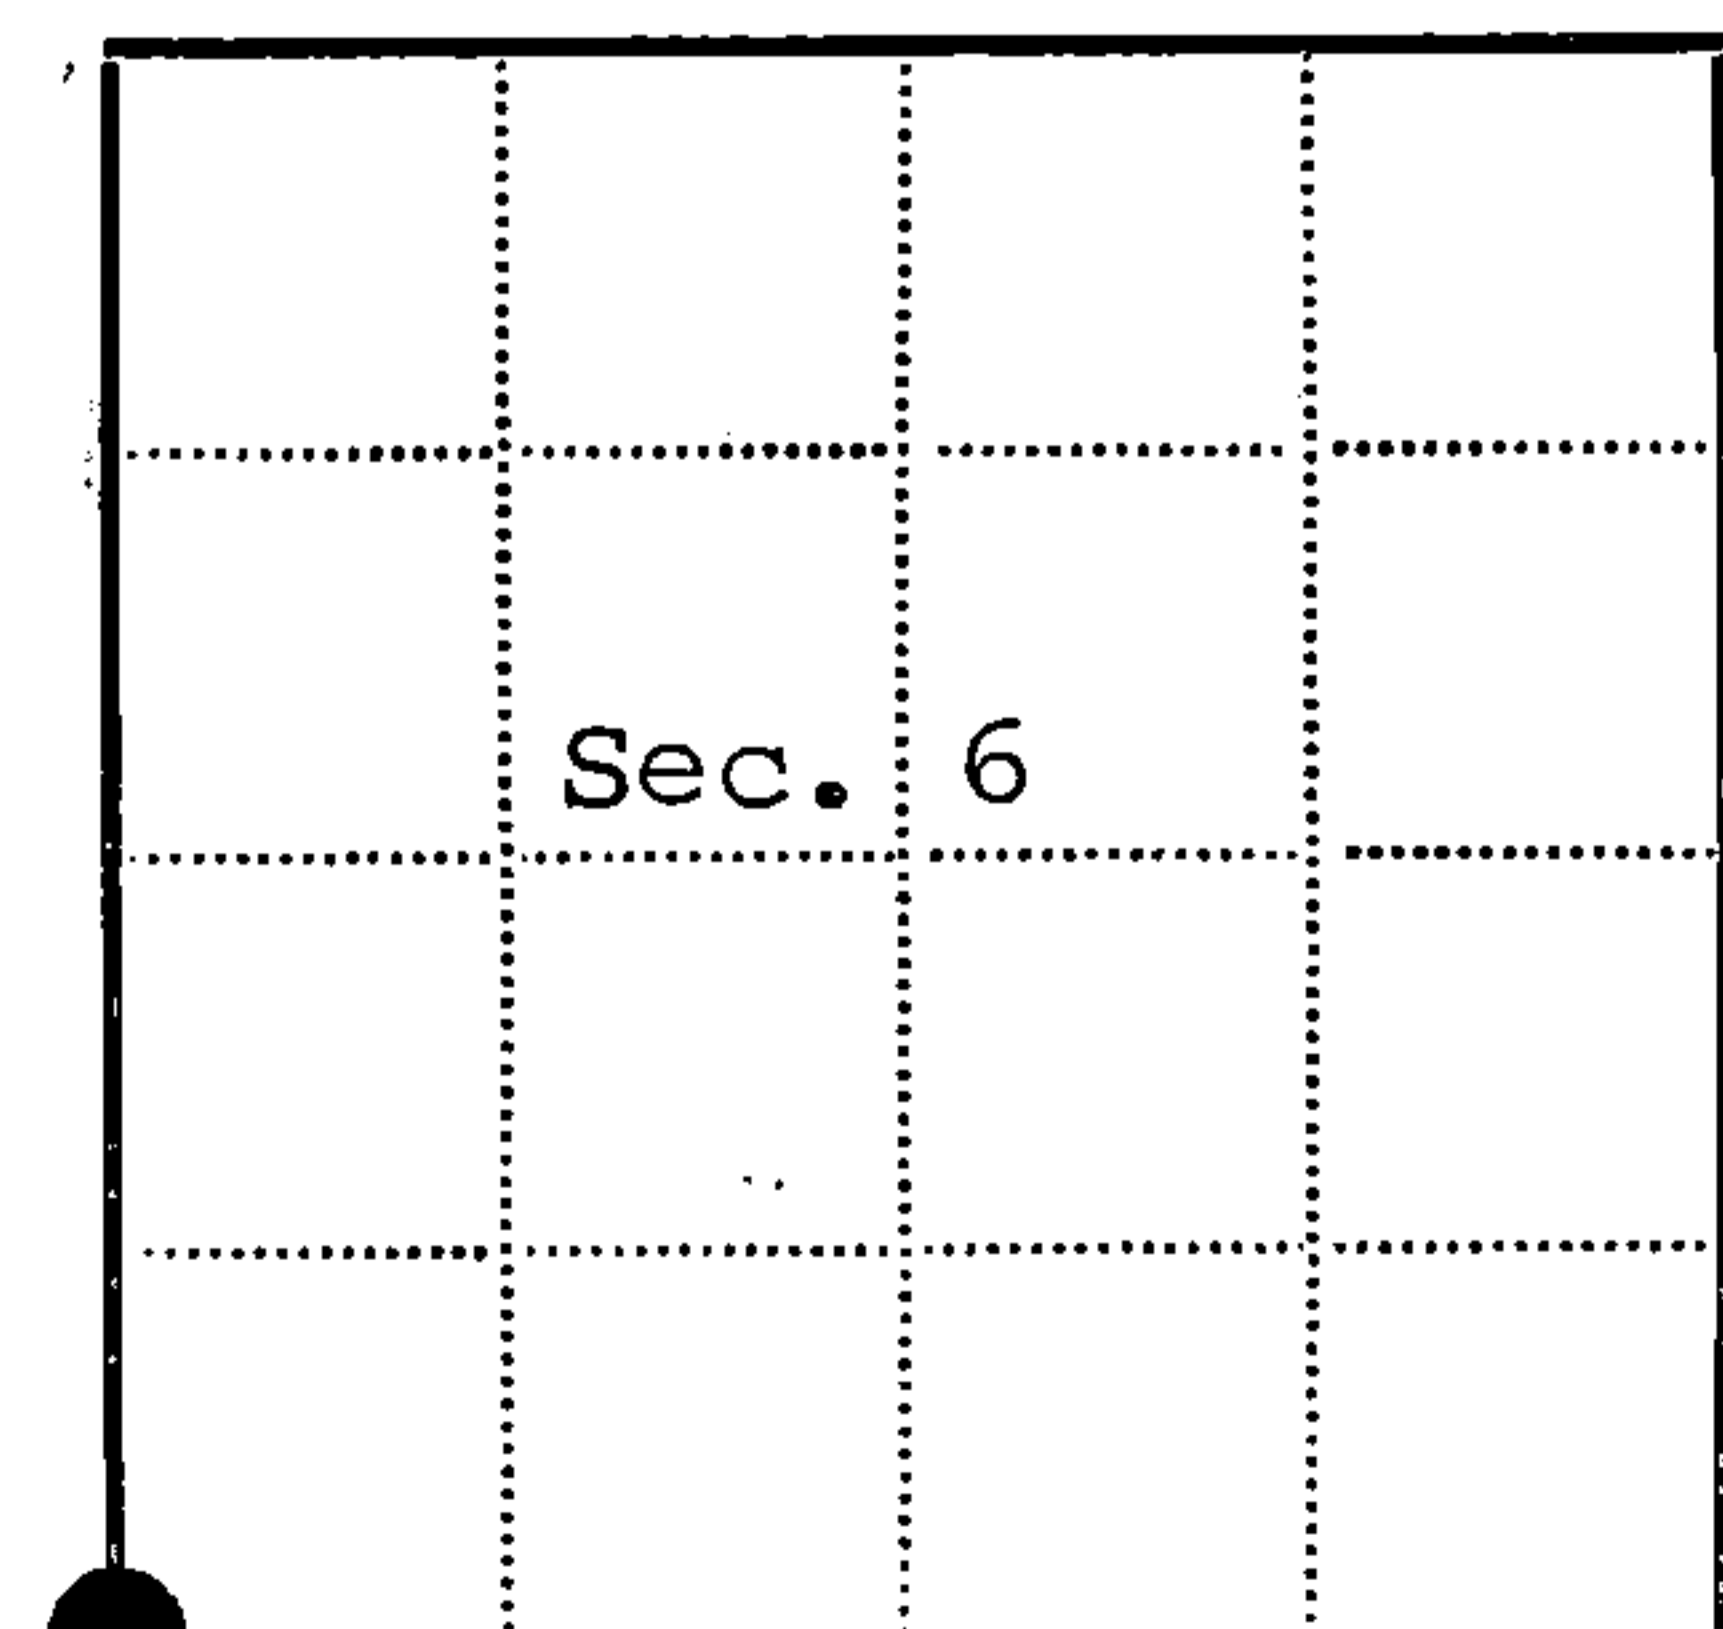

● = Corner monument restored
□ =

Resident witnesses.....

Dated at Rhinelander Wisconsin, this 15th day of June, 1971.

Signature Jean F. Resvick Title Land Surveyor
(County Surveyor, Registered Land Surveyor, or other duly authorized official)

Surveyors Registration No. S-802 DOCUMENT NUMBER 100183

Office of Register of Deeds County of Forest

I hereby certify that the within instrument was filed in this office for record on the 5th day of August, 1971, and was filed in Book No. Page No. of County Records.

Signature Eugene Staszewski Title Register of Deeds

Township 38 North, Range 14 East, Section 6, Index No. E-1, Page No.



E
7

U.S. PUBLIC LAND SURVEY MONUMENT RECORD

Index No. E-25

State of Wisconsin } ss.
County of Forest

I, William B. Cochran, do hereby certify that on the 30th day of March, 1993, I found evidence of the Southeast Section corner of Section 1 Township 38 North, Range 13 East, Fourth Principal Meridian, as described hereon; and that from this evidence I established a new monument and accessories as described hereon to perpetuate the original location of this corner.

Resident witnesses:

History of original corner establishment:

Original Government survey in 1858 by Alfred Millard.

North between sections 7 and 12, at 80 chains set Section corner post from which:

Y. Birch	8"	N58°W	17 lks
Y. Birch	9"	N28°E	19 lks
Y. Birch	22"	S35°E	35 lks
Y. Birch	10"	S22°W	17 lks

Description of corner evidence found:

On 6/15/71 Jean Resvick found Y. Birch 15" N28°E 19 lks, Y. Birch stump S35°E, 35 lks, Y. Birch 19" N58°W 17 lks, wood post in mound of rock.


From original evidence, set a 2 1/2" X 60" galvanized iron pipe monument with brass cap stamped: T38N, R13E, R14E, S1, S6, S12, S7, 1971, S-802. From which the following bear:

Maple	5"	N15°E	30.77 feet
Maple	5"	S70°E	10.49 feet
Maple	7"	S37°W	13.70 feet
Maple	4"	N40°W	33.09 feet
Steel sign post		Southwest	1.00 feet

Description of monument and accessories I established to perpetuate the original location of this corner.

Found monument as described and in place.

Maple	6"	N15°E	30.77 feet
Maple	6"	S70°E	10.49 feet
Maple	12"	S37°W	13.70 feet
Maple	5"	N40°W	33.09 feet
steel sign post		Southwest	1.00 feet

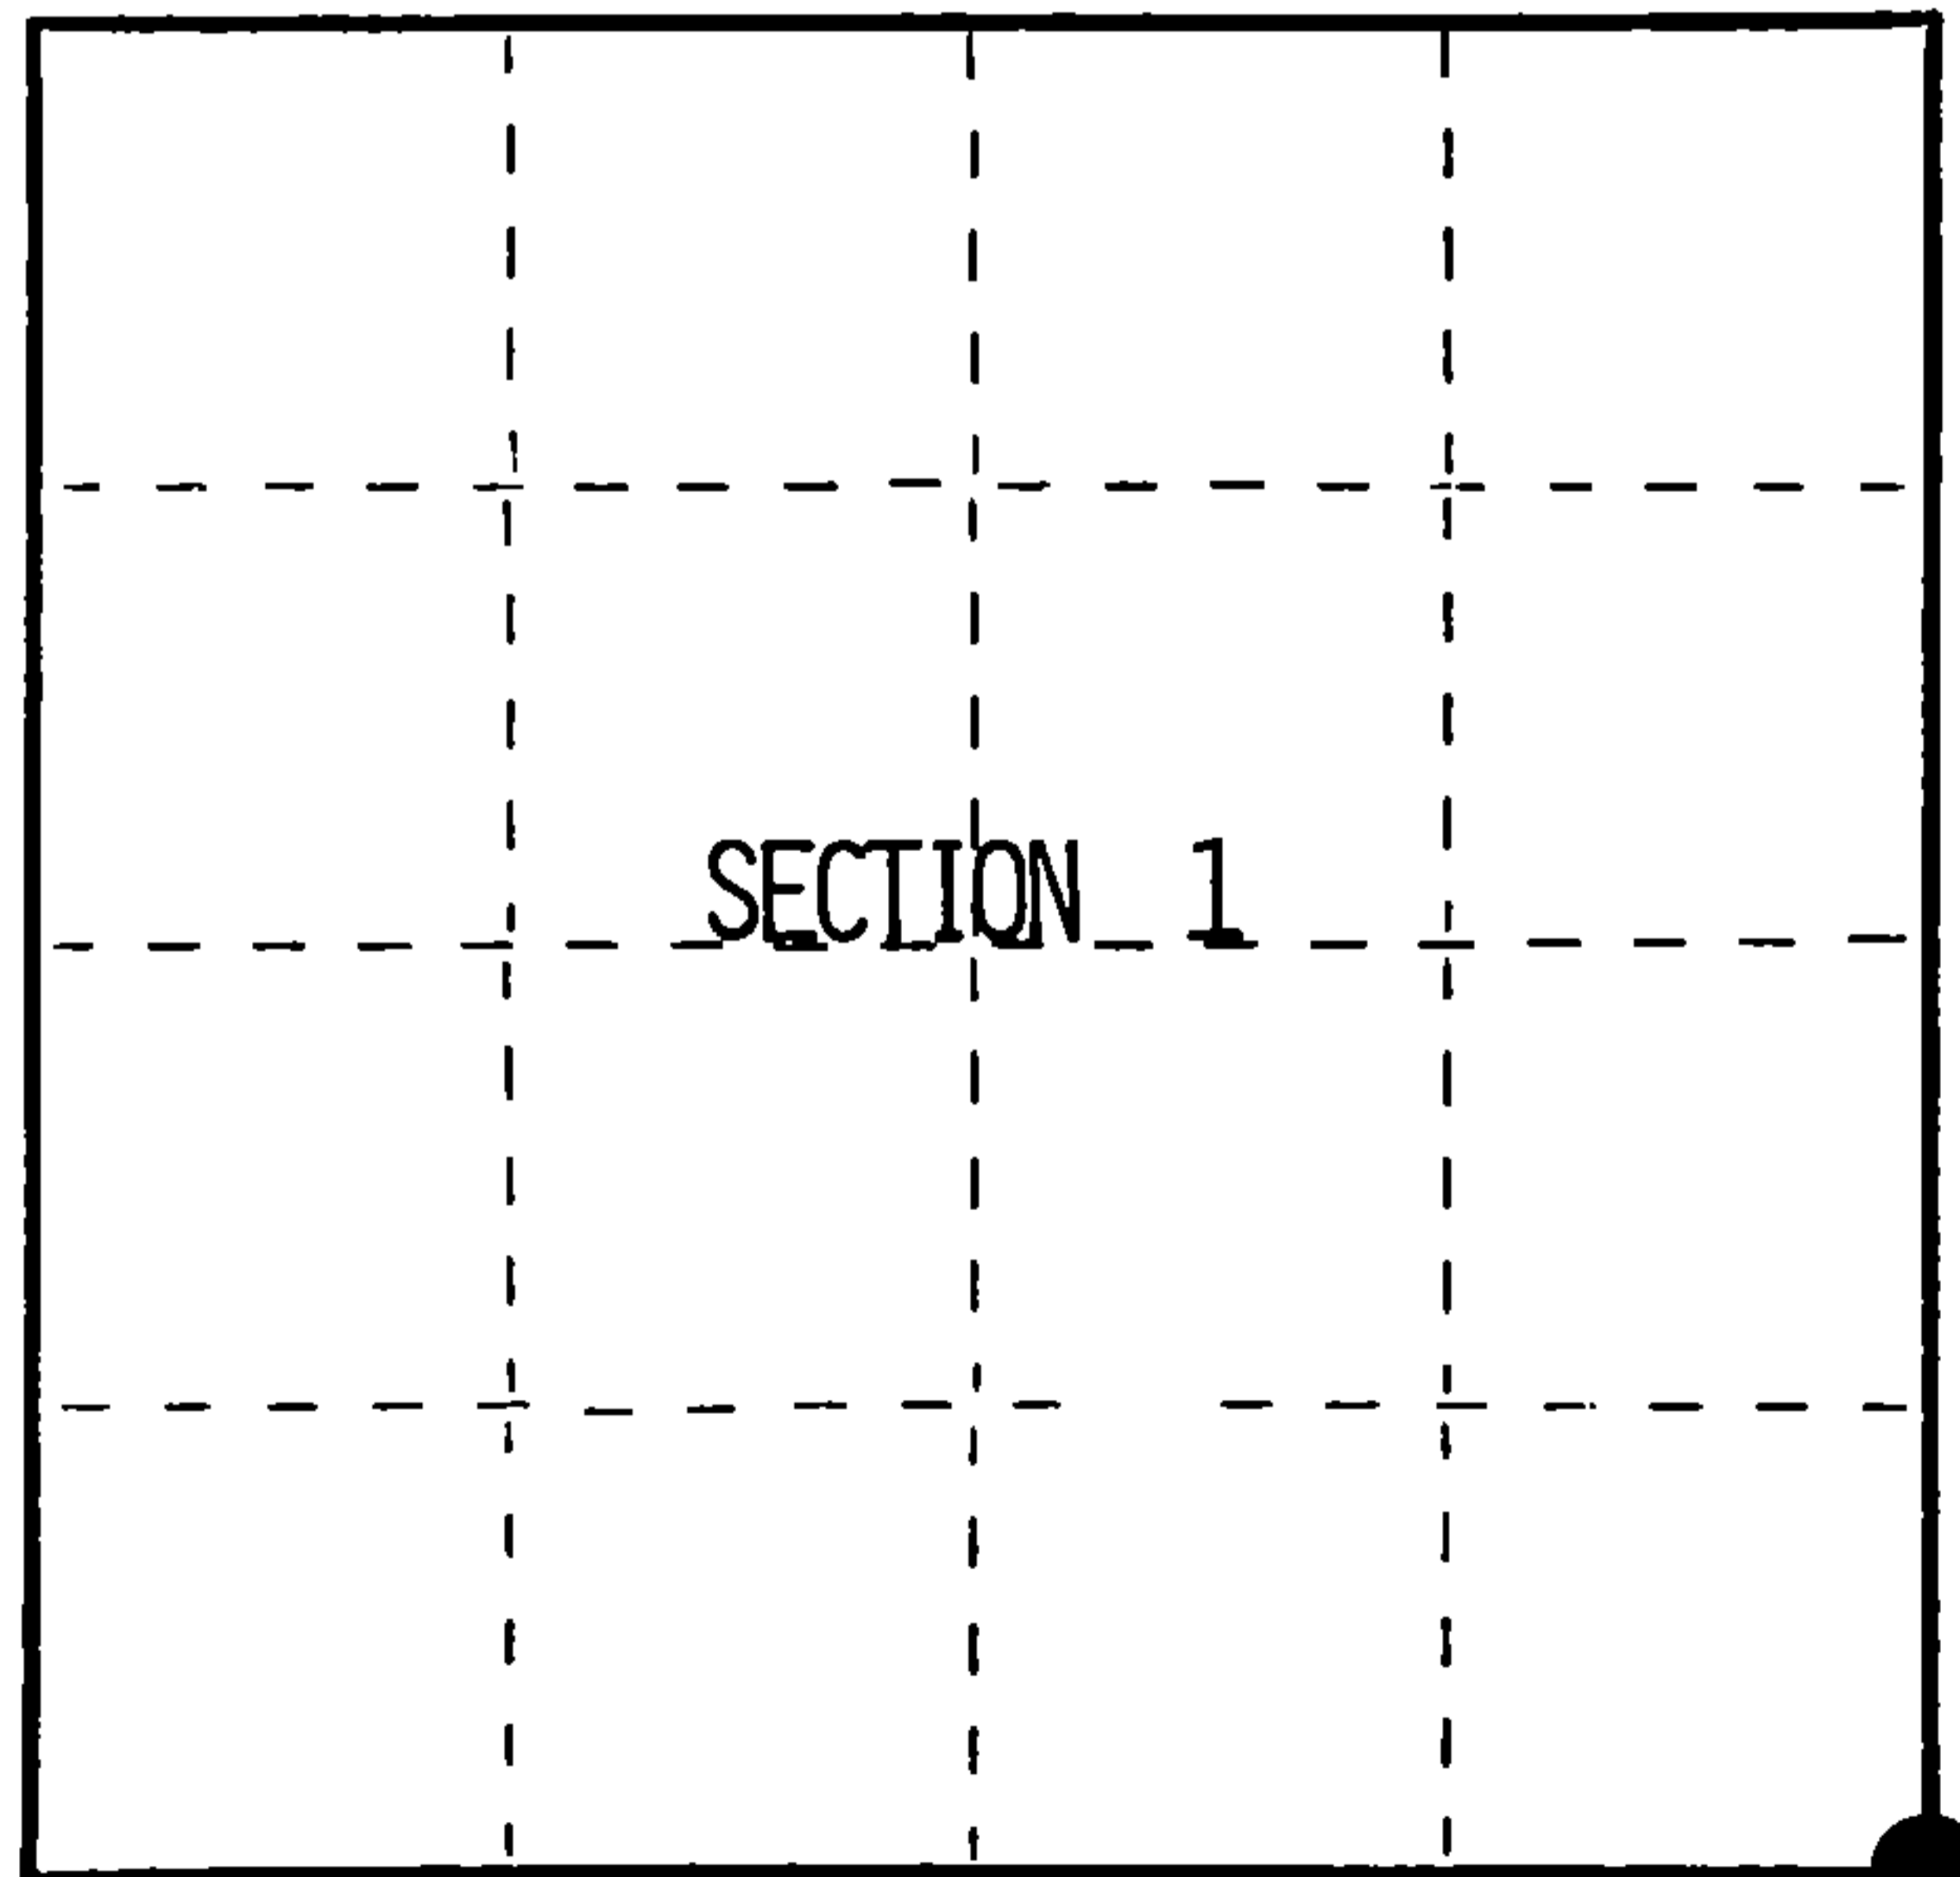

○ = Corner monument restored.

Dated at Hiles, Wis., this 4th day of January, 1995.

Signature: William B. Cochran, Land Surveyor, Registration No. S-1107.
(County Surveyor, Registered Land Surveyor, or other duly authorized official)

Office of Register of Deeds, County of Forest, I hereby certify that the within instrument was filed in this office for record on the 23rd day of August, 1996 at 2:30 o'clock P.M.

(Register of Deeds)

By: [Signature] Deputy

FORM NO. 985-A

H.C. Miller Company

Stock No. 26273

156555

43813010000



(e) Describe any material discrepancy between the location of the corner as restored or reestablished and the location of that corner as previously restored or reestablished by distance and direction. Show the discrepancy on the plan view drawing under (d), above. Show the distances between the corner as previously restored or reestablished and (1) the corner as restored or reestablished, and (2) to at least 2 of the witness monuments shown on the drawing in (d), above.

See drawin belōw.

(f) Was the corner restored through acceptance of (1) an obliterated evidence location, or, (2) a found perpetuated location?

Corner restored from recovered original evidence.

(g&h) Was the corner reestablished through lost corner proportionate methods? If so, show the method, including the directions and distances to other public land survey corners used as evidence or used for proportioning in determining the corner location?

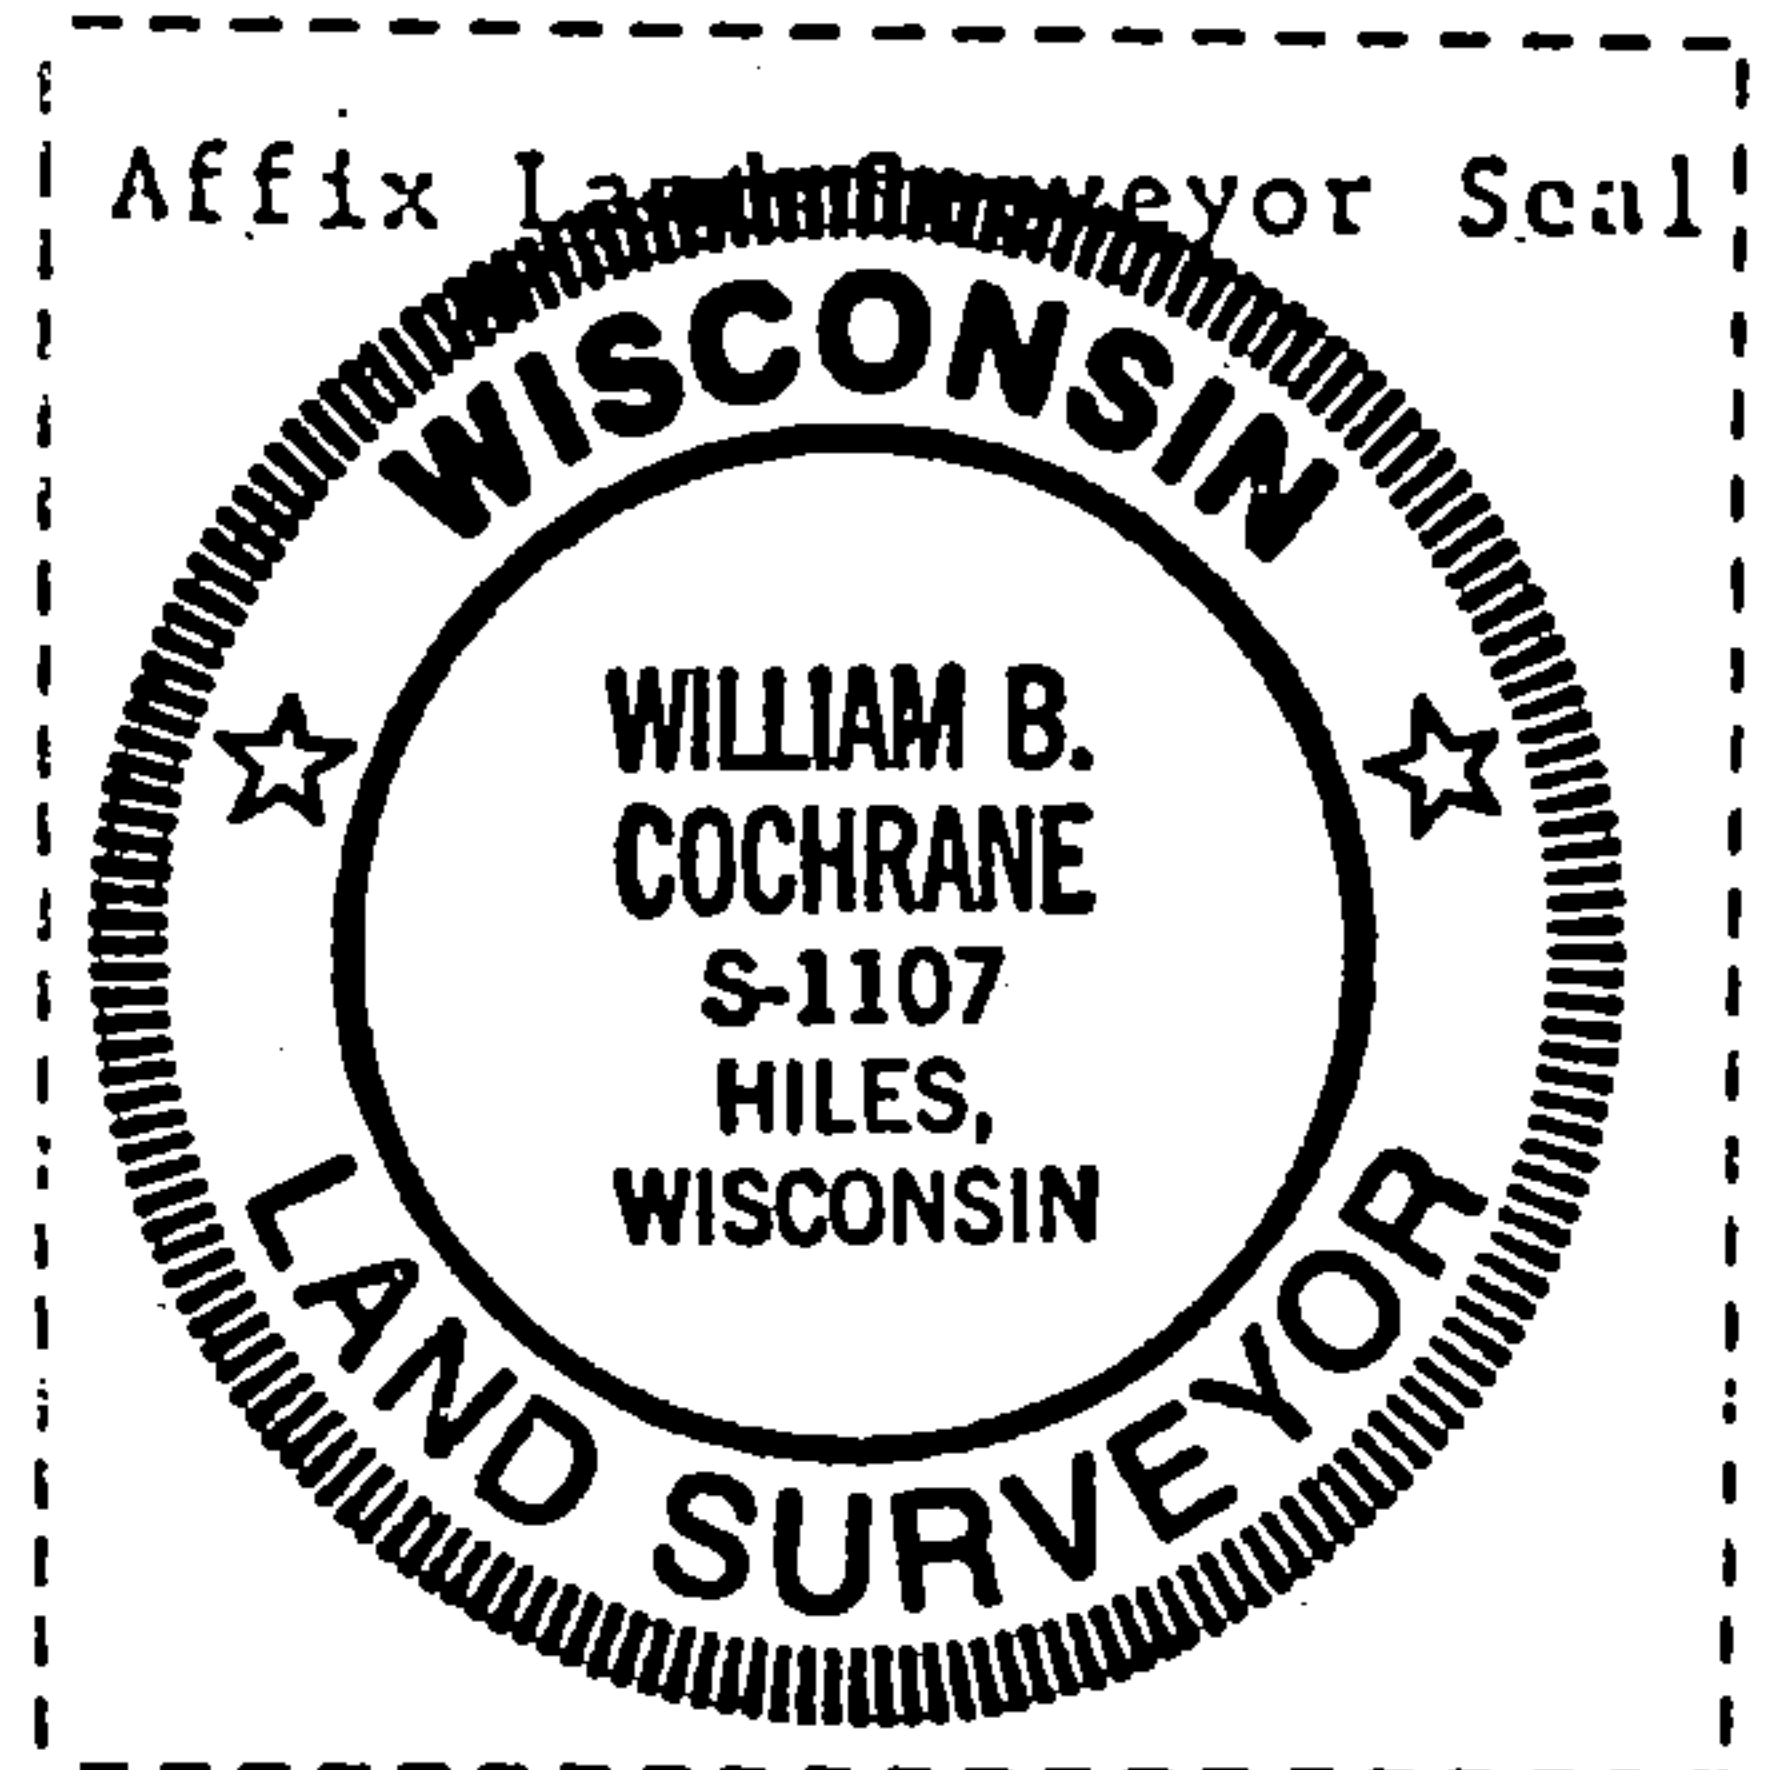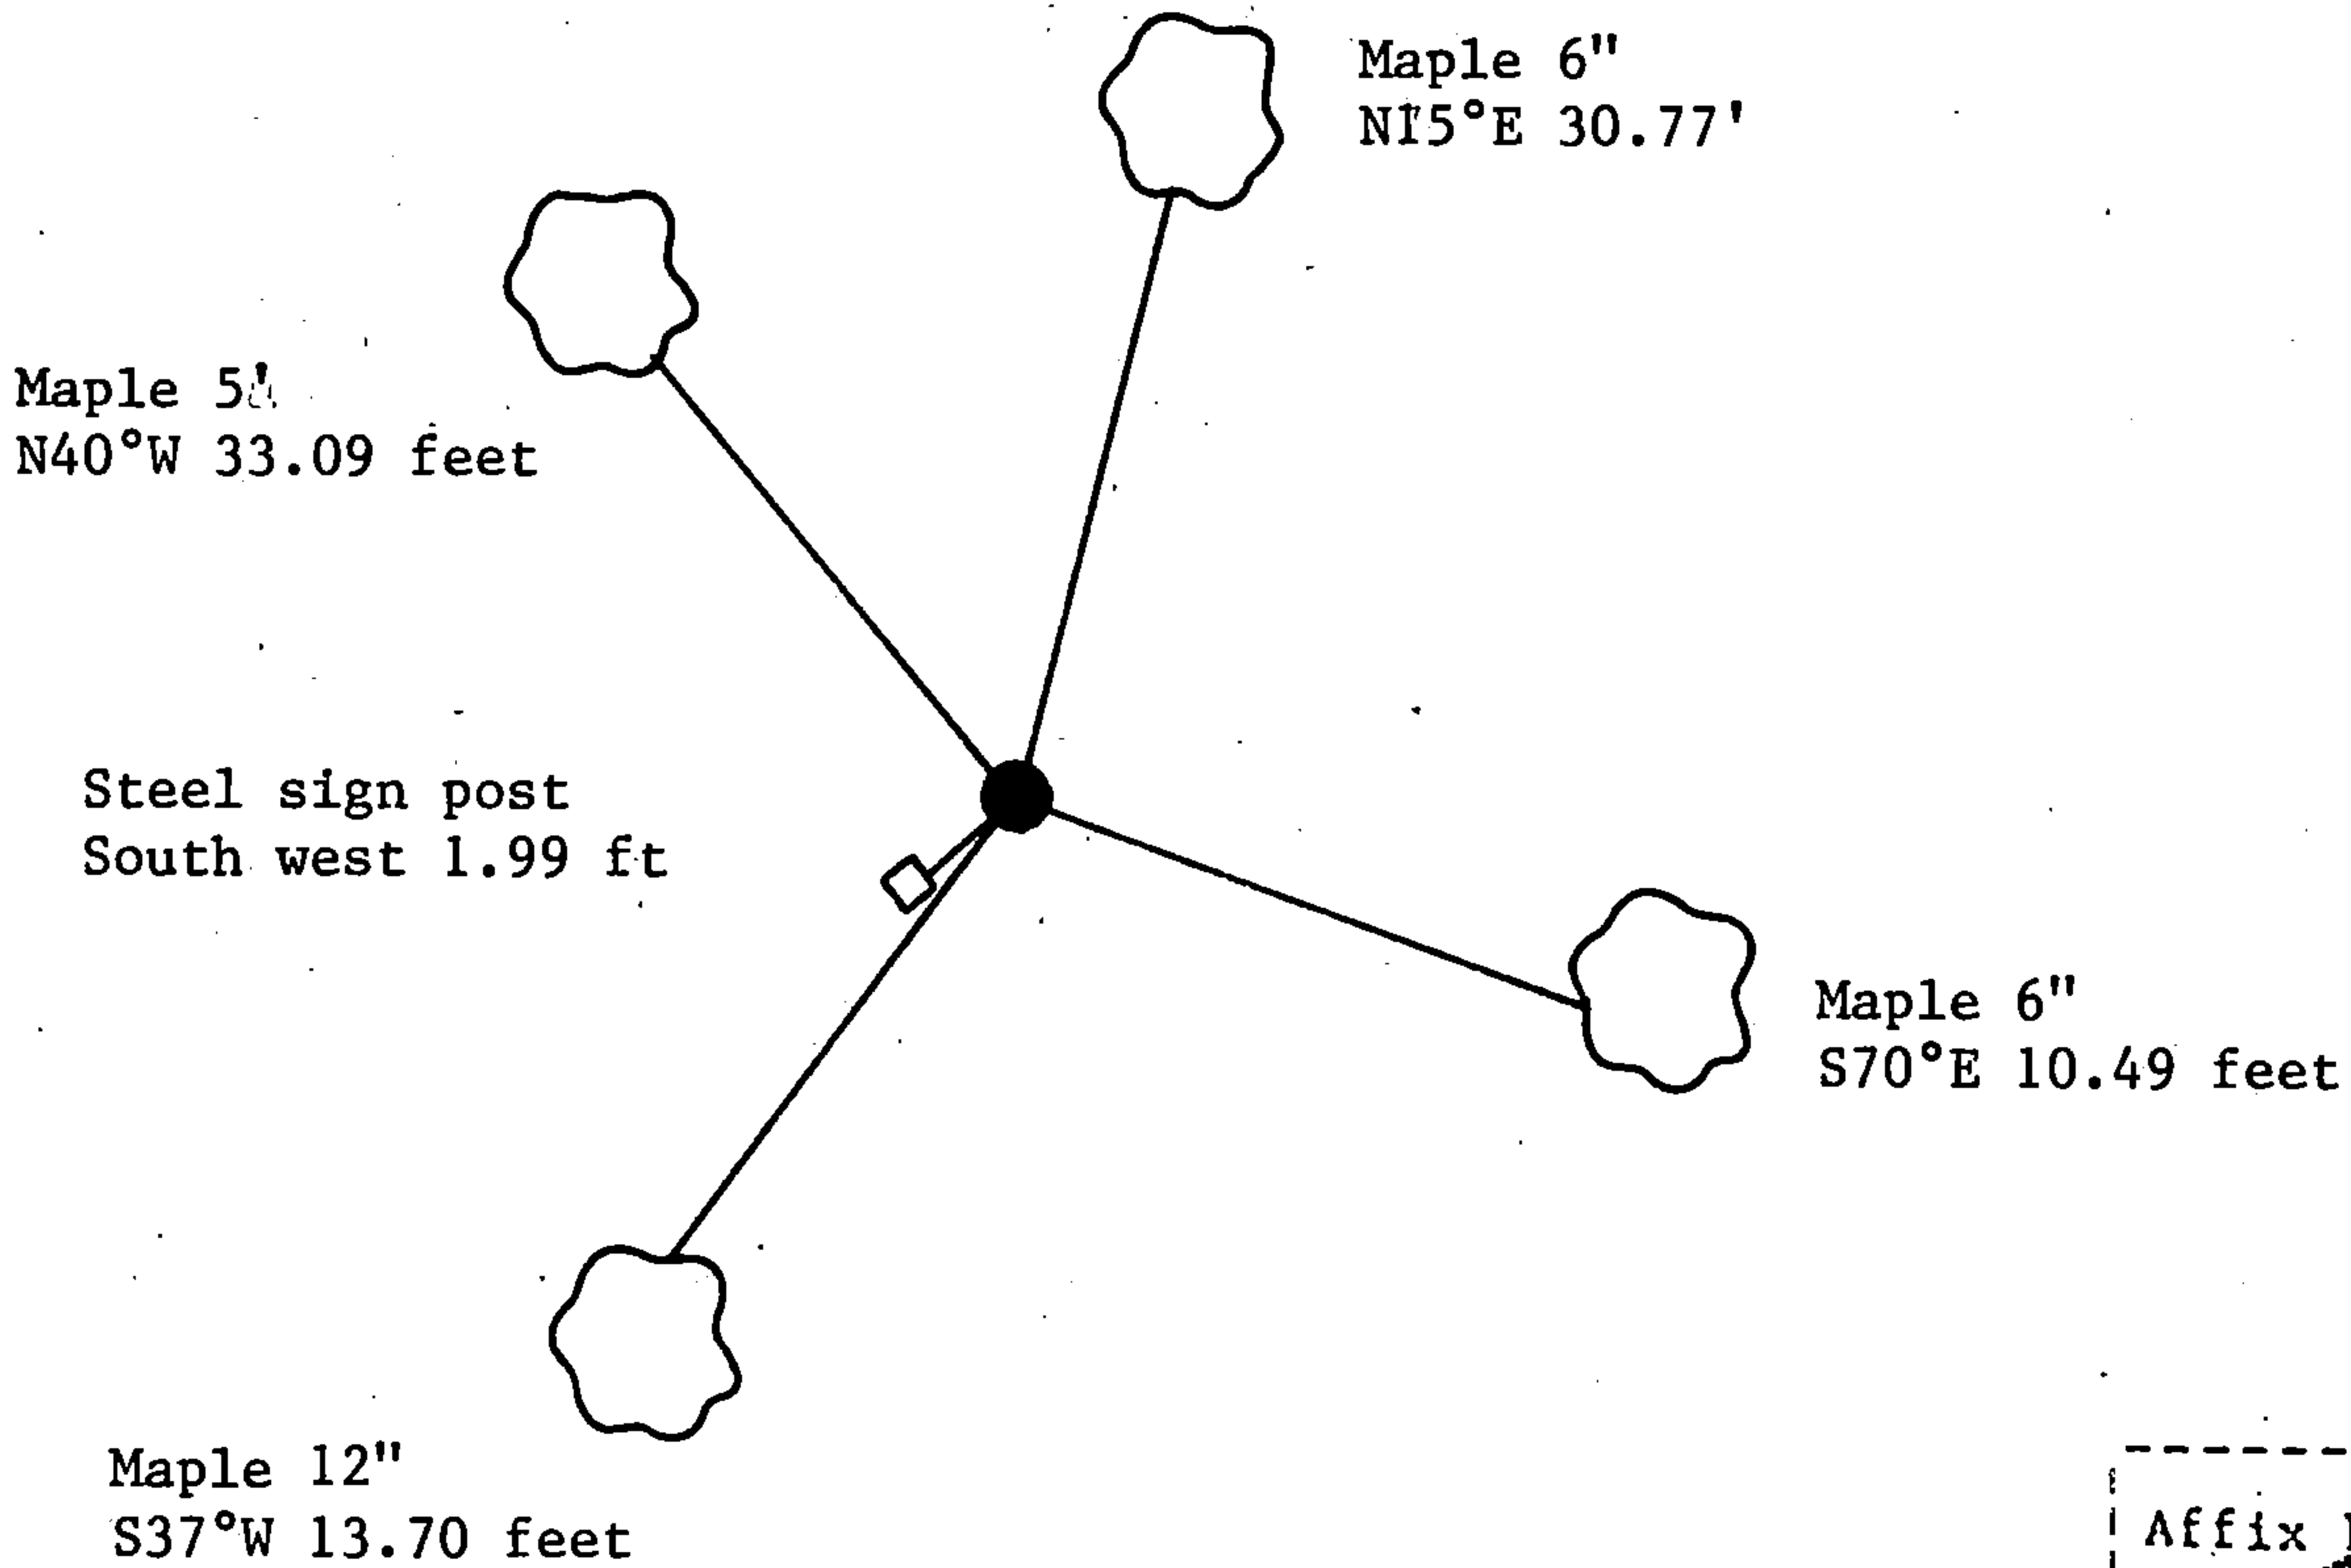

(i) I, William B. Cochrane
(type or print name) certify that the corner location shown on this record was determined by me or under my direction and control and that this U.S. Public Land Survey Monument Record is correct and complete to the best of my knowledge and belief.

William B. Cochrane
Signature

1/4/95
Date