

U.S. PUBLIC LAND SURVEY MONUMENT RECORD

Index No. E-21

State of Wisconsin

County of Forest

ss.

I, William B. Cochrane, do hereby certify that on the 26th day of April, 1992, I found evidence of the Southwest Section corner of Section 1 Township 38 North, Range 13 East, Fourth Principal Meridian, as described hereon; and that from this evidence I established a new monument and accessories as described hereon to perpetuate the original location of this corner.

Resident witnesses:

History of original corner establishment:


Original Government Survey by H. & J. L. Nowlin in August 1865. North between sections 11 and 12 at 80 chains set post from which: Birch 15" N10°E 20 lks Hemlock 20" N29°W 24 lks

Description of corner evidence found:

No corner evidence was found.

Description of monument and accessories I established to perpetuate the original location of this corner. At proportionate distance one mile North and two miles south to existing corners and using the center line of State Highway 33. Set a railroad spike flush in the road surface and set a reference monument East at 33.16 feet, from which the following bear:

Maple 6" S77°W 37.94 feet Maple 6" N48°W 45.60 feet Reference Monument 1 1/2" X 36" aluminum pipe with an aluminum cap stamped: T38N, R13E, Reference Corner, S1, S2, S11, S12, West, 33.16 ft, 1992, S-1107. Steel sign post East 33.61 feet

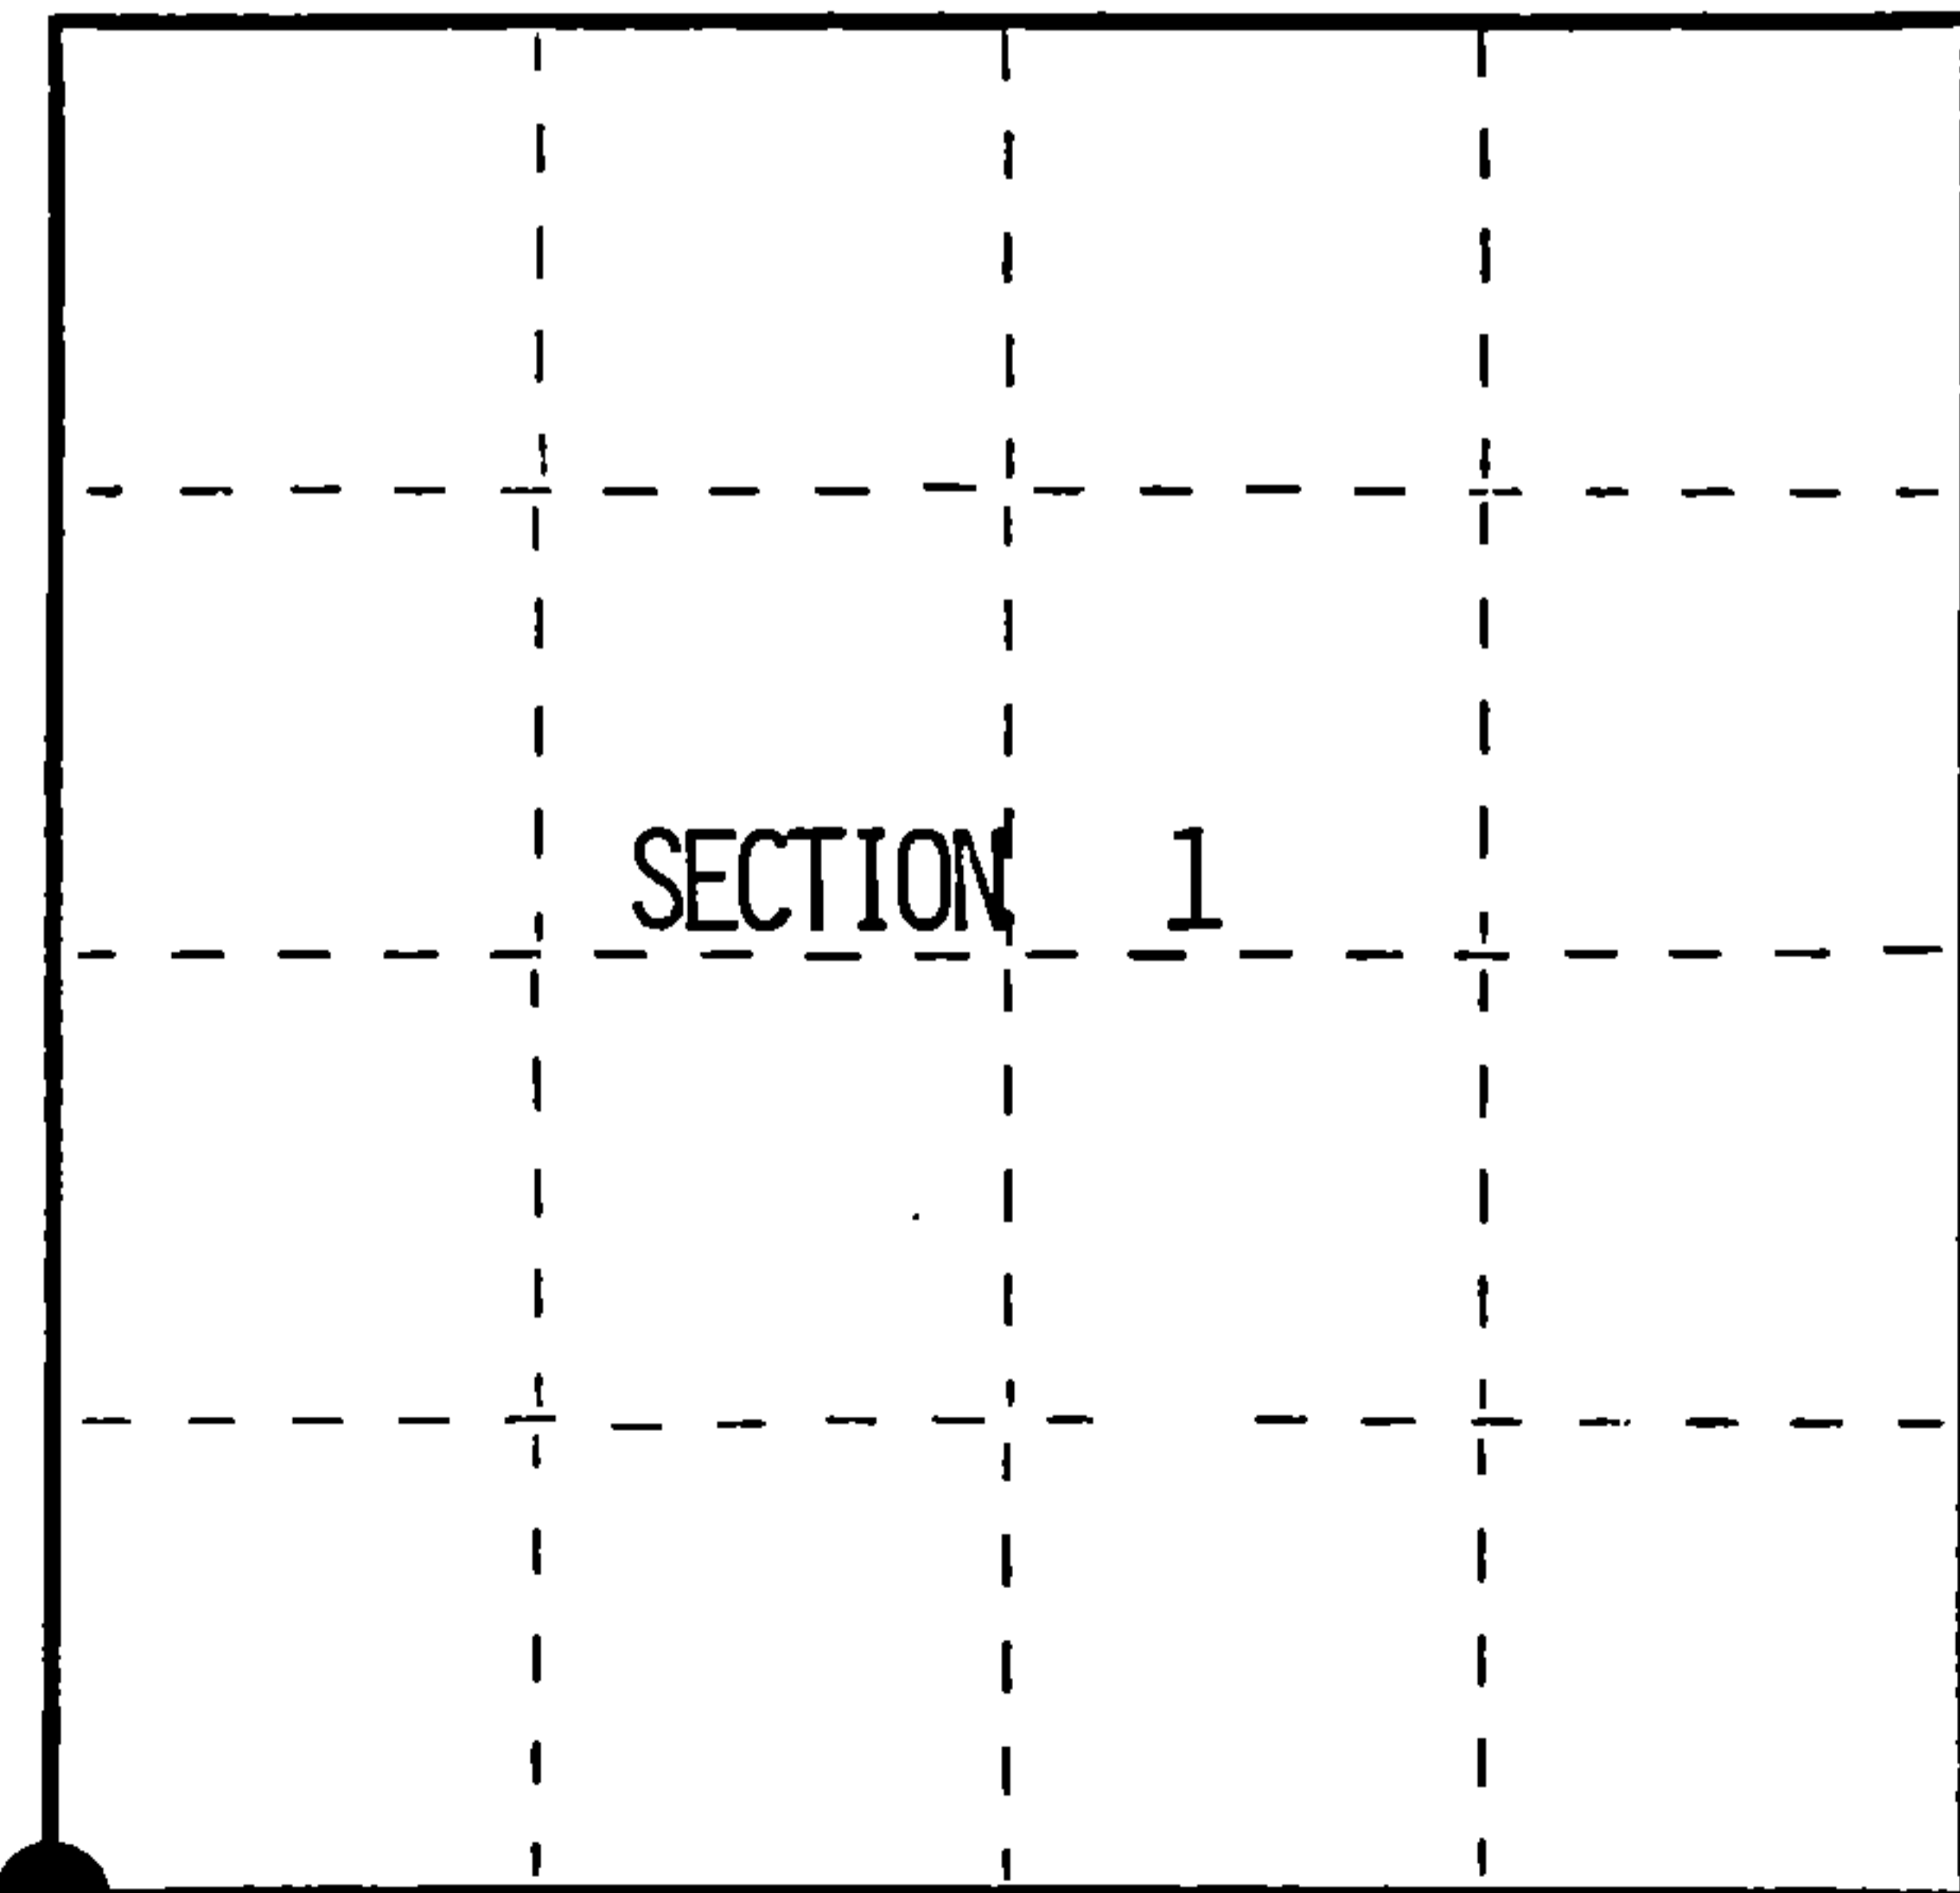

○ = Corner monument restored.

Dated at Hiles, Wis., this 4th day of January, 1995

Signature William B. Cochrane Title Land Surveyor Registration No. S-1107 (County Surveyor, Registered Land Surveyor, or other duly authorized official)

Office of Register of Deeds, County of Forest, I hereby certify that the within instrument was filed in this office for record on the 23rd day of August, 1996 at 2:30 o'clock P.M.

By Paul Tomkiewicz Deputy (Register of Deeds)

FORM NO. 985-A

McMiller Company

Stock No. 26273

156553

43813020000

