

CERTIFIED LAND CORNER RESTORATION

State of Wisconsin }
County of Forest } ss.

I Jean F. Resvick, do hereby certify that on the 17th day of March, 1971, I found evidence of the northeast section corner of Section 23 Township 38 North, Range 13 East, Fourth Principal Meridian, as described hereon; and that from this evidence I established a new monument and accessories as described hereon to perpetuate the original location of this corner:

Description of original monument and accessories and subsequent restorations:


Surveyed in 1865 by H. and J. L. Nowlin
80.0 chains North between Section 23 and 24, Set post.
Tamarack 14, N80E, 10 lks.
Tamarack 14, S59W, 30 lks.
4 chains south leave swamp
4 chains east leave swamp
48 chains north leave swamp
31.5 chains west leave swamp

Description of corner evidence found:

Post point from which:
Tamarack snag bears S59W, 23 lks., scribed
Tamarack stump bears N80E, 9 lks., scribed
4 chains south leave swamp.
Blaze on snag bears dates of 1915 and 1916.


Description of monument and accessories I established to perpetuate the original location of this corner:

Replaced post point with a 2 inch inside diameter galvanized wrought iron pipe, 5 ft. long, filled with concrete with brass cap stamped

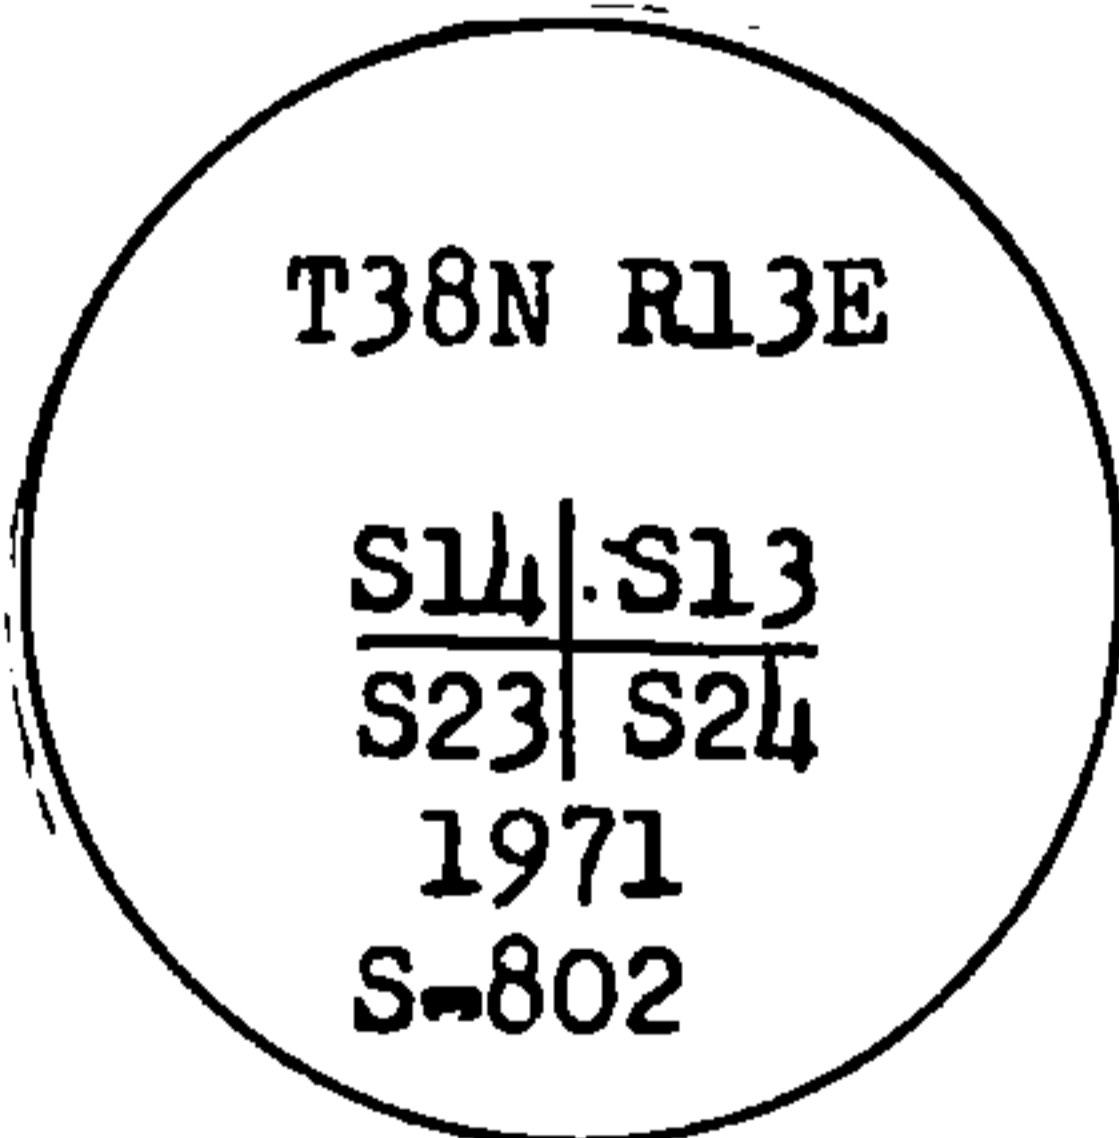

from which the following blazed and scribed new bearing trees bear:

Cedar 10, N57E, 9.0 ft.
Cedar 11, S59E, 15.30 ft.
Cedar 9, S38W, 16.06 ft.
Sign Post set 1 ft. west of Monument

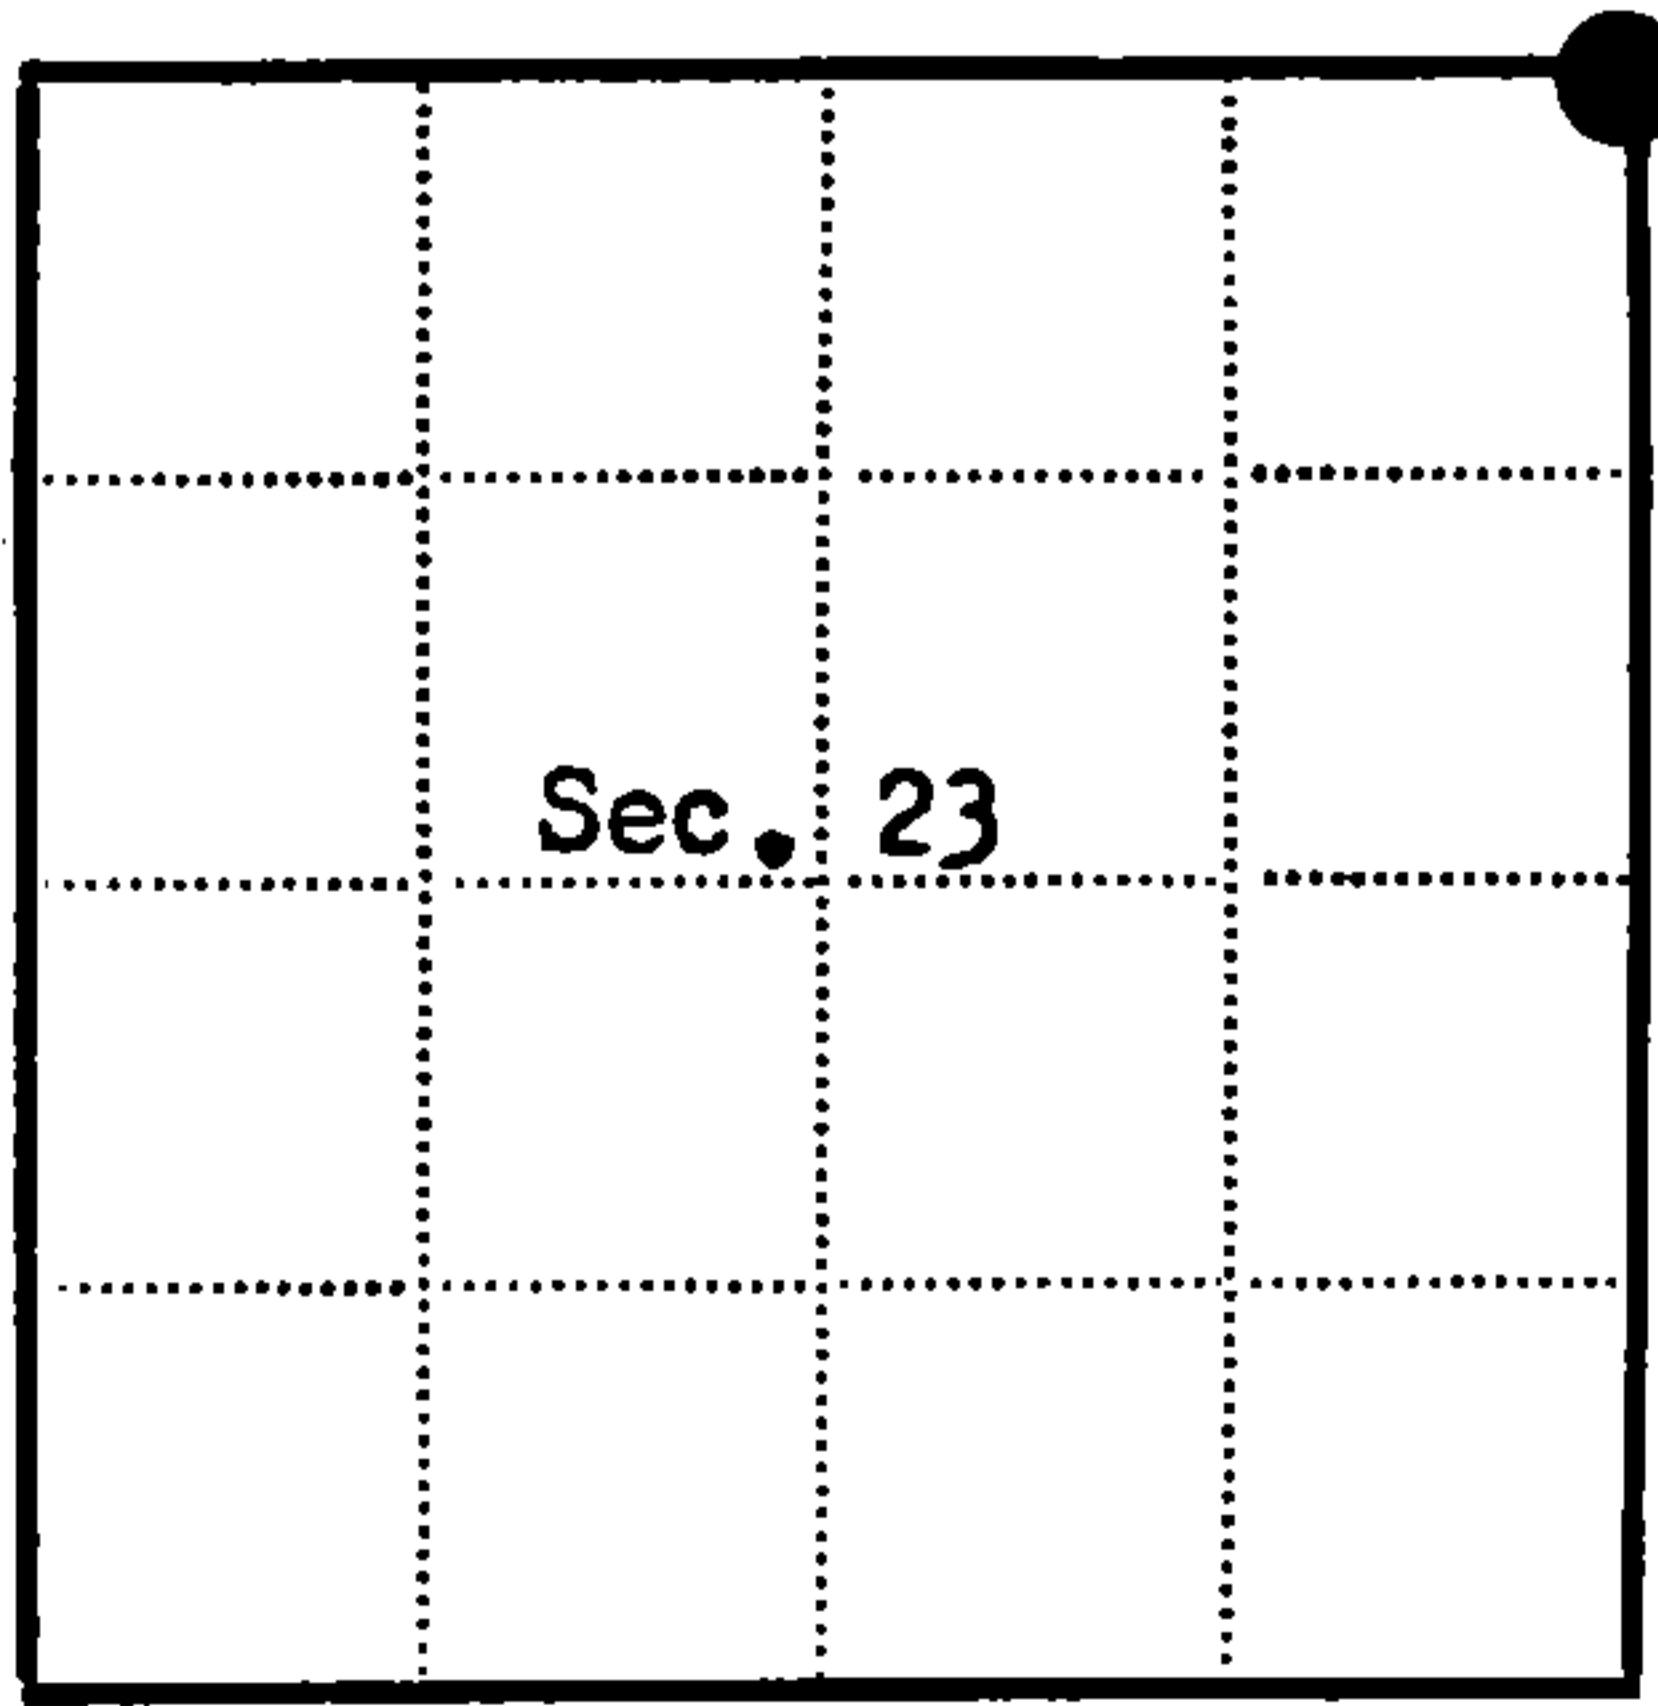

● = Corner monument restored
□ =

Resident witnesses _____

Dated at Rhinelander Wisconsin, this 17th day of March, 1971.

Signature Jean F. Resvick Title Land Surveyor
(County Surveyor, Registered Land Surveyor, or other duly authorized official)

Surveyors Registration No. S-802 DOCUMENT NUMBER 99716

Office of Register of Deeds County of Forest

I hereby certify that the within instrument was filed in this office for record on the 25th day of May, 1971, and was filed in Book No. 1 Page No. N-21 of County Records.

Signature Eugene Staszewski Title Register of Deeds

Township 38 North, Range 13 East, Section 23, Index No. N-21, Page No. _____

43813140000

N 21