

Stock No. 26273
DOCUMENT NUMBER
145348


U.S. PUBLIC LAND SURVEY MONUMENT RECORD

Index No. Z-9

State of Wisconsin }
County of Forest } ss.

I, William B. Cochrane, do hereby
certify that on the 1st day
of June, 1990, I found
evidence of the Southwest Section
corner of Section 33
Township 38, North, Range
13 East, Fourth Principal Meridian,
as described hereon; and that from this evidence
I established a new monument and accessories
as described hereon to perpetuate the original
location of this corner.

Resident witnesses:

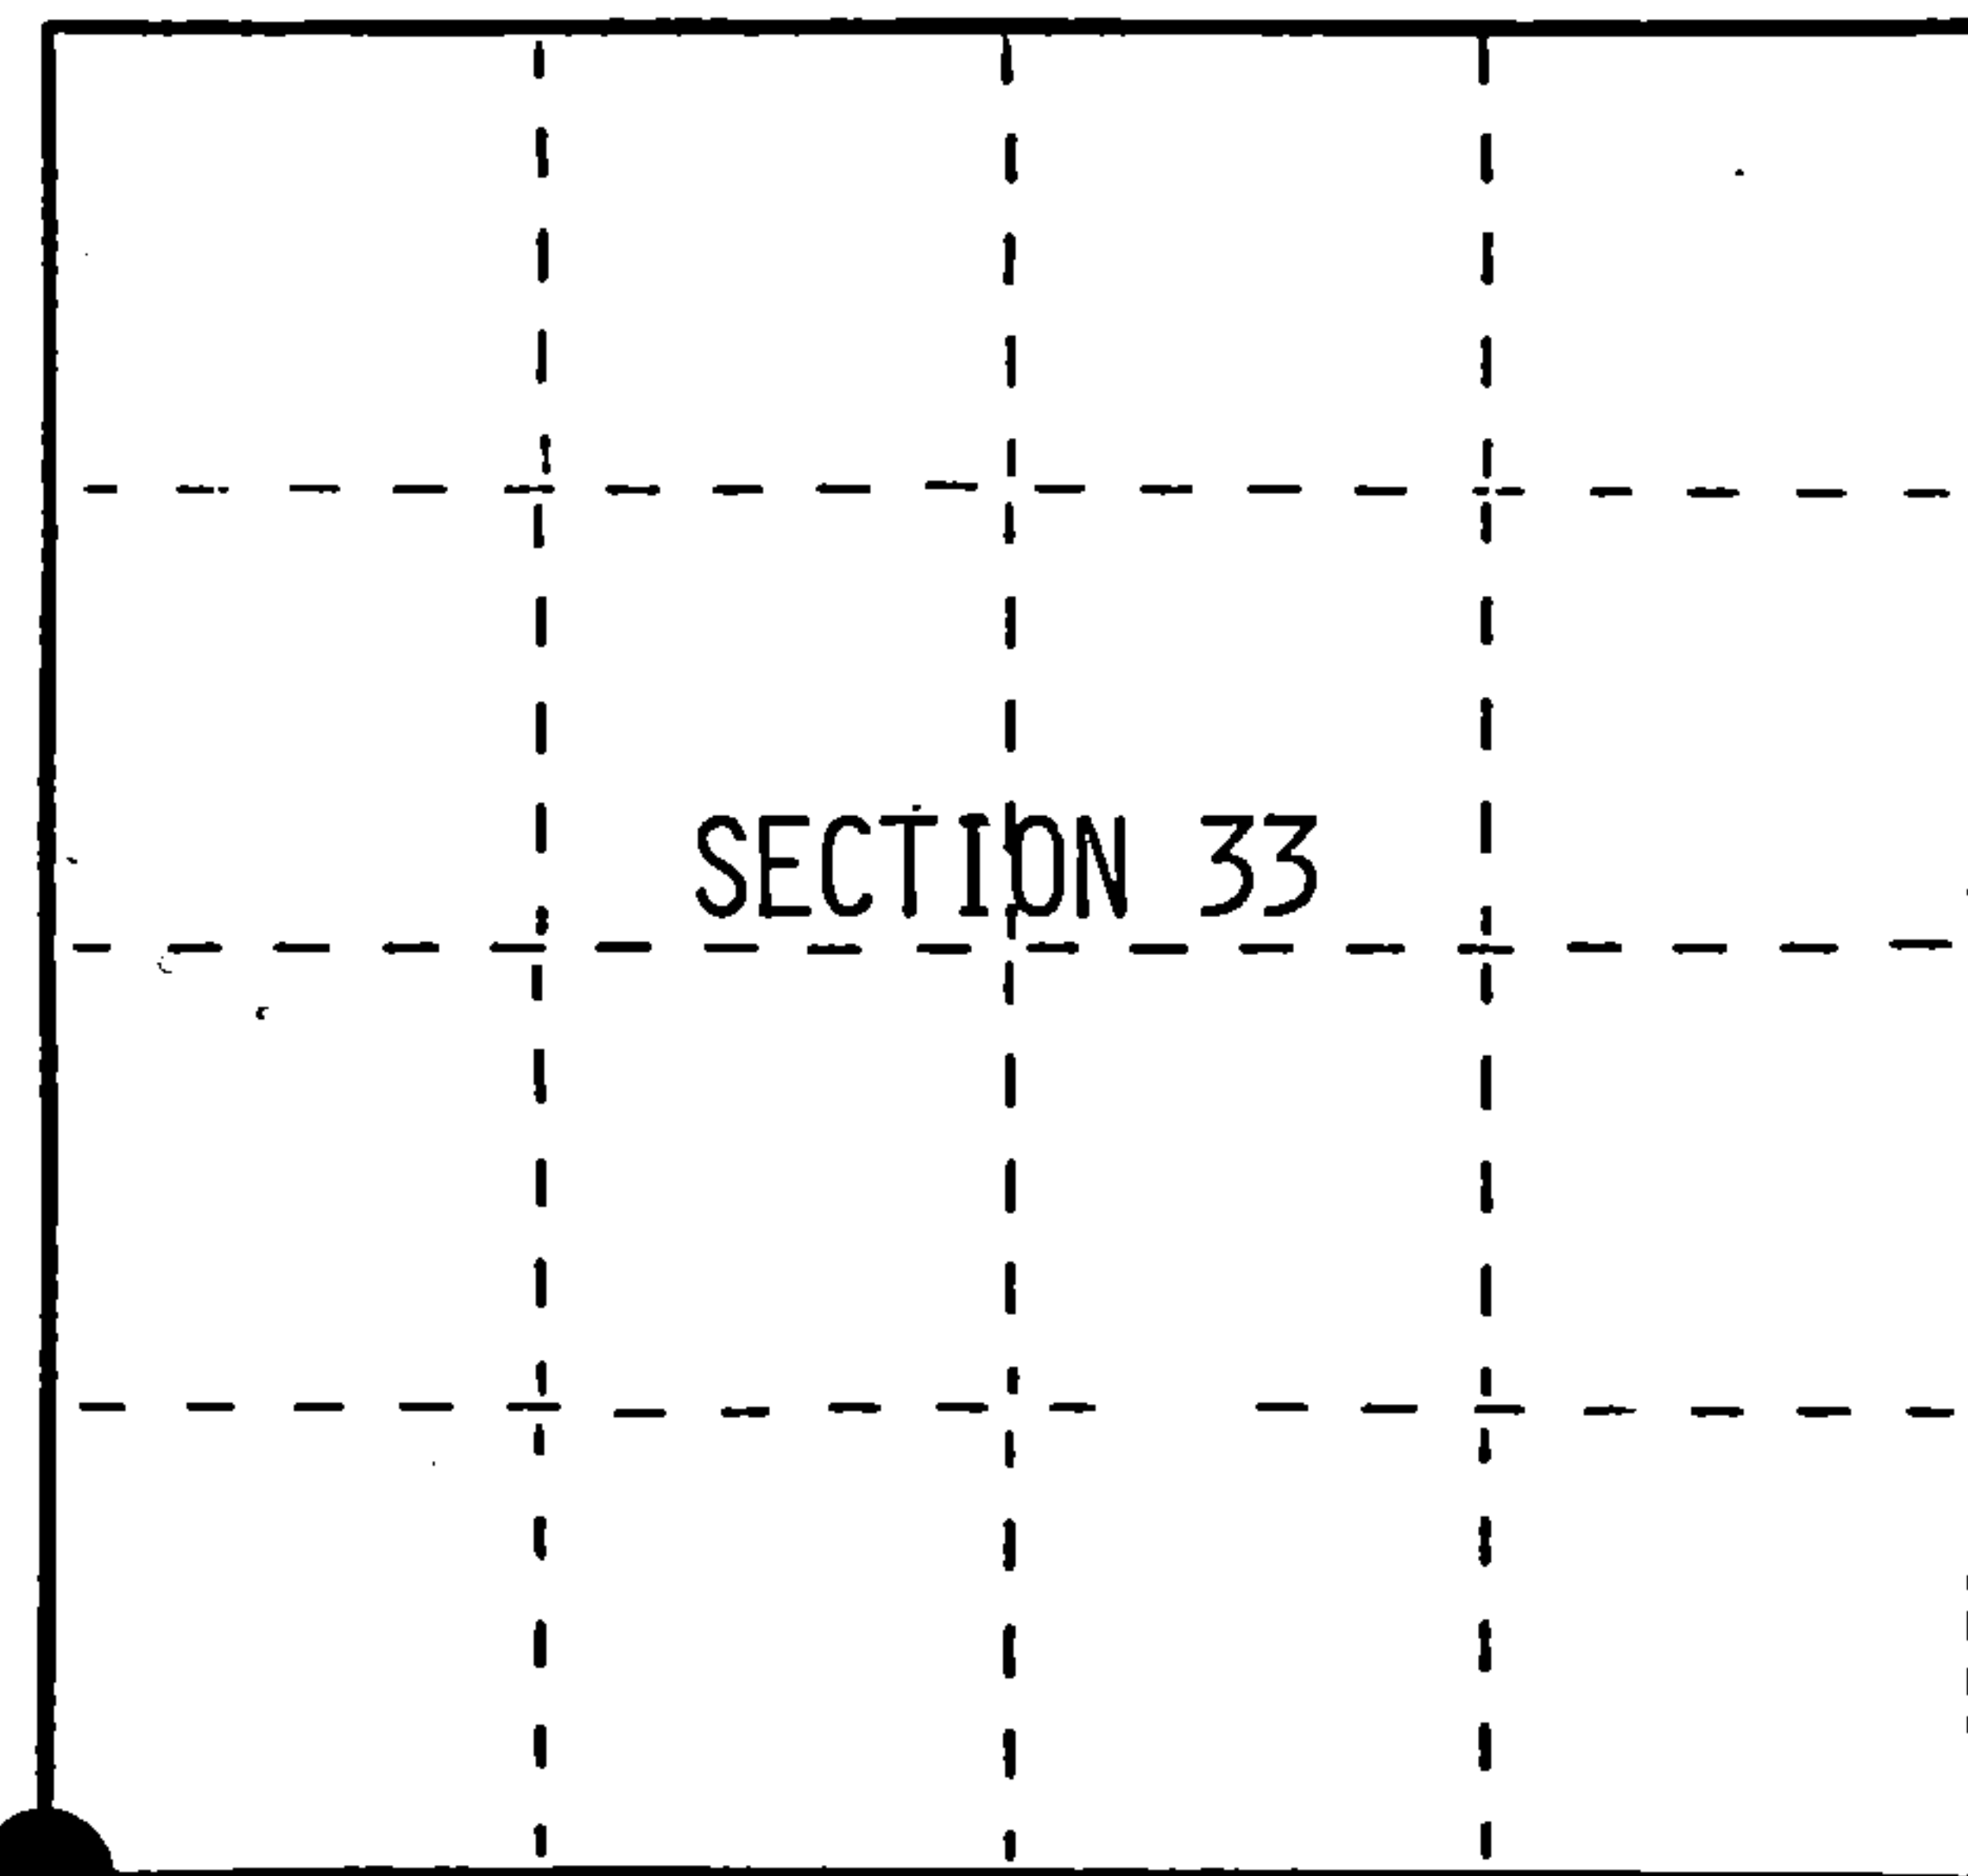

○ = Corner monument restored.

History of original corner establishment:

Original Government Survey in 1858 by Alfred Millard.

In 1971, while doing a survey of Sections 5, 6 and 7 of T37N R13E, Jean Resvick re-established the corner position at proportionate distance and on line between the Township Corner and the South Quarter Corner of Section 33. At the corner position, he set a 2" inside diameter galvanized iron pipe, 5 feet long, with a brass tablet stamped; T38N R13E, S32, S33, S4, S5, T37N, 1970, S-802. From which the following bear;

Maple	5"	N58°E	59.53 feet,	Maple	6"	S35°E	15.95 feet,
Maple	4"	S24°W	10.14 feet,	Ash	12"	N46°W	51.51 feet

Steel Sign Post, Northeast, 1.00 feet
Description of corner evidence found:

Found monument as described above, in place, from which the following bear;

Maple	8"	N58°E	59.53 feet
Maple	9"	S35°E	15.95 feet
Maple	9"	S24°W	10.14 feet
W. Ash	15"	N46°W	51.51 feet
Steel Sign Post		Northeast	1.00 feet

Description of monument and accessories I established to perpetuate the original location of this corner.

Re-painted all of the above bearing trees and attached bearing tree signs to same.

Dated at Hiles, Wis., this 27th day of February, 1992

Signature William B. Cochrane, Title Land Surveyor, Registration No. S-1107
(County Surveyor, Registered Land Surveyor, or other duly authorized official)

Office of Register of Deeds, County of Forest, I hereby certify that the within
instrument was filed in this office for record on the 3rd day of August, 1992
at 10:15 o'clock A. M.

Paul Achenbrenner
(Register of Deeds)

By Deputy

43813320000

(e) Describe any material discrepancy between the location of the corner as restored or reestablished and the location of that corner as previously restored or reestablished by distance and direction. Show the discrepancy on the plan view drawing under (d), above. Show the distances between the corner as previously restored or reestablished and (1) the corner as restored or reestablished, and (2) to at least 2 of the witness monuments shown on the drawing in (d), above.

(f) Was the corner restored through acceptance of (1) an obliterated evidence location, or, (2) a found perpetuated location?

Restored through acceptance of a found perpetuated location.

(g&h) Was the corner reestablished through lost corner proportionate methods? If so, show the method, including the directions and distances to other public land survey corners used as evidence or used for proportioning in determining the corner location?

15" W. Ash
N46°W, 51.51 feet

8" Maple
N58°E, 59.53 feet

Steel Sign Post,
Northeast, 1.00 feet

Section Corner

S32	S33	T38N
S5	S4	T37N

9" Maple
S24°W, 10.14 feet

9" Maple
S35°E, 15.95 feet

Affix Land Surveyor Seal



(i) I, William B. Cochrane
(type or print name) certify that the corner location shown on this record was determined by me or under my direction and control and that this U.S. Public Land Survey Monument Record is correct and complete to the best of my knowledge and belief.

William B. Cochrane
Signature

Feb 27, 1992
Date

Survey requested by;

Susan Vap
District Ranger

4/2/92