


U. S. PUBLIC LAND SURVEY MONUMENT RECORD

INSTRUCTIONS: This record shall show the location of the corner and shall include all of the following nine elements (a through i)

- (a) Identify the corner by reference to the U.S. public land survey system.
- = Corner monument restored.

Section corner to Sections 33-34, T38N, R13E and 3-4 T37N, R13E, Forest County, Wisconsin

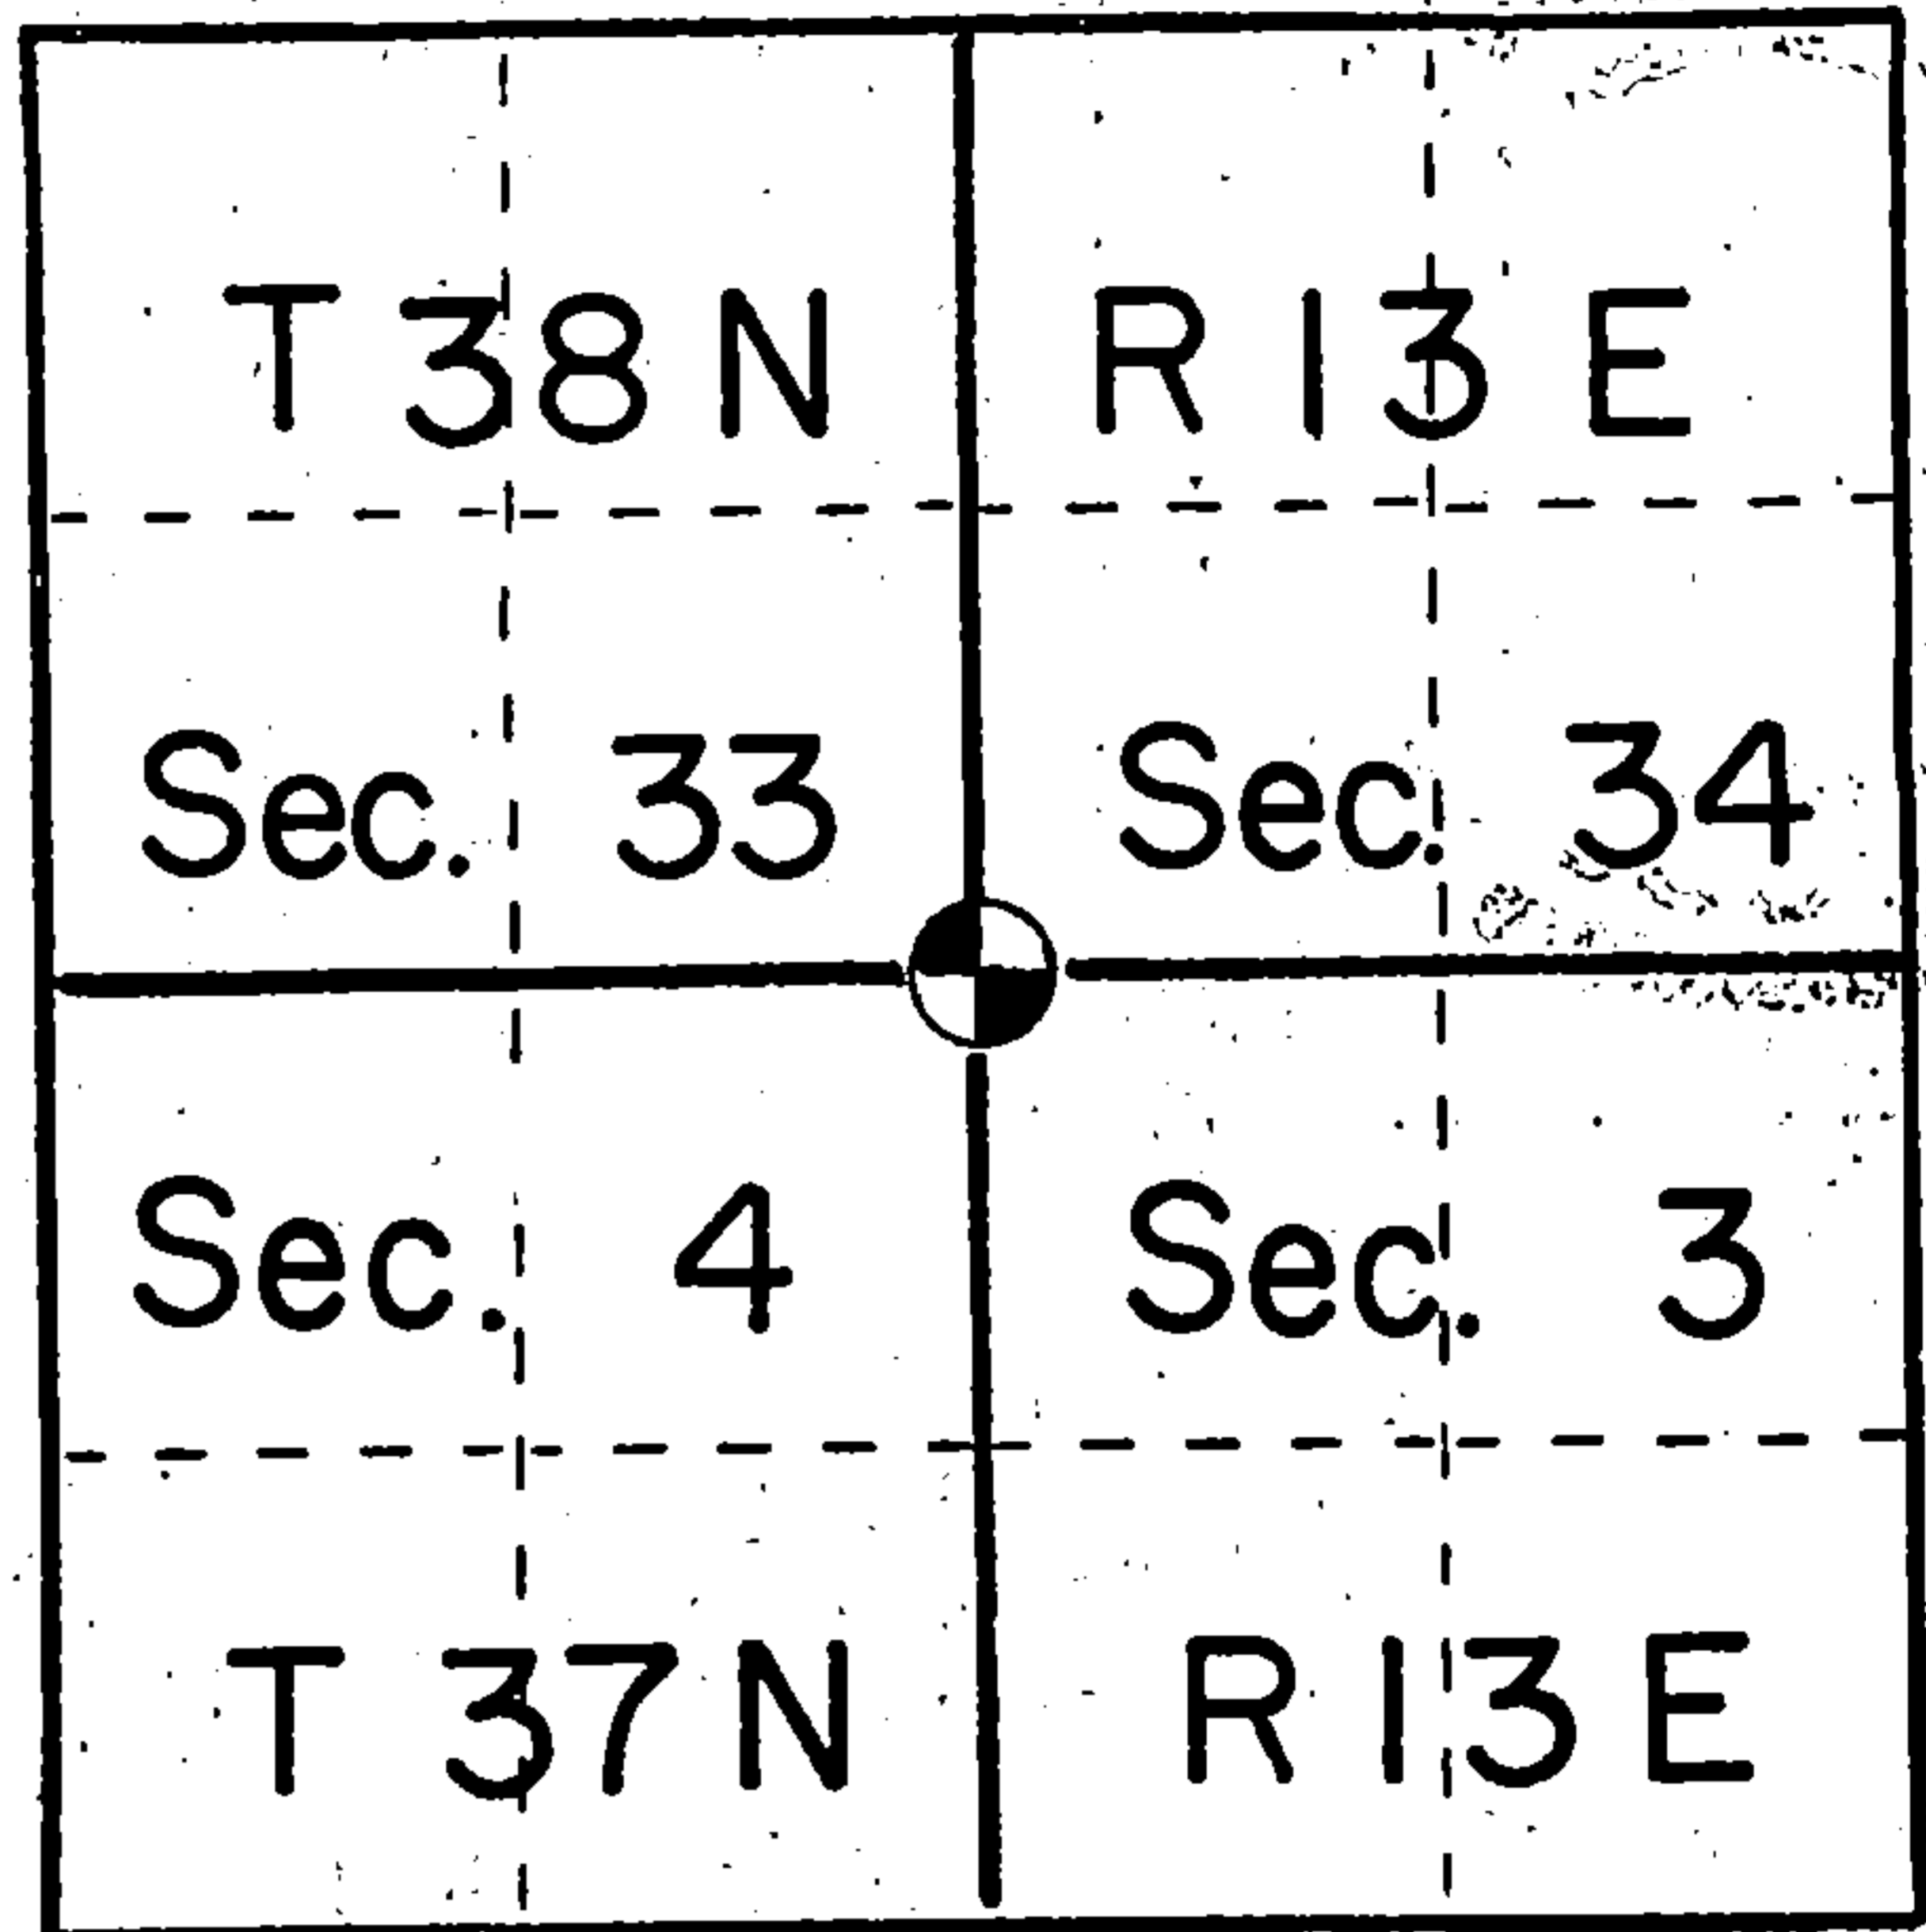

- (b) Describe any record evidence, monument evidence, occupational evidence, testimonial evidence or any other material evidence you considered, and whether the monument was found or placed.

In 1858 the government set a wood post with:  
 Sugar 8" N 15E 17 links  
 Yellow Birch 20" N18W 22 links  
 Fir 12" S50W 32 links  
 Sugar 12" S25E 30 links


In 1937 the General Land Office set a monument

In 1971 Jean Resvick located the GLO corner and set a 2" iron pipe with brass cap reference corner.

I found the GLO corner and Resvick's reference monument and added new ties:


- (c) In the plan view drawing below, provide reference ties to at least 4 witness monuments, or, if the location is within a municipality, to at least 2 witness monuments. (Witness monuments shall be made of concrete, natural stone, iron or other equally durable material.) Describe witness monuments.

- (d) Show a plan view drawing depicting the relevant monuments and reference ties which is sufficient in detail to enable accurate relocation of the corner monument if the corner monument is disturbed. Indicate north.

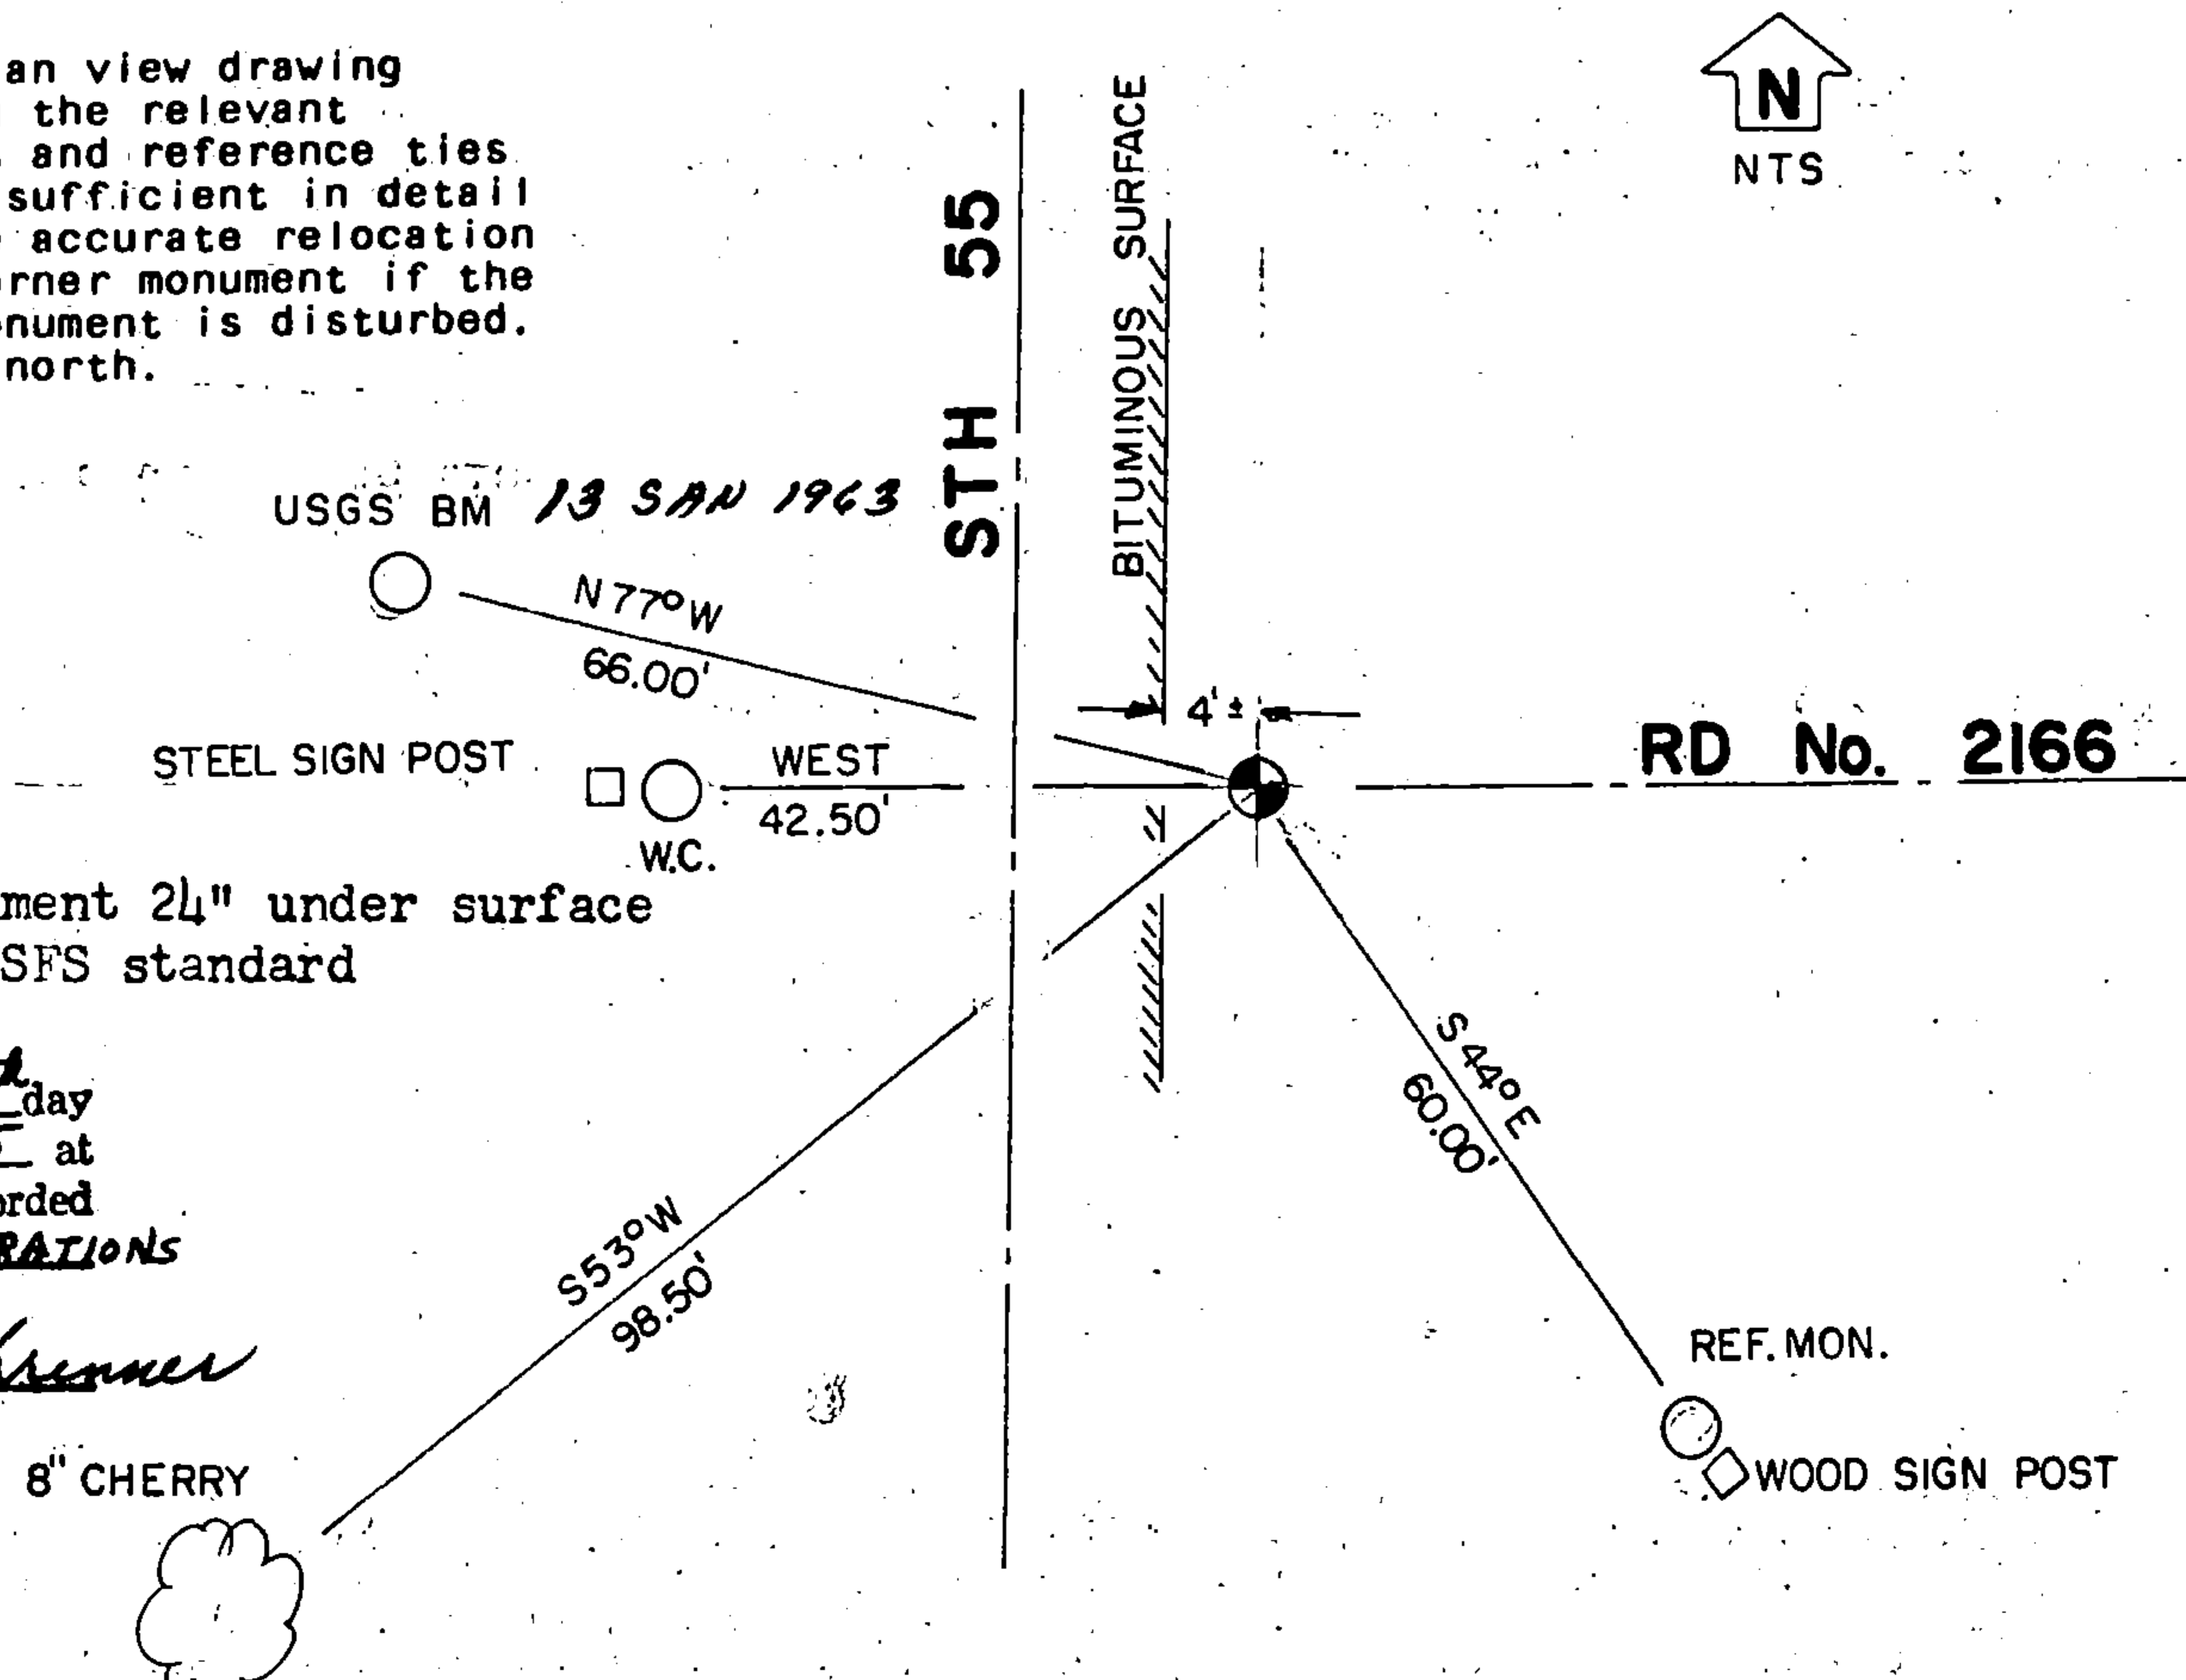

GLO monument 24" under surface set to USFS standard

REGISTER'S OFFICE }  
 Forest County, Wis. }  
 Received for record this 7th day  
 of August A.D., 1985 at  
 3:00 o'clock P.M. and recorded  
 in Vol. CORNER RESTORATIONS  
 page A-13  
*Paul Aschenbrenner*  
 Register of Deeds

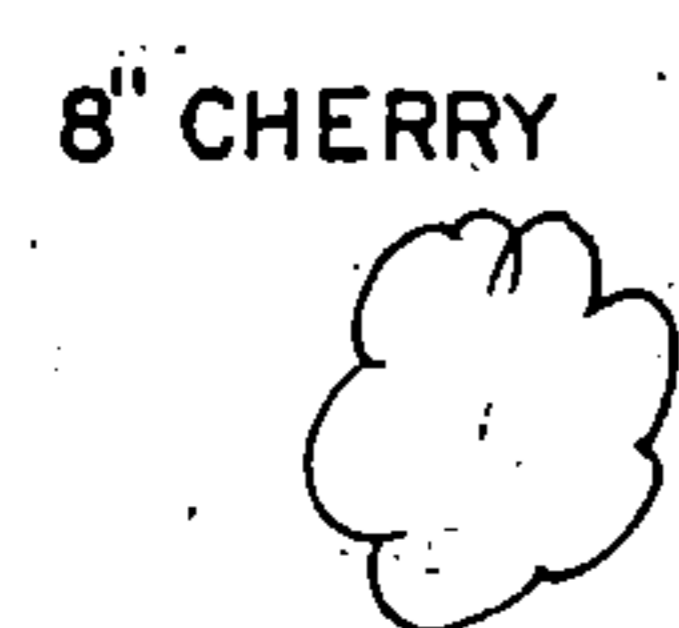

34-13

43813330000

INDEX NO. A-13

- (e) Describe any material discrepancy between the location of the corner as restored or reestablished and the location of that corner as previously restored or reestablished by distance and direction. Show the discrepancy on the plan view drawing under (d), above. Show the distances between the corner as previously restored or reestablished and (1) the corner as restored or reestablished, and (2) to at least 2 of the witness monuments shown on the drawing in (d), above.

No discrepancy

- (f) Was the corner restored through acceptance of (1) an obliterated evidence location, or, (2) a found perpetuated location?

Found perpetuated location

- (g&h) Was the corner reestablished through lost corner proportionate methods? If so, show the method, including the directions and distances to other public land survey corners used as evidence or used for proportioning in determining the corner location?

No



- (i) I, Kim H Pritzlaff  
(type or print name) certify that the corner location shown on this record was determined by me or under my direction and control and that this U.S. Public Land Survey Monument Record is correct and complete to the best of my knowledge and belief.

Signature

Date

*Kim H Pritzlaff*

5-6-85