

U.S. PUBLIC LAND SURVEY MONUMENT RECORD


Index No. Z-11

State of Wisconsin }  
County of Forest } ss.

I, William B. Cochrane, do hereby certify that on the 1st day of June, 1990, I found evidence of the South Quarter corner of Section 33 Township 38 North, Range 13 East, Fourth Principal Meridian, as described hereon; and that from this evidence I established a new monument and accessories as described hereon to perpetuate the original location of this corner.

Resident witnesses:

.....  
.....  
.....

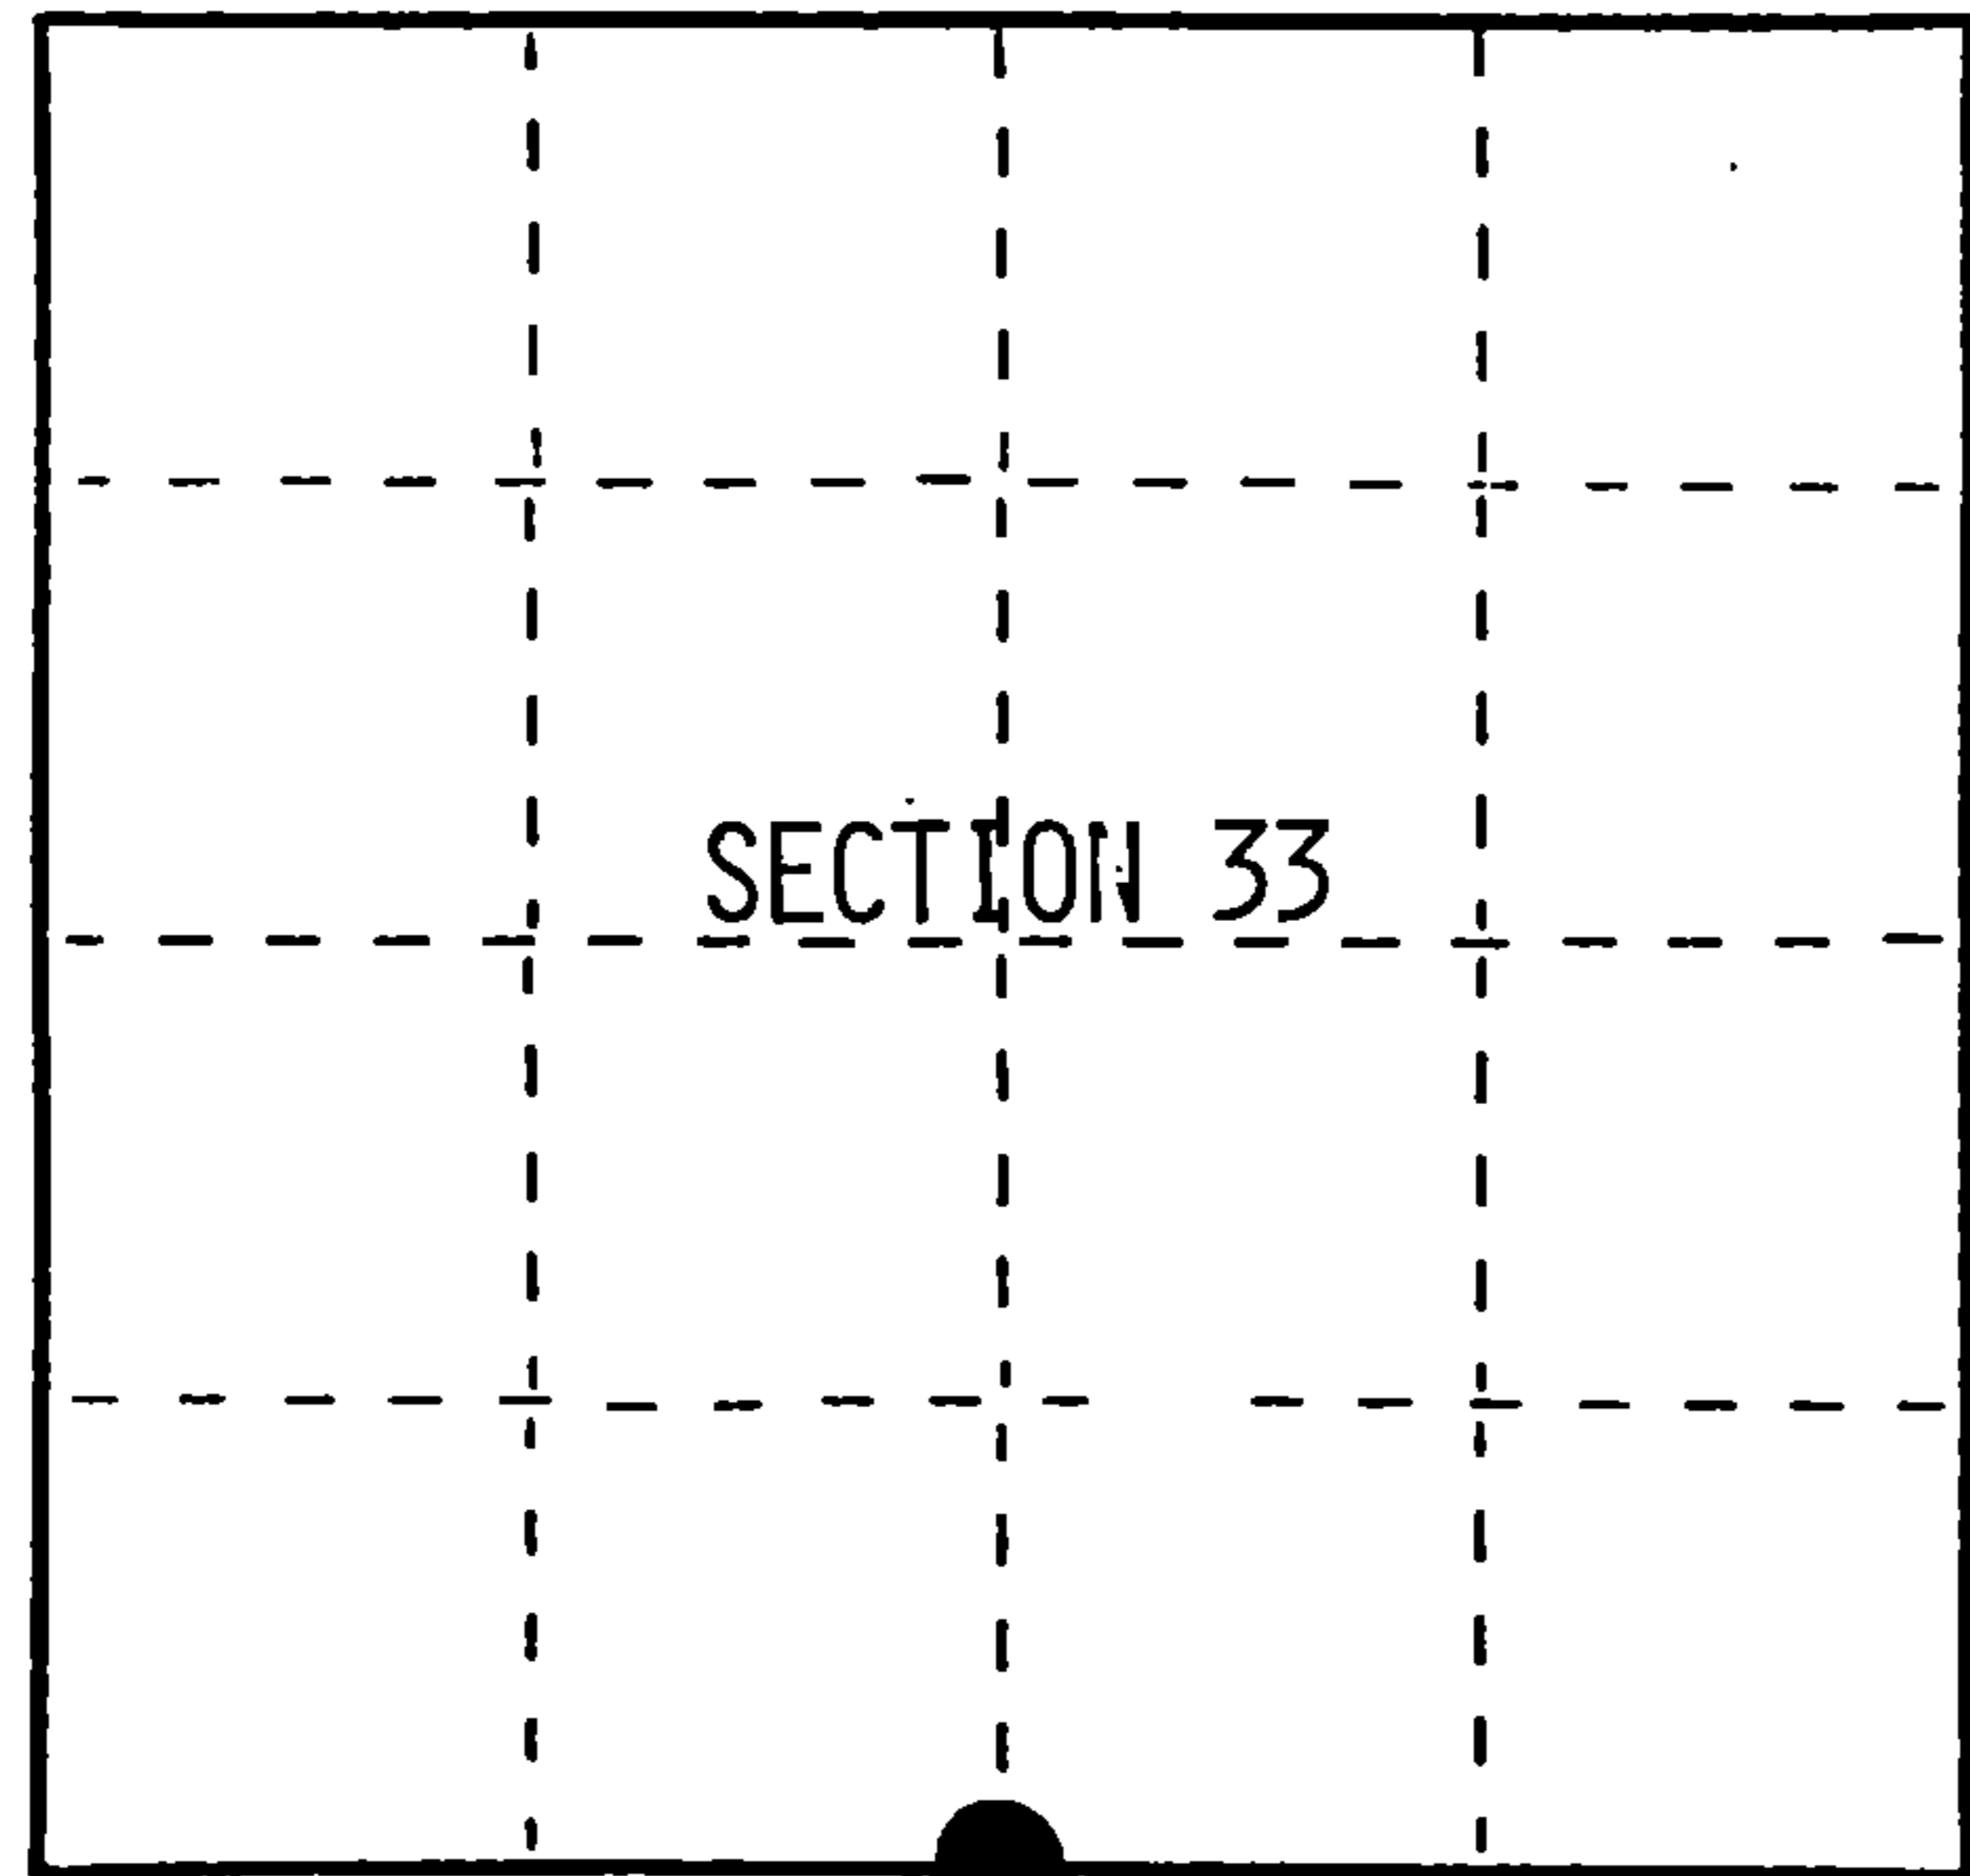

○ = Corner monument restored.

History of original corner establishment:

Original Government Survey in 1858 by Alfred Millard.

In 1971 while doing a survey of Sections 5, 6 and 7 of T37N R13E, Jean Resvick found a stake in the top of an iron pipe at a fence corner marking this corner position. In place of iron pipe he set a 2 inch inside diameter galvanized iron pipe, 5 feet long, with a 3 inch diameter brass tablet marked; T38N R13E, 1/4, S33, S4, T37N, 1971, S-802. Blazed and scribed the following bearing trees;

Aspen	11"	S04°E	52.94 feet	
Aspen	5"	N85°W	54.29 feet	Iron Post, Southwest, 0.80 feet

Description of corner evidence found:

Found monument as described and in place, from which the following bear;

Aspen	14"	S04°E	52.94 feet
Aspen	9"	N85°W	54.29 feet

Description of monument and accessories I established to perpetuate the original location of this corner.

Painted all bearing trees.

Set a new Steel Sign Post, Southwest, 1.00 feet

Dated at Hiles, Wis., this 27th day of February, 1992


Signature *William B. Cochrane* Title Land Surveyor Registration No. S-1107  
(County Surveyor, Registered Land Surveyor, or other duly authorized official)

Office of Register of Deeds, County of Forest, I hereby certify that the within instrument was filed in this office for record on the 31st day of August, 1992 at 10:15 o'clock A.M.

*Paul Aschenbrenner*  
(Register of Deeds)

By Deputy

FORM NO. 985-A

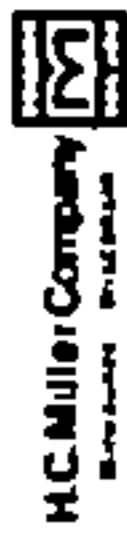

Stock No. 26273

DOCUMENT NUMBER

145349

4381323020

(e) Describe any material discrepancy between the location of the corner as restored or reestablished and the location of that corner as previously restored or reestablished by distance and direction. Show the discrepancy on the plan view drawing under (d), above. Show the distances between the corner as previously restored or reestablished and (1) the corner as restored or reestablished, and (2) to at least 2 of the witness monuments shown on the drawing in (d), above.

(f) Was the corner restored through acceptance of (1) an obliterated evidence location, or, (2) a found perpetuated location?

Restored through acceptance of a found perpetuated location.

(g&h) Was the corner reestablished through lost corner proportionate methods? If so, show the method, including the directions and distances to other public land survey corners used as evidence or used for proportioning in determining the corner location?

9" Aspen  
N85°W, 54.29 feet



Quarter Corner

S33	T38N
S4	T37N



Steel Sign Post  
Southwest, 1.00 feet



14" Aspen  
S04°E, 52.94 feet



Affix Land Surveyor Seal



(i) I, William B. Cochrane  
(type or print name) certify that the corner location shown on this record was determined by me or under my direction and control and that this U.S. Public Land Survey Monument Record is correct and complete to the best of my knowledge and belief.

William B. Cochrane  
Signature

Feb. 27, 1992  
Date

Survey requested by; Sue Vap  
District Ranger

4/2/92  
Date