


U. S. PUBLIC LAND SURVEY MONUMENT RECORD

INSTRUCTIONS:

This record shall show the location of the corner and shall include all of the following nine elements (a through i).

- (a) Identify the corner by reference to the U.S. public land survey system.
- = Corner monument restored.

Quarter Corner to Section 3, T.37N., R.13E. & Section 34, T.38N., R.13E., 4th P.M.

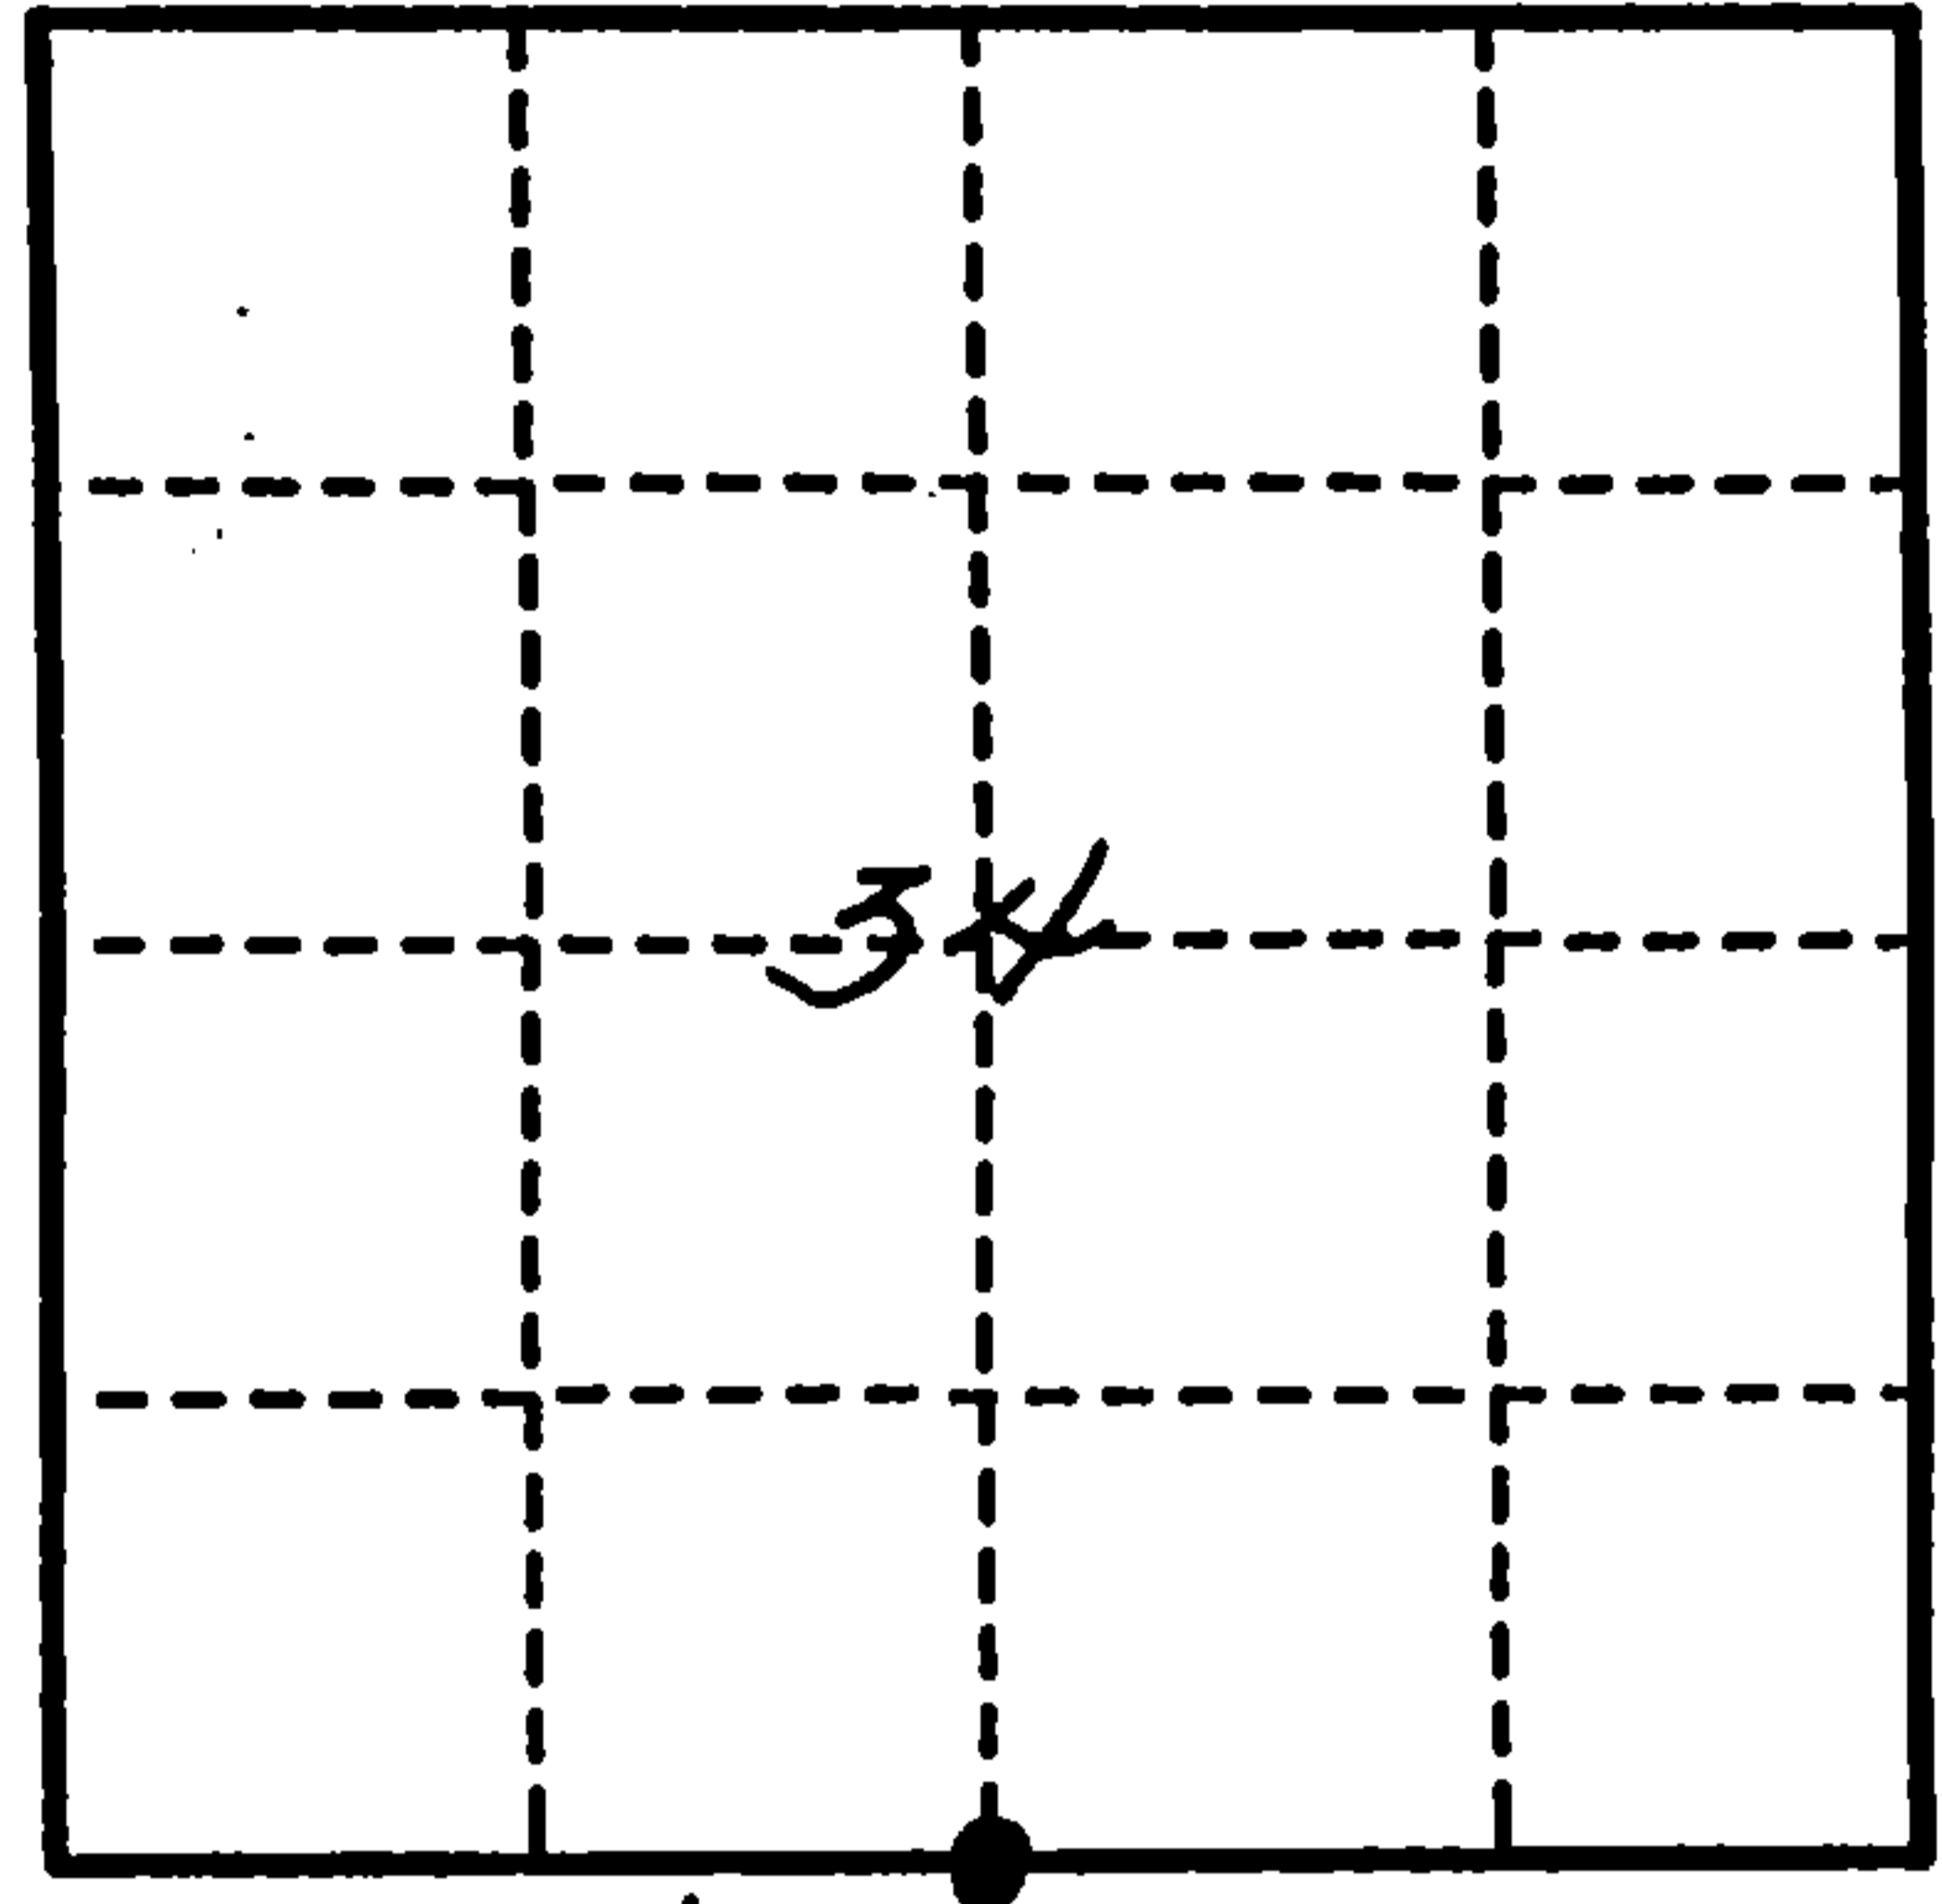

- (b) Describe any record evidence, monument evidence, occupational evidence, testimonial evidence or any other material evidence you considered, and whether the monument was found or placed.

Found aluminum monument cut off by grader and Southeast BT dead. Two BTs and sign post in good condition. Replaced monument with an 1 1/2" x 24" iron pipe 8" below road surface.


We made one new BT: Tamarack, 8", N.32°W., 70.50'.
Set a Witness Corner (2" x 60" aluminum monument), North, 33.09'.

This corner was restored by Resvick in 1971.

- (c) In the plan view drawing below, provide reference ties to at least 4 witness monuments, or, if the location is within a municipality, to at least 2 witness monuments. (witness monuments shall be made of concrete, natural stone, iron or other equally durable material.)

- (d) Show a plan view drawing depicting the relevant monuments and reference ties which is sufficient in detail to enable accurate relocation of the corner monument if the corner monument is disturbed. Indicate north.

1. 1 1/2" x 24" iron pipe.
2. Tamarack, 6", N.30°E., 39.00'.
3. Tamarack (dead), 6", S.28°E., 48.70'.
4. Tamarack, 4", S.12 1/2°W., 23.89'.
5. Tamarack, 8", N.32°W., 70.50'.
6. 4" x 4" Cedar Post, S.10°E., 49.17'.
7. 4" x 4" Cedar Post, N.12°W., 78.54'.
8. Steel sign post, South, 8.8'.
9. Witness Corner, North, 33.09'.

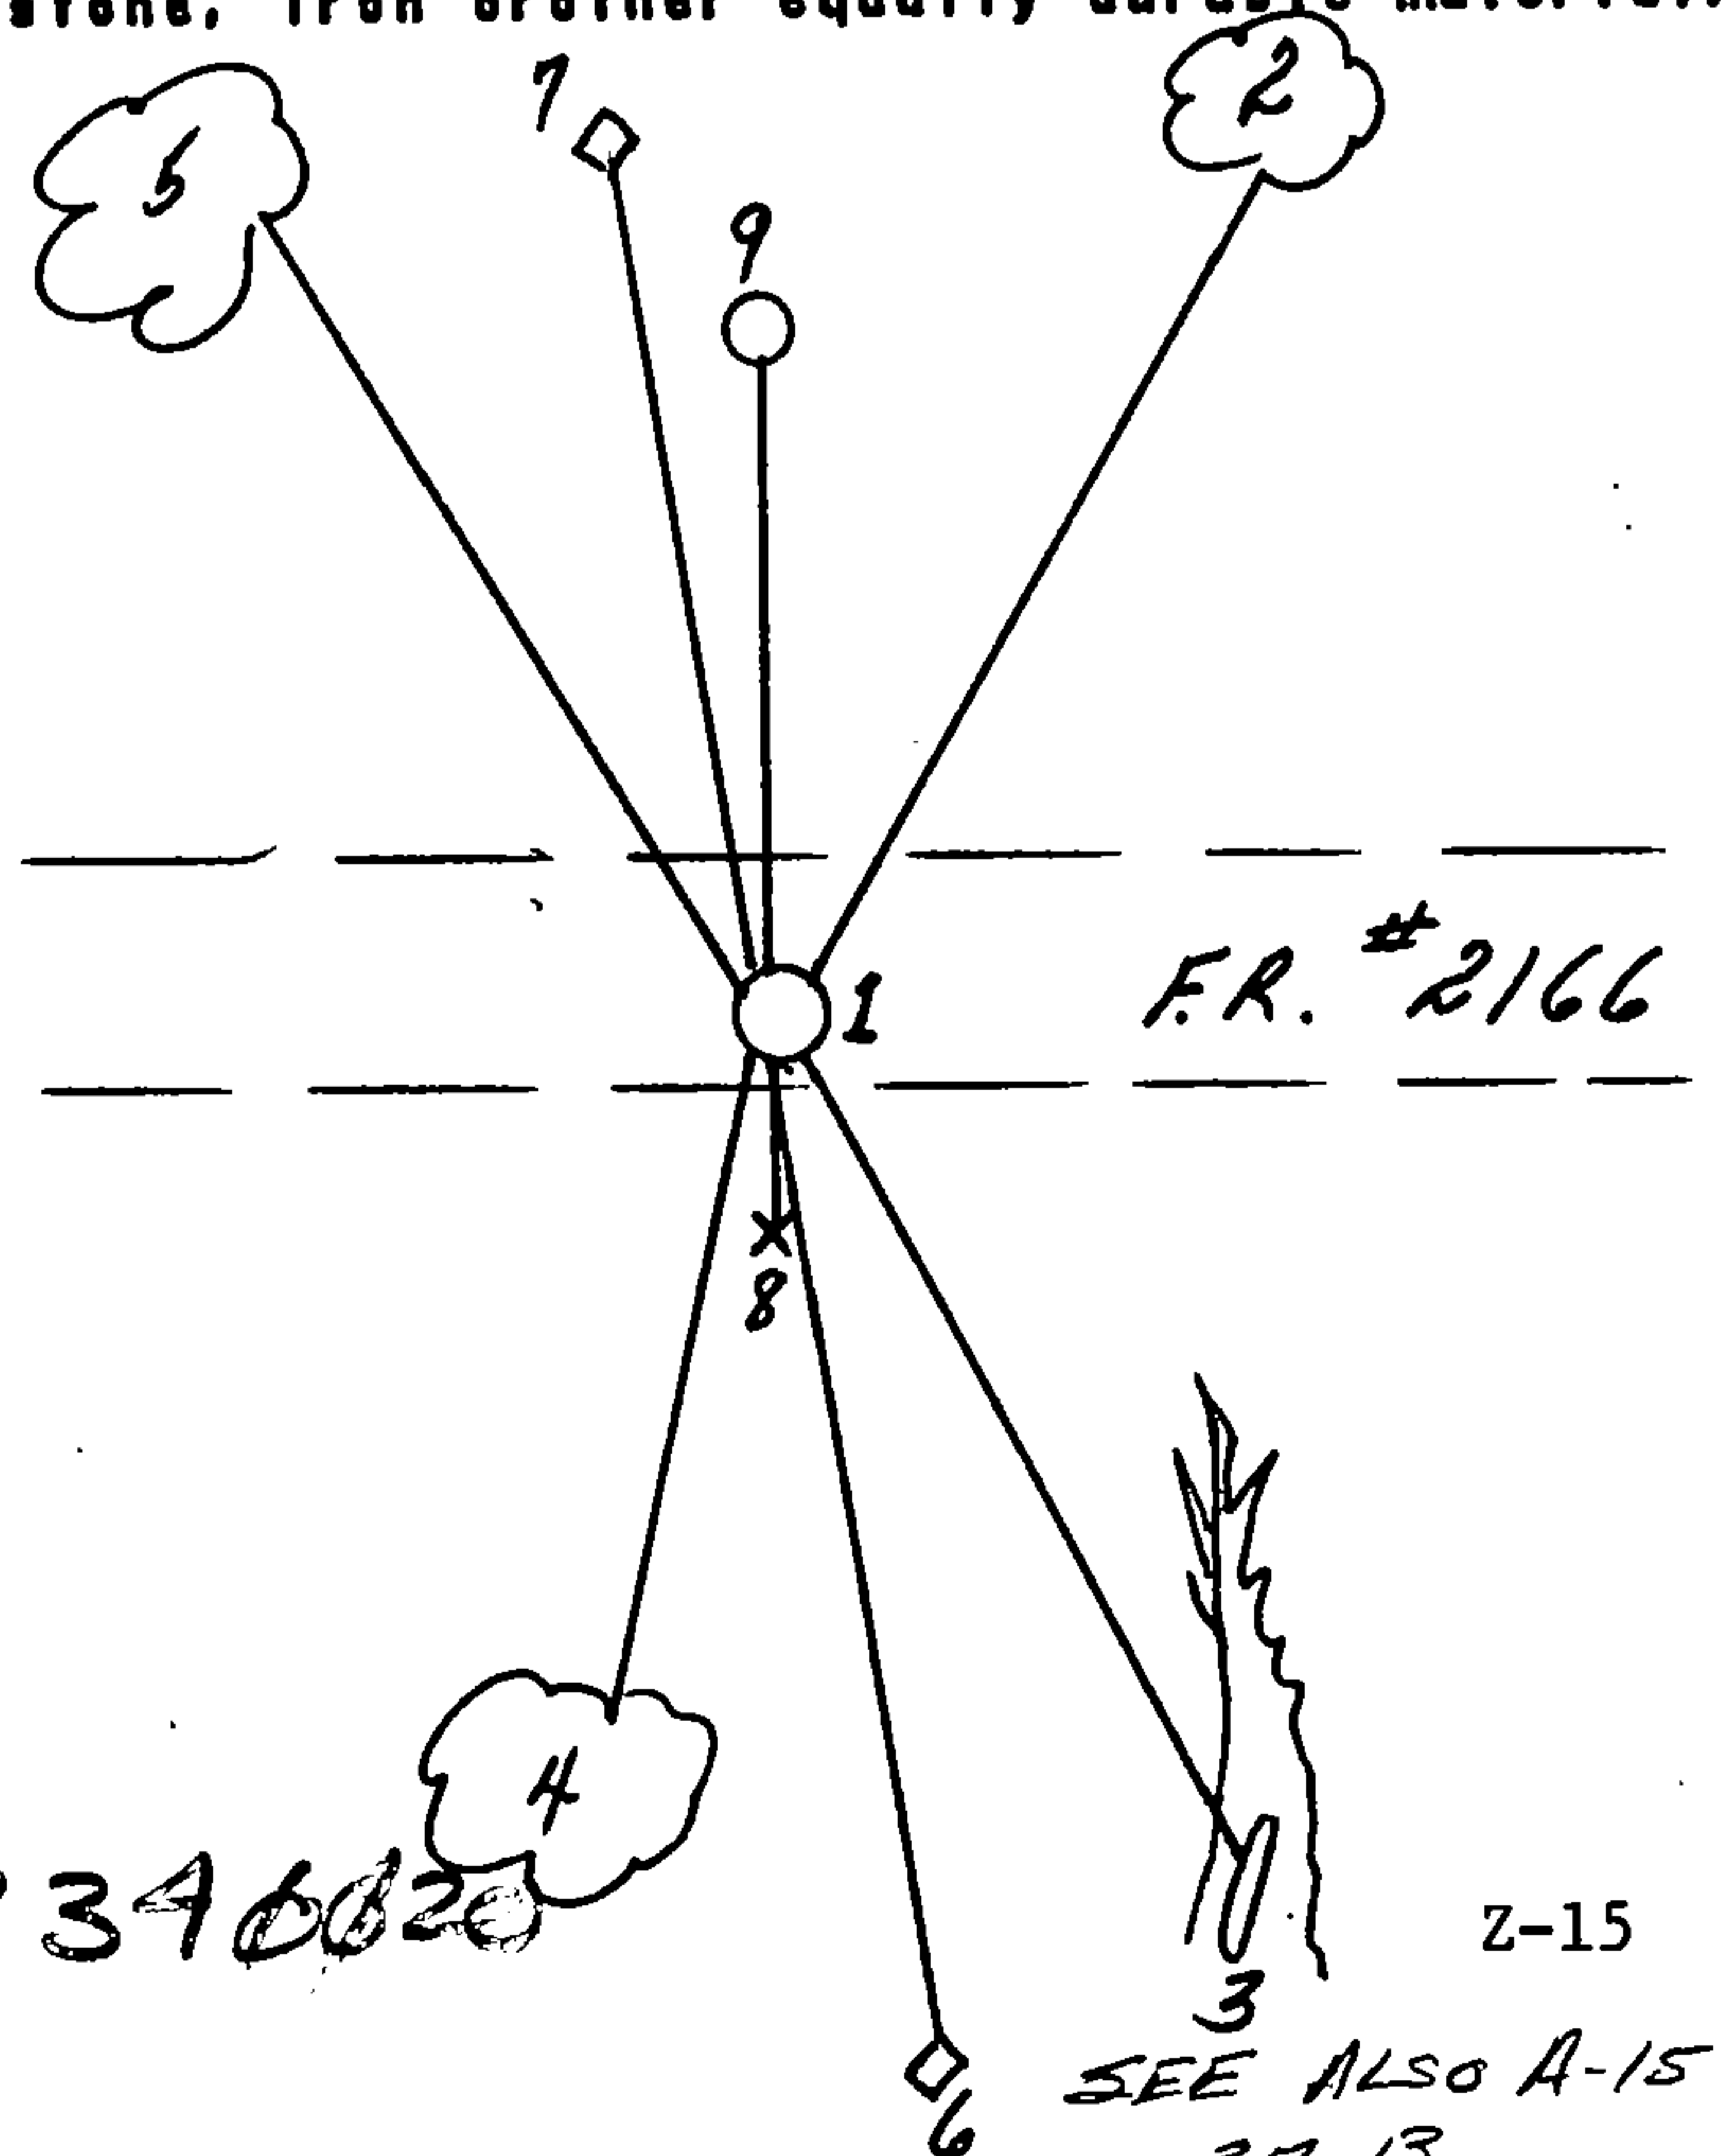

REGISTER'S OFFICE
Forest County, Wis.

Received for record this 9th day
of March A.D., 19 93 at
9:15 o'clock A.M. and recorded
in Vol. 38-13 Corner Restorations
page 2-15
Paul Clithro, Deputy
Register of Deeds

43813340020

Z-15

SEE ALSO A-15
37-13

(e) Describe any material discrepancy between the location of the corner as restored or reestablished and the location of that corner as previously restored or reestablished by distance and direction. Show the discrepancy on the plan view drawing under (d). above. Show the distances between the corner as previously restored or reestablished and (1) the corner as restored or reestablished, and (2) to at least 2 of the witness monuments shown on the drawing in (d), above.

N/A

(f) Was the corner restored through acceptance of (1) an obliterated evidence location, or, (2) a found perpetuated location?

(2)

(g & h) Was the corner reestablished through lost corner proportionate methods? If so, show the method, including the directions and distances to other public land survey corners used as evidence or used for proportioning in determining the corner location?

N/A

(1) I, Milo E. Stefan
(type or print name) certify that the corner location shown on this record was determined by me or under my direction and control and that this U.S. Public Land Survey Monument Record is correct and complete to the best of my knowledge and belief.



Milo E. Stefan
Signature

November 20, 1992
Date

CERTIFICATE READY FOR FILING:


Dale R. Covey
Acting District Ranger

U. S. PUBLIC LAND SURVEY MONUMENT RECORD

INSTRUCTIONS: This record shall show the location of the corner and shall include all of the following nine elements (a through i).

- (a) Identify the corner by reference to the U.S. public land survey system.
- = Corner monument restored.

Quarter corner to Sections 3 and 34, T.37-38N., R.13E.

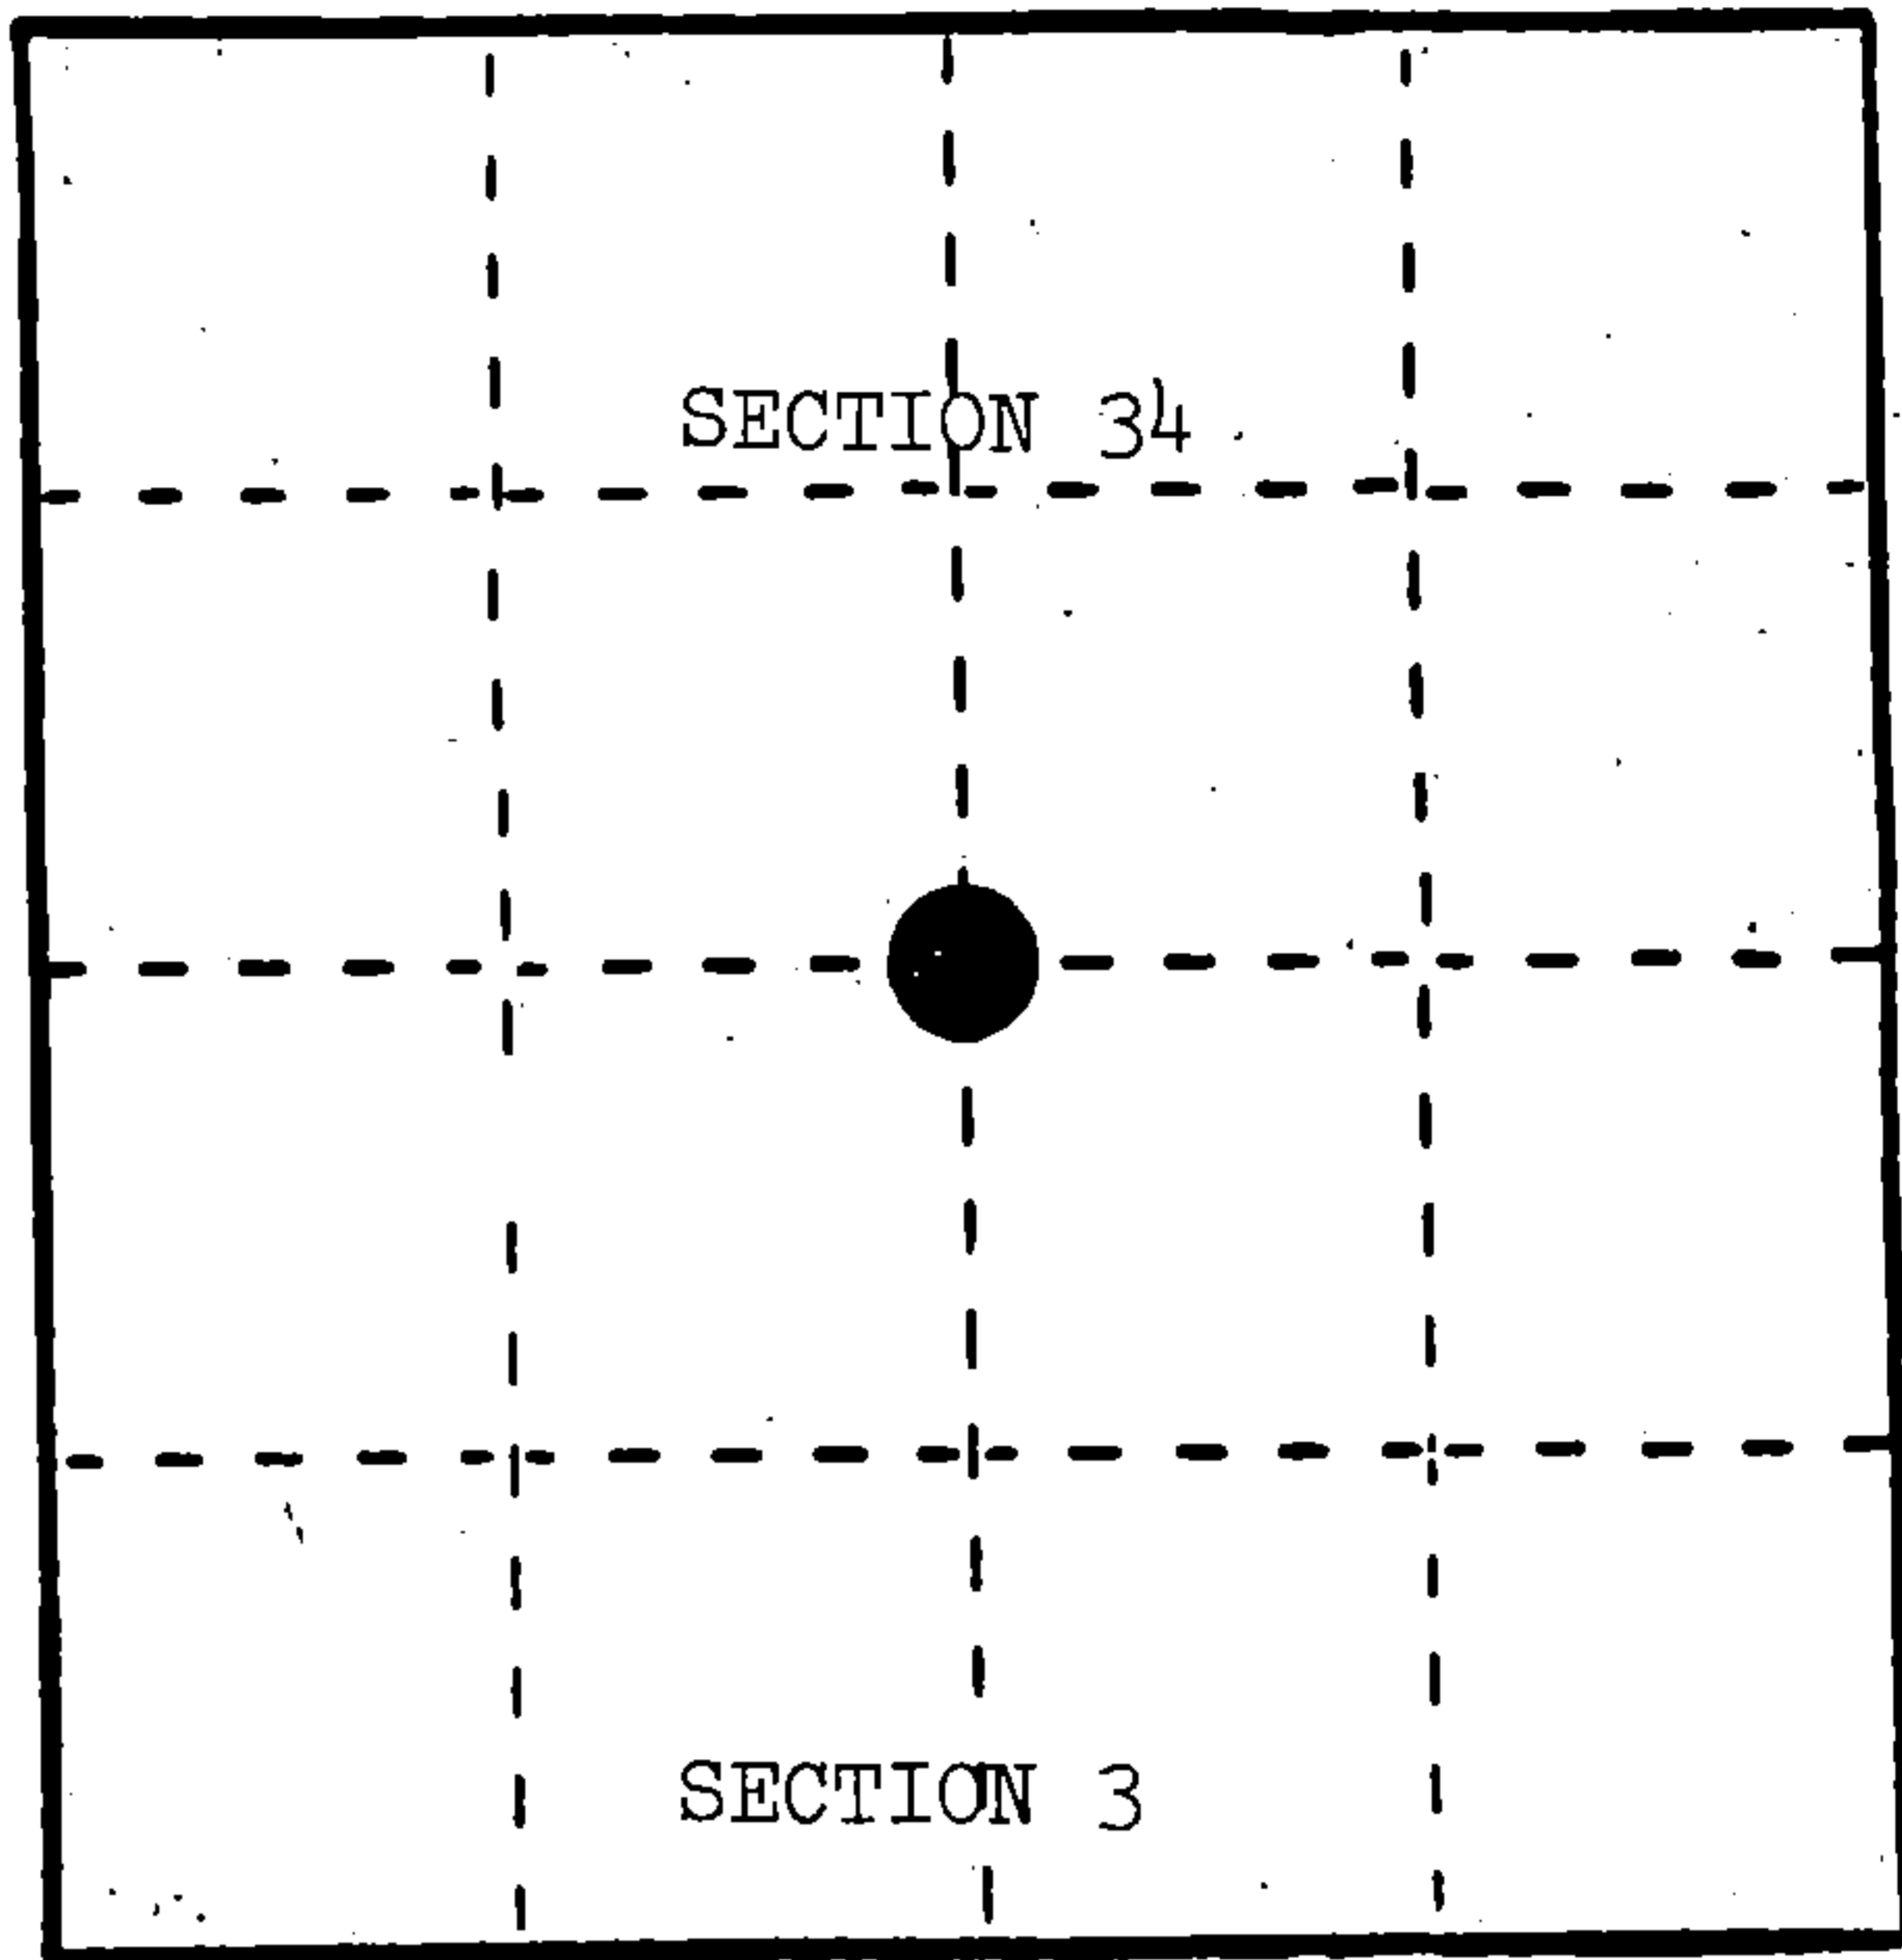

- (b) Describe any record evidence, monument evidence, occupational evidence, testimonial evidence, or any other material evidence you considered, and whether the monument was found or placed.

Corner established at 40.00 chains by Alfred Millard in June, 1858.

December 17, 1936, H. O. Nixon found Cedar post about to be covered by road construction and set two witness posts as follows: 4" x 4" Cedar post, S.10°E., 74.5 links; 4" x 4" Cedar post, N.12°W., 119.0 links.


July 7, 1965, Jean F. Resvick found Nixon's witness posts and restored Cedar post in road with a 6" concrete monument with brass cap.

September 11, 1984, Milo Stefan found monument broken off by grader and replaced concrete monument with a 2" x 60" aluminum monument and tablet stamped to identify the corner.

- (c) In the plan view drawing below, provide reference ties to at least 4 witness monuments, or, if the location is within a municipality, to at least 2 witness monuments. (Witness monuments shall be made of concrete, natural stone, iron or other equally durable material.) Describe witness monuments.

- (d) Show a plan view drawing depicting the relevant monuments and reference ties which is sufficient in detail to enable accurate relocation of the corner monument if the corner monument is disturbed. Indicate north.

1. Tamarack, 6", N.30°E., 39.00 feet
2. Tamarack, 6", S.28°E., 48.70 feet
3. Tamarack, 4", S.12°30'W., 23.89 feet
4. Steel Sign Post, South, 8.8 feet
5. 4" x 4" Cedar post, S.10°E., 49.17 feet
6. 4" x 4" Cedar post, N.12°W., 78.54 feet

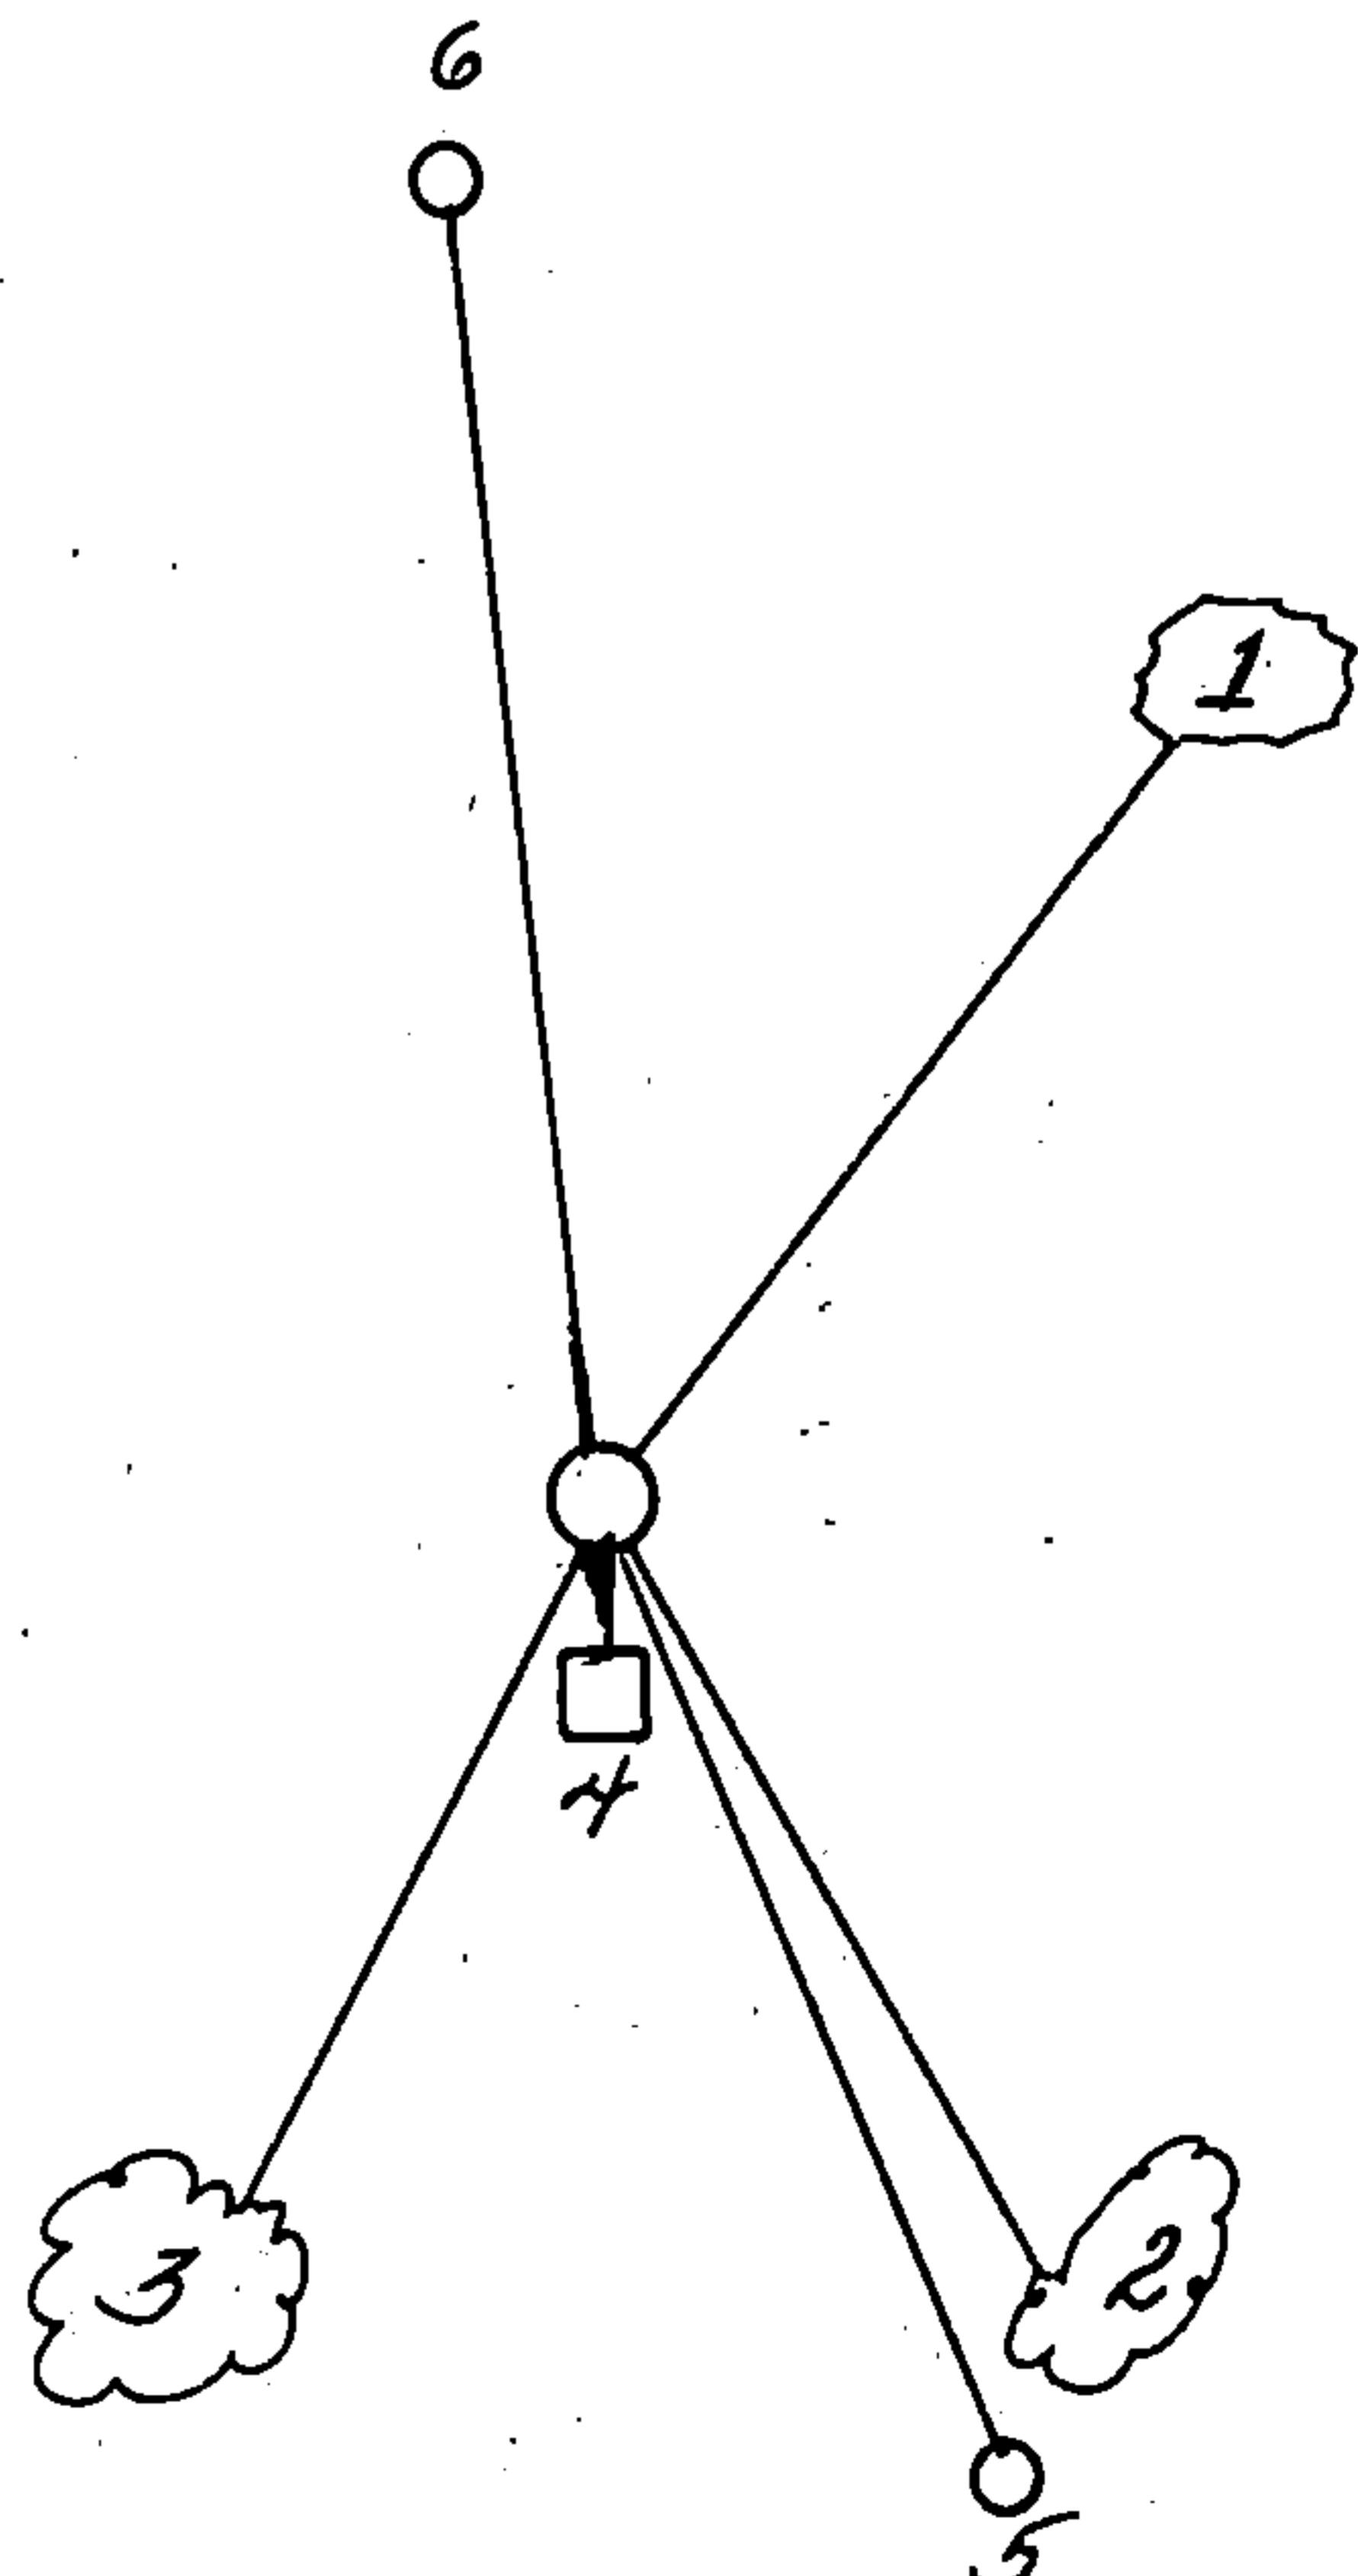

REGISTER'S OFFICE }
Forest County, Wis. }

Received for record this... 1st... day
of April... A. D., 1985 at
2:05... o'clock... P... M. and
recorded in Vol. CORNER RESTORATIONS
on page A-15
Paul Aschambrenner
REGISTER

(e) Describe any material discrepancy between the location of the corner as restored or reestablished and the location of that corner as previously restored or reestablished by distance and direction. Show the discrepancy on the plan view drawing under (d), above. Show the distances between the corner as previously restored or reestablished and (1) the corner as restored or reestablished, and (2) to at least 2 of the witness monuments shown on the drawing in (d), above.

None.

(f) Was the corner restored through acceptance of (1) an obliterated evidence location, or, (2) a found perpetuated location?

(2) a found perpetuated location.

(g&h) Was the corner reestablished through lost corner proportionate methods? If so, show the method, including the directions and distances to other public land survey corners used as evidence or used for proportioning in determining the corner location?

Affix Land Surveyor Seal



(i) I, Milo E. Stefan
(type or print name) certify that the corner location shown on this record was determined by me or under my direction and control and that this U.S. Public Land Survey Monument Record is correct and complete to the best of my knowledge and belief.

Milo E. Stefan
Signature

1/18/85
Date

CERTIFIED LAND CORNER RESTORATION

State of Wisconsin }
County of Forest } ss.

I Jean F. Resvick, do hereby certify that on the 7th day of July, 1965, I found evidence of the north quarter corner of Section 3 Township 37 North, Range 13 East, Fourth Principal Meridian, as described hereon; and that from this evidence I established a new monument and accessories as described hereon to perpetuate the original location of this corner:

Description of original monument and accessories and subsequent restorations:


- Surveyed in 1865 by J. L. Nowlin
- 40.00 chains west between Sec. 3 and 34 set post
- Tamarack 11 ins., N 18°E, 36 lks.
- Tamarack 8 ins., S 16°W, 54 lks.
- 7.00 chains East leave Tamarack swamp
- 8.00 chains West leave Tamarack swamp
- U.S. Forest Service form 874-9 dated 12/17/36 by H. O. Nixon records finding cedar post to be covered with road fill and post witnessed by two 4x4 cedar posts.
- 4 x 4 cedar post bears, S 10° E, 74.5 lks.
- 4 x 4 cedar post bears, N 12° W, 119 lks.

Description of corner evidence found:


4 x 4 cedar witness posts found in place. At point located from witness posts dug and found cedar post in south shoulder of road fill.

Description of monument and accessories I established to perpetuate the original location of this corner:

Replace cedar post in south shoulder of road with 6 ins. diam. concrete monument, 4 feet long, top just below the surface of road shoulder, with brass cap marked.

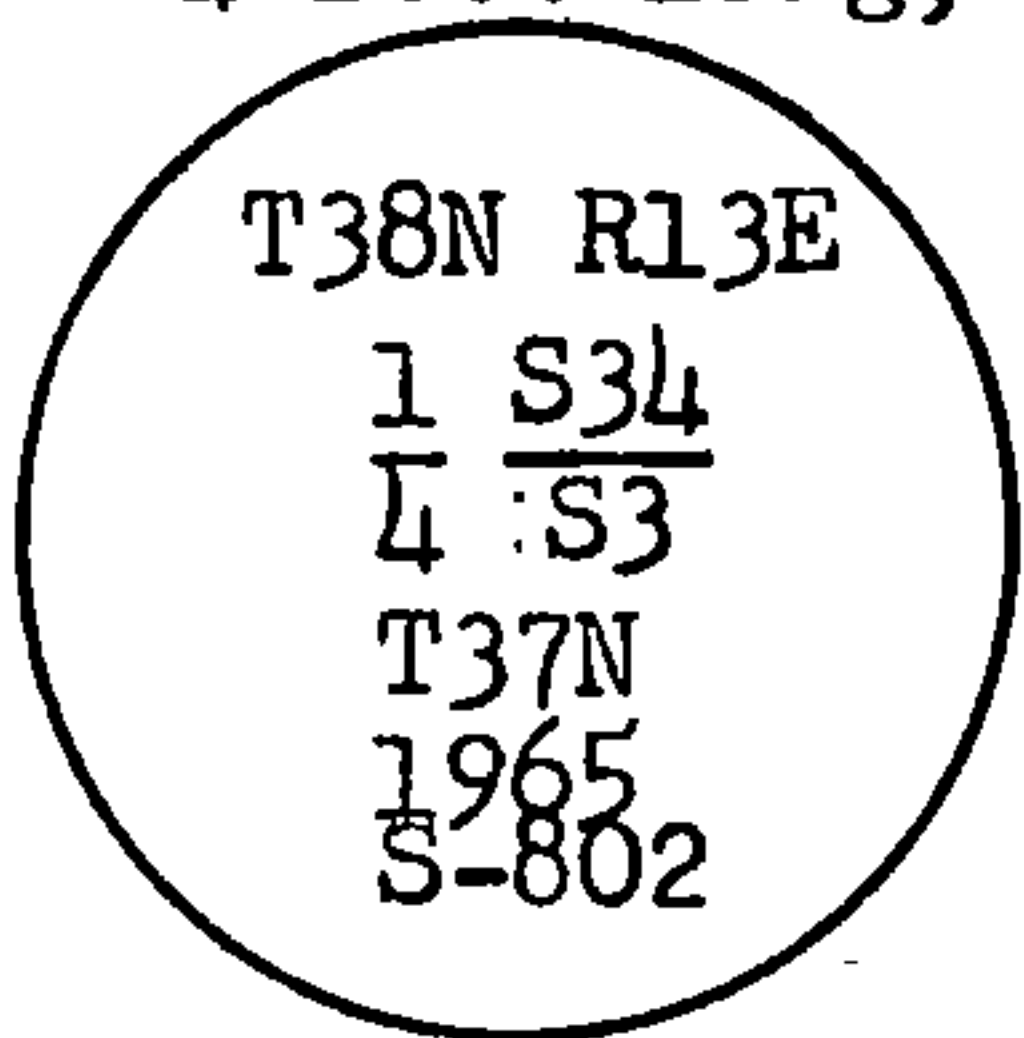

from which the following new bearing trees bear.
Tamarack 6 ins., N 30° E, 39.00 ft. or 59.09 lks.
Tamarack 4 ins., S 12° 30'W, 23.89 ft. or 36.20 lks.
4 x 4 pine post, south, 8 ft. or 12.12 lks.
Old 4 x 4 cedar witness post still in place.

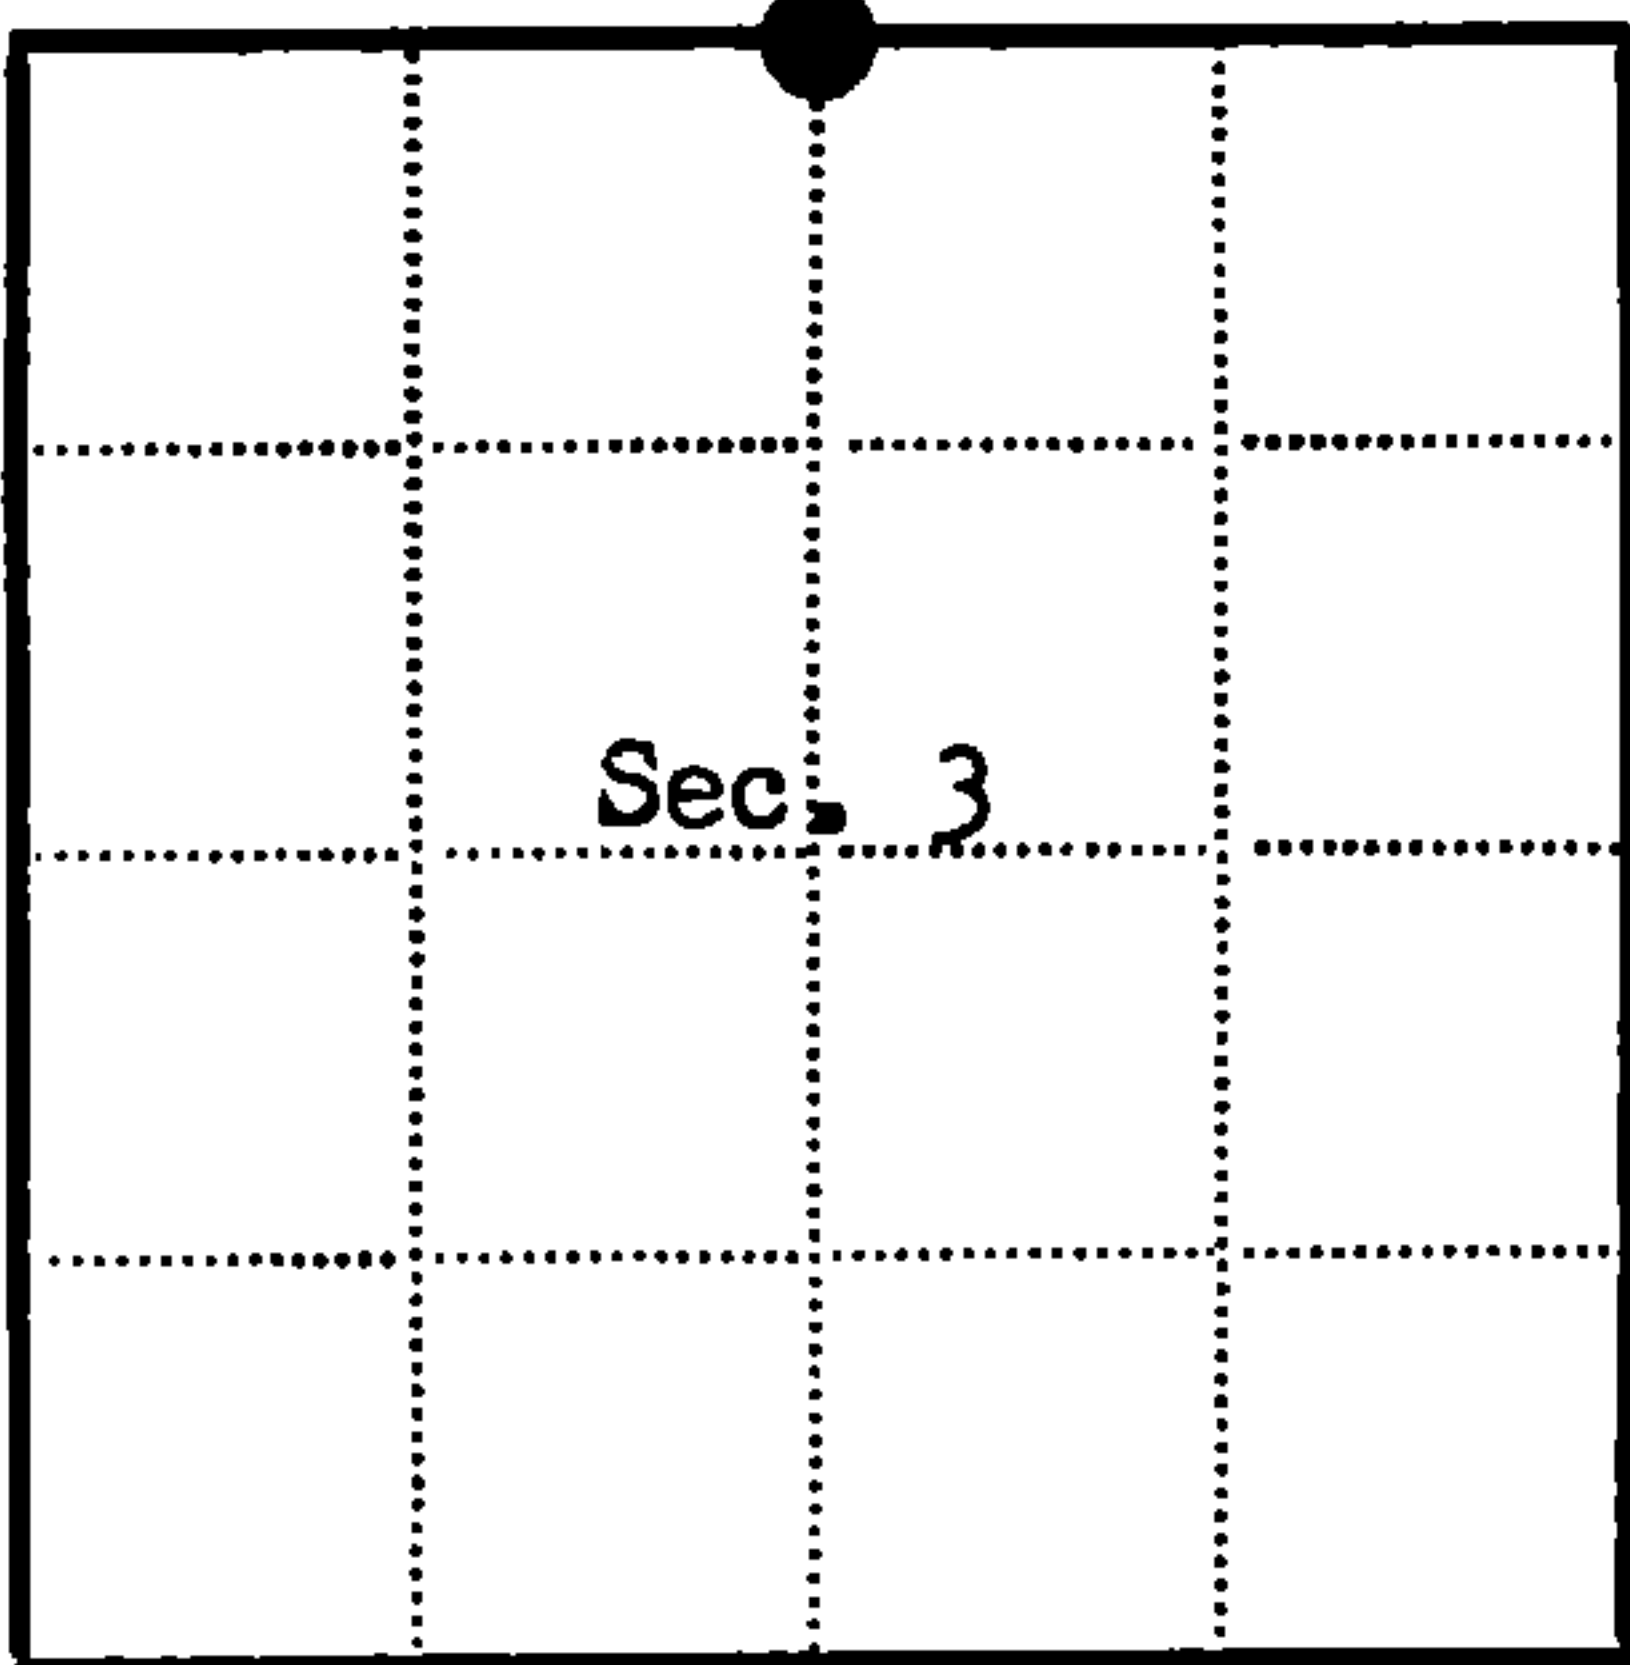

● = Corner monument restored
□ =

Resident witnesses.....

Dated at Rhinelander Wisconsin, this 11th day of Feb. 1966.

Signature Jean F. Resvick Title Cadastral Surveyor
(County Surveyor, Registered Land Surveyor, or other duly authorized official)

Surveyors Registration No. S-802

01254

Office of Register of Deeds County of Forest
I hereby certify that the within instrument was filed in this office for record on the 13 day of April 1966, and was filed in Book No. Page No. of County Records.

Signature Anna Peterson Title Register of Deeds

Township 37 North, Range 13 East, Section 3, Index No. A-15, Page No.

4381334 0020

A 15