

U.S. PUBLIC LAND SURVEY MONUMENT RECORD

Index No. C-25

State of Wisconsin }
County of Forest } ss.

I, William B. Cochrane, do hereby certify that on the 5th day of October, 1983, I found evidence of the East Quarter corner of Section 1 Township 38, North, Range 14 East, Fourth Principal Meridian, as described hereon; and that from this evidence I established a new monument and accessories as described hereon to perpetuate the original location of this corner.

Resident witnesses:

David Brownell

Tony Tillman

History of original corner establishment:

Original Government Survey in 1857 by Artemas Curtis. North between Sections 1 and 6, 40.00 chains, set Quarter Corner post to Sections 1 and 6, from which the following bear:

Spruce	16"	S84°W	44 lks.
Hemlock	22"	N79°E	7 lks.

Description of corner evidence found:


No original corner evidence was recovered.

The corner position was restored at proportionate distance and on line between the Northeast and Southeast Section Corners of Section 1.

Description of monument and accessories I established to perpetuate the original location of this corner.

At the restored corner position, set a 2½" diameter aluminum pipe monument, 3 feet long, 30 inches in the ground, with an aluminum cap stamped: T38N, R14E, R15E, 1/4, S1, S6, 1983, S-1107. From which the following new blazed and scribed bearing trees bear:

R. Pine	8"	N66°E	22.63 feet
R. Pine	11"	N 4°W	24.69 feet
Steel Sign Post		West	0.50 feet

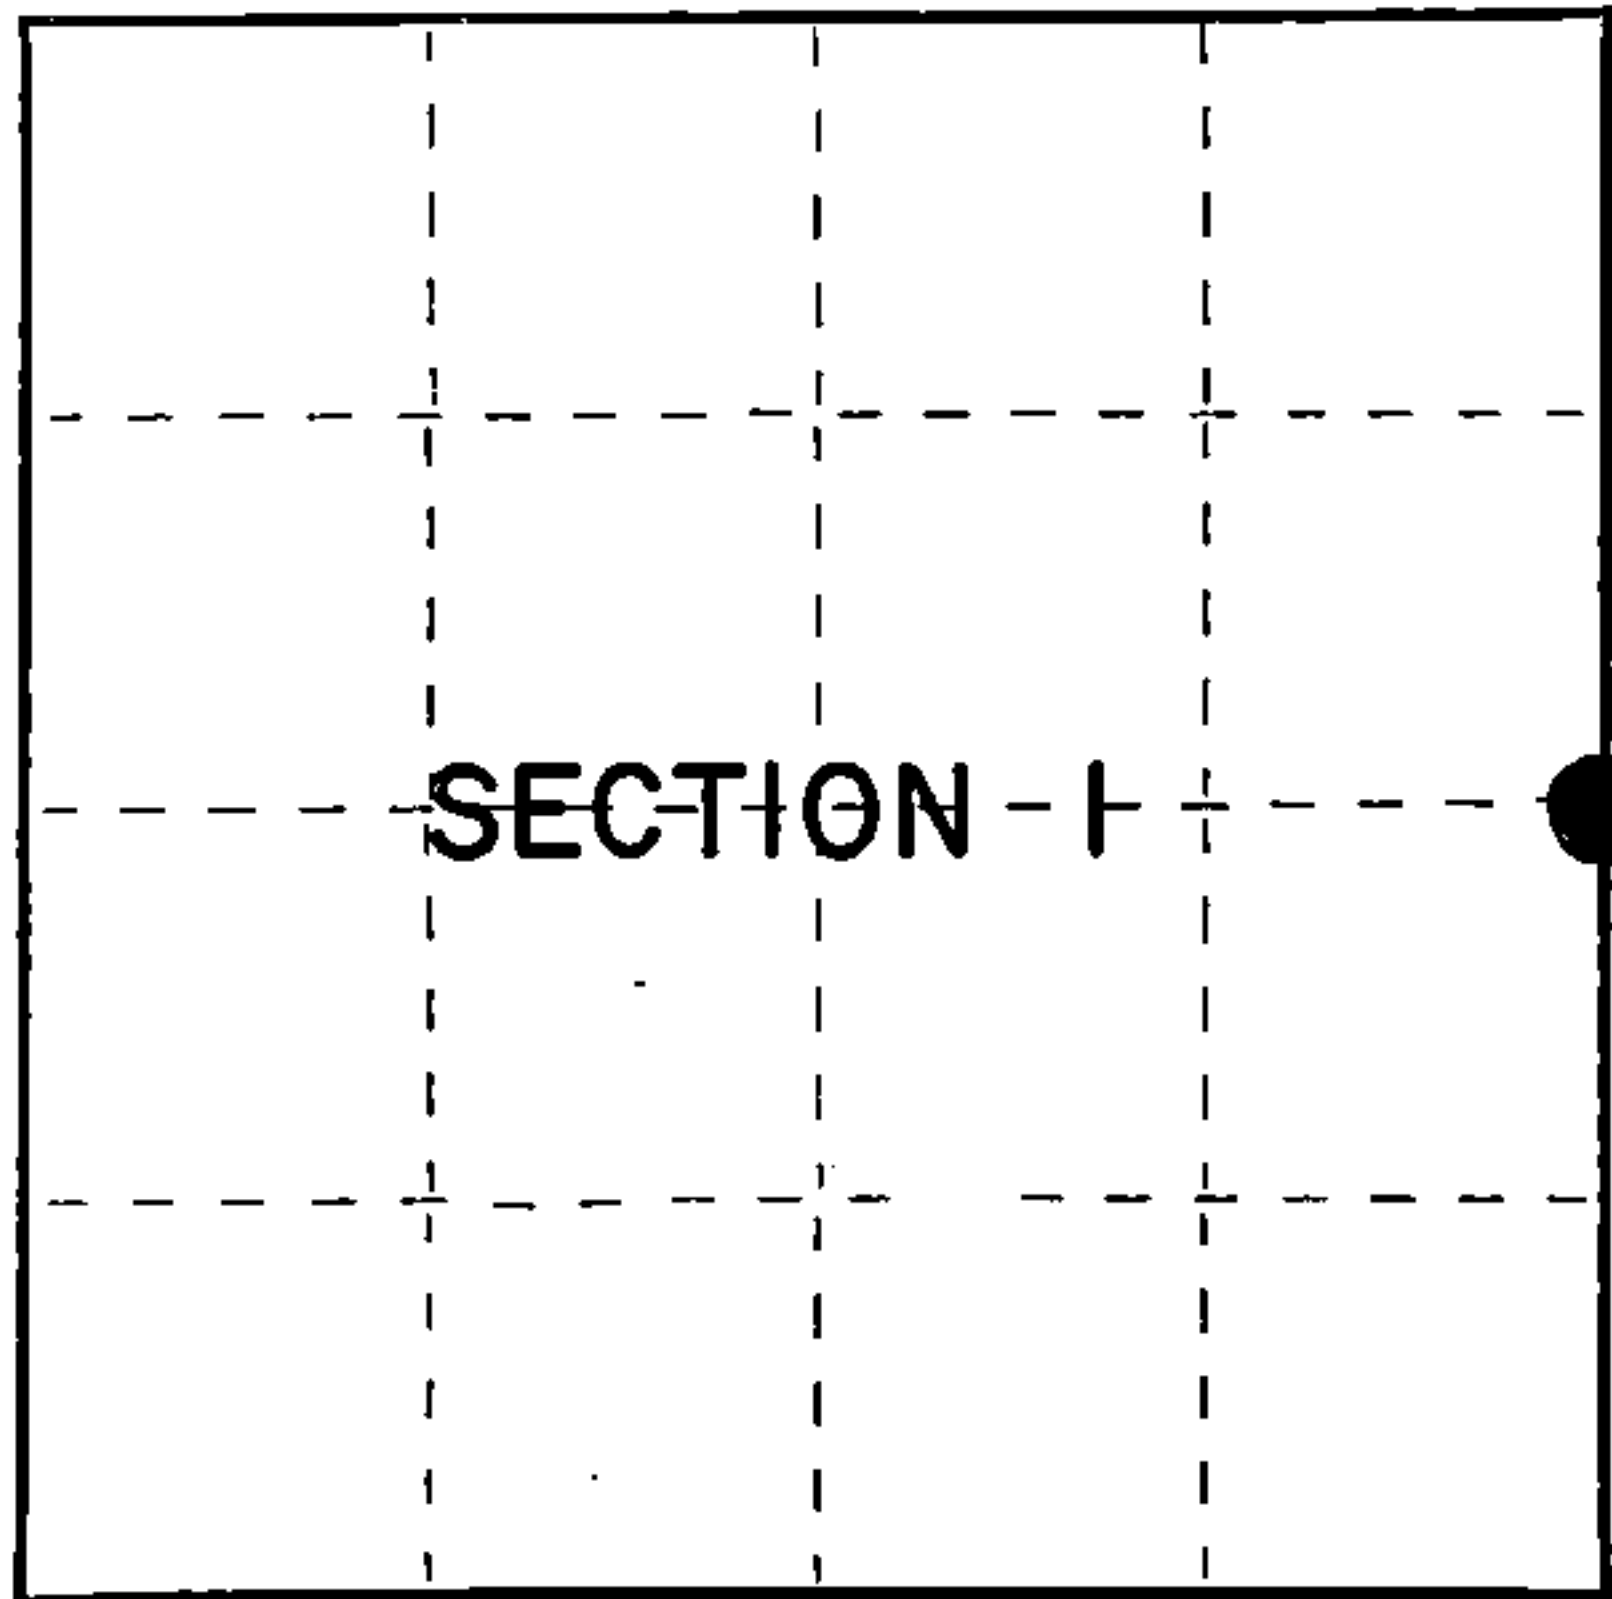

○ = Corner monument restored.

Dated at Hiles, Wis., this 2nd day of April, 1985

Signature: William B. Cochrane, Land Surveyor, Registration No. S-1107
(County Surveyor, Registered Land Surveyor, or other duly authorized official)

Office of Register of Deeds, County of Forest, I hereby certify that the within instrument was filed in this office for record on the 24th day of April, 1985 at 1:00 o'clock P. M.

Paul Aschenbrenner
(Register of Deeds)

By _____ Deputy

FORM NO. 985-A

H.C. Miller Company

Stock No. 26273

Document Number 127888

Handwritten: 413814012988



(e) Describe any material discrepancy between the location of the corner as restored or reestablished and the location of that corner as previously restored or reestablished by distance and direction. Show the discrepancy on the plan view drawing under (d), above. Show the distances between the corner as previously restored or reestablished and (1) the corner as restored or reestablished, and (2) to at least 2 of the witness monuments shown on the drawing in (d), above.

See drawing below.

(f) Was the corner restored through acceptance of (1) an obliterated evidence location, or, (2) a found perpetuated location?

Restored through lost corner proportionate methods.

(g&h) Was the corner reestablished through lost corner proportionate methods? If so, show the method, including the directions and distances to other public land survey corners used as evidence or used for proportioning in determining the corner location?

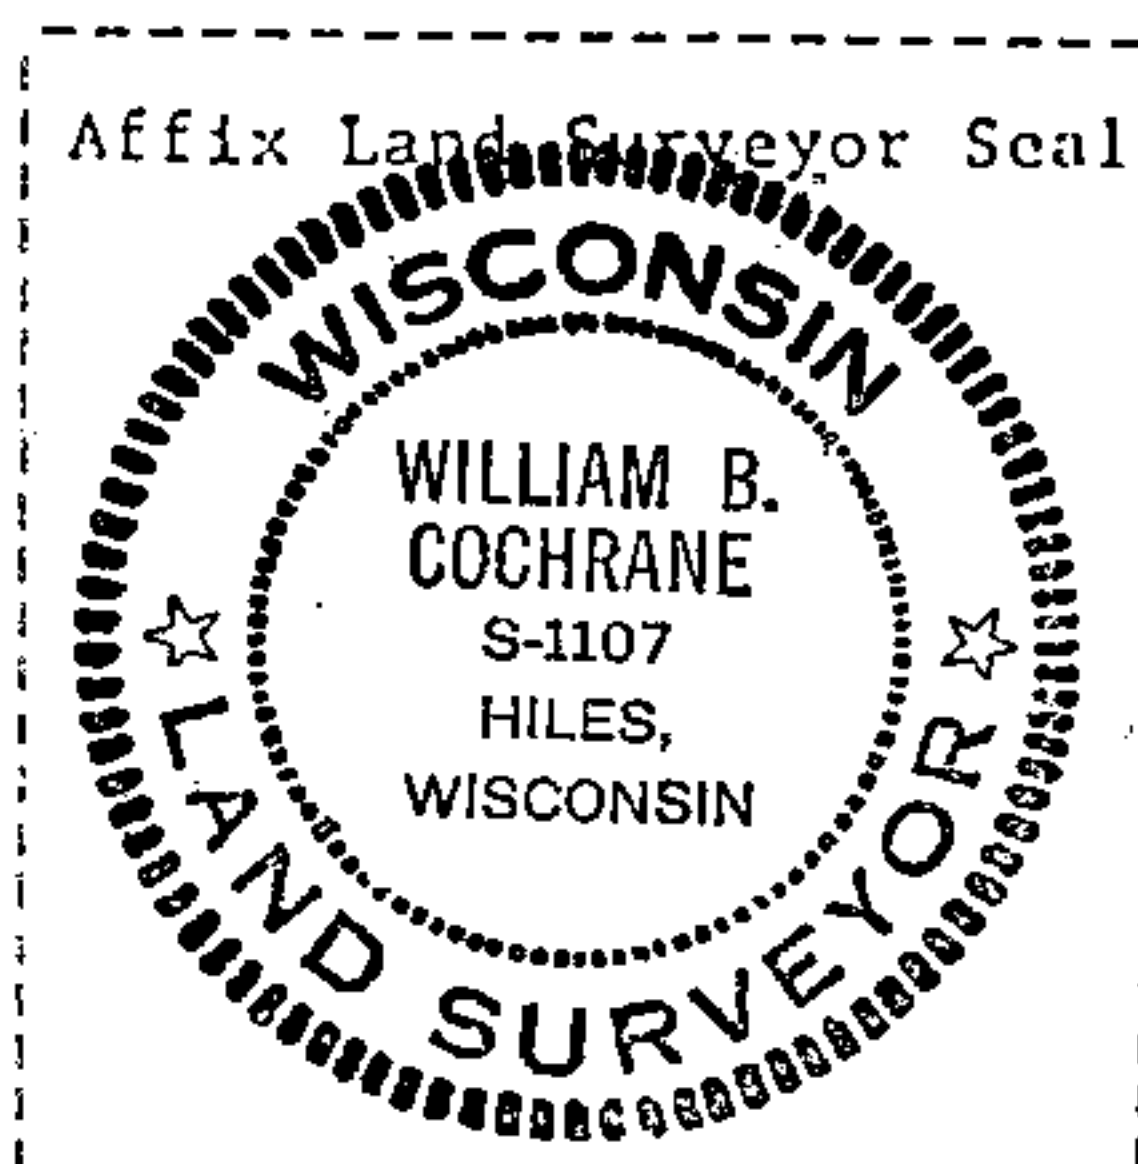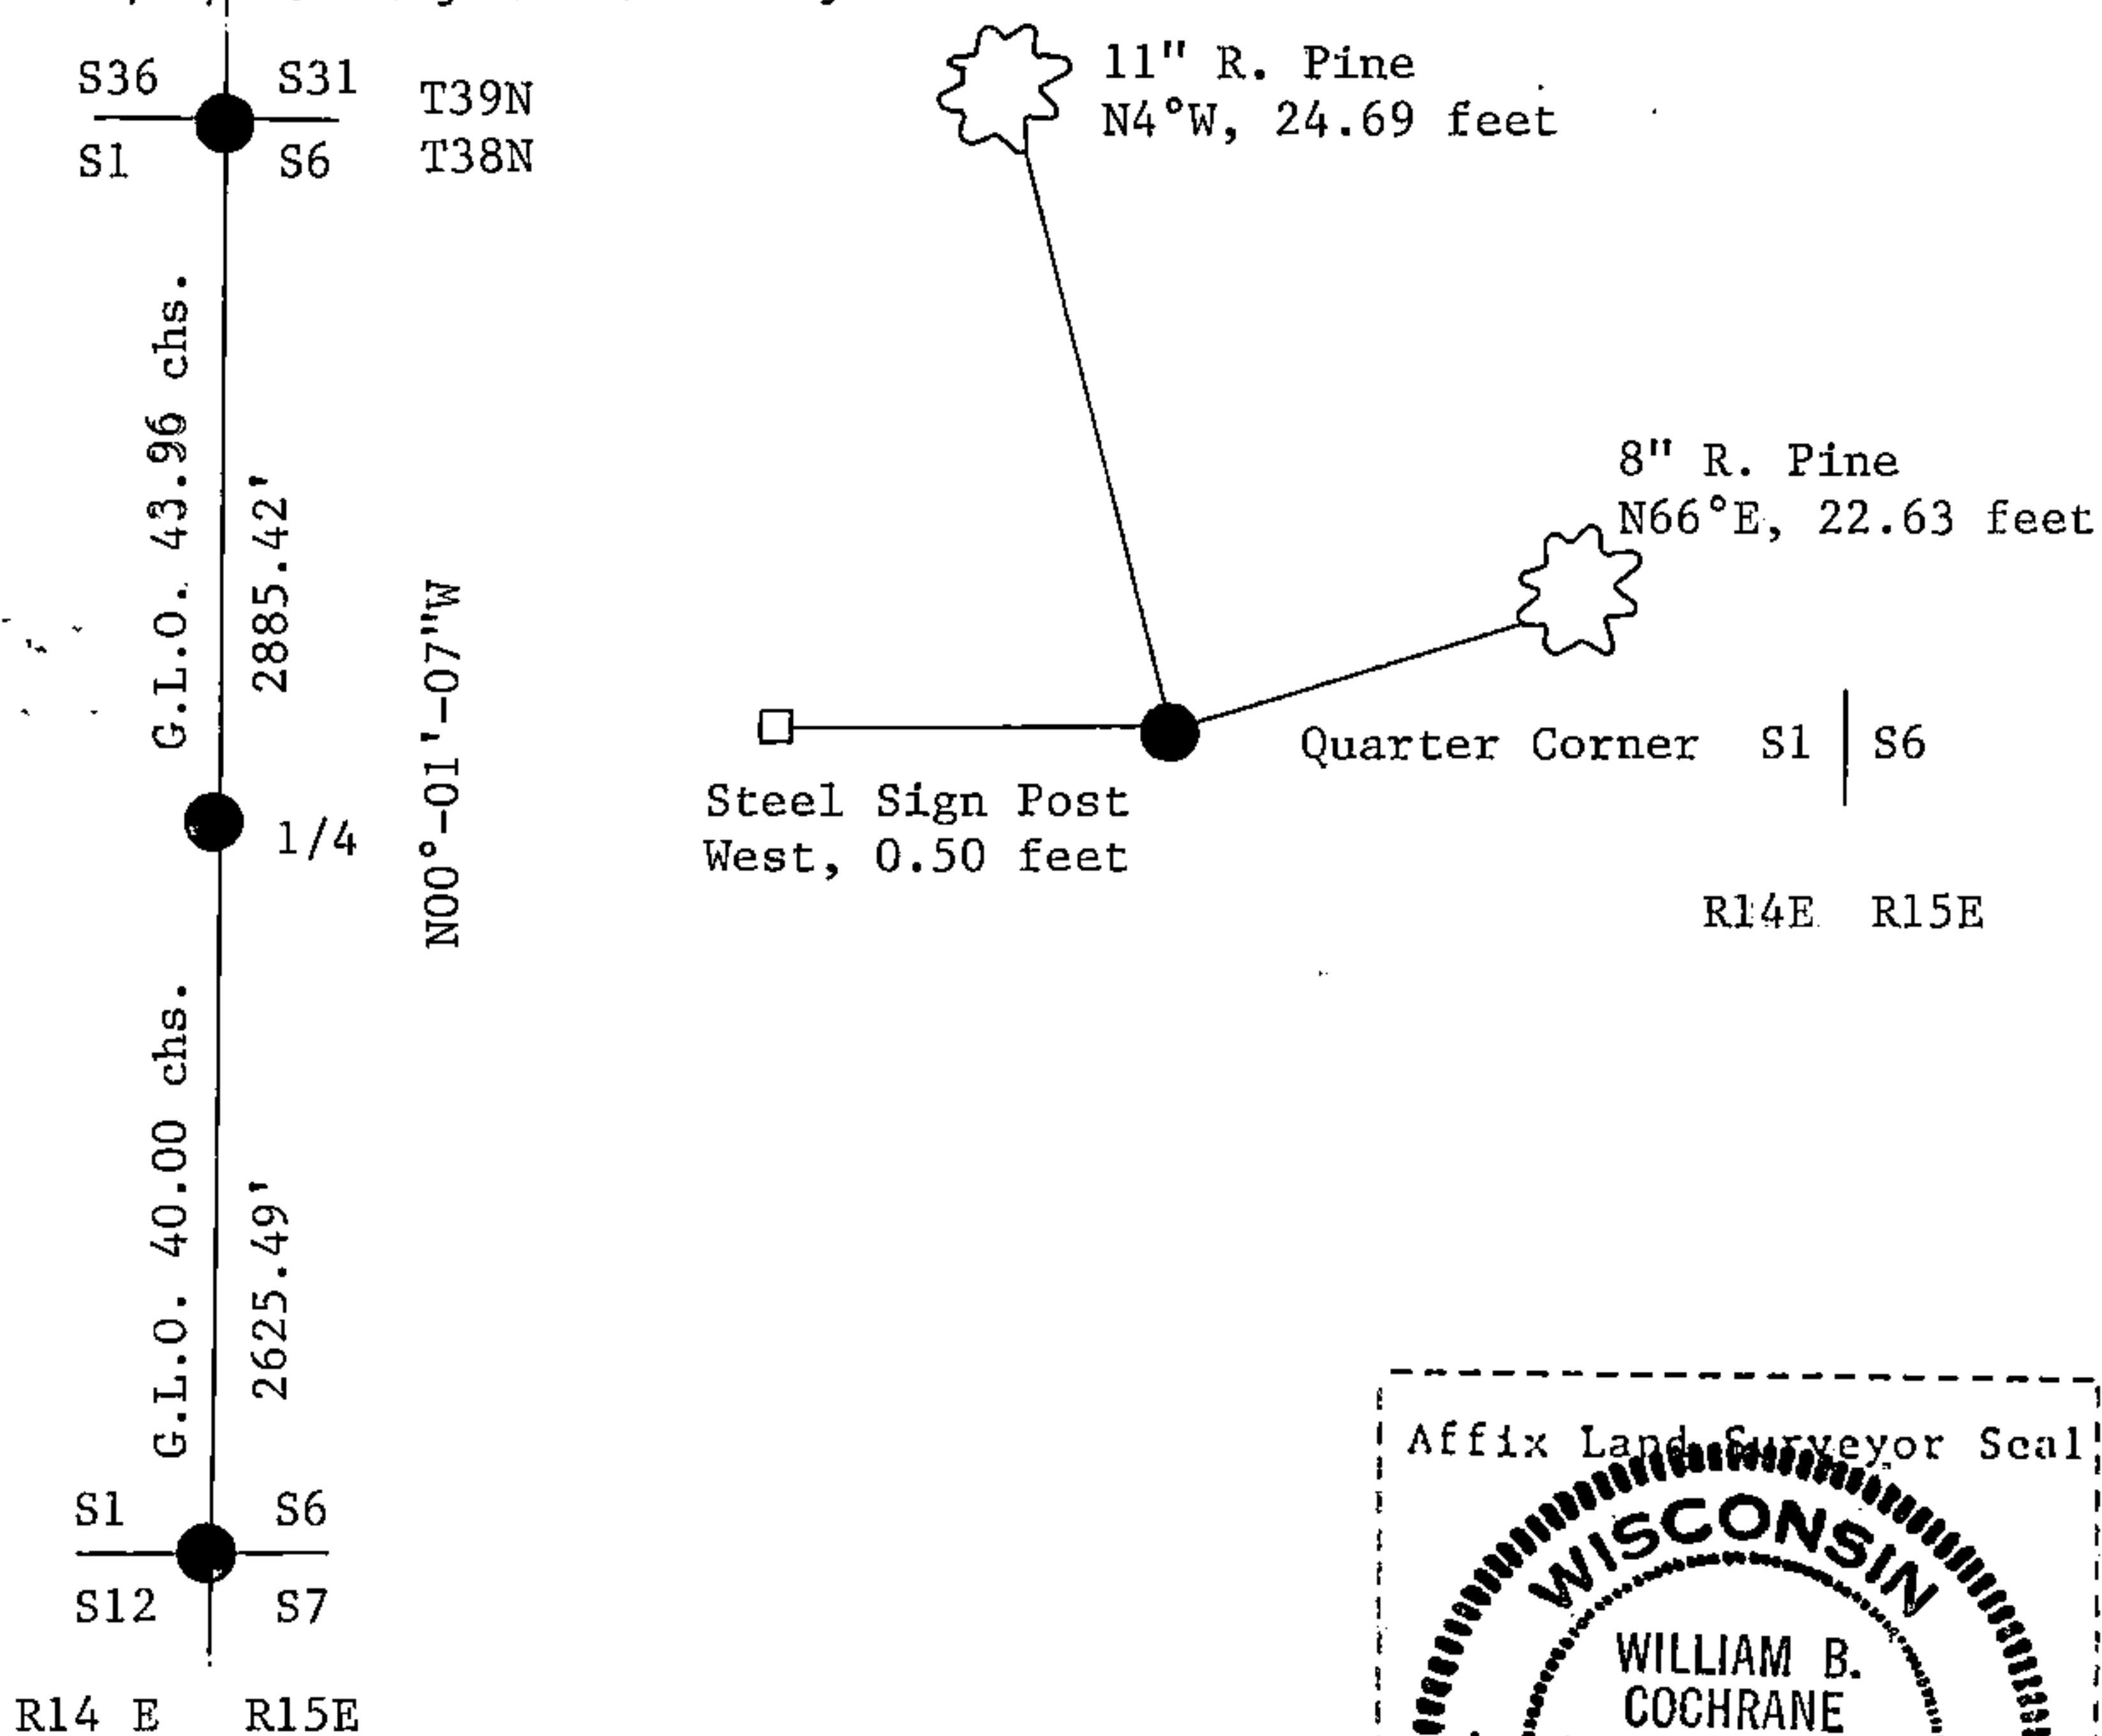

(i) I, William B. Cochrane
 (type or print name) certify that the corner location shown on this record was determined by me or under my direction and control and that this U.S. Public Land Survey Monument Record is correct and complete to the best of my knowledge and belief.

William B. Cochrane
 Signature

April 2, 1985
 Date