

CERTIFIED LAND CORNER RESTORATION

Index No. N-3

State of Wisconsin }
County of Forest } ss.



I, Philip T. Hansen, do hereby
certify that on the 6th day
of February, 1980, I found
evidence of the Quarter
corner of Sections 18 and 19
Township 38, North, Range
14 East, Fourth Principal Meridian,
as described hereon; and that from this evidence
I established a new monument and accessories
as described hereon to perpetuate the original
location of this corner.

Resident witnesses:

Glen Barker

Jim Claflin

Herb Wagoner

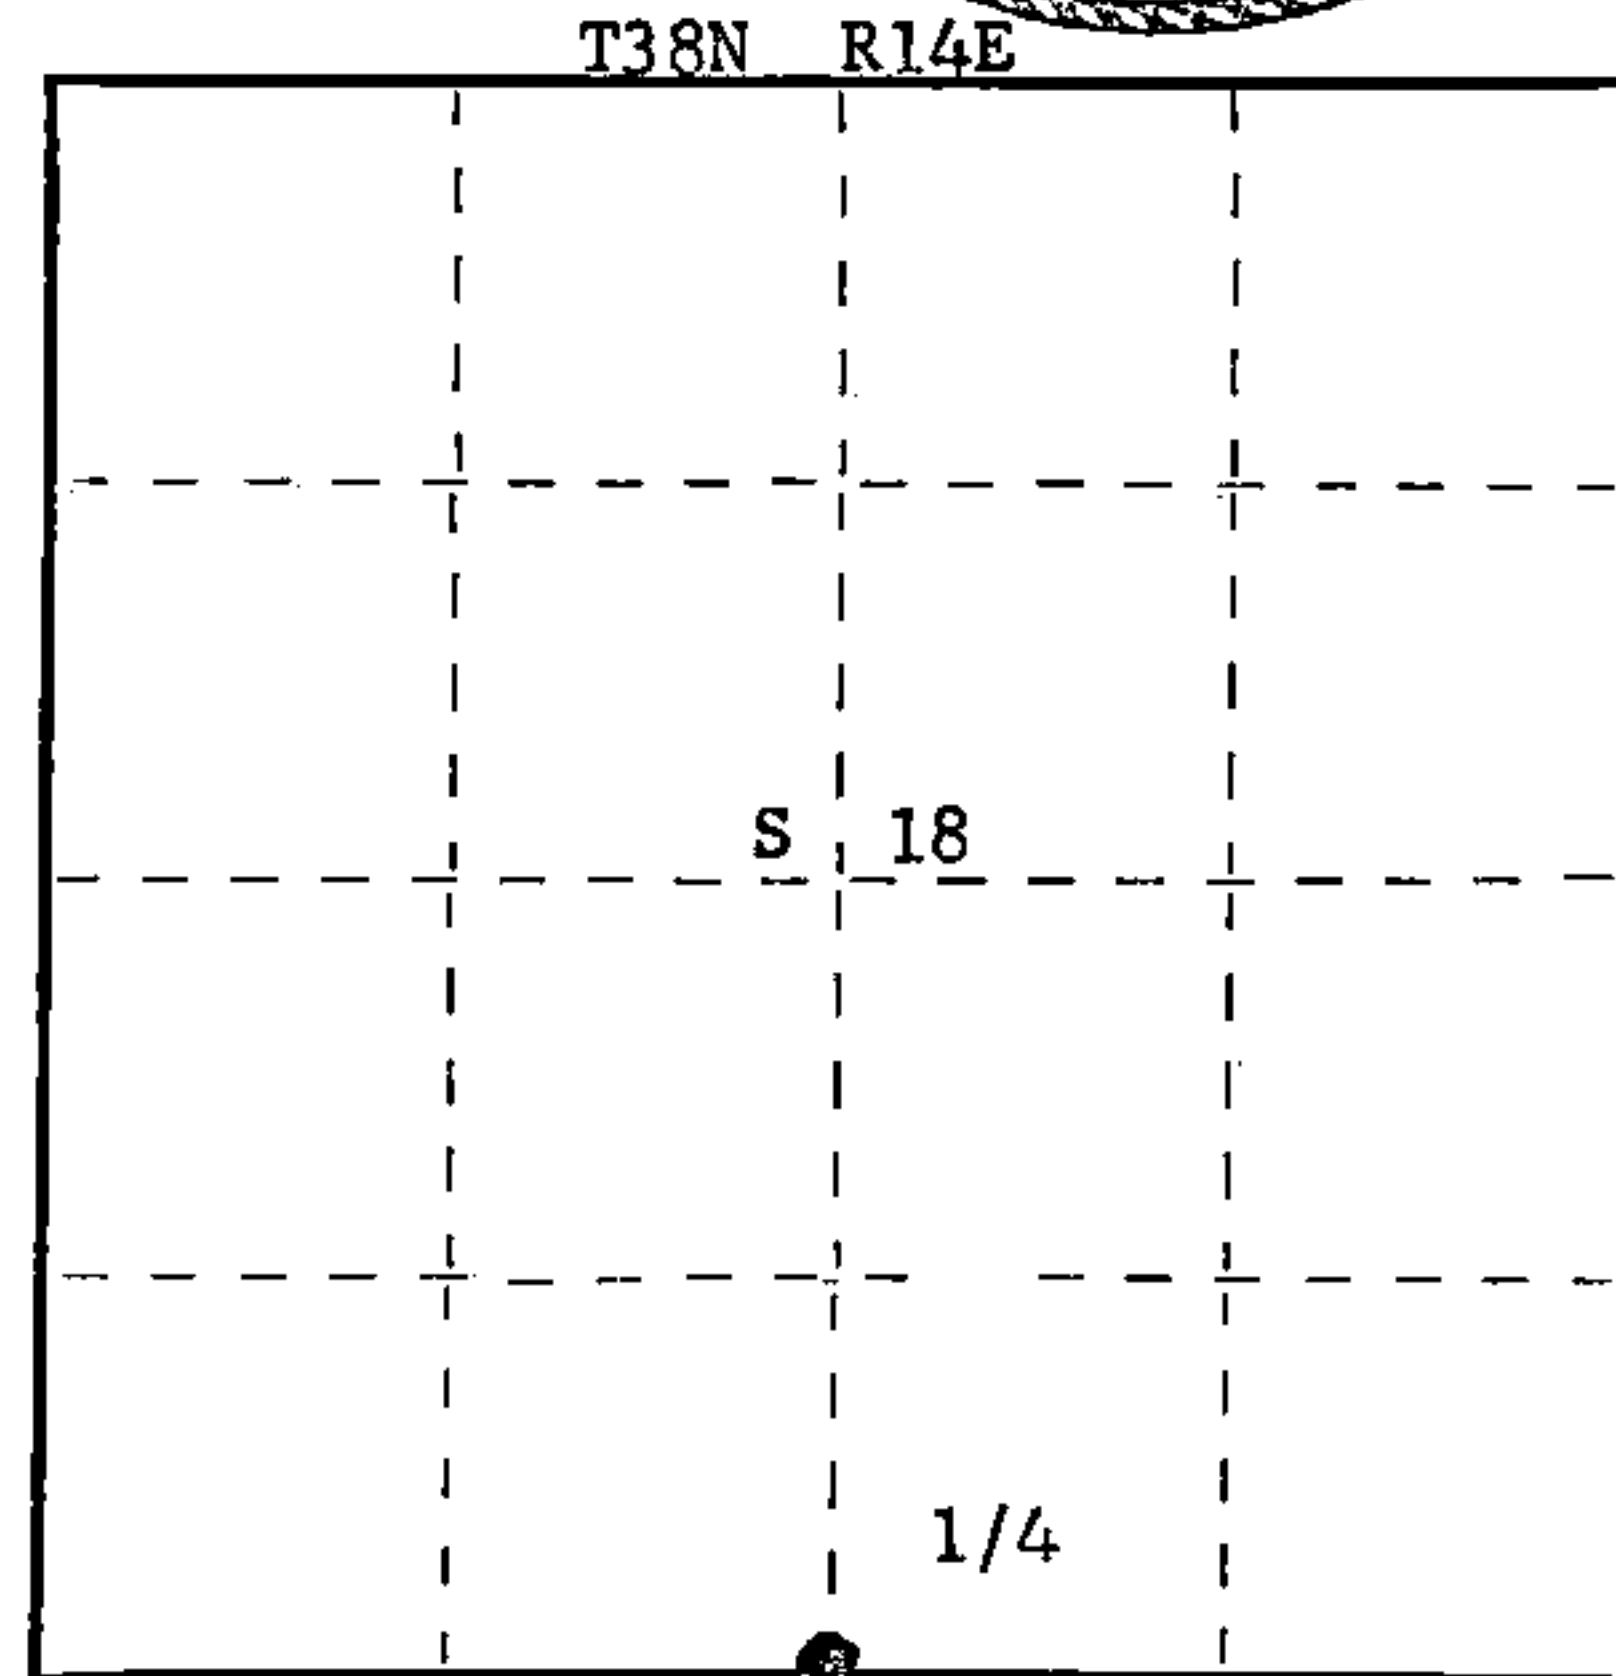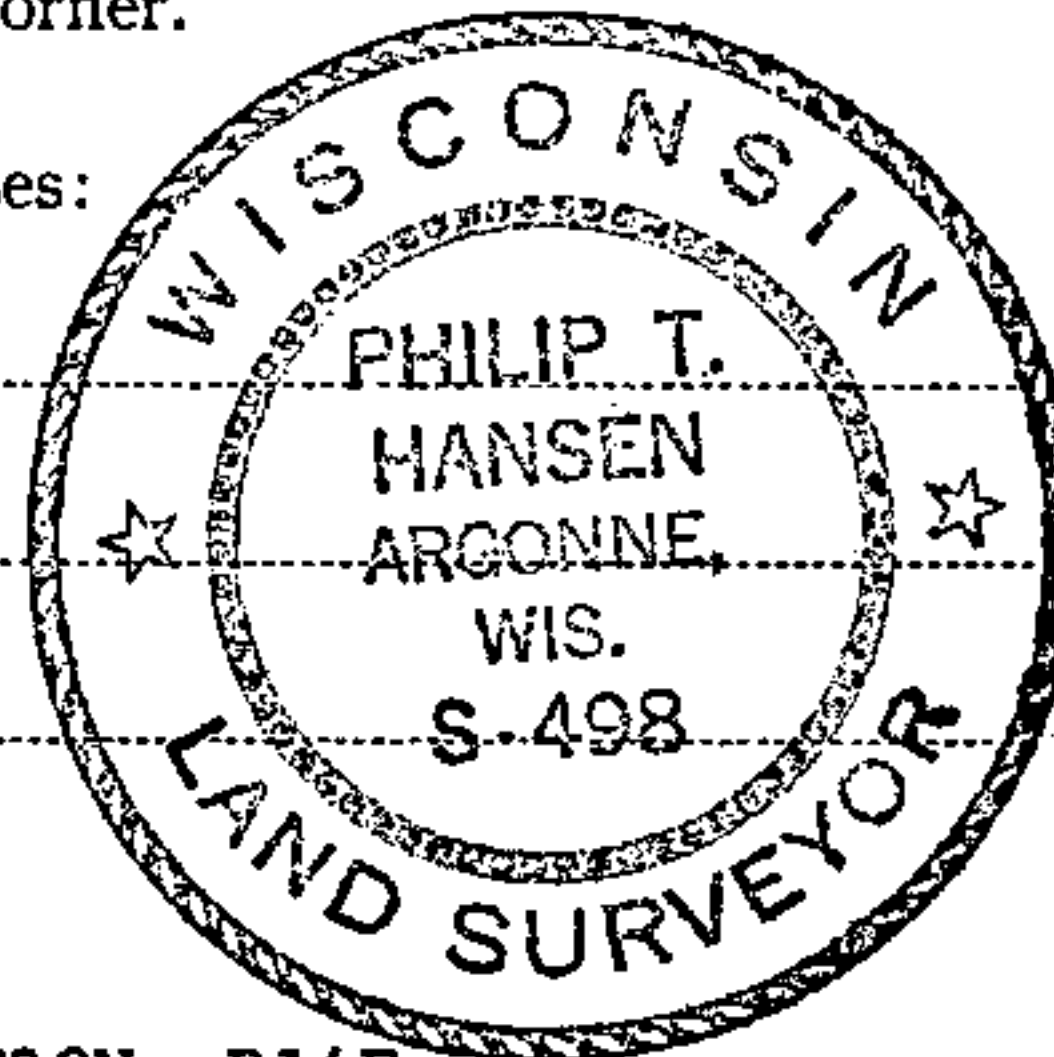

○ = Corner monument restored.

History of original corner establishment:

Description of corner evidence found:

Recovered an old 3" cedar stake, scribing no longer visible. Recovered an old tamarack stump N 49° W 20 links which is believed to be original BT, Tamarack 5" N48°W 20 links. Also found an old blazed line running east from this stake.

Description of monument and accessories I established to perpetuate the original location of this corner.

Replaced cedar stake with 2-1/2" Berntsen A-1 Federal Monument, projecting 12" above ground. Cap stamped:

Set wood post beside new monument.

Marked NBT's -

Cedar 7" S79°E 30.29 feet, scribed 1/4 BT.

Cedar 5" S2°E 24.55 feet, scribed 1/4 BT.

Cedar 5" N26°W 21.02 feet, scribed 1/4 BT.

T38N R14E

1/4 S+18
S+19

S498 - 1980

Dated at Rhineland, Wis., this 27th day of March, 1980

Signature Philip T. Hansen Title Registered Land Surveyor Registration No. S-498
(County Surveyor, Registered Land Surveyor, or other duly authorized official)

Office of Register of Deeds, County of Forest, I hereby certify that the within
instrument was filed in this office for record on the 6th day of May, 1980
at 8:30 o'clock A. M.

Eugene Stutzman
(Register of Deeds)

By _____ Deputy

DOCUMENT NO. **117898**

171022

U. S. PUBLIC LAND SURVEY MONUMENT RECORD

INSTRUCTIONS:

This record shall show the location of the corner and shall include all of the following nine elements (a through I).

- (a) Identify the corner by reference to the U.S. public land survey system.
○ = Corner monument restored.

Section Corners to Sections 17, 18, 19 and 20, T.38N., R.14E., Forest County, Wisconsin.

State Plane Coordinates:

N = 220915.456

E = 2280022.473


Geographic Coordinates

N = 45-45-57.387

W = 88-46-45.411

REGISTER'S OFFICE
Forest County, Wis.
Received for record this 21st day
of March A.D., 2001 at
9:30 o'clock A.M. and recorded
in Vol. Corner Restoration
page N-5

Kay Swanson, Deputy
Register of Deeds

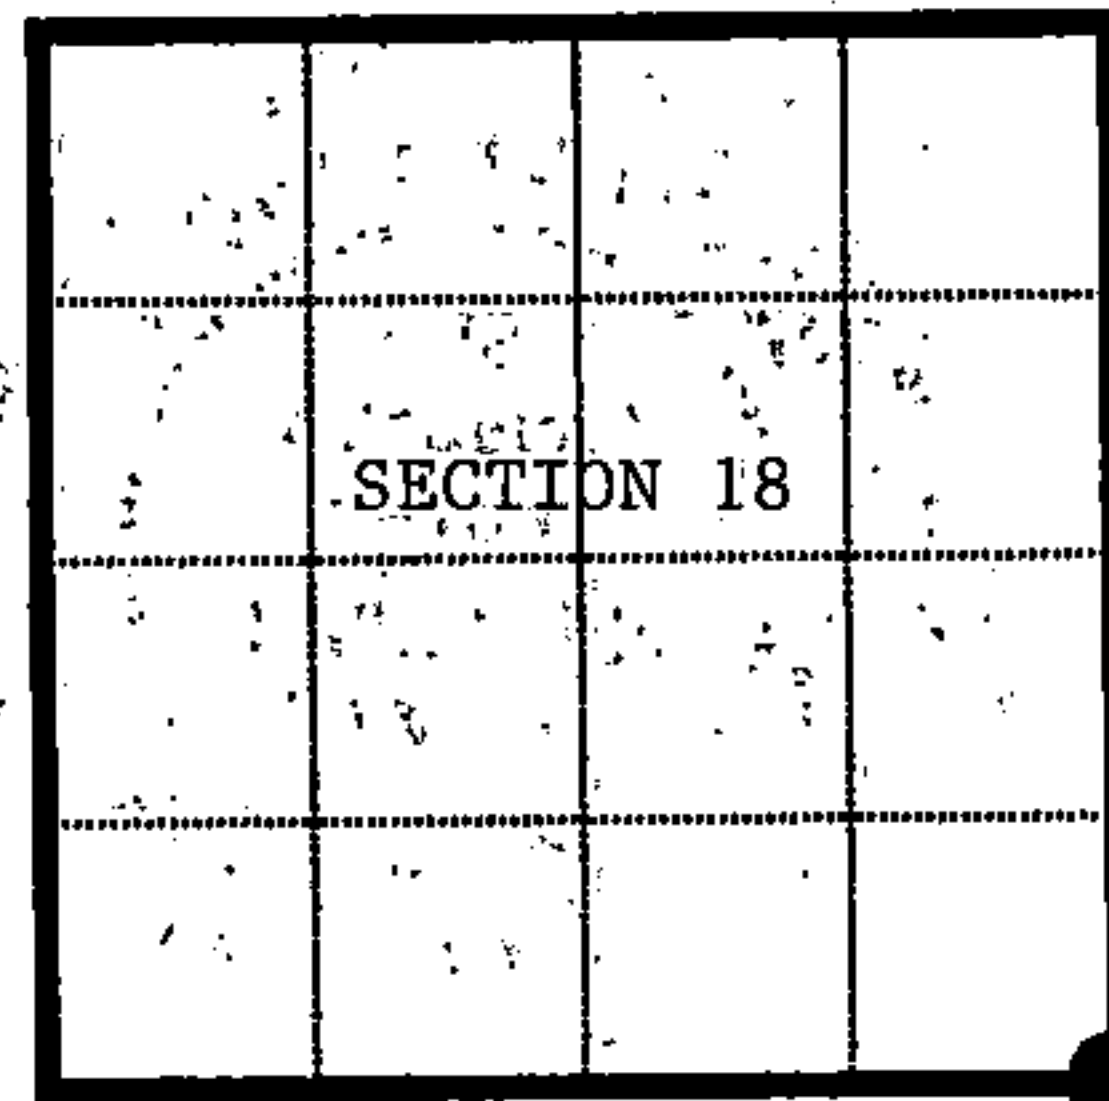

- (b) Describe any record evidence, monument evidence, occupational evidence, testimonial evidence or any other material evidence you considered, and whether the monument was found or placed.


Original Government Survey in 1865 by H. & J.L. Nowlin. North between Sections 19 and 20, at 80.00 chains set wood post from which the following bear; Birch, 12", N.34°E., 37 links, Birch, 14", N.03°W., 40 links.

On 4-22-98, Alan Harrison, RLS with the U.S. Forest Service, searched the corner area using Global Positioning Satellite control. No corner evidence was recovered. The corner position is reestablished using lost corner proportionate methods. At the corner position set a 2 1/2 inch diameter aluminum pipe monument, 3 feet long, 2 1/2 feet in the ground, with an aluminum cap stamped; T.38N., R.14E., S.17, S.18, S.19, S.20, 1998, R.L.S. 1651. Blazed and scribed new bearing trees as noted below.

- (c) In the plan view drawing below, provide reference ties to at least 4 witness monuments, or If the location is within a municipality, to at least 2 witness monuments. (witness monuments shall be made of concrete, natural stone, iron or other equally durable material.)

- (d) Show a plan view drawing depicting the relevant monuments and reference ties which is sufficient in detail to enable accurate relocation of the corner monument if the corner monument is disturbed. Indicate north.

- 1.) 2 1/2" x 36" aluminum monument stamped to identify corner
- 2.) Red Maple, 12", N.13°E., 52.58 feet (new)
- 3.) Red Maple, 12", N.65°E., 91.93 feet (new)
- 4.) Red Maple, 6", S.74°E., 56.42 feet (new)
- 5.) Aspen, 8", N.45°W., 21.93 feet (new)
- 6.) Steel Sign Post, South, 0.90 feet

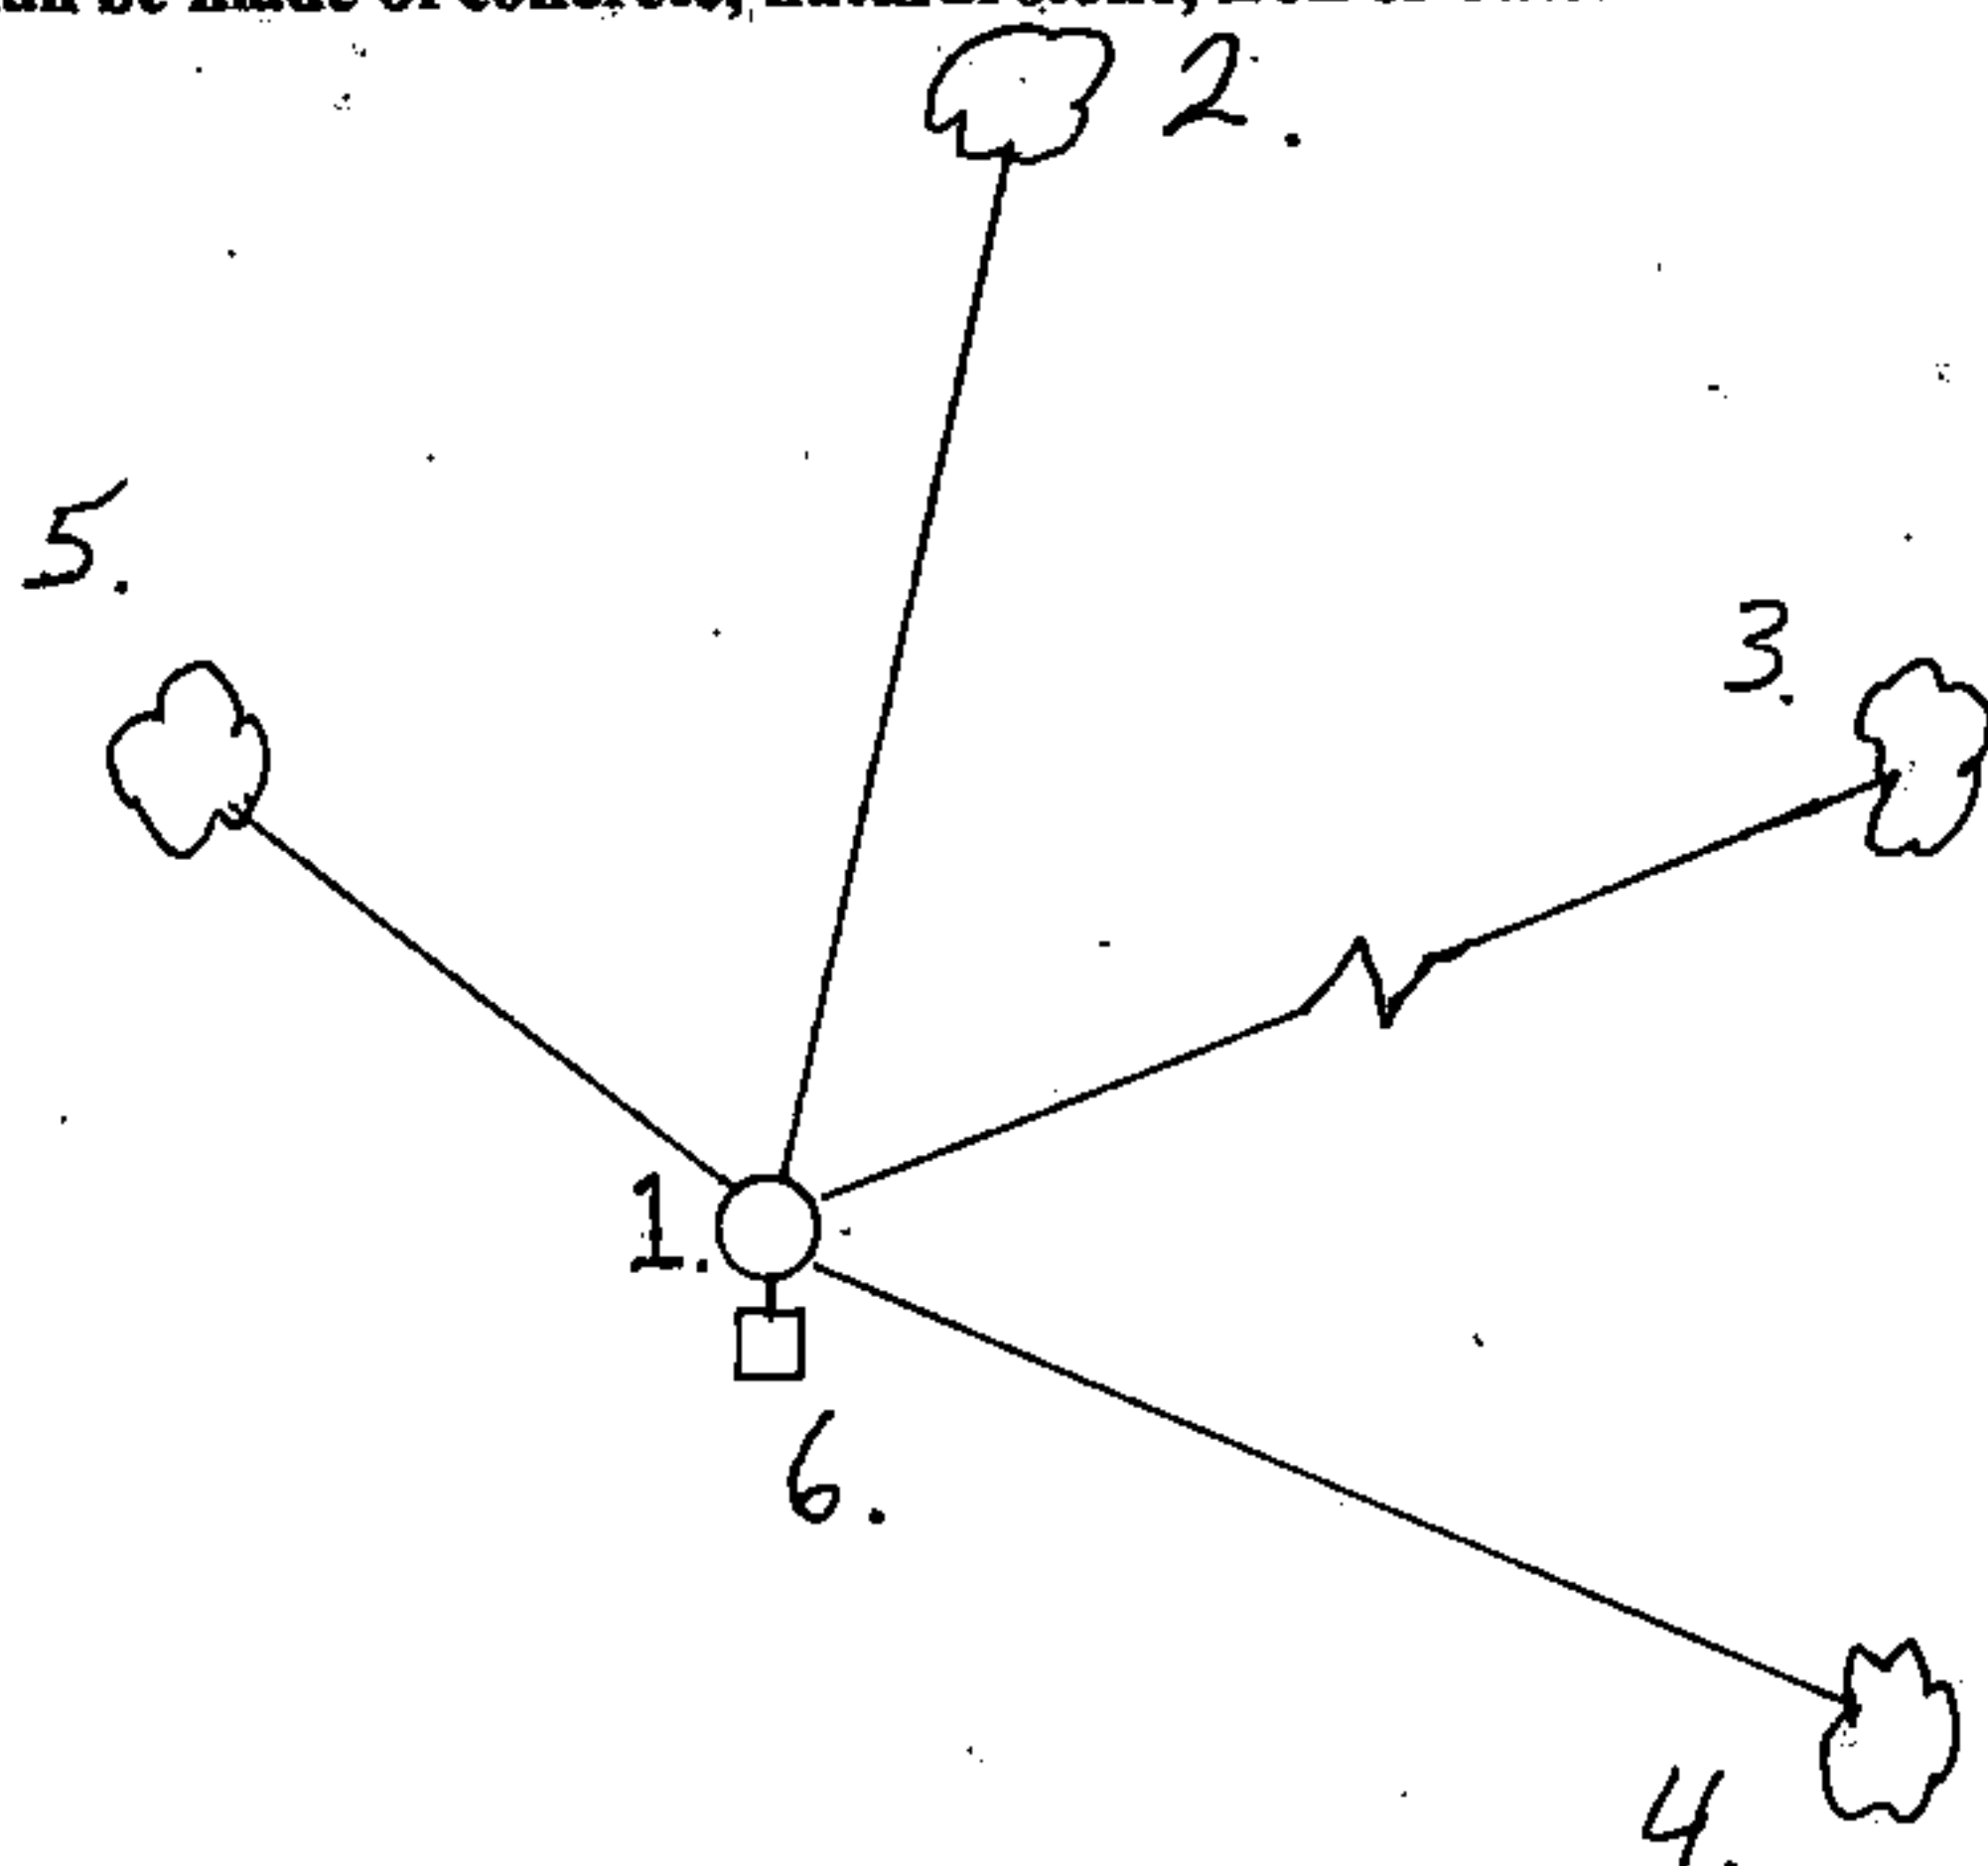

(e) Describe any material discrepancy between the location of the corner as restored or reestablished and the location of that corner as previously restored or reestablished by distance and direction. Show the discrepancy on the plan view drawing under (d), above. Show the distances between the corner as previously restored or reestablished and (1) the corner as restored or reestablished, and (2) to at least 2 of the witness monuments shown on the drawing in (d), above.


None

(f) Was the corner restored through acceptance of (1) an obliterated evidence location, or, (2) a found perpetuated location?


2.) No

(g & h) Was the corner reestablished through lost corner proportionate methods? If so, show the method, Including the directions and distances to other public land survey corners used as evidence or used for proportioning in determining the corner location?

Yes

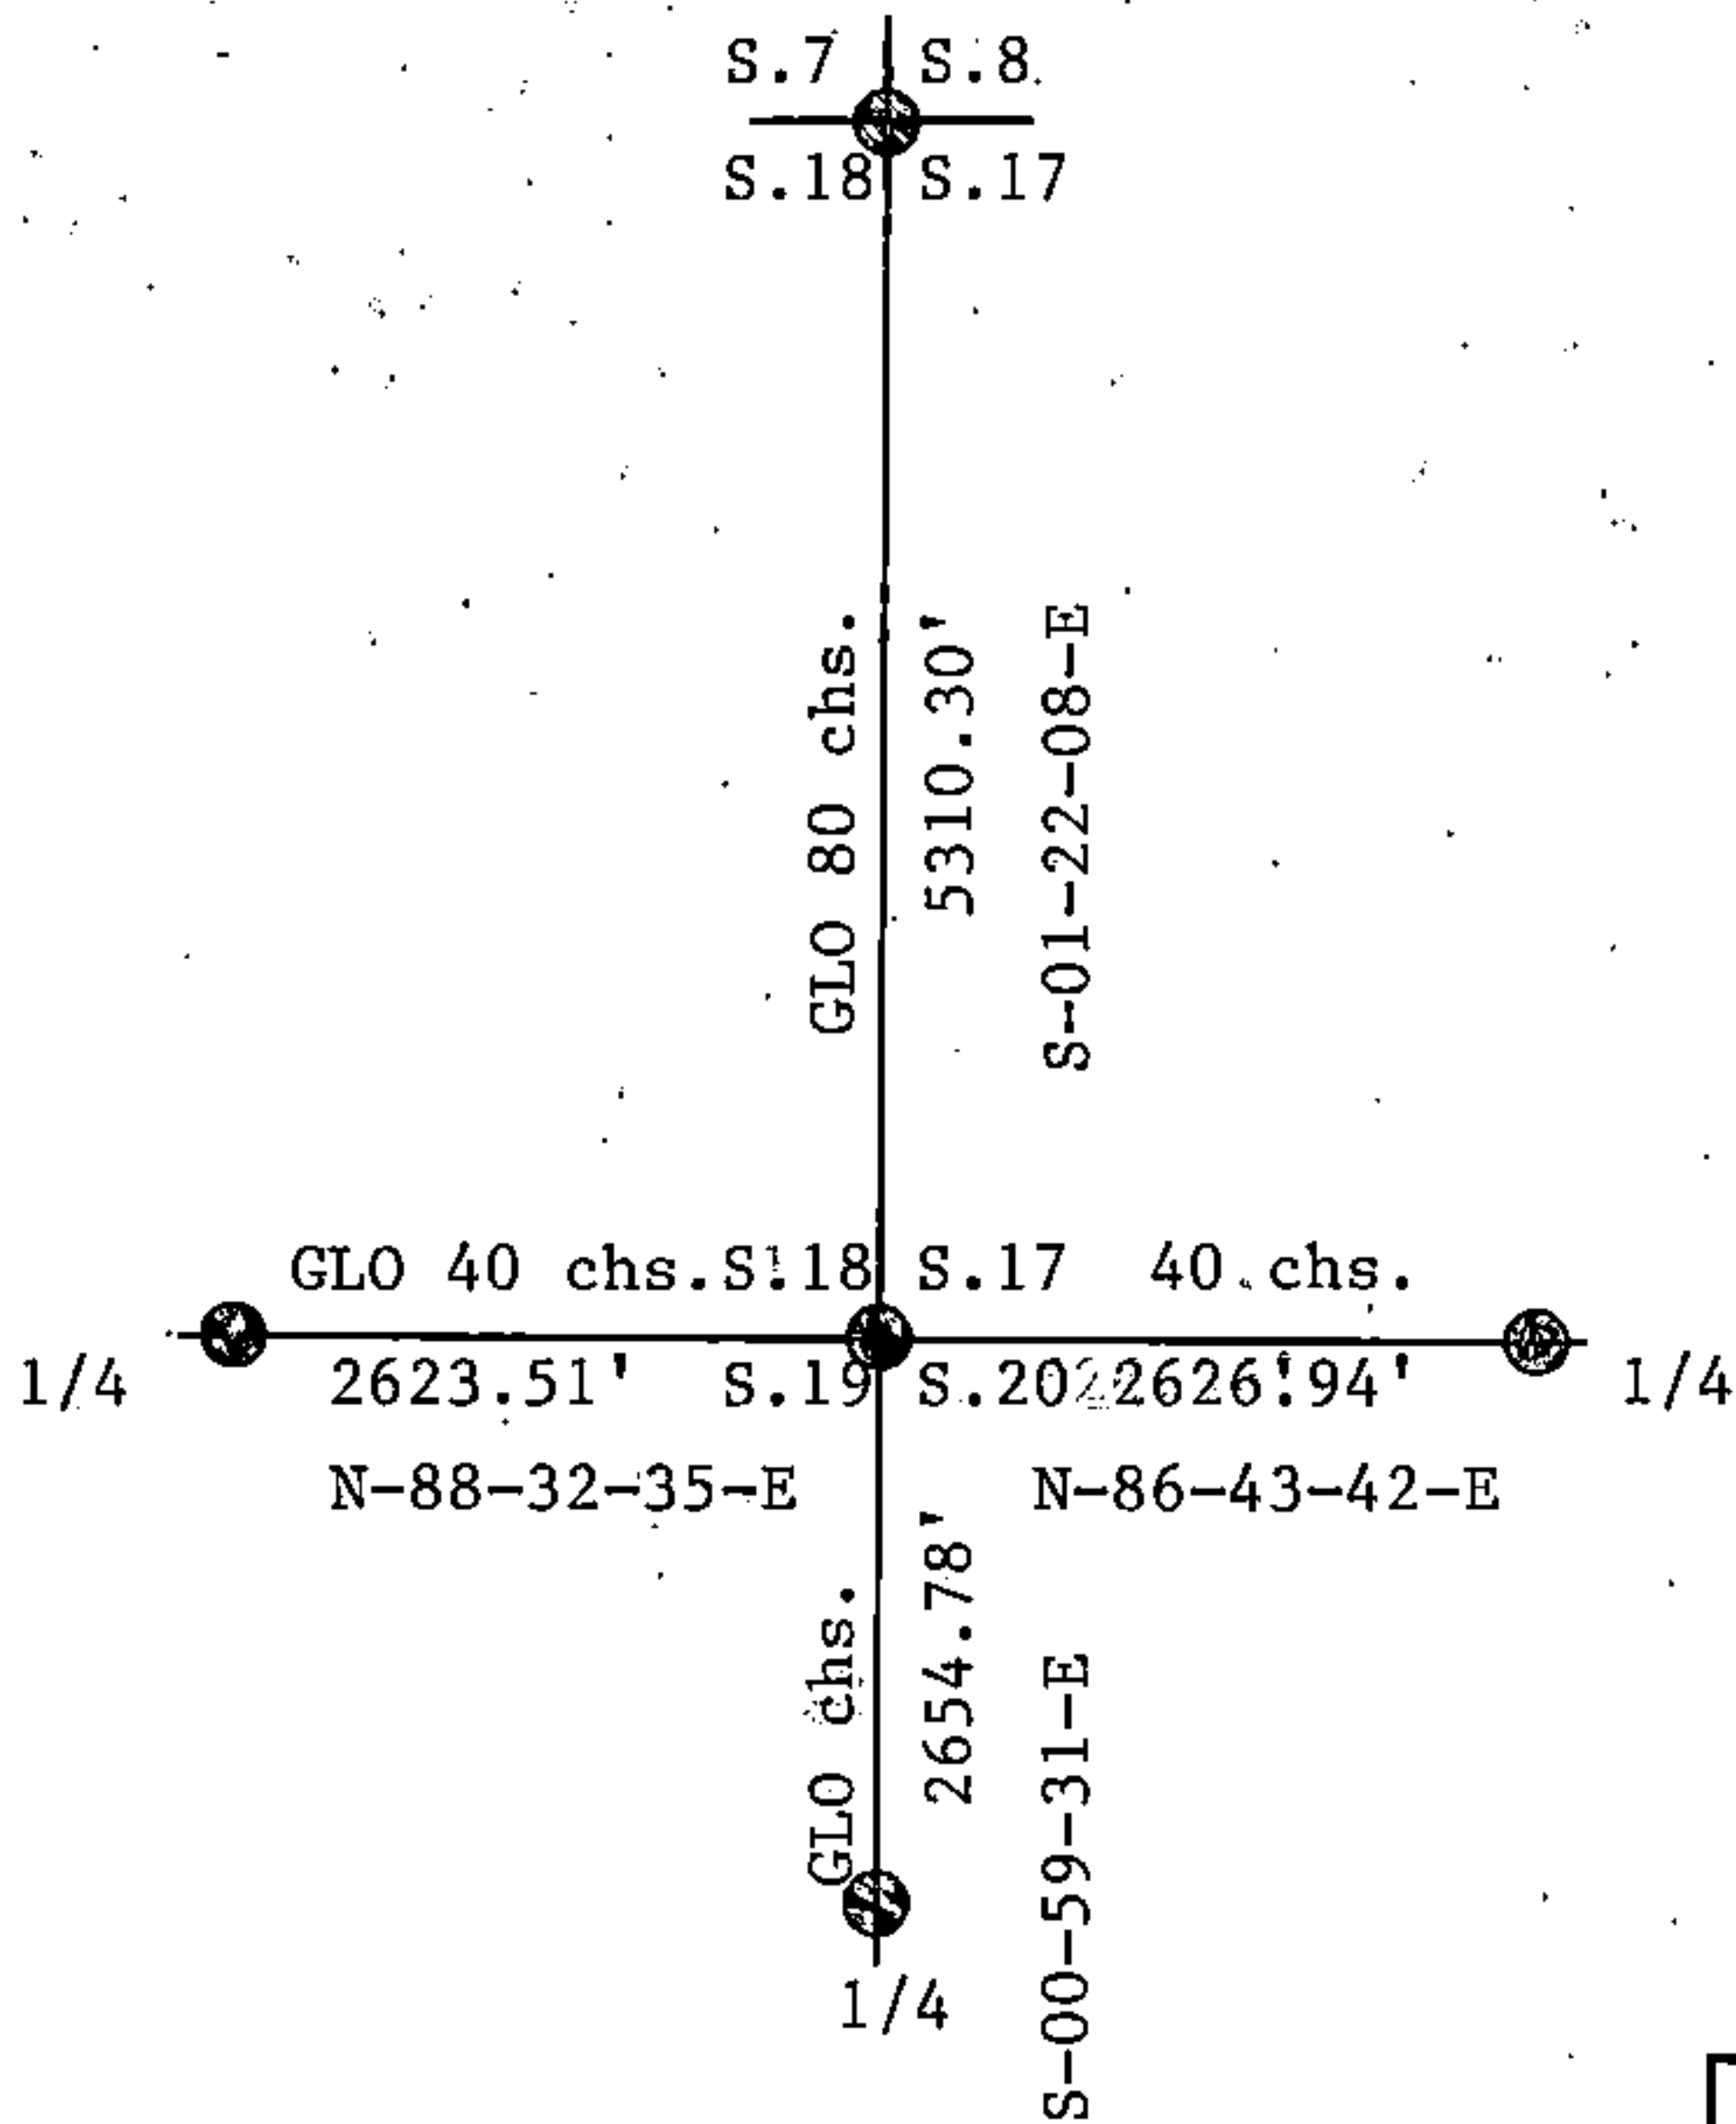

(I) I, Alan D. Harrison
(type or print name) certify that the corner location shown on this record was determined by me or under my direction and control and that this U. S. Public Land Survey Monument Record is correct and complete to the best of my knowledge and belief.

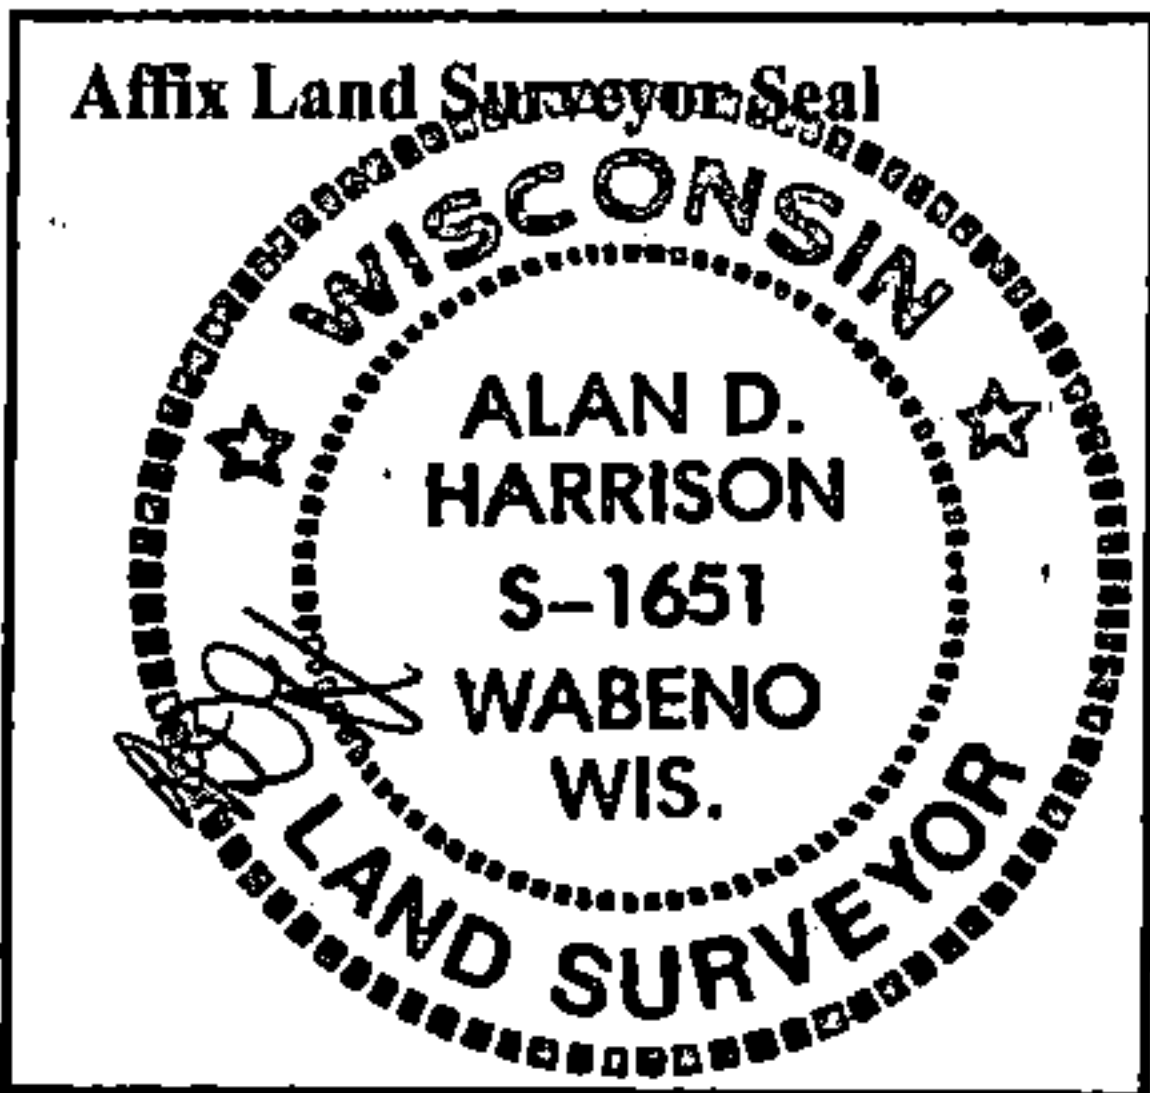

Alan D. Harrison 3/13/01
Signature Date

CERTIFICATE READY FOR FILING: [Signature]
District Ranger