

CERTIFIED LAND CORNER RESTORATION

Index No. **P 8**

State of Wisconsin }
County of Forest } ss.

I, Philip T. Hansen, do hereby certify that on the 2nd day of January, 1976, I found evidence of the EC-1/16 corner of Section 20 Township 38, North, Range 14 East, Fourth Principal Meridian, as described hereon; and that from this evidence I established a new monument and accessories as described hereon to perpetuate the original location of this corner.

History of original corner establishment: Origin of this corner unknown. Wes White and John Walters, foresters for Consolidated Papers, Inc., recovered this corner in 1946. Found an old squared post scribed SC-1/16. Search recovered old point still intact in the ground. Set new cedar post in place of old point.

Corner maintained by Ray Leigh, Consolidated Forester.

Description of corner evidence found: Recovered 4" squared cedar post in fair condition. Also, a 1-1/2" iron pipe was found beside wood post.

OBT's - none recovered.


Resident witnesses:

Glen Barker

Jim Claflin



T38N R14E

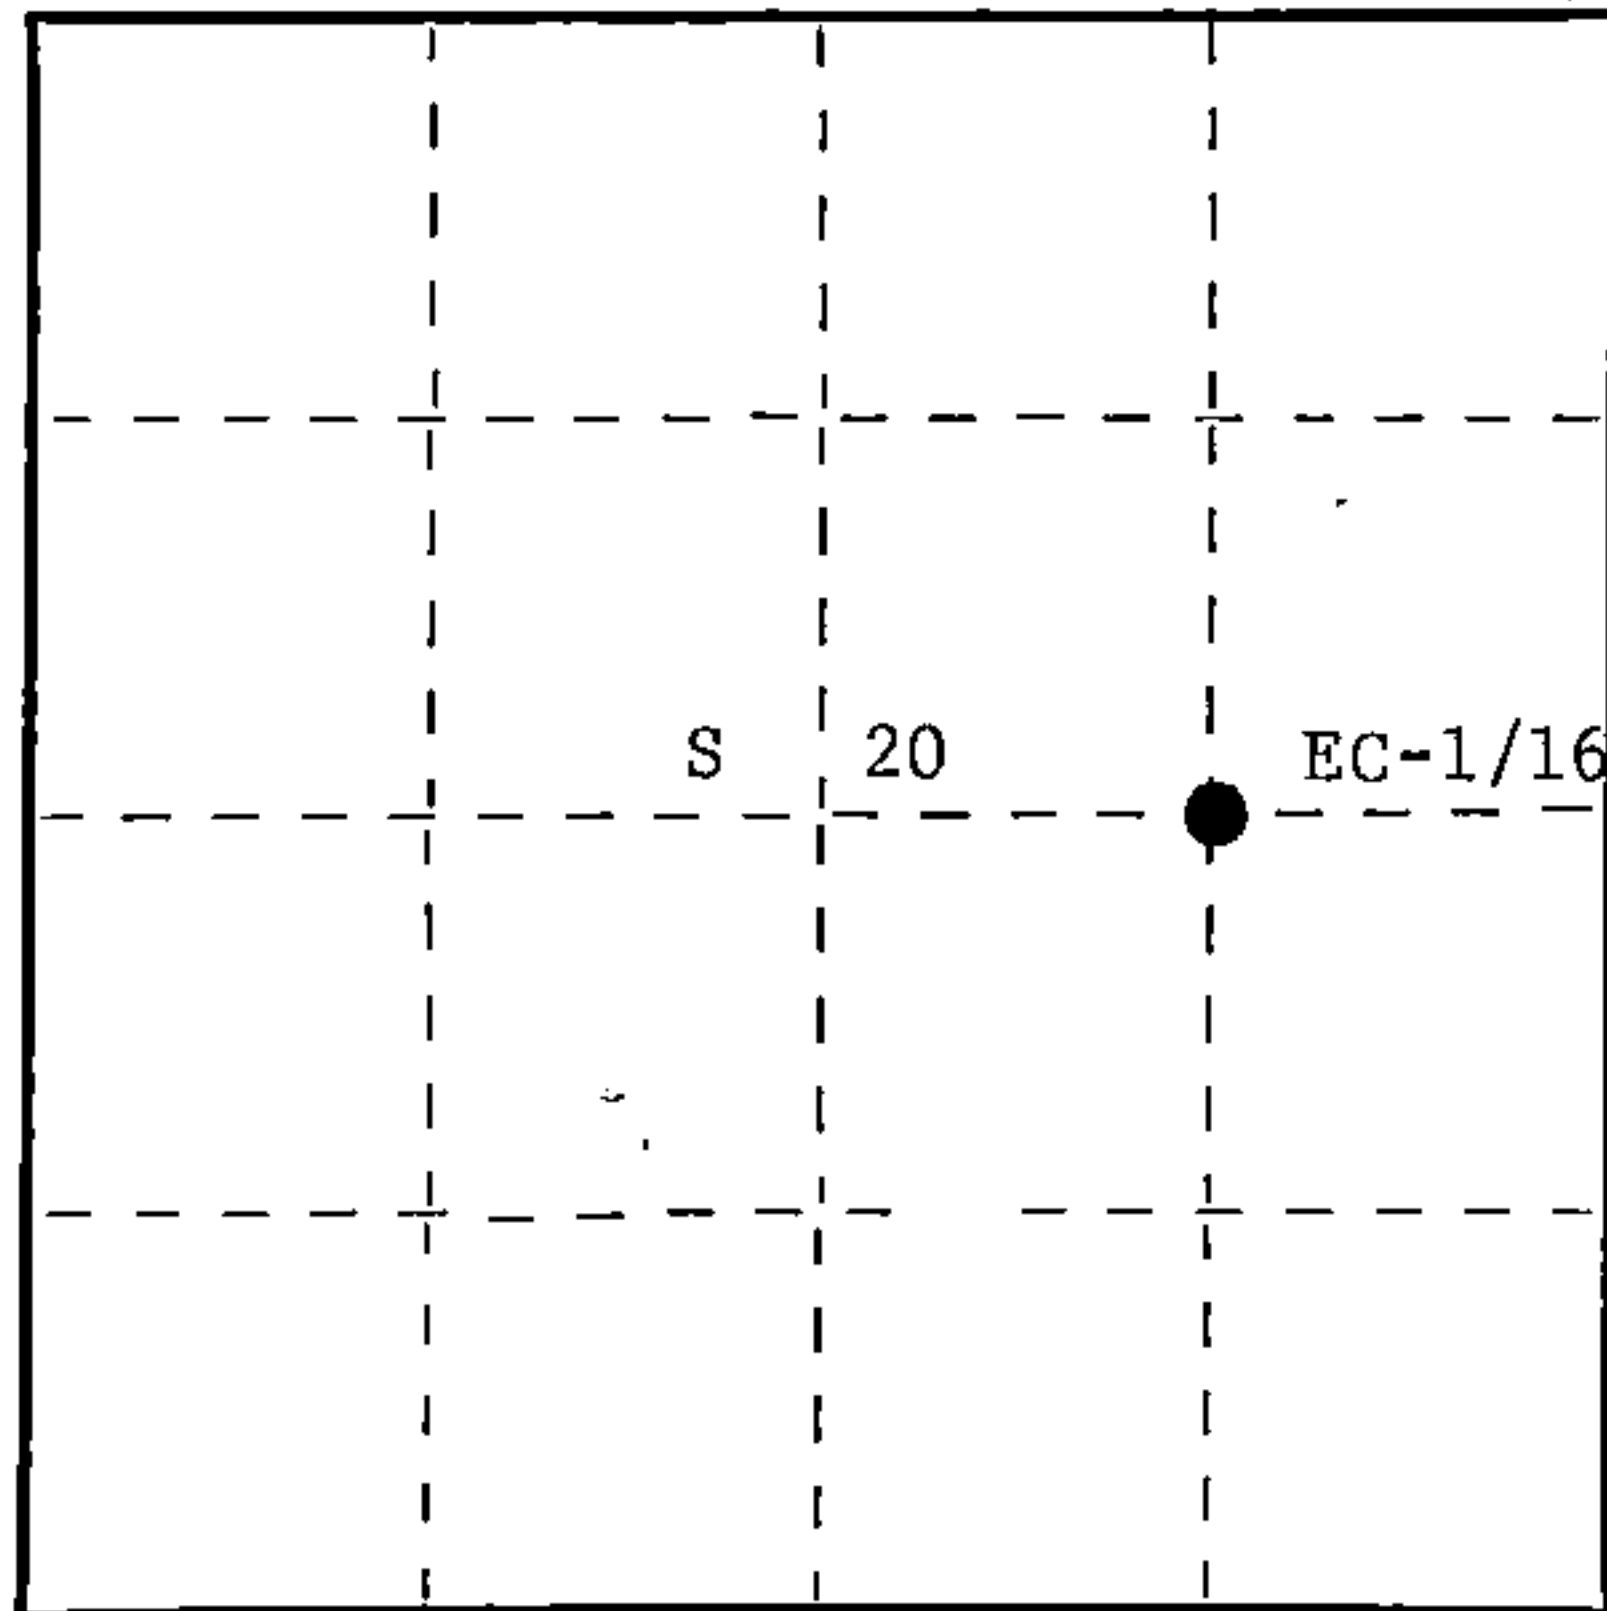

○ = Corner monument restored.

Description of monument and accessories I established to perpetuate the original location of this corner.

Replaced 4" squared cedar post with 1-1/2" O.D. iron pipe with 2" brass cap stamped -

Pipe projects 18" above the ground.

NBT's - Hemlock 12" N30W 85 links scribed 1/16 BT
Maple 7" Due East 27.2 links scribed 1/16 BT

Set 4" cedar post beside new pipe.

Pipe, post, and NBT's painted blue.

S498
T38N R14E
EC-1/16 S 20
CPI-1975

Dated at Argonne, Wis., this 8th day of January, 1976

Signature Philip T. Hansen Title Registered Land Surveyor Registration No. S-498
(County Surveyor, Registered Land Surveyor, or other duly authorized official)

Office of Register of Deeds, County of Forest, I hereby certify that the within instrument was filed in this office for record on the 4th day of February, 1976 at 4:00 o'clock P. M.

Eugene Stutzman
(Register of Deeds)
By: _____ Deputy

DOCUMENT NUMBER **108702**

FORM 985 M. C. MILLER CO., MILWAUKEE

43814202010