

U.S. PUBLIC LAND SURVEY MONUMENT RECORD

Index No. **R-25**

State of Wisconsin }
 County of Forest } ss.

I, William B. Cochran, do hereby certify that on the 1st day of April, 1982, I found evidence of the Southeast Section corner of Section 24 Township 38, North, Range 14 East, Fourth Principal Meridian, as described hereon; and that from this evidence I established a new monument and accessories as described hereon to perpetuate the original location of this corner.

Resident witnesses:

David Brownell

Tony Tillman

History of original corner establishment:

Original Government Survey in 1857 by Artemas Curtis. North between Sections 25 and 30, 80.00 chains, set Section Corner post to Sections 19, 24, 25, and 30, from which the following bear:

Tamarack	7"	S63°W	13 lks.
Tamarack	6"	N39°W	27 lks.
Cedar	6"	N43°E	17 lks.
Spruce	7"	S40°E	18 lks.

Description of corner evidence found:

4"x4" Cedar Post.

I accept the 4"x4" Cedar post as the best available evidence for restoring the corner position.

No original corner evidence was recovered.

Description of monument and accessories I established to perpetuate the original location of this corner.

In place of 4"x4" Cedar post, set a 2½" diameter aluminum pipe monument, 5 feet long, 4 feet in the ground, with an aluminum cap stamped: T38N, R14E, R15E, S19, S24, S25, S30, 1982, S-1107. From which the following new blazed and scribed bearing trees bear:

B. Cherry	13"	N89°W	127.59 feet
Cedar	14"	S55°W	140.26 feet
Steel Sign Post		NE	1.50 feet


Dated at Hiles, Wis., this 27th day of March, 1985

Signature William B. Cochran Title Land Surveyor Registration No. S-1107
 (County Surveyor, Registered Land Surveyor, or other duly authorized official)

Office of Register of Deeds, County of Forest, I hereby certify that the within instrument was filed in this office for record on the 24th day of April, 1985 at 1:00 o'clock P. M.

Paul Aschenbrenner
 (Register of Deeds)

By.....Deputy

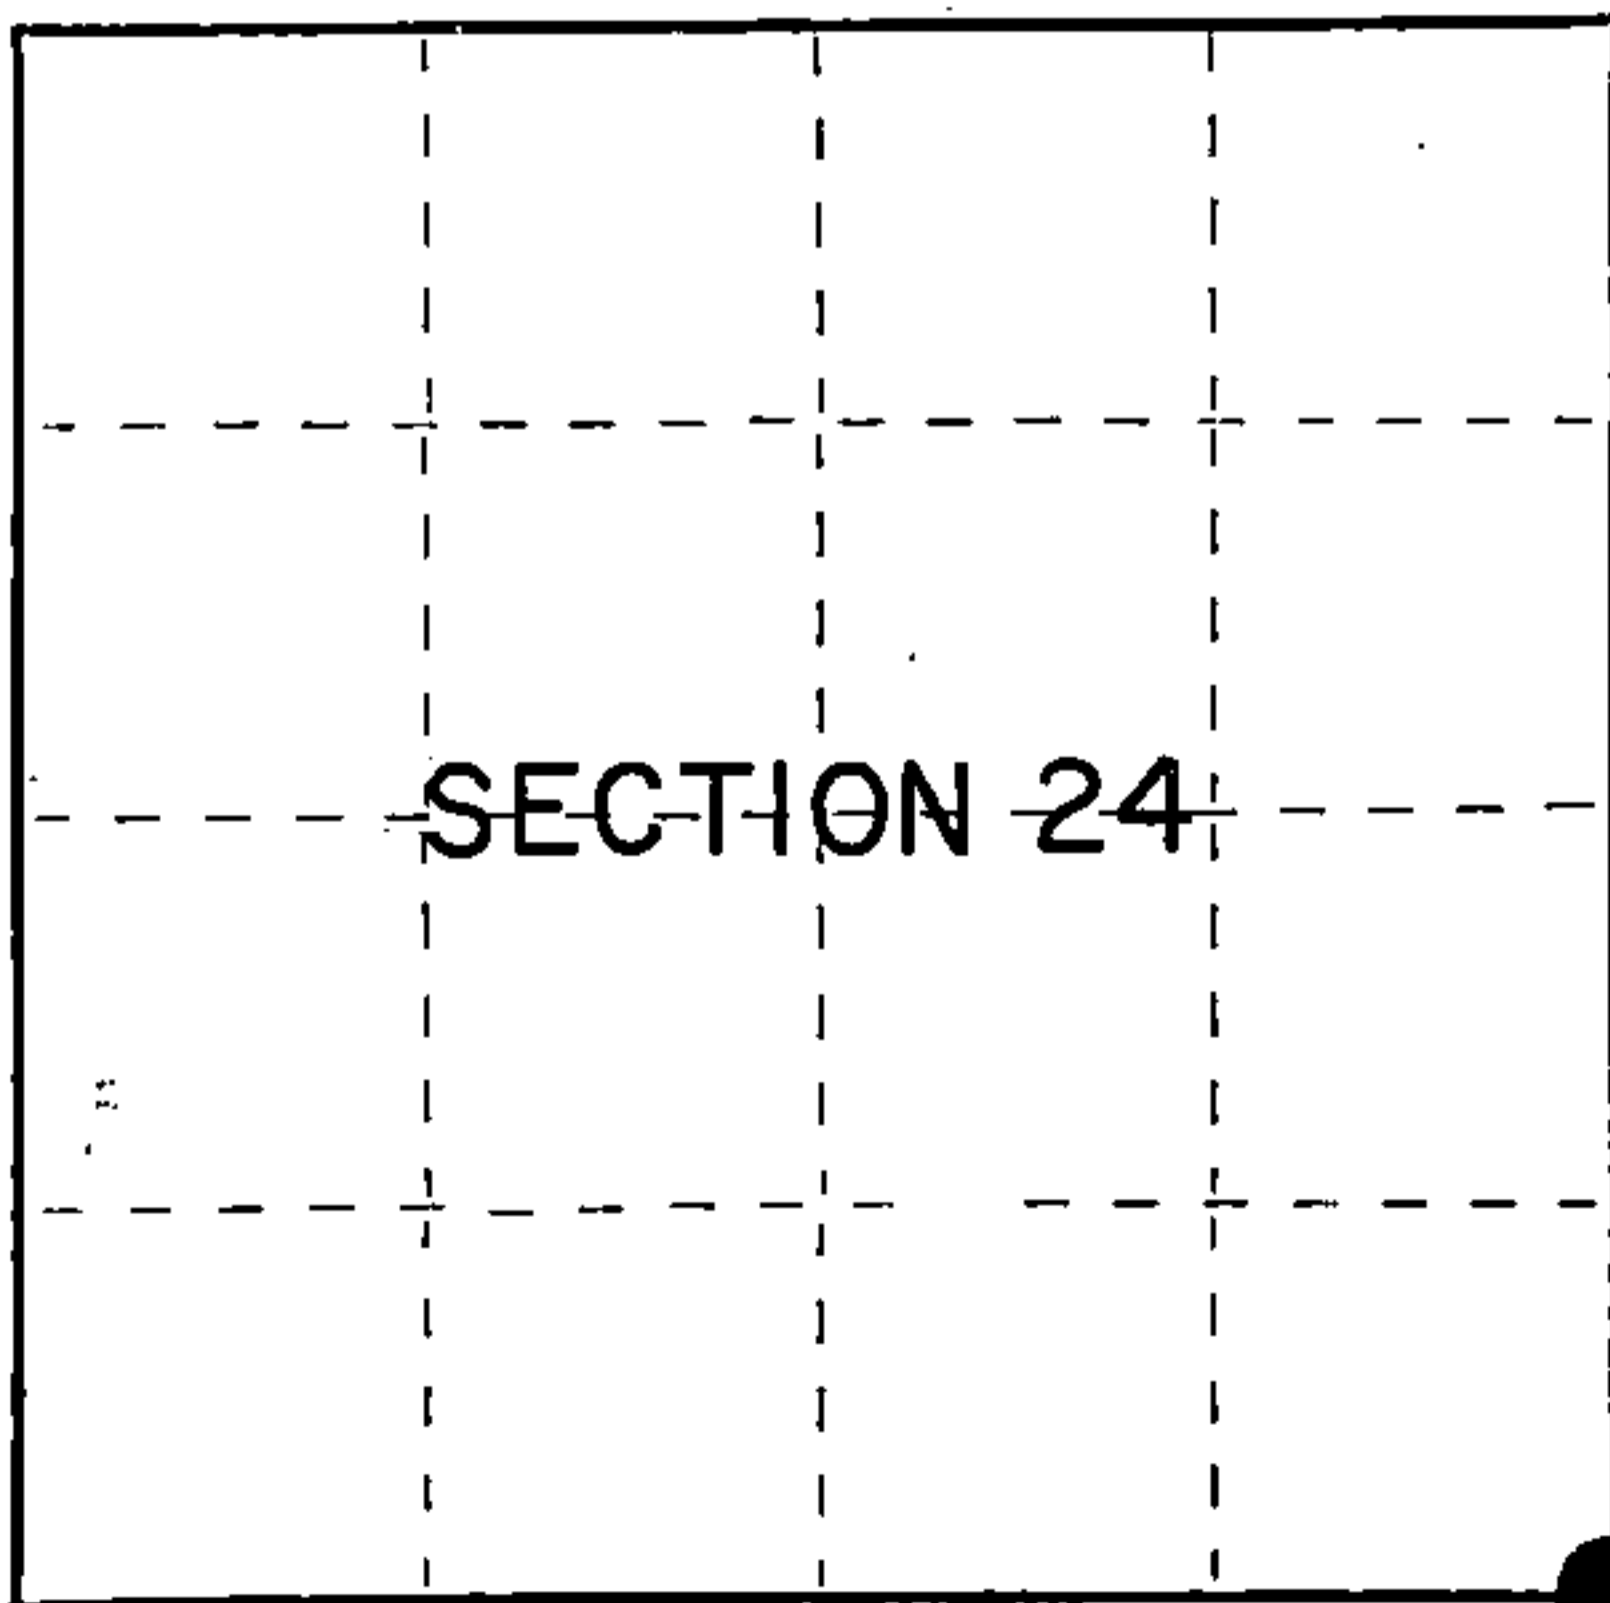

○ = Corner monument restored.

FORM NO. 985-A

H.C. Miller Company

Stock No. 26273

Document Number 127904

43814240000

