

CERTIFIED LAND CORNER RESTORATION

Index No. X-23

State of Wisconsin }
County of Forest } ss.

History of original corner establishment:

I Philip T. Hansen, do hereby certify that on the 24th day of April, 1977, I found evidence of the C 1/4 corner of Section 36 Township 38, North, Range 14 East, Fourth Principal Meridian, as described hereon; and that from this evidence I established a new monument and accessories as described hereon to perpetuate the original location of this corner.

No records on establishment of this corner.

Description of corner evidence found:

Recovered a 2 1/4" iron pipe projecting 2 1/2 feet above the ground. Also an old 4" squared cedar post laying beside it. No evidence of any BTs in evidence.


This corner has been accepted by Connor Company surveyor and foresters. It was recovered about 30 years ago and has been perpetuated since that time.

Resident witnesses:

Glen Barker

Jim Claflin

Herb Wagoner

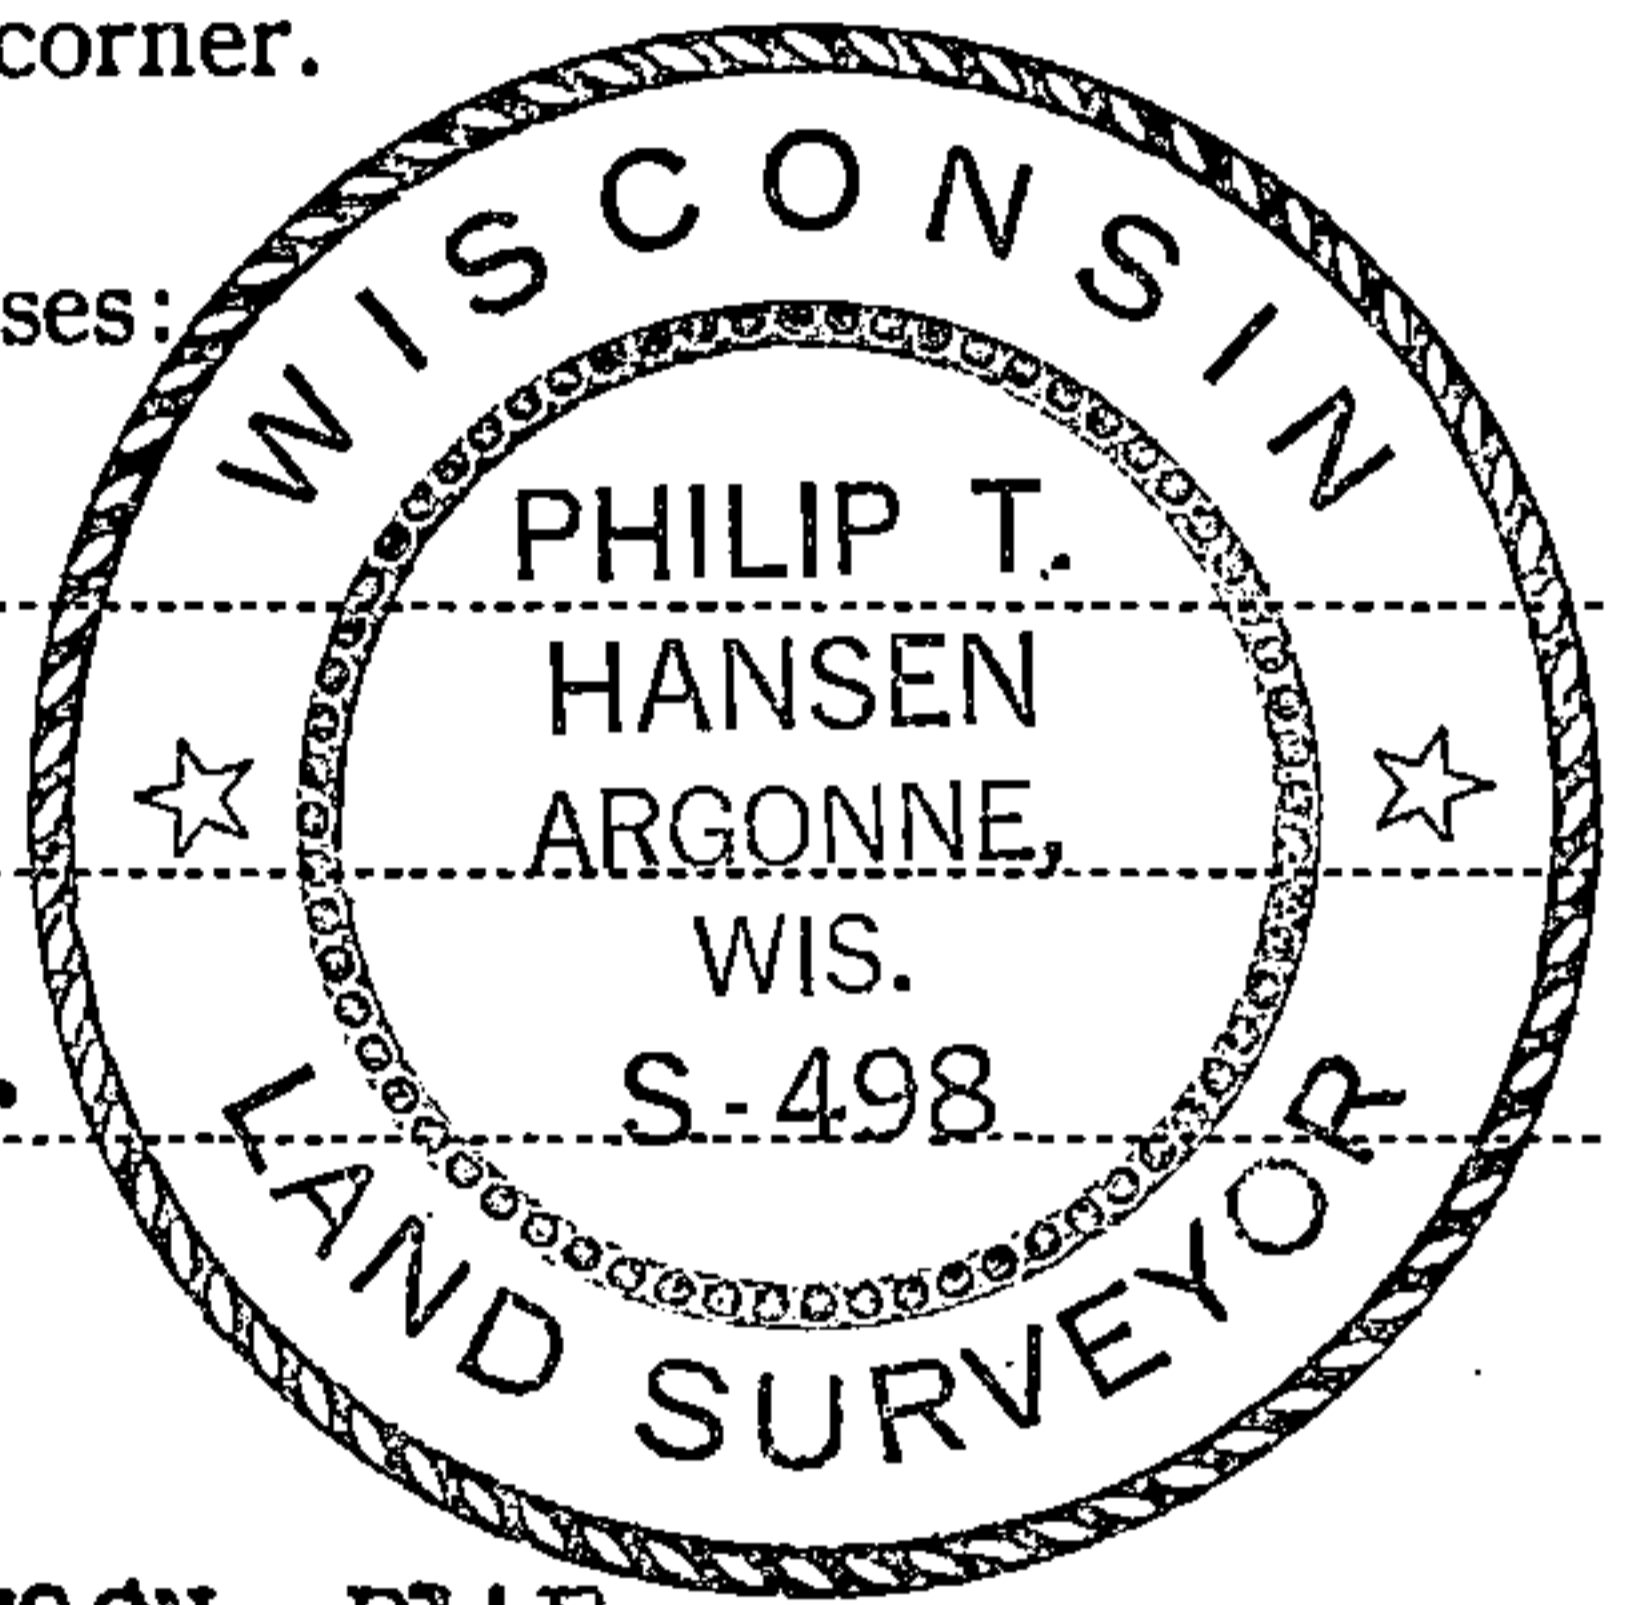

Description of monument and accessories I established to perpetuate the original location of this corner.

Replaced iron pipe with 2 1/2" Berntsen A-1 Federal Monument, aluminum with magnet in cap and base.

Monument projects 18" above ground. Cap stamped:


Marked NBTs - Sugar 9" S40°E, 23 1/2 links, scribed C 1/4 BT.

Hemlock 8" N78°W, 23.4 links, scribed C 1/4 BT.

Sugar 12" S 31°W, 21.4 links, scribed C 1/4 BT.

T38N R14E
C 1/4 S 36
S498-1977

FORM 985
Wisconsin Printing & Engraving Co.
Milwaukee, Wisconsin

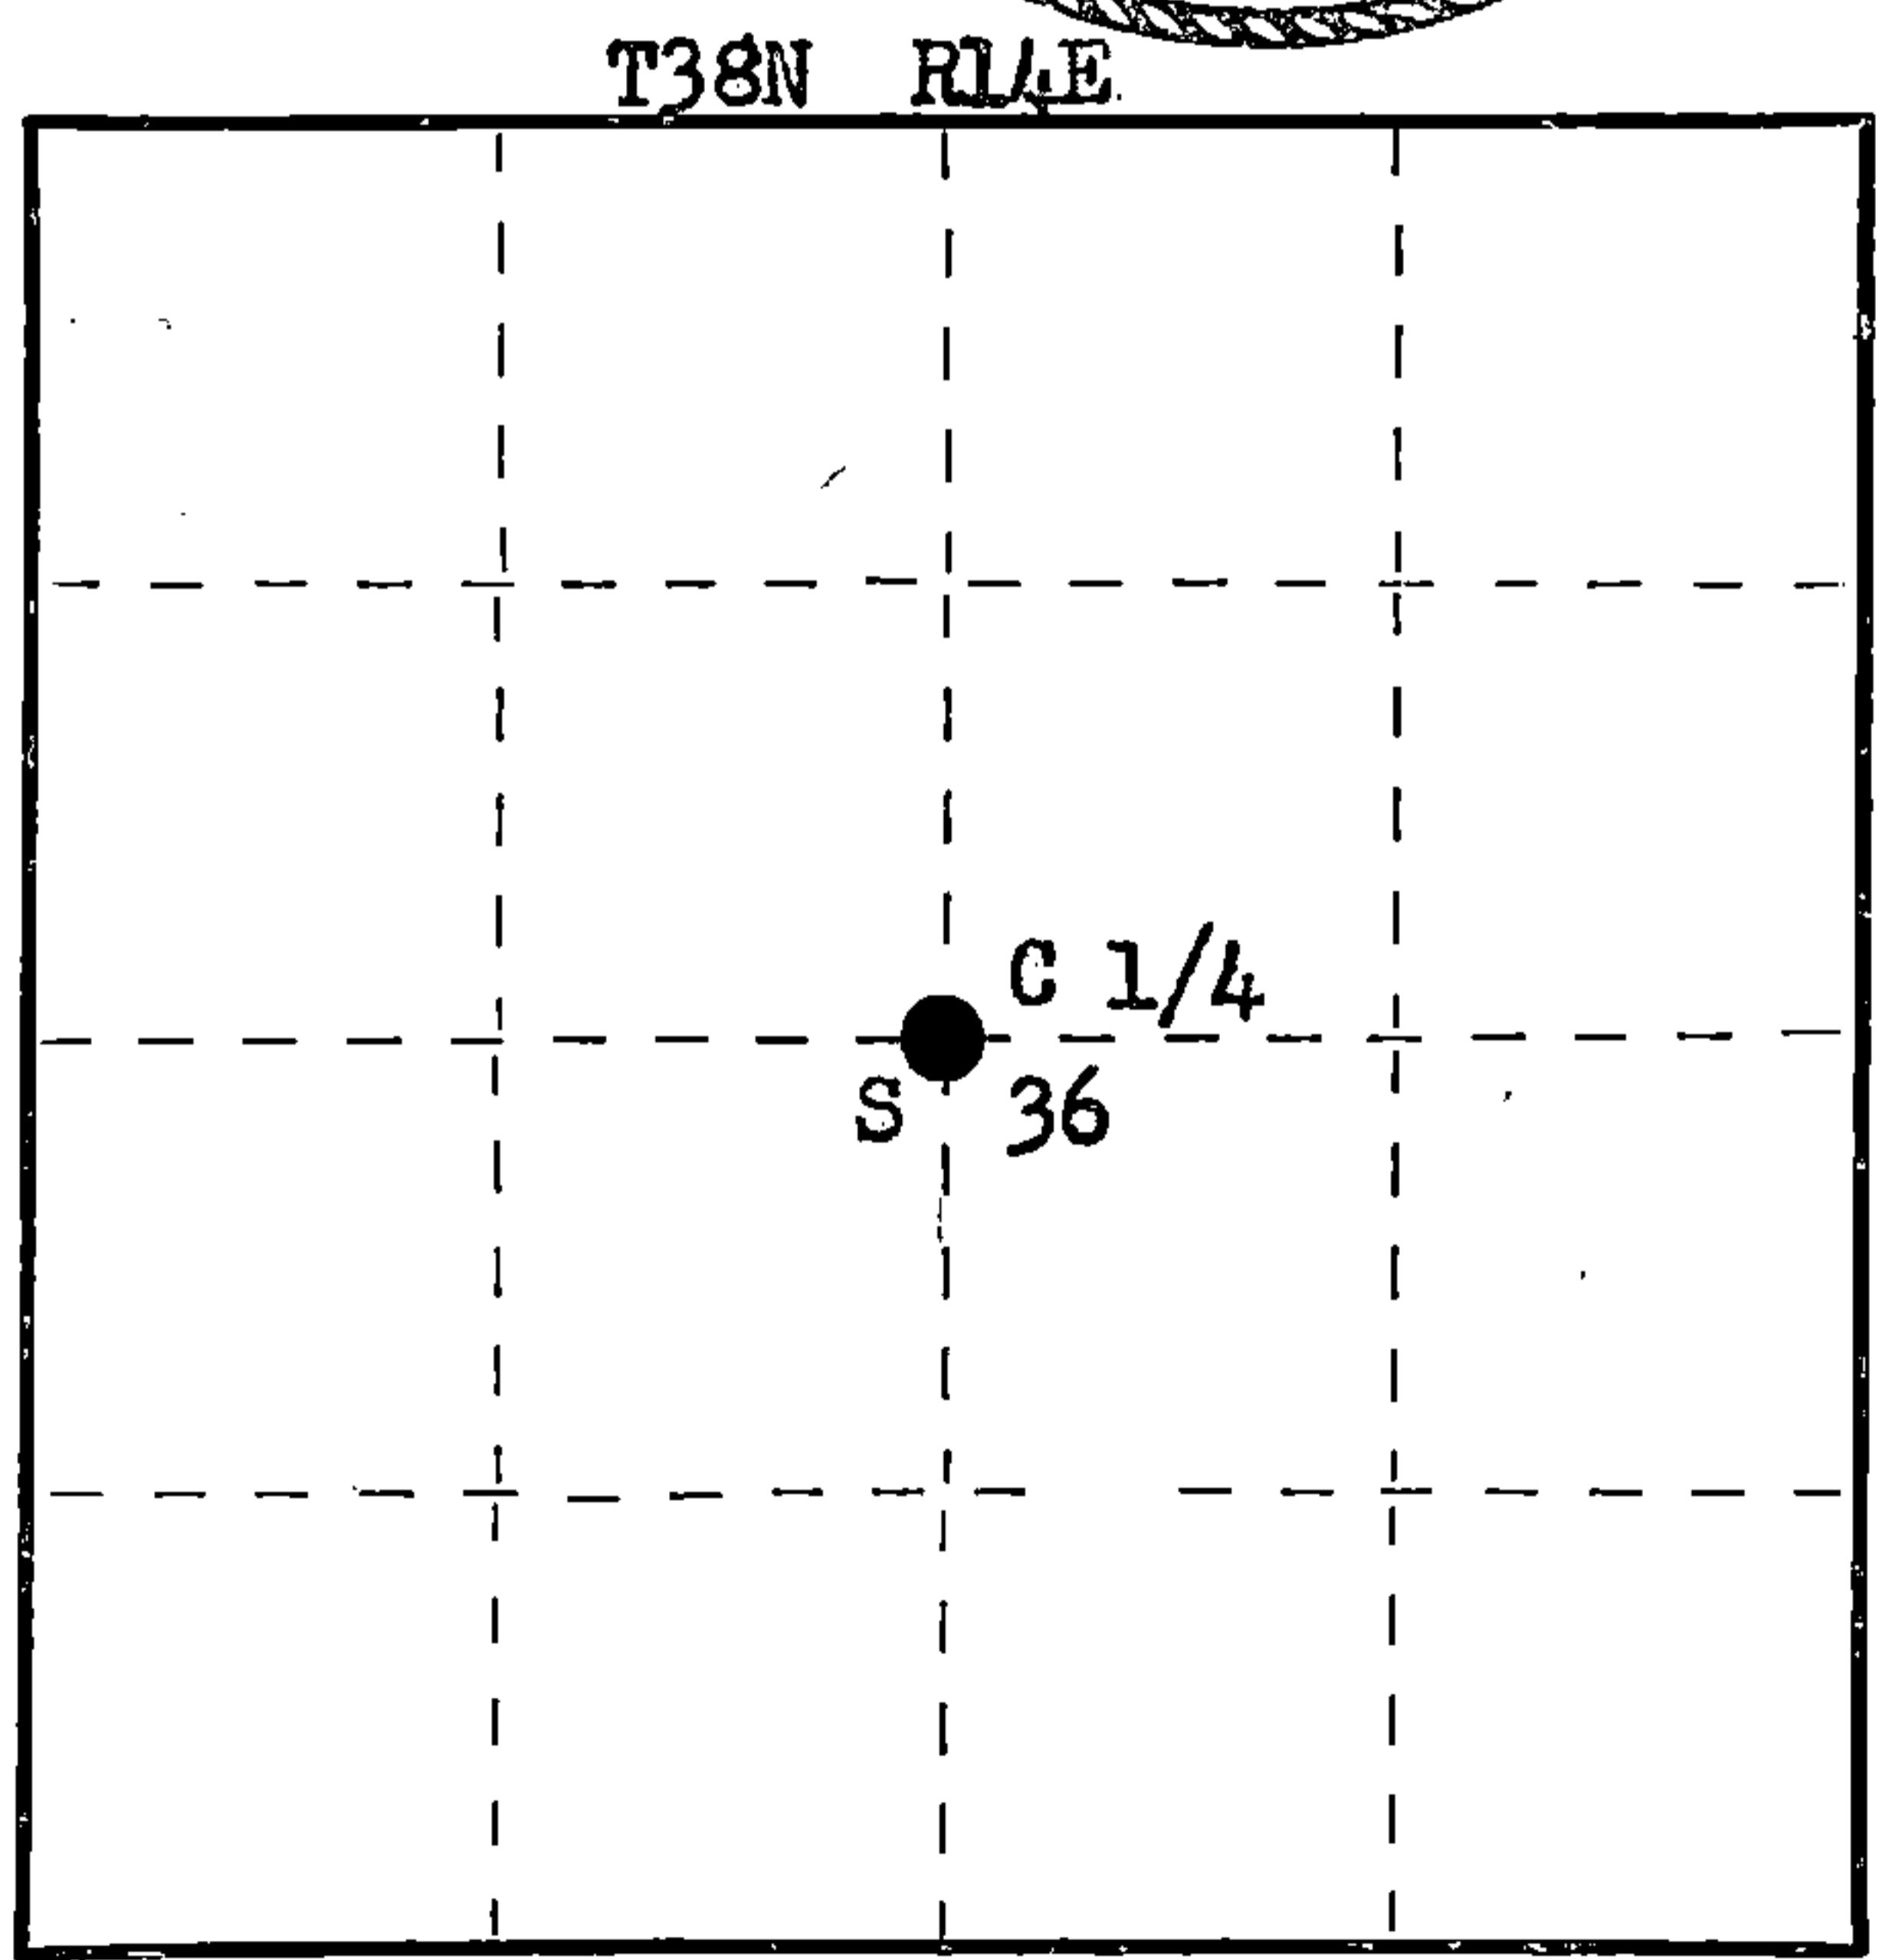

○ = Corner monument restored.

Dated at Rhineland, Wis., this 3rd day of May, 1977

Signature Philip T. Hansen Title Registered Land Surveyor Registration No. S-498
(County Surveyor, Registered Land Surveyor, or other duly authorized official)

Office of Register of Deeds, County of Forest, I hereby certify that the within instrument was filed in this office for record on the 5TH day of May, 1977 at 4:00 o'clock P. M.

Eugene Stutzman
(Register of Deeds)
By _____ Deputy

DOCUMENT NUMBER -- **111350**

4381430 2020