

CERTIFIED LAND CORNER RESTORATION

Index No. U-9


State of Wisconsin }
County of Forest } ss.

I Glen Barker, do hereby
certify that on the 31st day
of December, 1984, I found
~~xxxxxx~~ established S 1/16
corner of Sections 28 & 29
Township 38, North, Range
14 East, Fourth Principal Meridian,
as described hereon; and that from this evidence
I established a new monument and accessories
as described hereon to perpetuate the original
location of this corner.

Resident witnesses:

N. Spiess

R. Lundt

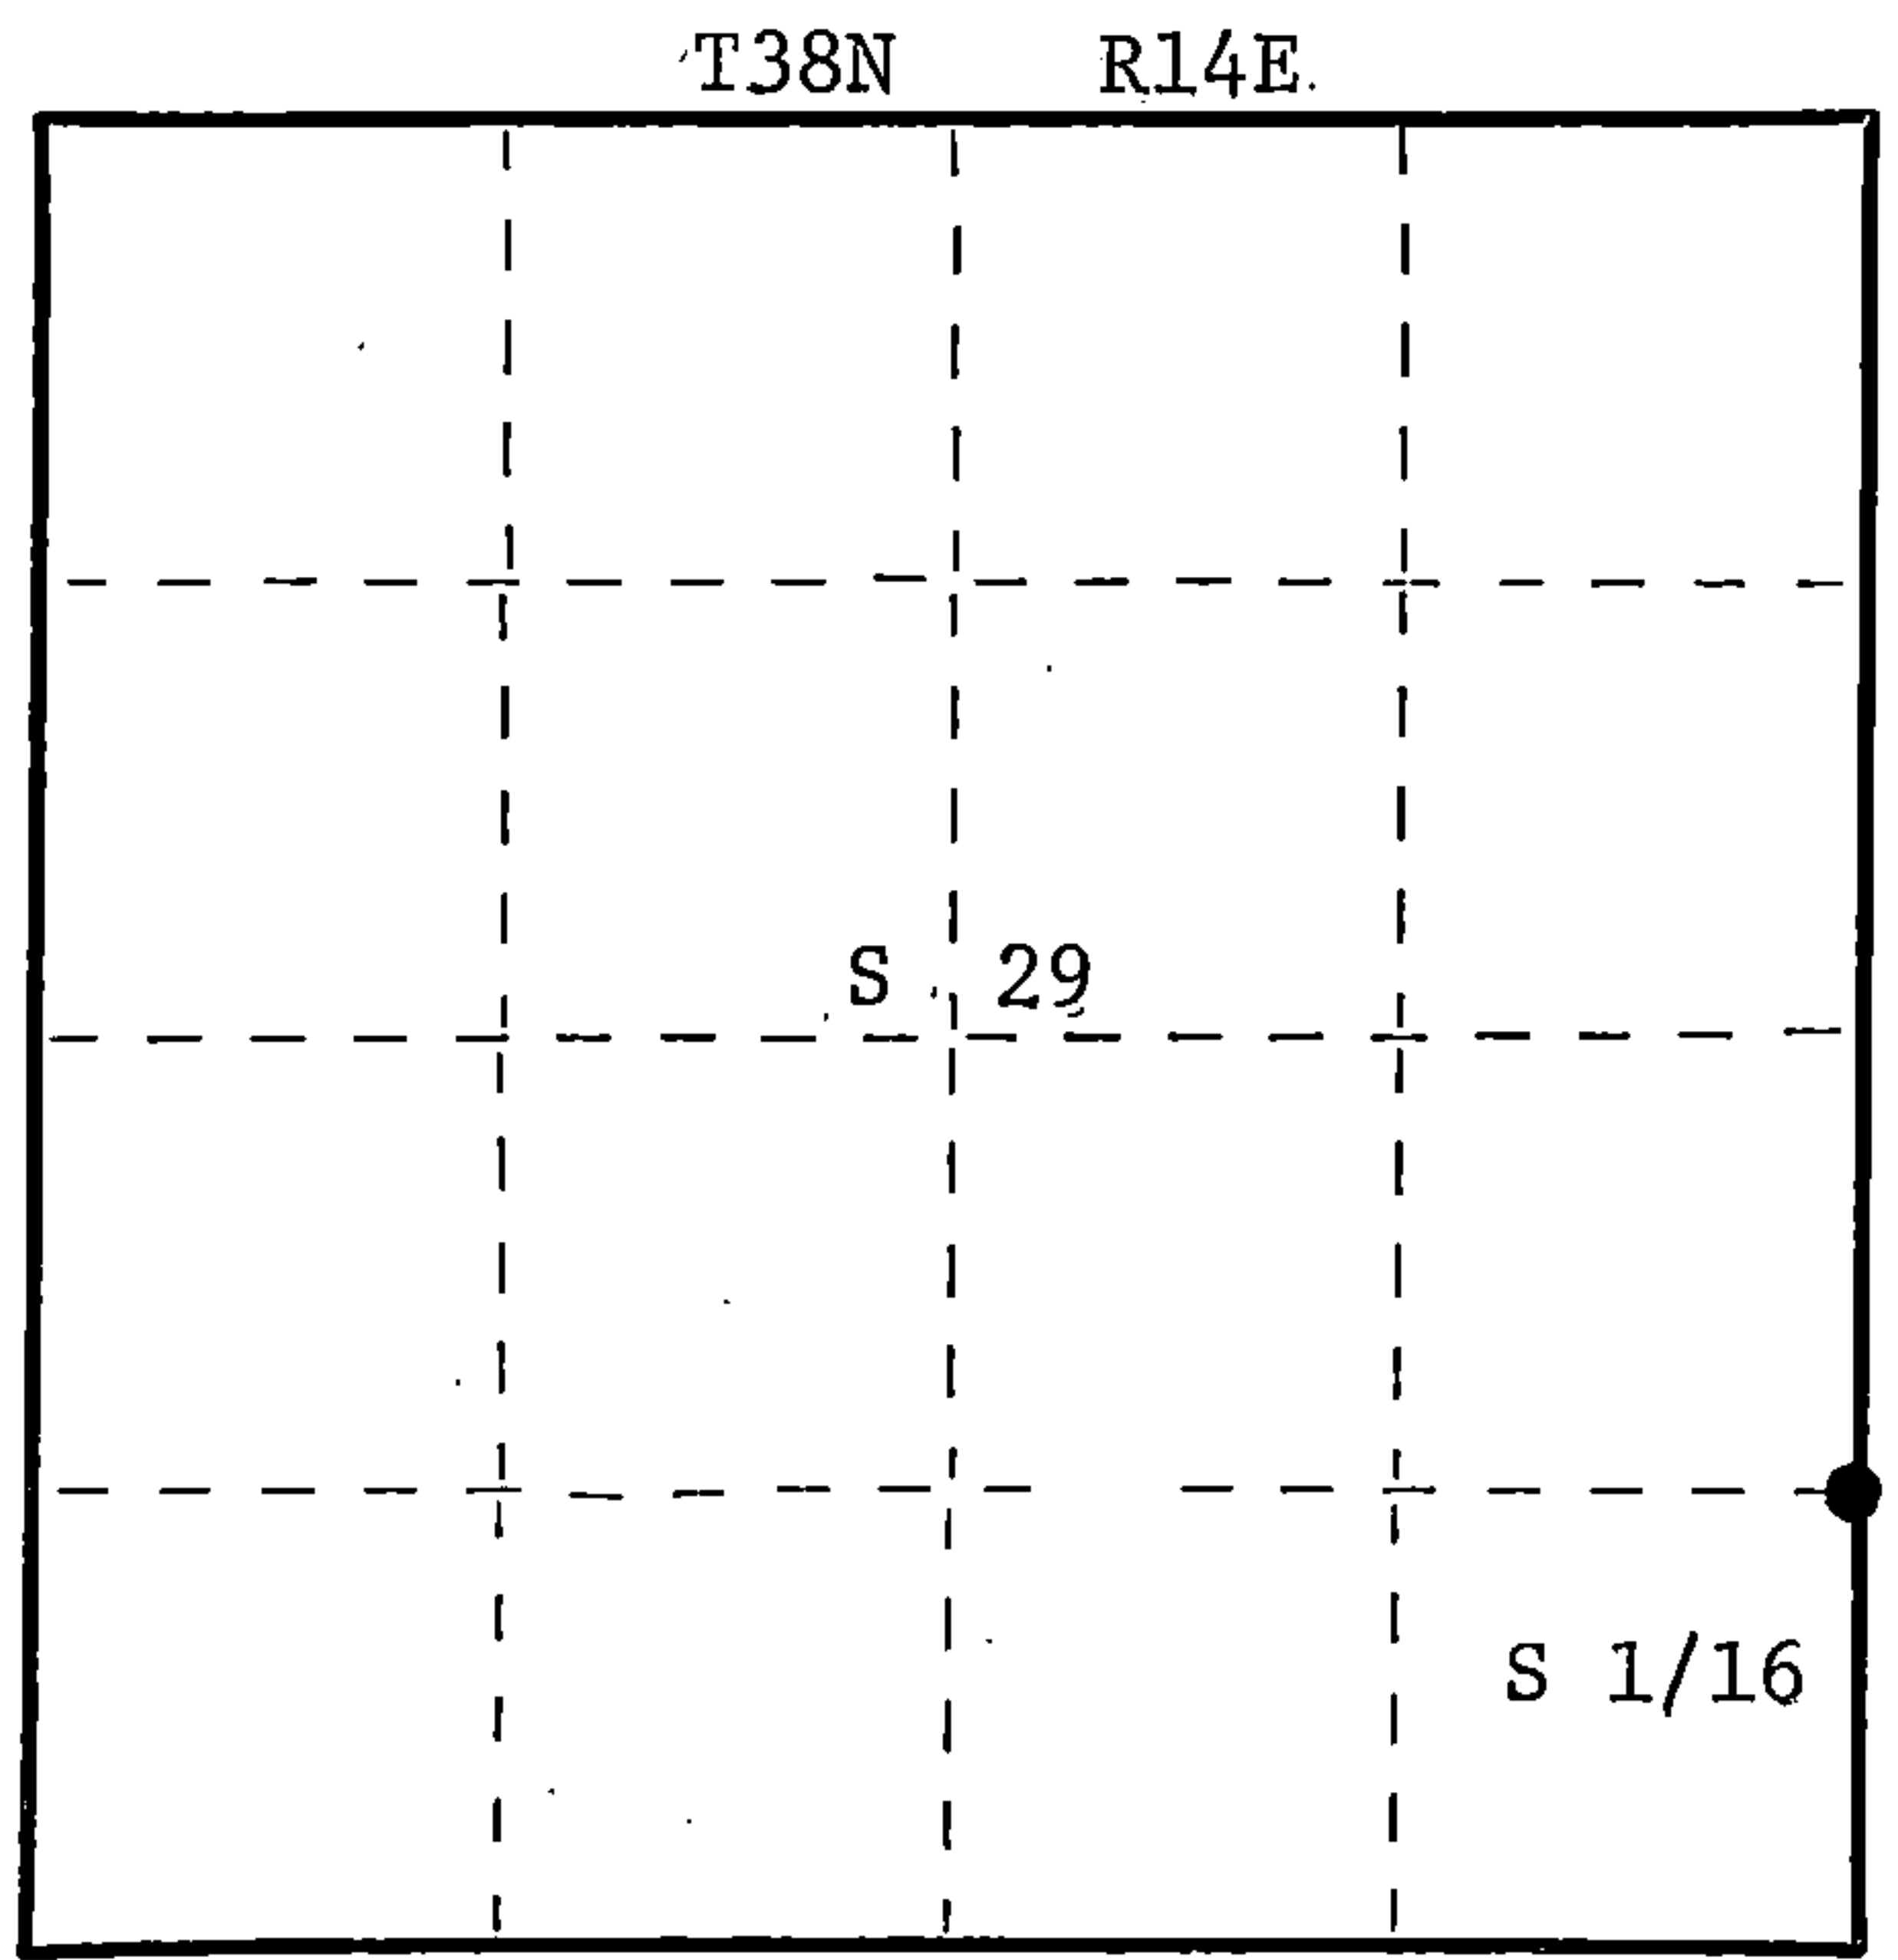

○ = Corner monument restored.

History of original corner establishment:

No evidence of any previous corner.

Description of corner evidence found:

Total distance from section corner 28-29-32-33 to 1/4 corner between 28 & 29 is
2631.70'.
Set S 1/16 1315.85' intermediate.

Description of monument and accessories I established to perpetuate the original location of this corner.

Set a 1" iron pipe with 2" diameter alloy cap stamped:
Monument projects 18" above ground.
Marked NBTs: Sugar 8" N38E 9.14'
Sugar 8" N62W 26.95'

S1682
T38N
S 1/16
S29 | S28
R14E
CPI-1984

Dated at Rhineland, Wis., this 17th day of April, 1985

Signature Glen Barker Title Registered Land Surveyor Registration No. S1682
(County Surveyor, Registered Land Surveyor, or other duly authorized official)

Office of Register of Deeds, County of Forest, I hereby certify that the within
instrument was filed in this office for record on the 3rd day of May, 1985
at 11:30 o'clock A. M.

Paul Aschenbrenner
(Register of Deeds)

By _____ Deputy

Document Number 127963

FORM 985 H. C. MILLER CO., MILWAUKEE

00016241834