


State of Wisconsin }
County of Forest } ss.

I, Glen Barker, do hereby
certify that on the 26th day
of December, 1984, I found
~~re-established~~ established
~~existence of the~~ EC 1/16
corner of Section 29
Township 38, North, Range
14 East, Fourth Principal Meridian,
as described hereon; and that from this evidence
I established a new monument and accessories
as described hereon to perpetuate the original
location of this corner.

Resident witnesses:

N. Spiess

R. Lundt

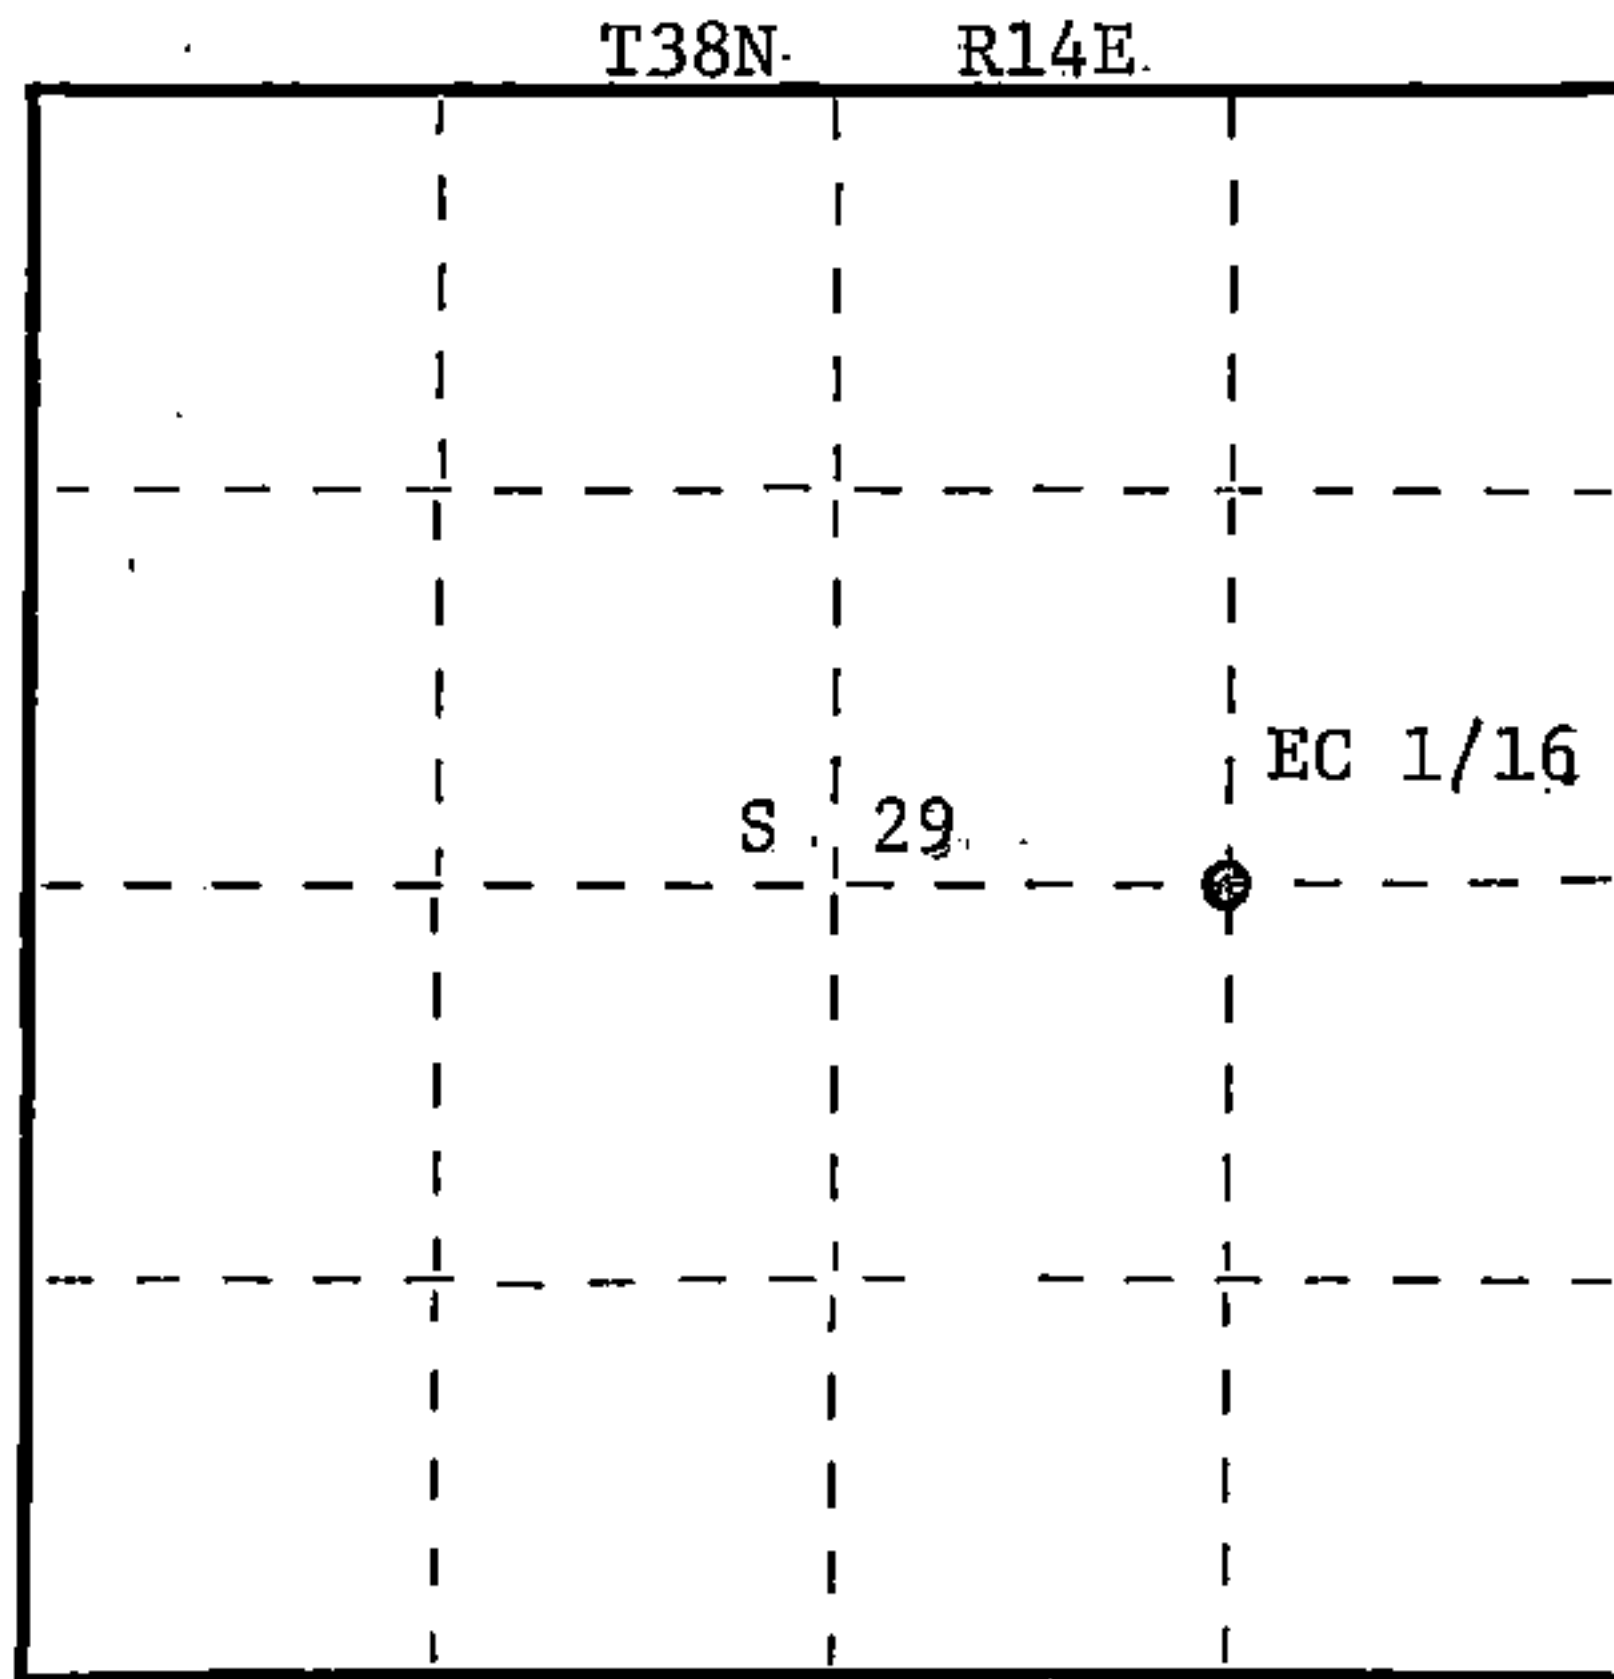

○ = Corner monument restored.

CERTIFIED LAND CORNER RESTORATION

Index No. 7-8

History of original corner establishment:

No evidence of any previous corner.

Description of corner evidence found:

Total distance from 1/4 corner between sections 28 & 29 to C 1/4 section 29 is
2633.85'.

Set EC 1/16 1316.92' intermediate.

Description of monument and accessories I established to perpetuate the original location of this corner.

Set a 1" iron pipe with 2" diameter alloy cap stamped:

Monument projects 18" above ground.

Marked NBTs: White Pine 14" S88E 14.17'

Black Spruce 7" N41W 27.78'

S1682

T38N

EC 1/16 S 29

R14E

CPI-1984

Dated at Rhinelander, Wis., this 17th day of April, 1985

Signature Glen Barker Title Registered Land Surveyor Registration No. S1682
(County Surveyor, Registered Land Surveyor, or other duly authorized official)

Office of Register of Deeds, County of Forest, I hereby certify that the within
instrument was filed in this office for record on the 3rd day of May, 1985
at 11:30 o'clock A. M.

Paul Aschenbrenner
(Register of Deeds)

By _____ Deputy

43814292010