

CERTIFIED LAND CORNER RESTORATION

Index No. T-7


State of Wisconsin }
County of Forest } ss.

I, Glen Barker, do hereby certify that on the 25th day of January, 1985, I found evidence of the C 1/4 corner of Section 29, Township 38 North, Range 14 East, Fourth Principal Meridian, as described hereon; and that from this evidence I established a new monument and accessories as described hereon to perpetuate the original location of this corner.

Resident witnesses:

N. Spiess

R. Lundt

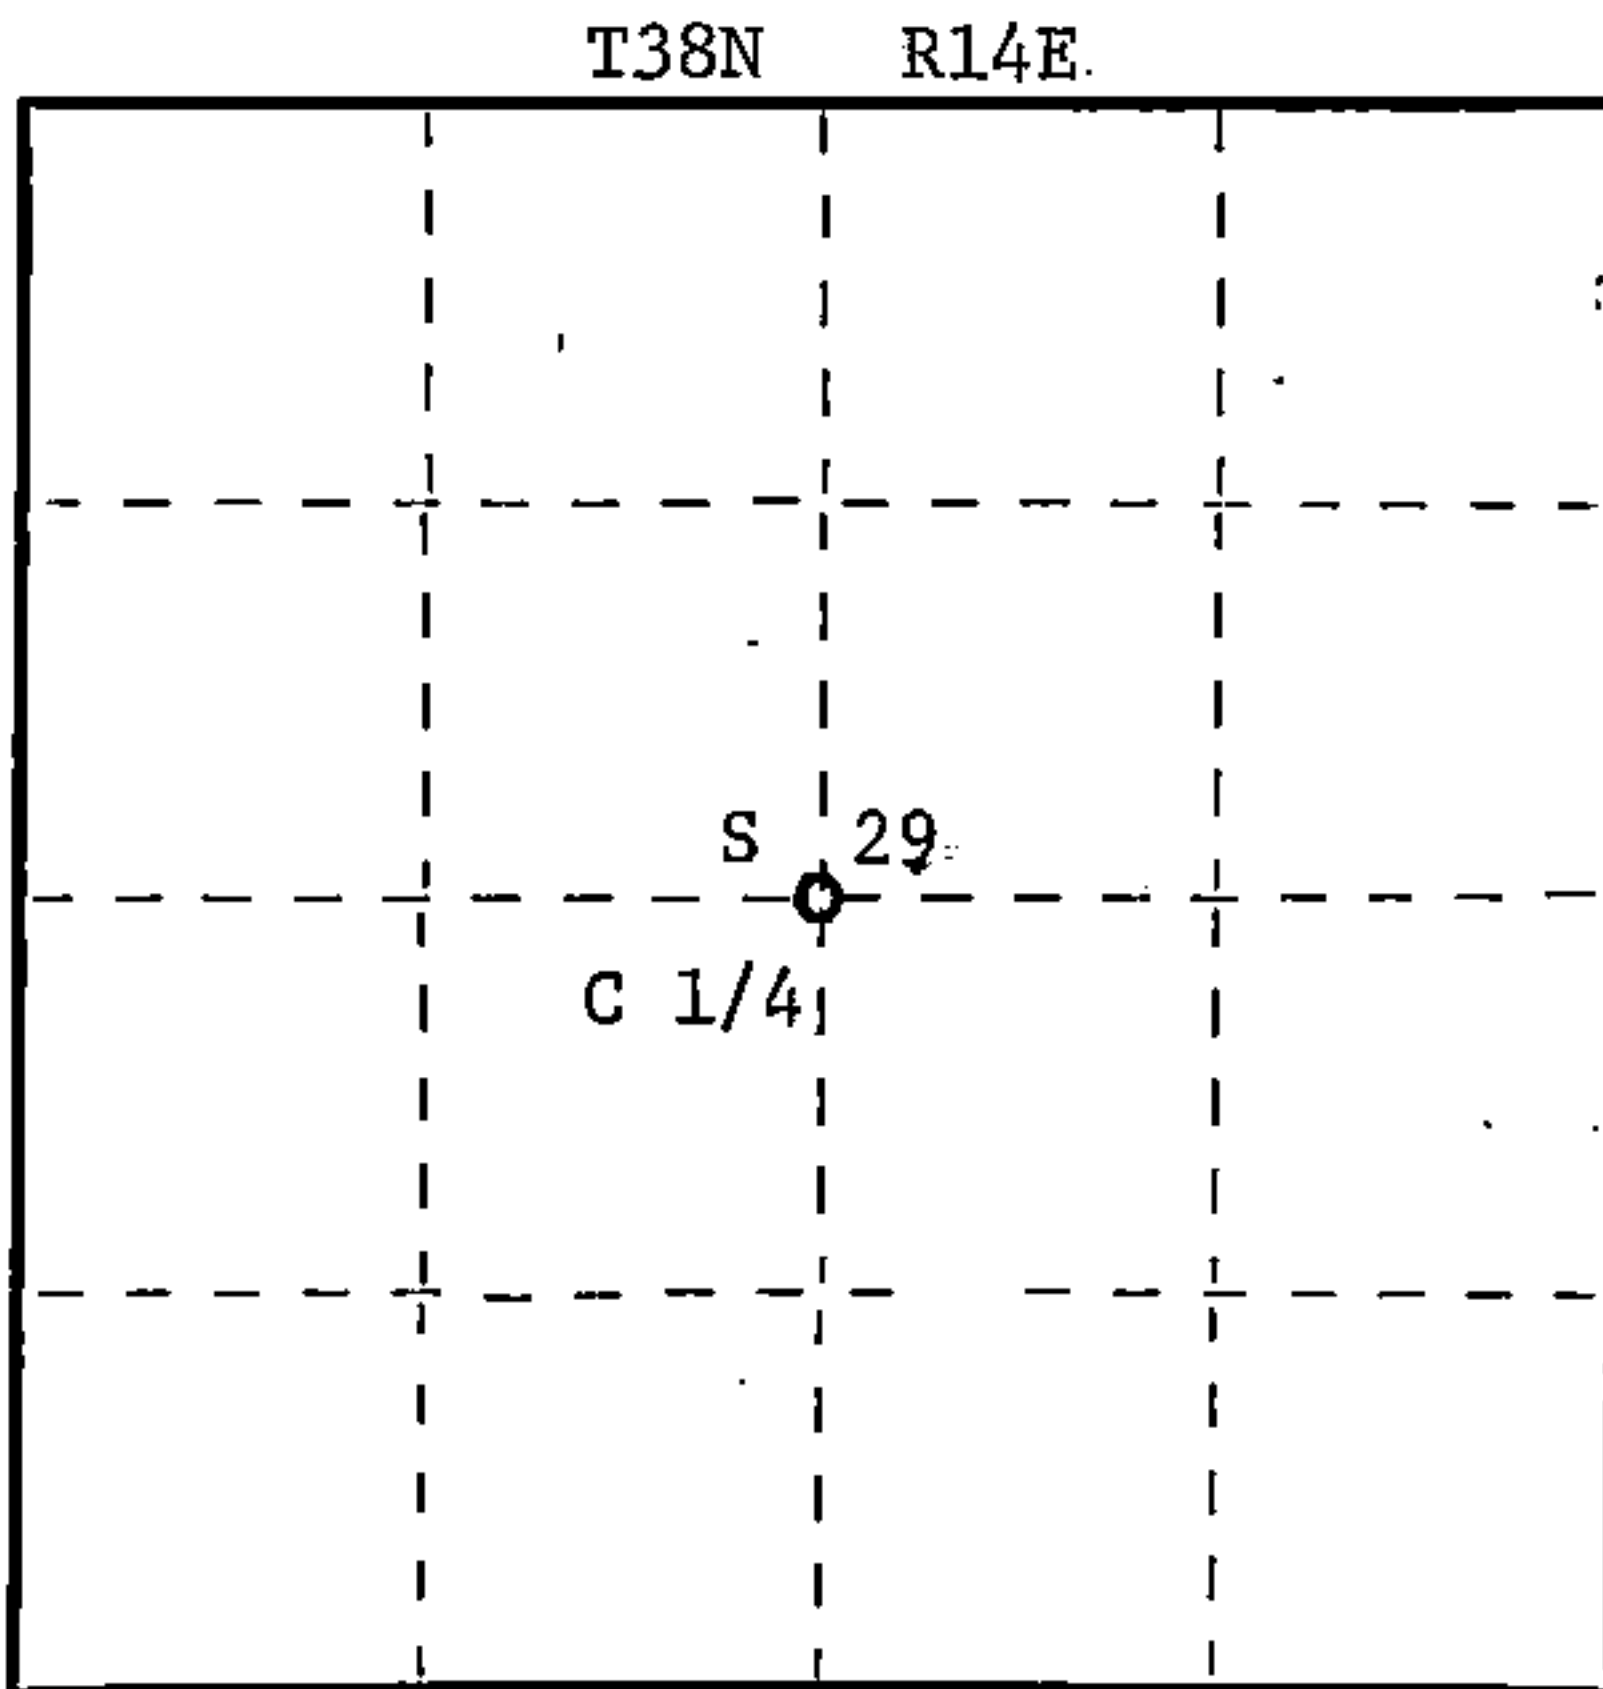

○ = Corner monument restored.

History of original corner establishment:

No evidence of any previous corner.

Description of corner evidence found:

Corner established by subdivision of section 29. C 1/4 corner sets 2638.04' of N 1/4 corner, 2633.85' of E 1/4 corner, 2631.48' of S 1/4 corner and 2731.03 of W 1/4 corner.

Description of monument and accessories I established to perpetuate the original location of this corner.

Set a 2-1/2" A-1 Federal aluminum monument with 3/4" alloy cap stamped: Monument projects 6" above ground.

Marked NBTs:

- Sugar Maple 6" N29W 27.12'
- Sugar Maple 6" S40W 13.22'
- Black Ash 6" S59E 12.69'

T38N
C 1/4 S 29
R14E
S1682 1985

Dated at Rhinelander, Wis., this 18th day of April, 1985

Signature: *Glen Barker* Title: Registered Land Surveyor Registration No. S1682
(County Surveyor, Registered Land Surveyor, or other duly authorized official)

Office of Register of Deeds, County of Forest, I hereby certify that the within instrument was filed in this office for record on the 3rd day of May, 1985 at 11:30 clock A.M.

Paul Aschenbrenner
(Register of Deeds)

By _____ Deputy

Document Number 127958

FORM 985 H. C. MILLER CO., MILWAUKEE

43814 29 2020