

Document Number 127510

FORM 985 R. C. MILLER CO., MILWAUKEE


State of Wisconsin }
County of Forest } ss.

I, Glen Barker, do hereby
certify that on the 13th day
of December 1984, I found
evidence of the EC 1/16
corner of Section 30
Township 38
14 East, Fourth Principal Meridian,
as described hereon; and that from this evidence
I established a new monument and accessories
as described hereon to perpetuate the original
location of this corner.

Resident witnesses:

N. Spiess

R. Lundt

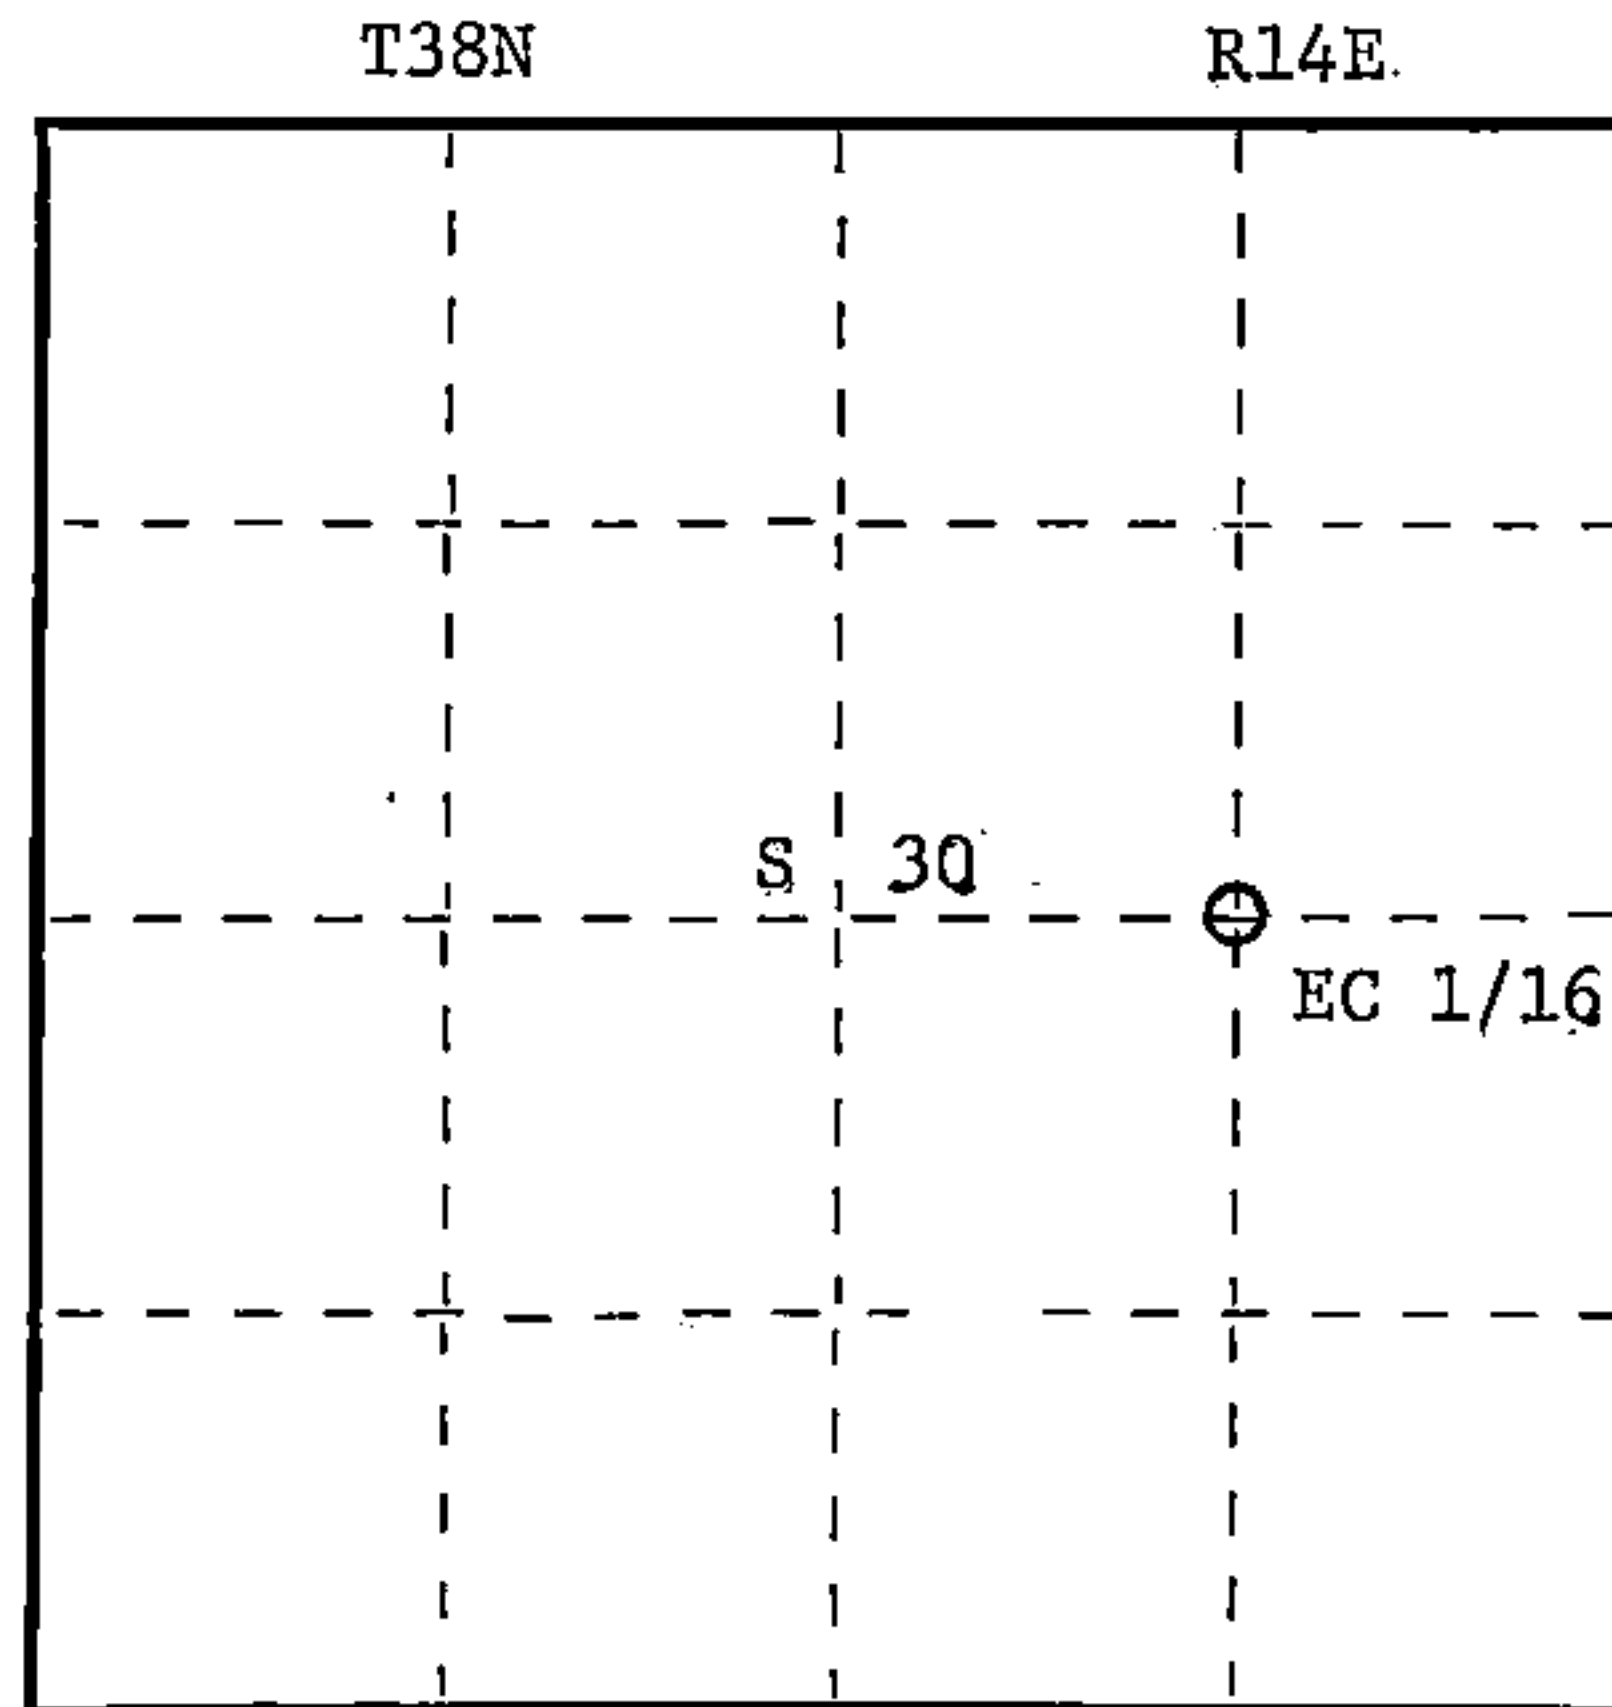

○ = Corner monument restored.

CERTIFIED LAND CORNER RESTORATION

Index No. T-4

History of original corner establishment:

No evidence of any previous corner.

Description of corner evidence found:

Total distance from 1/4 corner between sections 29 & 30 to C 1/4 Section 30 is 2596.78'
Set EC 1/16 1298.39' intermediate.

Description of monument and accessories I established to perpetuate the original location of this corner.

Set a 1" iron pipe with 2" diameter alloy cap stamped: S1682
Monument projects 18" above ground. T38N

Marked NBTs:

Maple 8" N73E 30.56'
Sugar 8" S11W 8.78'

CE 1/16 S30
CPI = 1984

Dated at Rhinelander, Wis., this 6th day of February, 1985

Signature: Glen Barker Title: Registered Land Surveyor Registration No. 1682
(County Surveyor, Registered Land Surveyor, or other duly authorized official)

Office of Register of Deeds, County of Forest
I hereby certify that the within
instrument was filed in this office for record on the 22nd day of February, 1985
at 2:15 o'clock P. M.

Paul Aschenbrenner
(Register of Deeds)

By Deputy

43814302010