

CERTIFIED LAND CORNER RESTORATION

Index No. 1 X 7

State of Wisconsin }  
County of Forest } ss.

I Philip T. Hansen, do hereby  
certify that on the 5th day  
of January, 19 76, I found  
evidence of the C-1/4  
corner of Section 32  
Township 38, North, Range  
14 East, Fourth Principal Meridian,  
as described hereon; and that from this evidence  
I established a new monument and accessories  
as described hereon to perpetuate the original  
location of this corner.


Resident witnesses:

Glen Barker

Jim Claflin



T38N R14E

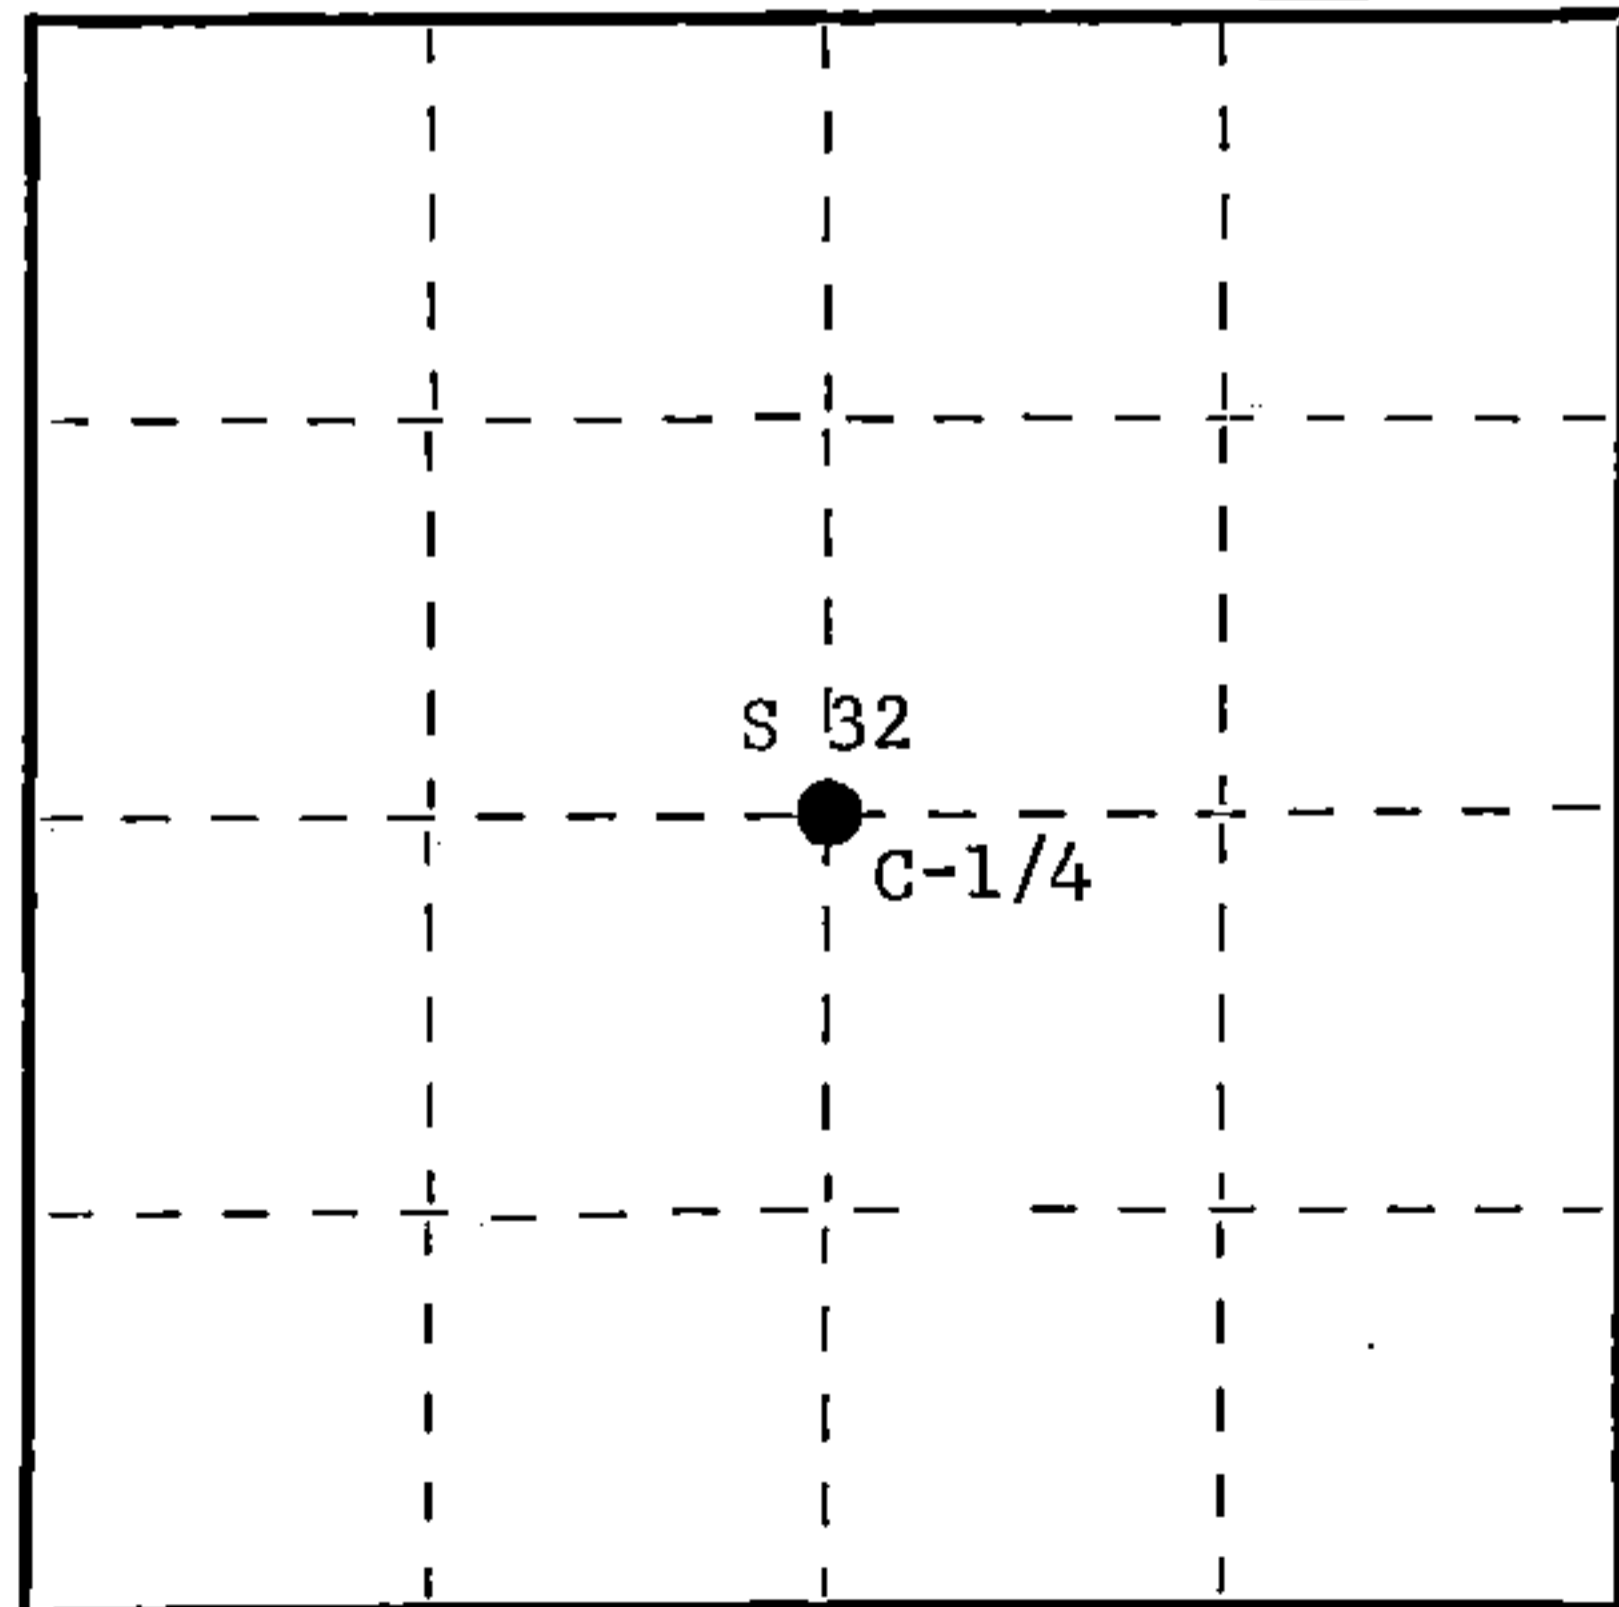

○ = Corner monument restored.

History of original corner establishment: Origin of this corner unknown. Corner was recovered by F. Hill and Mr. Moss in 1948 while running lines, cruising, and mapping. Recovered 5" squared cedar stake. No records of BT's recovered.

This corner has been maintained by Ray Leigh, Consolidated Forester, since recovery in 1948.


Description of corner evidence found: Recovered 5" squared cedar post in poor condition. No evidence of BT's was recovered.

Description of monument and accessories I established to perpetuate the original location of this corner.

Replaced 5" cedar post with 2-1/2" Berntsen, A-1 Federal Monument, aluminum with magnet installed in cap and base. Pipe projects 18" above ground. Cap stamped - Set old post beside new pipe.

NBT's - Cedar 10" S19°E 16.2 links scribed 1/4 BT  
Black ash 8" N60°E 24.6 links scribed 1/4 BT

Pipe, post, and NBT's painted blue.

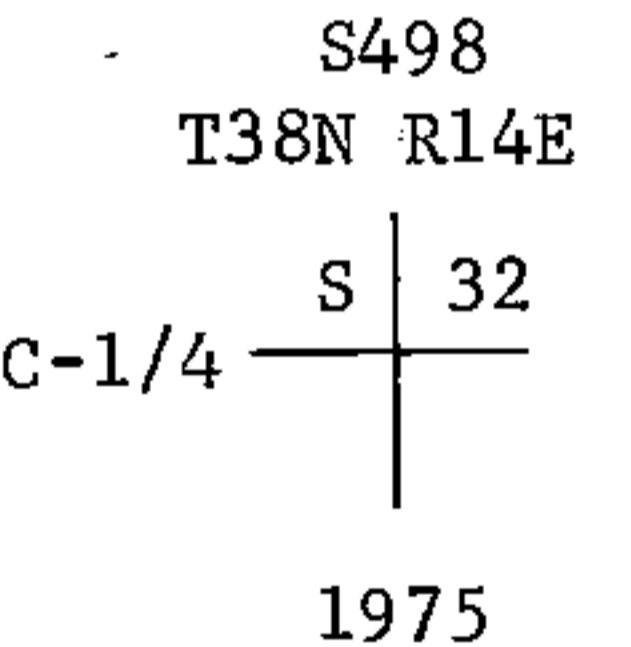

Dated at Argonne, Wis., this 12th day of January, 19 76.

Signature Philip T. Hansen Title Registered Land Surveyor Registration No. S-498  
(County Surveyor, Registered Land Surveyor, or other duly authorized official)

Office of Register of Deeds, County of Forest, I hereby certify that the within  
instrument was filed in this office for record on the 4th day of February, 19 76  
at 4:00 o'clock P. M.

Eugene Staszny  
(Register of Deeds)

By \_\_\_\_\_ Deputy

DOCUMENT NUMBER **108705**

FORM 985 H. C. MILLER CO., MILWAUKEE

43814 32 2020