

# CERTIFIED LAND CORNER RESTORATION

State of Wisconsin

County of Forest

ss.

I Jean F. Resvick, do hereby certify that on the 2 nd day of October, 19 69, I found evidence of the East Meander corner of Section 6 and 31 Township 37 and 38 North, Range 15 East, Fourth Principal Meridian, as described hereon; and that from this evidence I established a new monument and accessories as described hereon to perpetuate the original location of this corner:

## Description of original monument and accessories and subsequent restorations:


Township line surveyed in 1857 by Artemas Curtis.  
59.00 chains west between sections 6 and 31 set meander post.  
Yellow pine 12, bears N15W, 59 lks.  
Hemlock 14, bears S75E, 28 lks.

## Description of corner evidence found:



Yellow pine stump 3 feet tall, with lower blaze and scribed. At a bearing of S15E, a distance of 59 lks. from pine stump, corner falls in the edge of lake. From the point in edge of lake a rotten hemlock stump bears S75E, 28 lks.

## Description of monument and accessories I established to perpetuate the original location of this corner:

At a point, S15E a distance of 59 lks. from Yellow pine stump, set a 2 inch inside diameter galvanized wrought iron pipe 5 feet long, filled with concrete with brass cap marked.

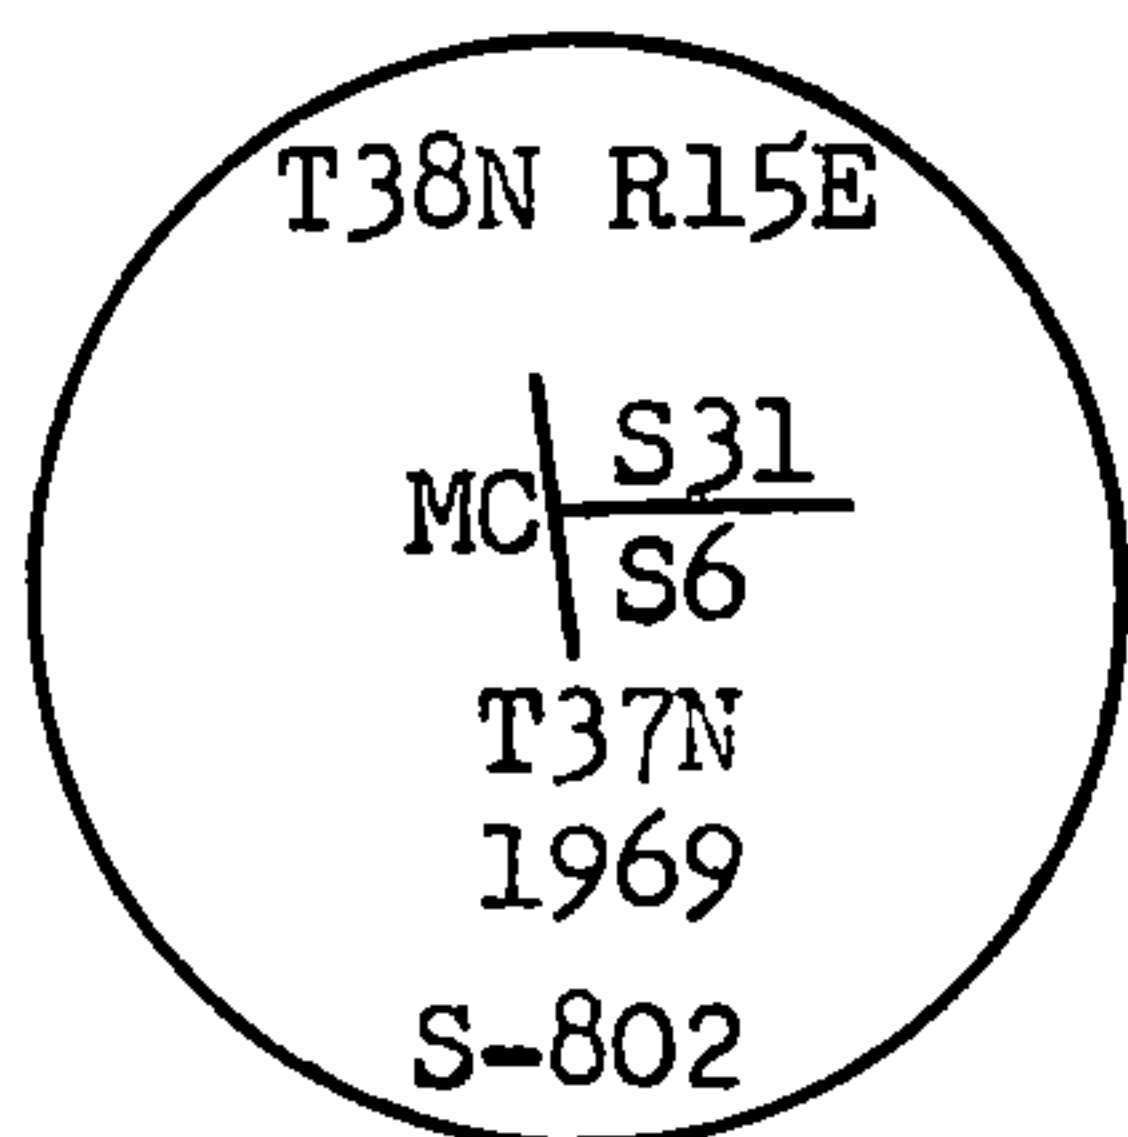

From which the following new blazed and scribed bearing trees bear:  
A Hemlock 8, bears N30E, 3.83 feet or 5.803 lks.  
A Red pine 7, bears S61E, 16.37 feet or 24.803 lks.  
This corner is in the water at the edge of shoreline.

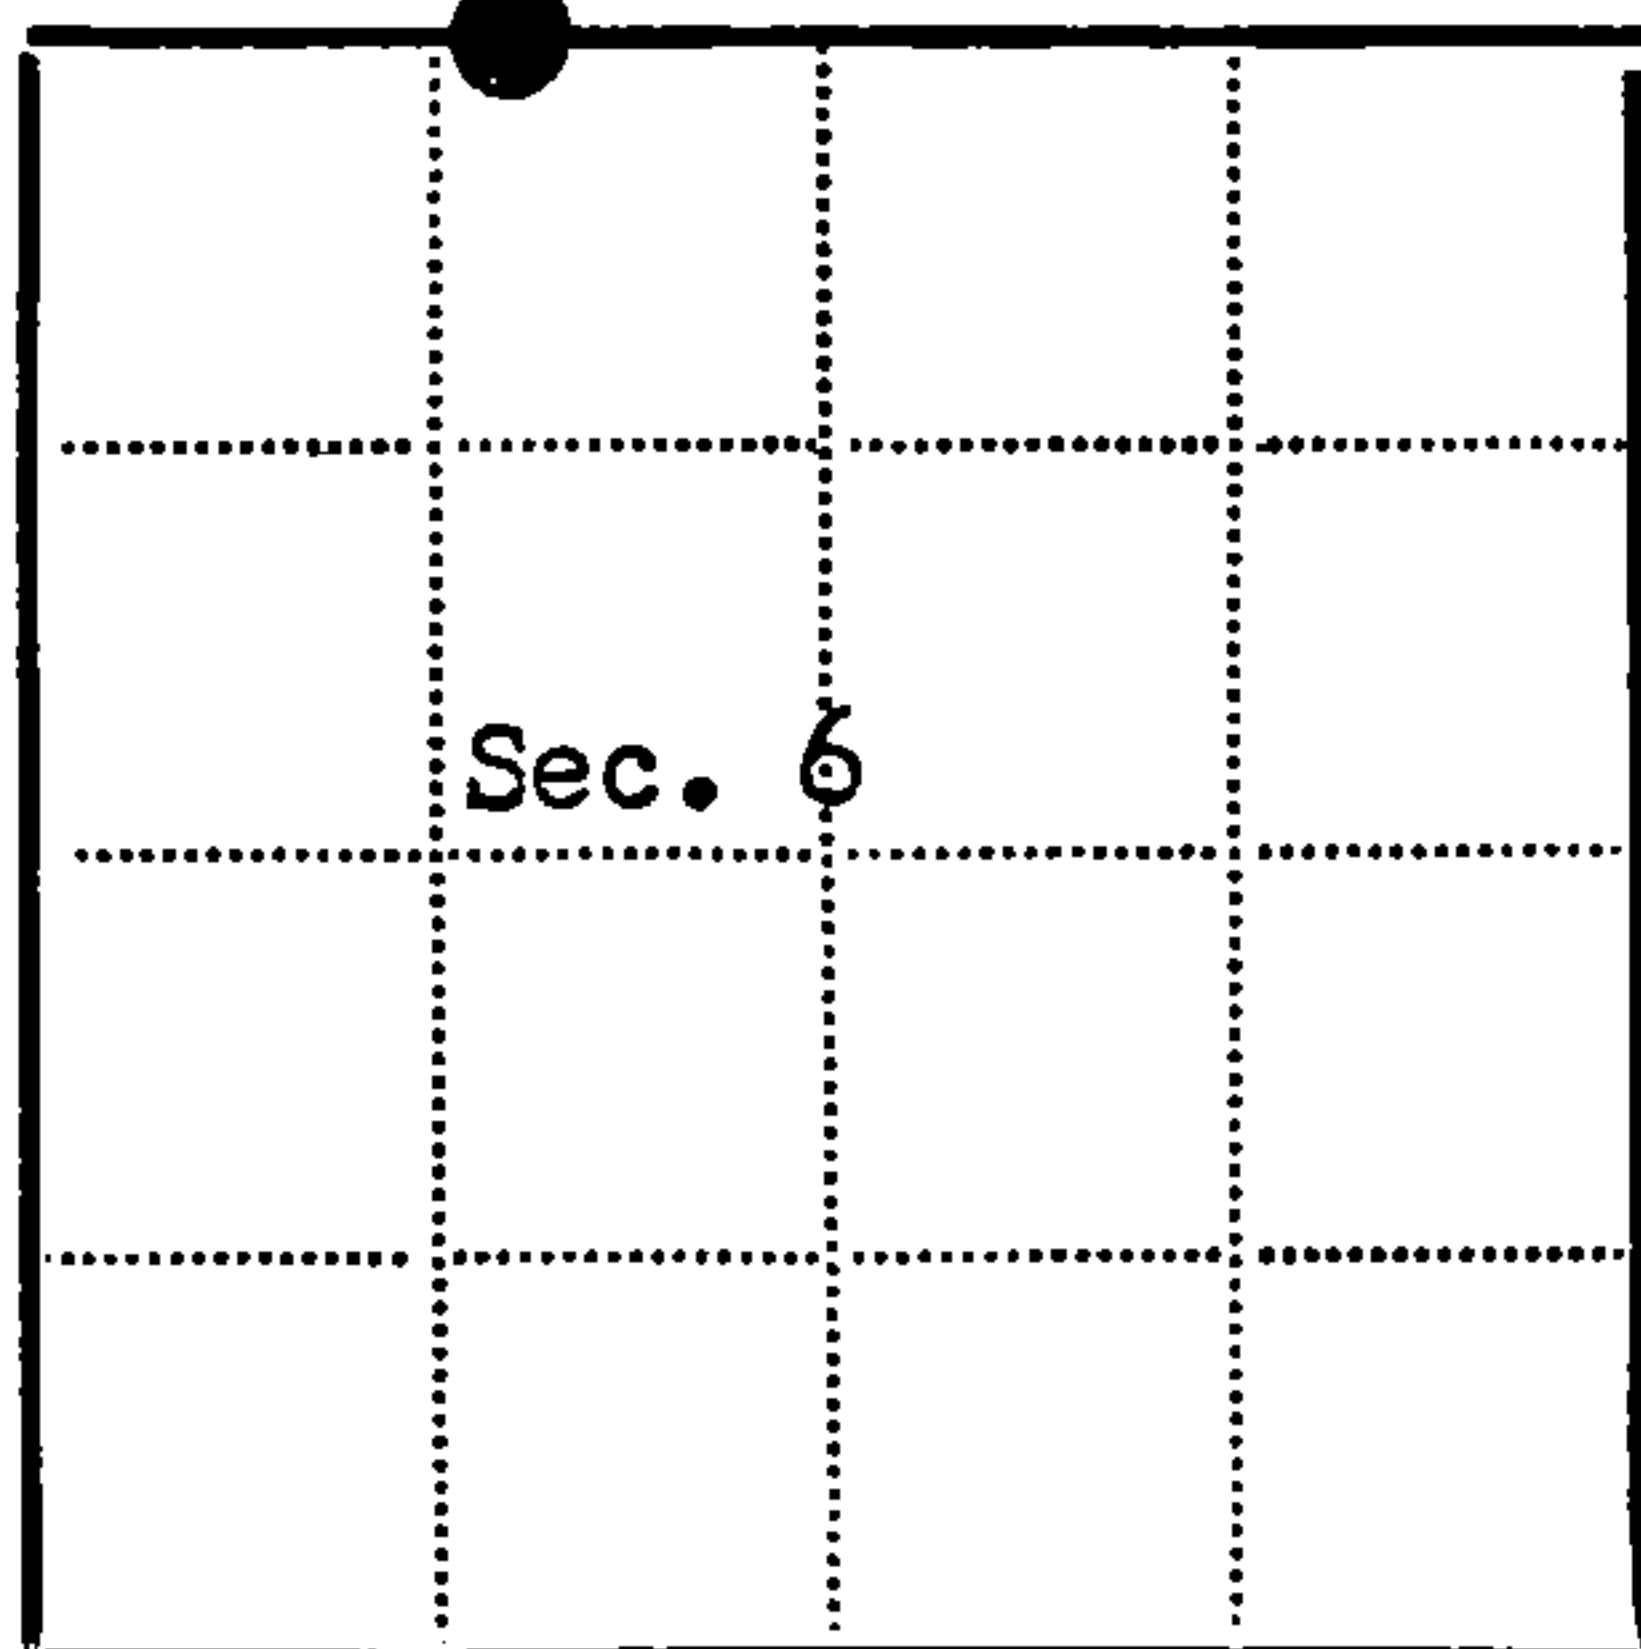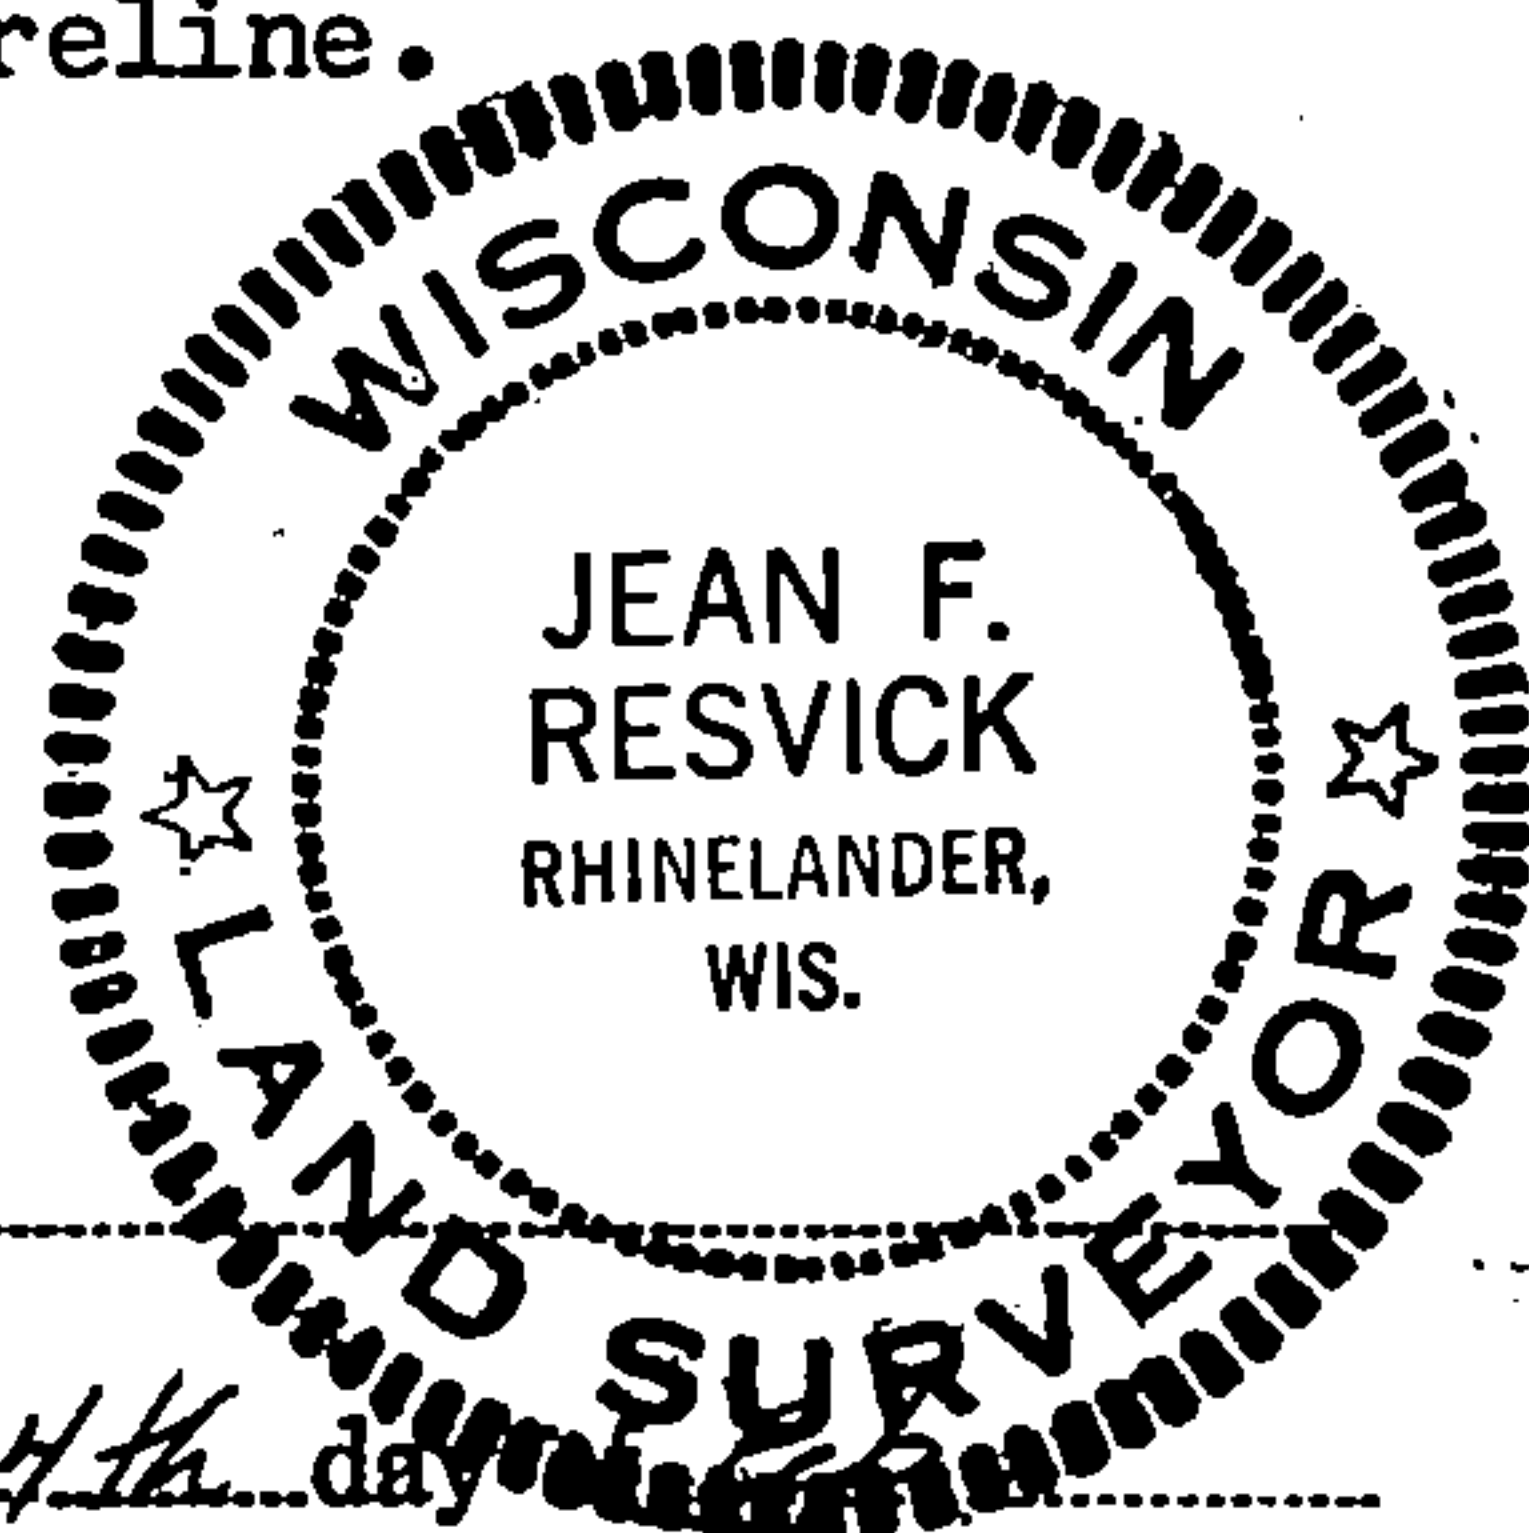

● = Corner monument restored

□ =

Resident witnesses

Dated at Rhinelanders Wisconsin, this 4th day of May 19 70.

Signature Jean F. Resvick Title Cadastral Surveyor  
(County Surveyor, Registered Land Surveyor, or other duly authorized official)

Surveyors Registration No. S-802 DOCUMENT NO. 98054

Office of Register of Deeds County of Forest

I hereby certify that the within instrument was filed in this office for record on the 22nd day of May 19 70, and was filed in Book No. Page No. A-2,3 of County Records.

Signature Eugene Stutzman Title Register of Deeds

Township 37 North, Range 15 East, Section 6, Index No. A-2,3, Page No.

43815310029

A 23