

## CERTIFIED LAND CORNER RESTORATION

State of Wisconsin

County of Forest

ss.

I Jean F. Resvick, do hereby certify that on the 31st day of October, 1974, I found evidence of the northeast section corner of Section 5 Township 37 North, Range 16 East, Fourth Principal Meridian, as described hereon; and that from this evidence I established a new monument and accessories as described hereon to perpetuate the original location of this corner:

## Description of original monument and accessories and subsequent restorations:


Surveyed in 1857 by Artemas Curtis  
80 chains west between sections 4 and 33 set post  
Spruce 8, N28W, 26 lks  
Tamarack 10, N64E, 36 lks  
White pine 16, S25E, 20 lks  
Hemlock 14, S47W, 34 lks  
0.50 chains west leave swamp bears NNW & SE

## Description of corner evidence found:


White pine stump, scribed OBT (this is not original scribing)  
Hemlock, fallen, has burned out face blaze  
At a point N25W, 20 lks from white pine the hemlock bears S49E, 34 lks  
A tamarack stump bears N64E, 36 lks from point  
A spruce stump bears N28W, 26 lks from point  
All four stumps found check to a common point by recorded distances and 3 bearings.

## Description of monument and accessories I established to perpetuate the location of this corner:

At position for the section corner set a 2 inch inside diameter galvanized iron pipe, 3 feet long, filled with concrete with a brass cap stamped, T38N, R16E, S32, S33, S5, S4, T37N, 1975, S-802  
Blazed and scribed the following new bearing trees:  
Spruce 3, N67E, 9.07 feet  
Spruce 8, S38E, 13.04 feet  
Spruce 6, S51W, 16.07 feet  
Spruce 4, N55W, 12.38 feet  
Set steel sign post 0.50 feet north of monument

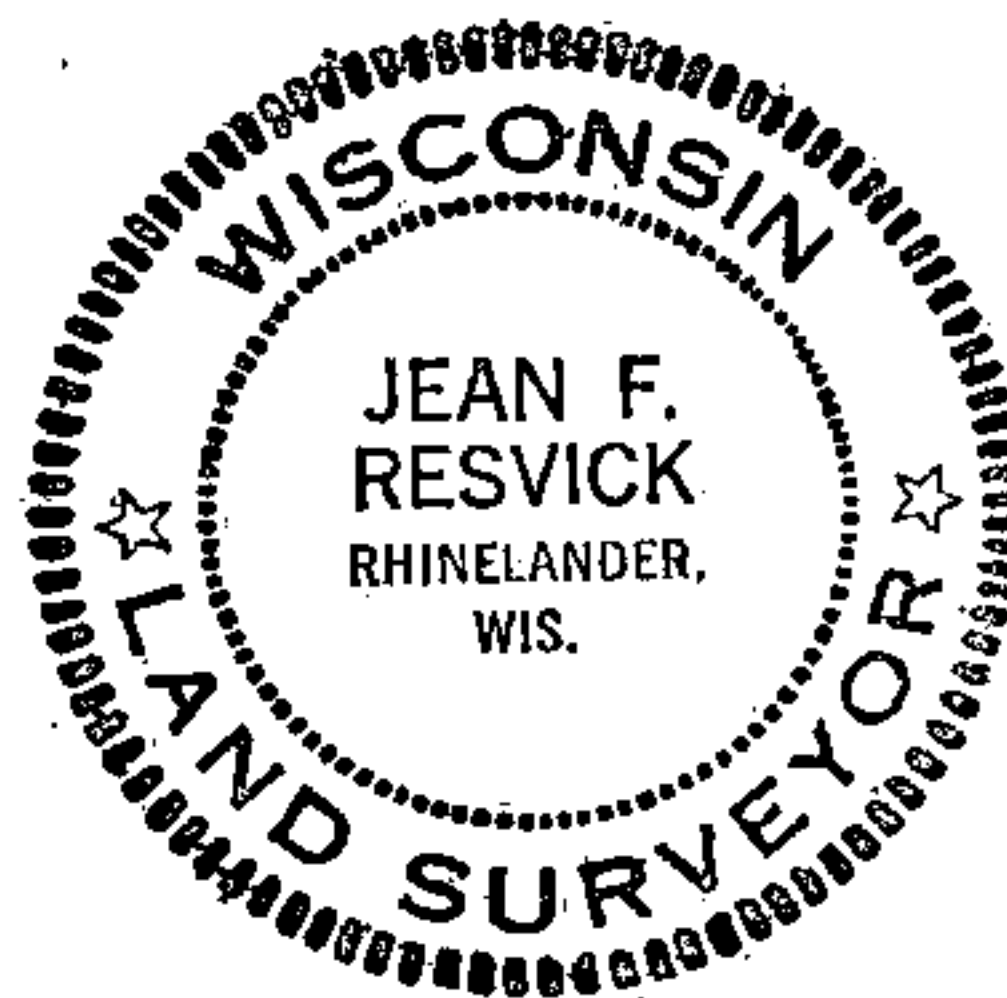

43816320000

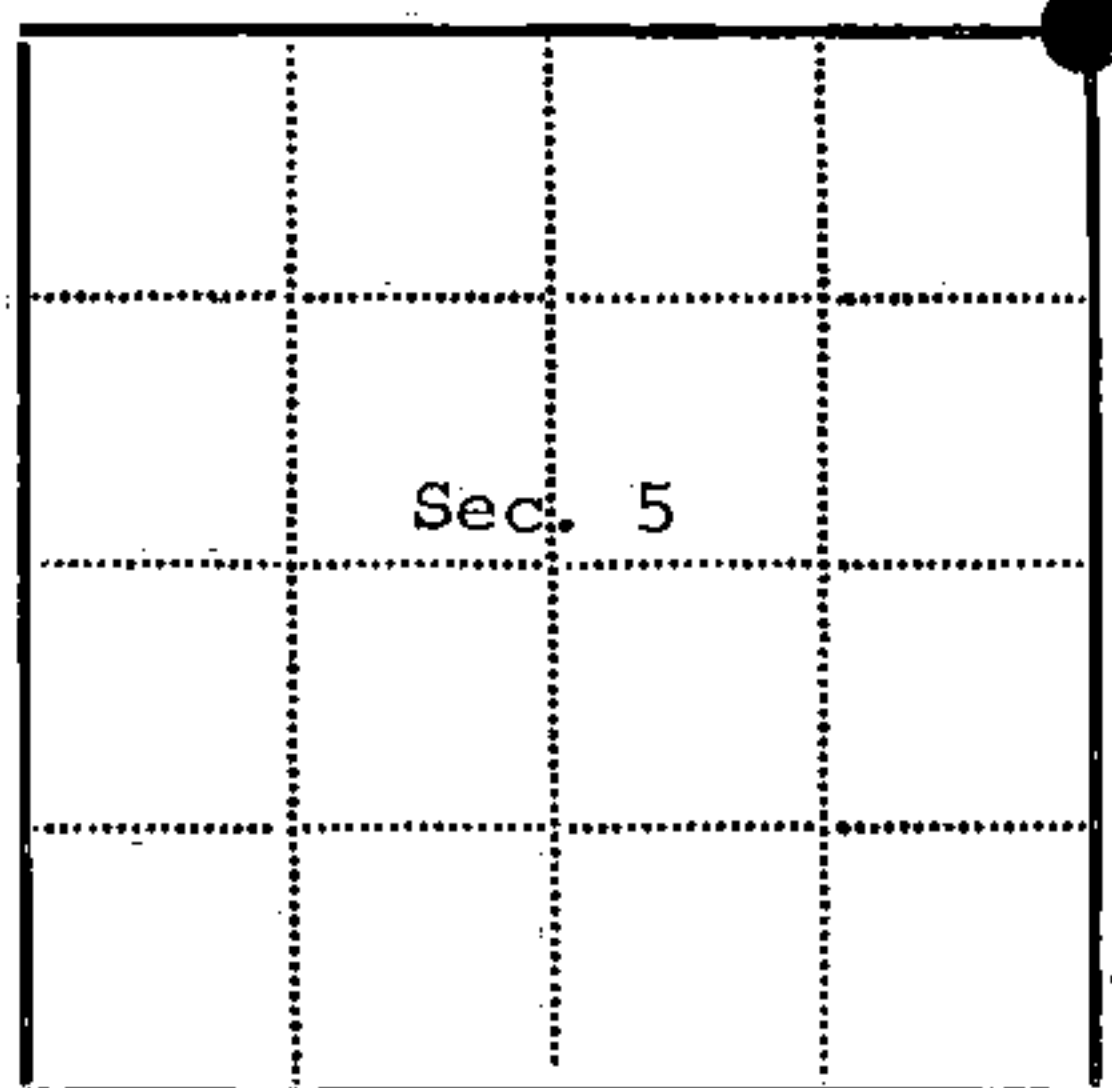

● = Corner monument restored

□ =

Resident witnesses

Dated at Rhineland Wisconsin, this 20 day of March, 1975.

Signature Jean F. Resvick Title Land Surveyor  
(County Surveyor, Registered Land Surveyor, or other duly authorized official)

Surveyors Registration No. S-802 Document Number 106872

Office of Register of Deeds County of Forest

I hereby certify that the within instrument was filed in this office for record on the 31st day of March, 1975, and was filed in Book No. Corner Page No. A-9 of County Records.

Signature Eugene Stutzman Title Register of Deeds

Township 37 North, Range 16 East, Section 5, Index No. A-9, Page No. 9


# U. S. PUBLIC LAND SURVEY MONUMENT RECORD

## INSTRUCTIONS:

This record shall show the location of the corner and shall include all of the following nine elements (a through i).

- (a) Identify the corner by reference to the U.S. public land survey system.  
○ = Corner monument restored.

Section Corner Common to Sections 4, 5, 32 and 33,  
Township 37 and 38 North, Range 16 East,  
Forest County, State of Michigan.

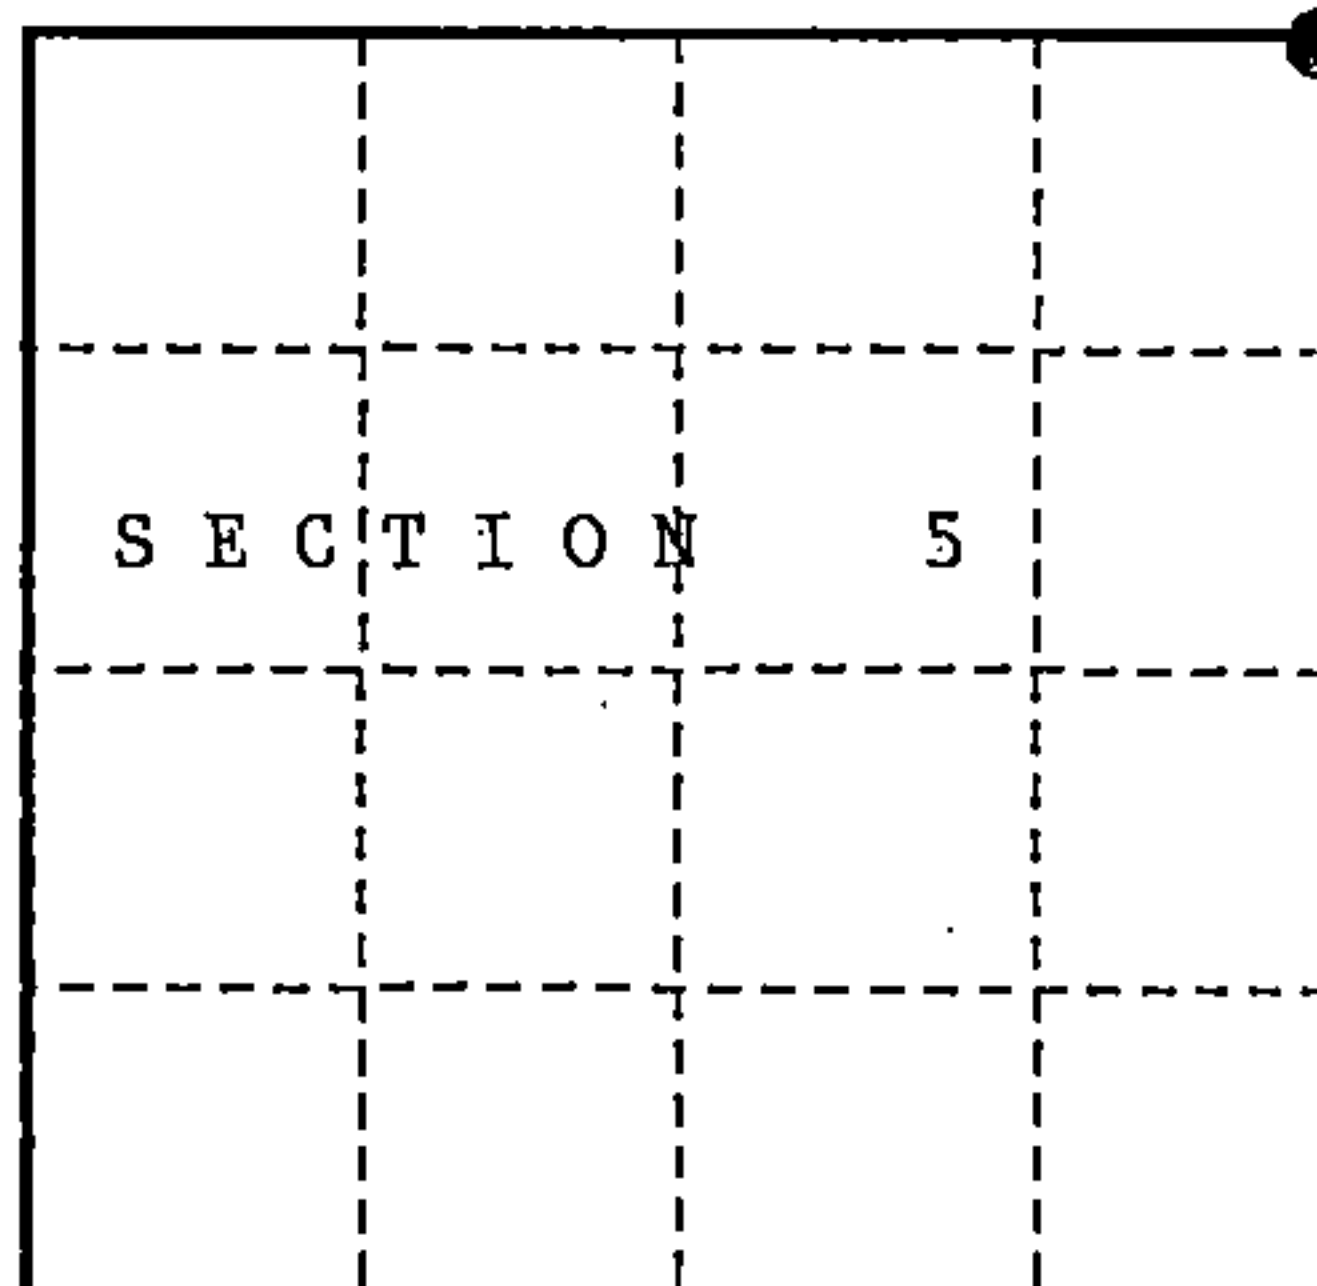

- (b) Describe any record evidence, monument evidence, occupational evidence, testimonial evidence or any other material evidence you considered, and whether the monument was found or placed.

In 1857, Artemas Curtis set a wooden post at the corner and established the following bearing trees:

Spruce	8"	bears N28°W, 26 lks.	Tamarack	10"	bears N64°E, 36 lks.
White pine	16"	bears S25°E, 20 lks.	Hemlock	14"	bears S47°W, 34 lks.

In 1975, Jean Resvick found all bearing trees and set a 2" dia. galvanized iron pipe filled with concrete with a brass cap stamped to identify the corner. The following corner references:

Steel sign post	North	0.5 ft.
Spruce	3"	bears N67°E, 9.07 ft.
Spruce	6"	bears S51°W, 16.07 ft.
Spruce	8"	bears S38°E, 13.04 ft.
Spruce	4"	bears N55°W, 12.38 ft.

In 1982, Kim Pritzlaff recovered monument in place and the 1975 corner references described on the Certified Land Corner Restoration form filed in the Forest County Register of Deed's Office, Document #106872.

In 1990, John Schulke recovered monument in place and the following corner references:


Spruce	5"	bears N63°E, 9.07 ft.	Spruce	11"	bears S47°E, 13.03 ft.
Spruce	8"	bears N53°W, 12.46 ft.	Steel sign post	bears North,	0.4 ft.

The following new corner references:

Spruce	5"	bears S67°W, 15.63 ft.
--------	----	------------------------

- (c) In the plan view drawing below, provide reference ties to at least 4 witness monuments, or, if the location is within a municipality, to at least 2 witness monuments. (Witness monuments shall be made of concrete, natural stone, iron or other equally durable material.)

- (d) Show a plan view drawing depicting the relevant monuments and reference ties which is sufficient in detail to enable accurate relocation of the corner monument if the corner monument is disturbed. Indicate north.

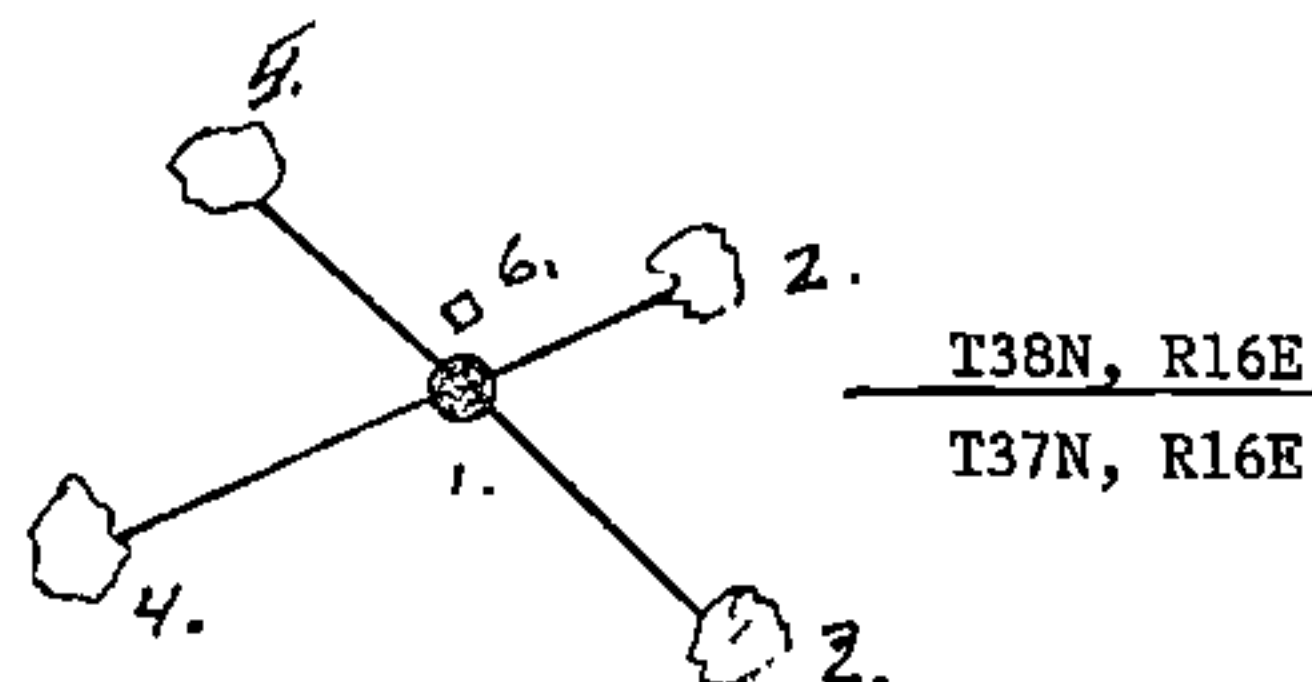

1. 2" dia. galvanized iron pipe with brass cap stamped to identify the corner.

- |                    |       |         |           |
|--------------------|-------|---------|-----------|
| 2. Spruce          | 5"    | N63°E   | 9.07 ft.  |
| 3. Spruce          | 11"   | S47°E   | 13.03 ft. |
| 4. Spruce          | 5"    | S67°W   | 15.63 ft. |
| 5. Spruce          | 8"    | N53°W   | 12.46 ft. |
| 6. Steel sign post | North | 0.4 ft. |           |

REGISTER'S OFFICE  
Forest County, Wis.

Received for record this 19th day

of December A.D., 1990 at

8:45 o'clock A.M. and recorded

In Vol. Corner Restoration

page A-9

Paul H. Schenck

Register of Deeds

43816320000

- (e) Describe any material discrepancy between the location of the corner as restored or reestablished and the location of that corner as previously restored or reestablished by distance and direction. Show the discrepancy on the plan view drawing under (d), above. Show the distances between the corner as previously restored or reestablished and (1) the corner as restored or reestablished, and (2) to at least 2 of the witness monuments shown on the drawing in (d), above.

NONE:

- (f) Was the corner restored through acceptance of (1) an obliterated evidence location, or, (2) a found perpetuated location?


(2) found perpetuated location.

- (g & h) Was the corner reestablished through lost corner proportionate methods? If so, show the method, including the directions and distances to other public land survey corners used as evidence or used for proportioning in determining the corner location?

NO.

(1) I, John Schulke a Register Land Surveyor

(type or print name) certify that the corner location shown on this record was determined by me or under my direction and control and that this U.S. Public Land Survey Monument Record is correct and complete to the best of my knowledge and belief.

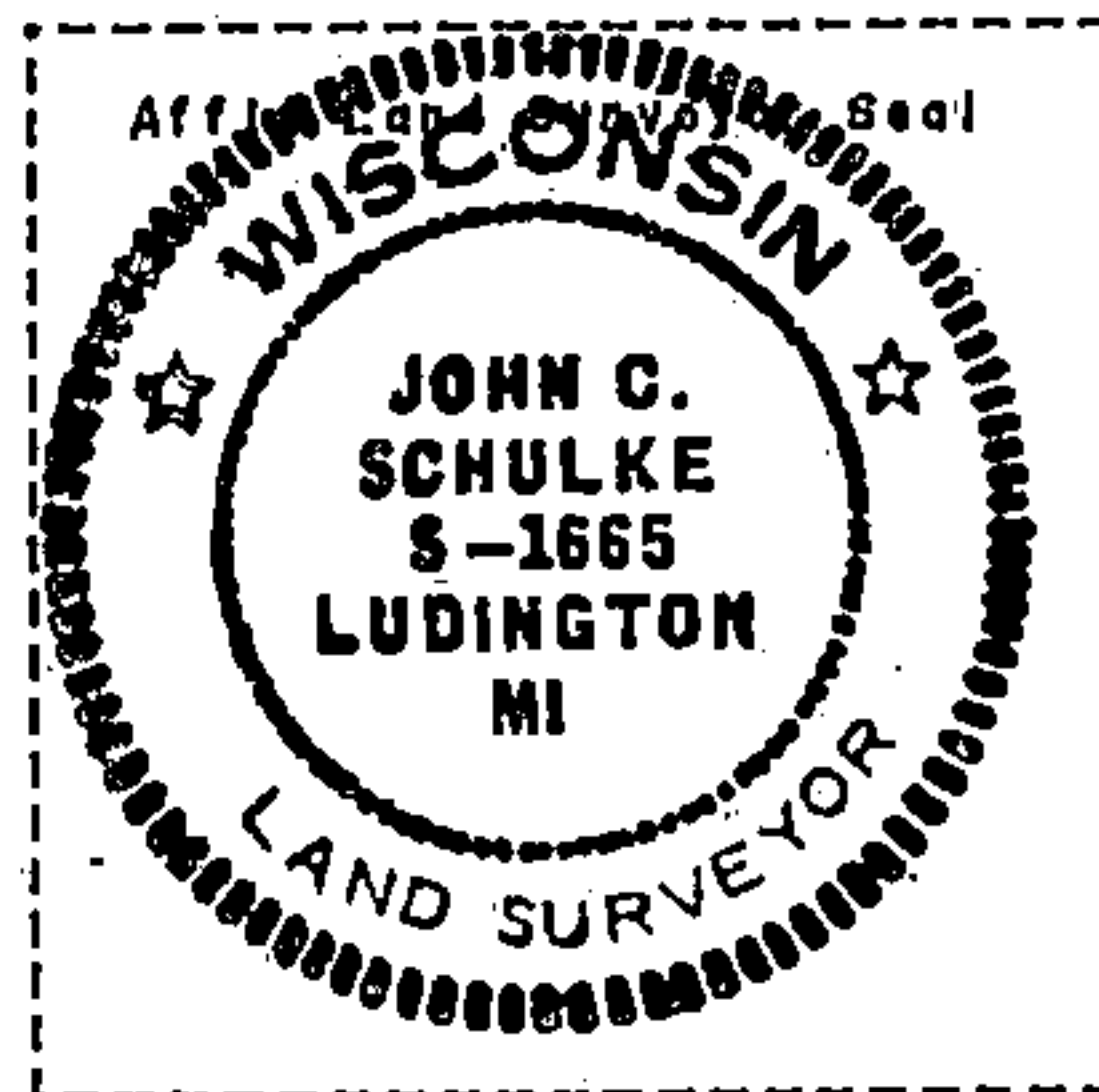

John Schulke  
Signature

9/21/90  
Date

CERTIFICATE READY FOR FILING:

Dale B. Stage  
District Ranger