


CERTIFIED LAND CORNER RESTORATION

State of Wisconsin }
County of Forest } ss.

I, Jean F. Resvick, do hereby certify that on the 25th day of October, 1965, I found evidence of the East quarter corner of section 9 Township 39 North, Range 12 East, Fourth Principal Meridian, as described hereon; and that from this evidence I established a new monument and accessories as described hereon to perpetuate the original location of this corner:

Description of original monument and accessories and subsequent restorations:

Dependent resurvey in 1941 by Guy R. Veal.
Set iron post 3 ft. long, 2 ins., diameter, 22 ins. in ground to rock, for 1/4 sec. corner with brass cap marked:

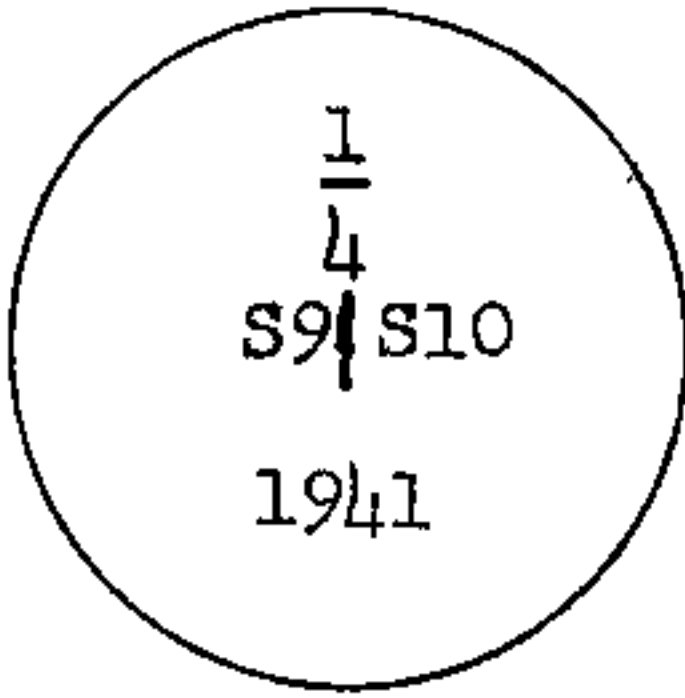


from which maple 8 ins., bears N47° 30'E, 125 lks.
yellow birch 10 ins., bears S77°W, 110 lks.

Description of corner evidence found:

Monument found as described above lying on the ground.
Maple 18 ins., scribed
Yellow birch 11, scribed and dead.

Description of monument and accessories I established to perpetuate the original location of this corner:

I located the correct position for corner from the two witness trees found above.
I then reset the monument found in position, removing the rock and setting monument 8 ins. above ground and mounded with rock.
I set a 4x4 cedar post on west side of monument.

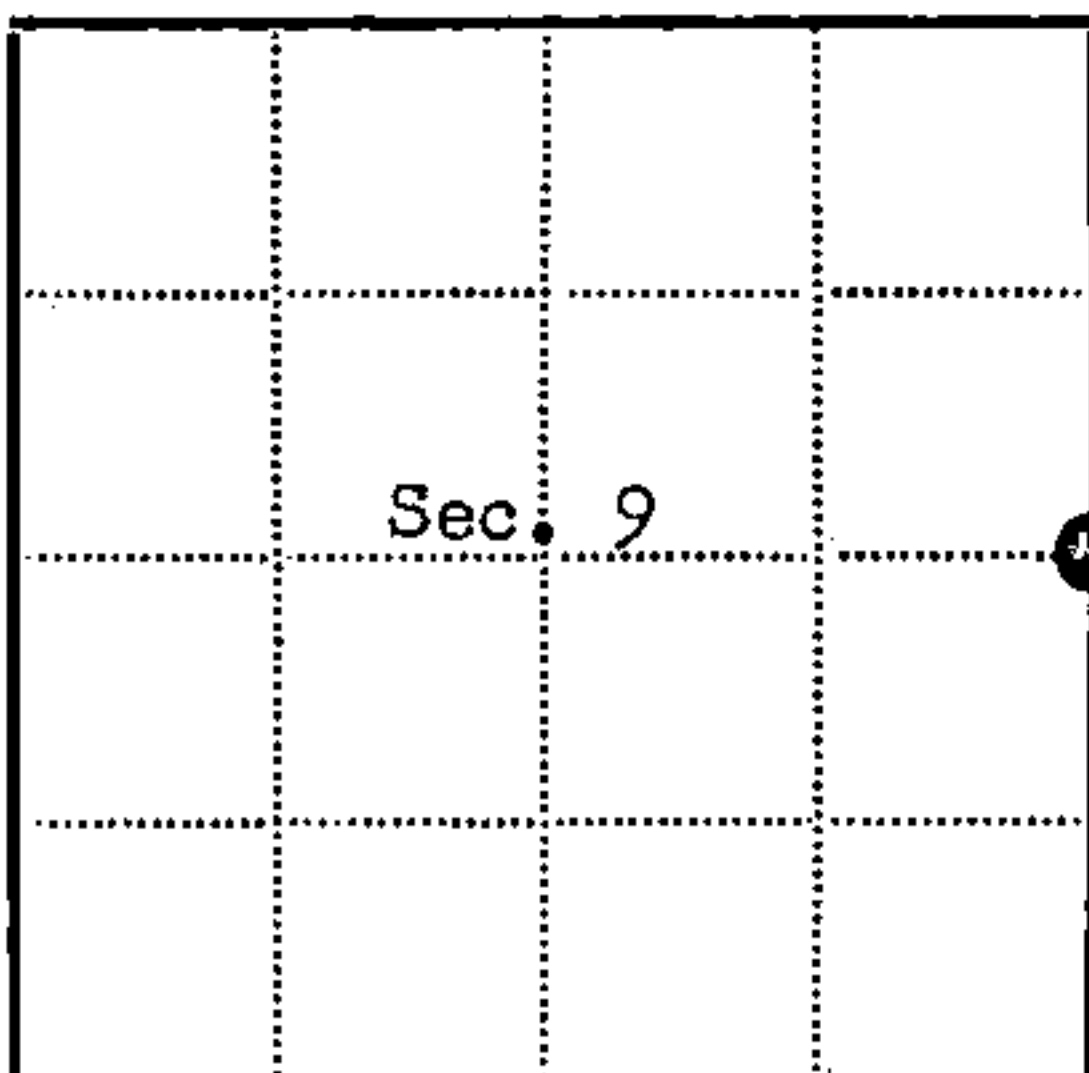

● = Corner monument restored
□ =

Resident witnesses.....

Dated at Rhinelander Wisconsin, this 17th day of March 1967.

Signature Jean F. Resvick Title Cadastral Surveyor
(County Surveyor, Registered Land Surveyor, or other duly authorized official)

Surveyors Registration No. S-802 DOC. NO. 94228

Office of Register of Deeds County of Forest

I hereby certify that the within instrument was filed in this office for record on the 27th day of February 1968, and was filed in Book No. I Page No. of County Records.

Signature Eugene Stegny Title Register of Deeds

Township 39 North, Range 12 East, Section 9, Index No. G-13, Page No.

43912092000

15