

CERTIFIED LAND CORNER RESTORATION

State of Wisconsin

County of Forest

ss.

I William B. Cochrane, do hereby certify that on the 9th day of February, 1976, I found evidence of the South Quarter corner of Section 13 Township 39 North, Range 12 East, Fourth Principal Meridian, as described hereon; and that from this evidence I established a new monument and accessories as described hereon to perpetuate the original location of this corner:

Description of original monument and accessories and subsequent restorations:

Surveyed in September 1859 by Wm. E. Daugherty.
Dependent resurvey in 1941 by H.D. Craig
At proportionate distance set a concrete monument, 6 ins. diameter, 24 ins. long, 17 ins. in the ground with a brass cap stamped: 1/4, S13, S24, 1941
From which the following bear:
W. Pine, 9 ins., N5°W, 40.5 lks.
W. Pine, 8 ins., S38°E, 39 Lks.

Description of corner evidence found:



Monument as described above. Monument was tipped and the top is damaged from logging operations. The brass cap is stable and readable.
Reset the monument from the bearing tree stumps.
W. Pine, stump, scribed, N5°W, 40.5 Lks.
W. Pine, stump, S38°E, 39 Lks.

Description of monument and accessories I established to perpetuate the location of this corner:

Blazed and scribed the following new bearing trees:

Maple, 10 ins., N87°W, 27.28 feet
Maple, 10 ins., S19°W, 46.70 feet

Set a steel sign post, East of the monument, 0.50 ft.

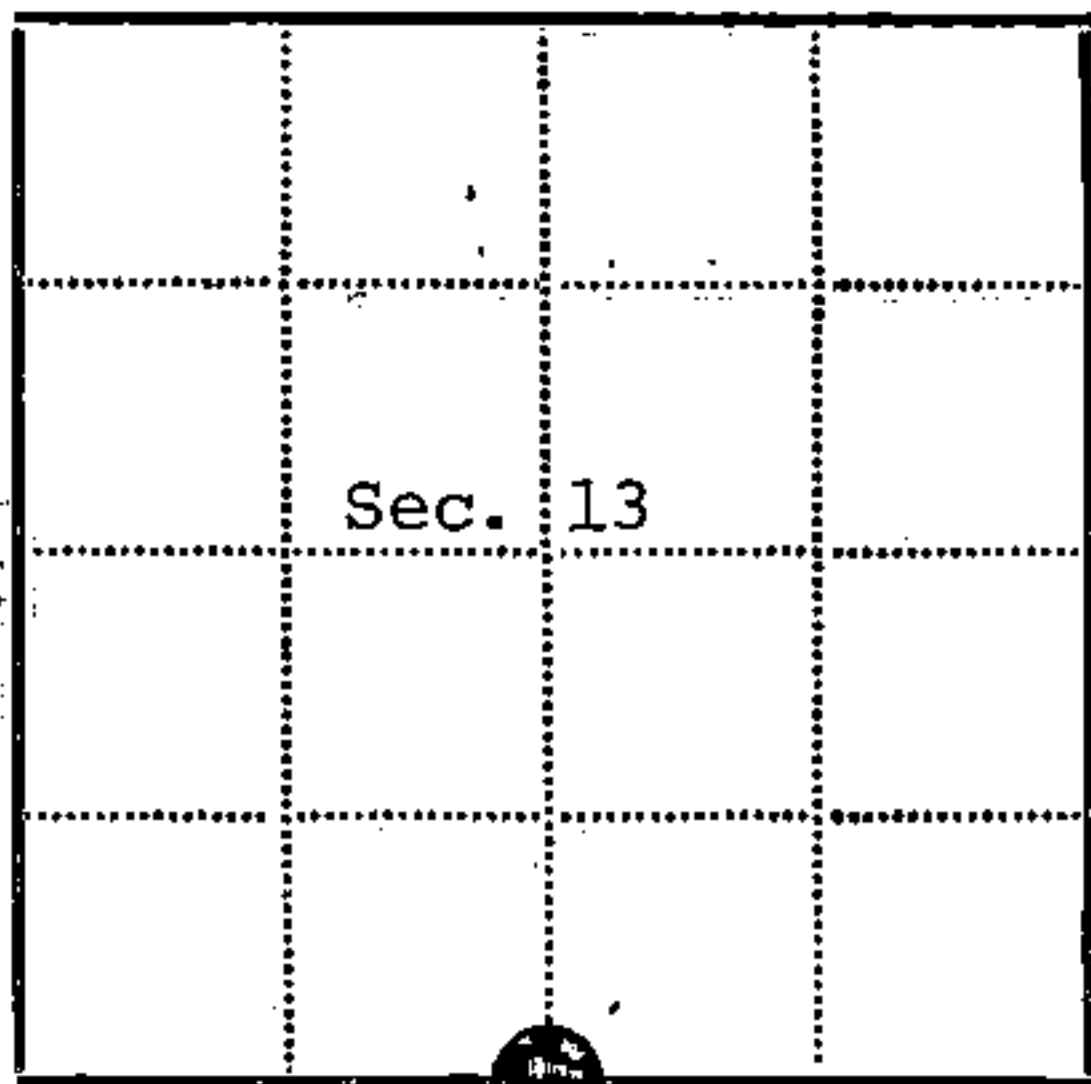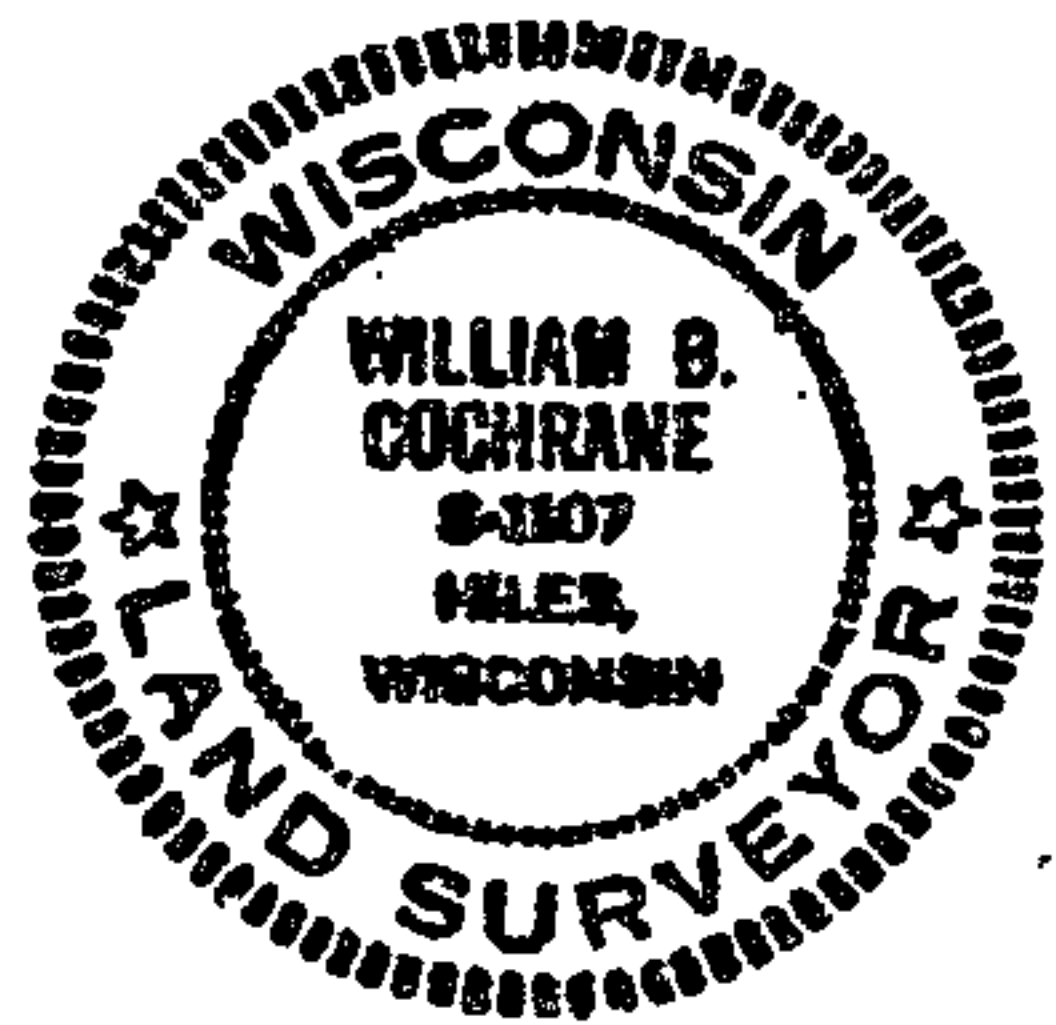

Legend:
● = Corner monument restored
□ =

Resident witnesses

Dated at Three Lakes Wisconsin, this 16th day of April 1976.

Signature William B. Cochrane Title Survey Technician
(County Surveyor, Registered Land Surveyor, or other duly authorized official)

Surveyors Registration No. S-1107 DOCUMENT NUMBER 109591

Office of Register of Deeds County of Forest

I hereby certify that the within instrument was filed in this office for record on the 2nd day of July 1976, and was filed in Book No. Page No. of County Records.

Signature Eugene Stutzman Title Register of Deeds

Township 39 North, Range 12 East, Section 13, Index No. N-23, Page No.

43912130020

N23