

CERTIFIED LAND CORNER RESTORATION

State of Wisconsin }
County of Forest } ss.

I Jean F. Resvick, do hereby certify that on the 13 day of June, 1977, I found evidence of the South quarter corner of Section 15 Township 39 North Range 12 East, Fourth Principal Meridian, as described hereon; and that from this evidence I established a new monument and accessories as described hereon to perpetuate the original location of this corner:

Description of original monument and accessories and subsequent restorations:



Original survey in 1859 by Wm. E. Daugherty. Dependent resurvey in 1941 by Hal D. Craig. Proportional distance set an iron post 3 ft. long, 2 ins. diam., 24 inches in ground with brass cap marked: S15, 1/4, S22, 1941
Tamarack 8, bears N3W, 14 lks. marked 1/4, S15 BT
Tamarack 7, bears S33E, 19 lks. marked 1/4, S22 BT
Local corner, bears S2E, 157 1/2 lks.
Local corner, bears S1W, 151 1/2 lks.
Set tamarack post 8 ft. long, 4 in. square alongside monument.

Description of corner evidence found:

- 1. Monument as described.
- 2. Black spruce 8, S33E, 12.85 ft. scribed 1/4, S22 BT
- 3. Balsam windfall, rotten, no sign of marks, N3W, 9.2 ft.
- 4. Tamarack post 8 ft. long, 4 in. square alongside monument.
- 5. Did not find the 2 local corners or tamarack bearing trees, it appears that trees were not properly identified.

Description of monument and accessories I established to perpetuate the location of this corner:

Stabilized monument by driving tamarack posts, 18 inches long around monument, tops below surface level.
Blazed and scribed the following new bearing trees:
Tamarack 6, N21E, 22.57 feet
Black spruce 7, S61W, 30.71 feet
Set steel sign post 4 inches west of monument

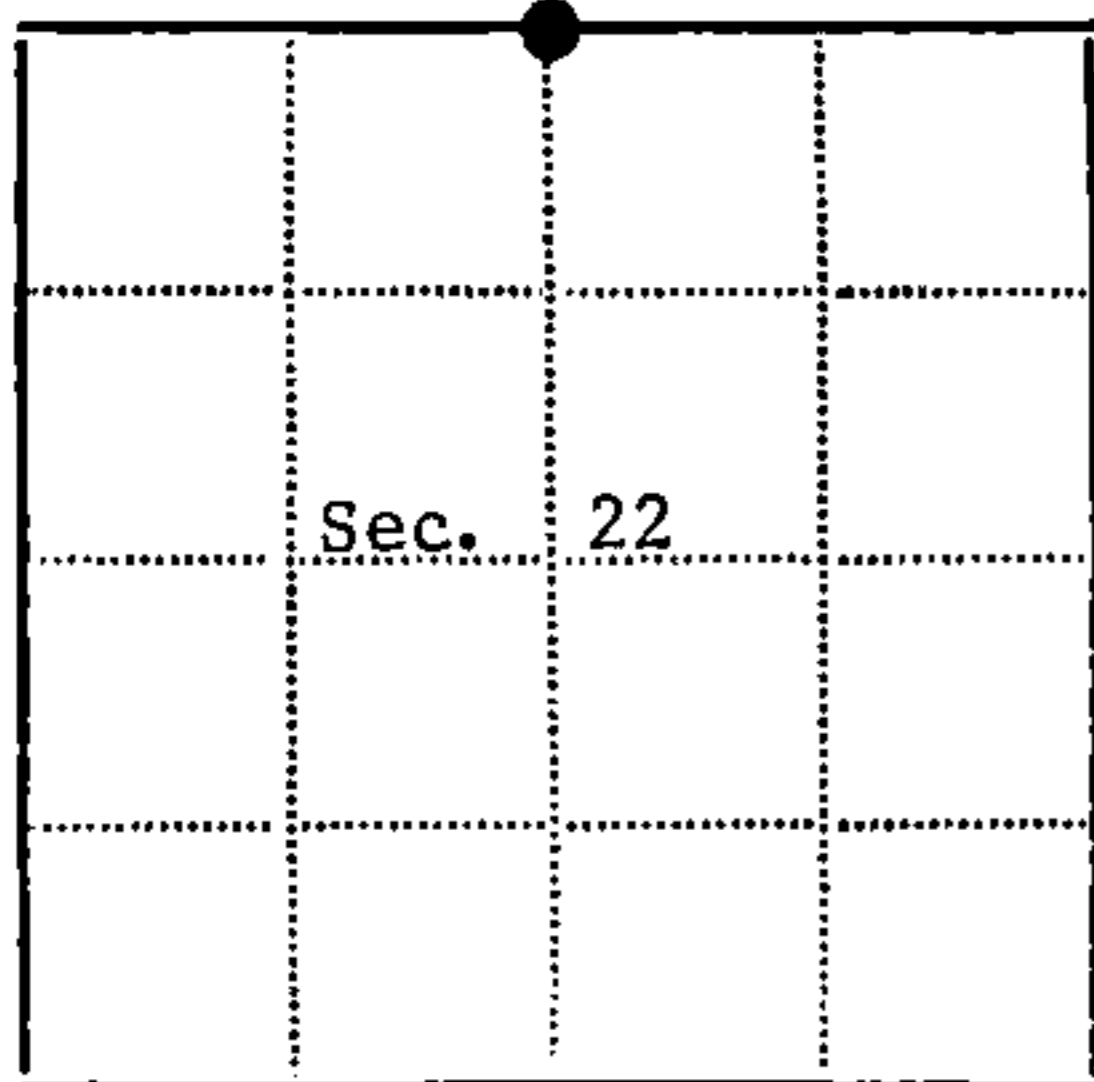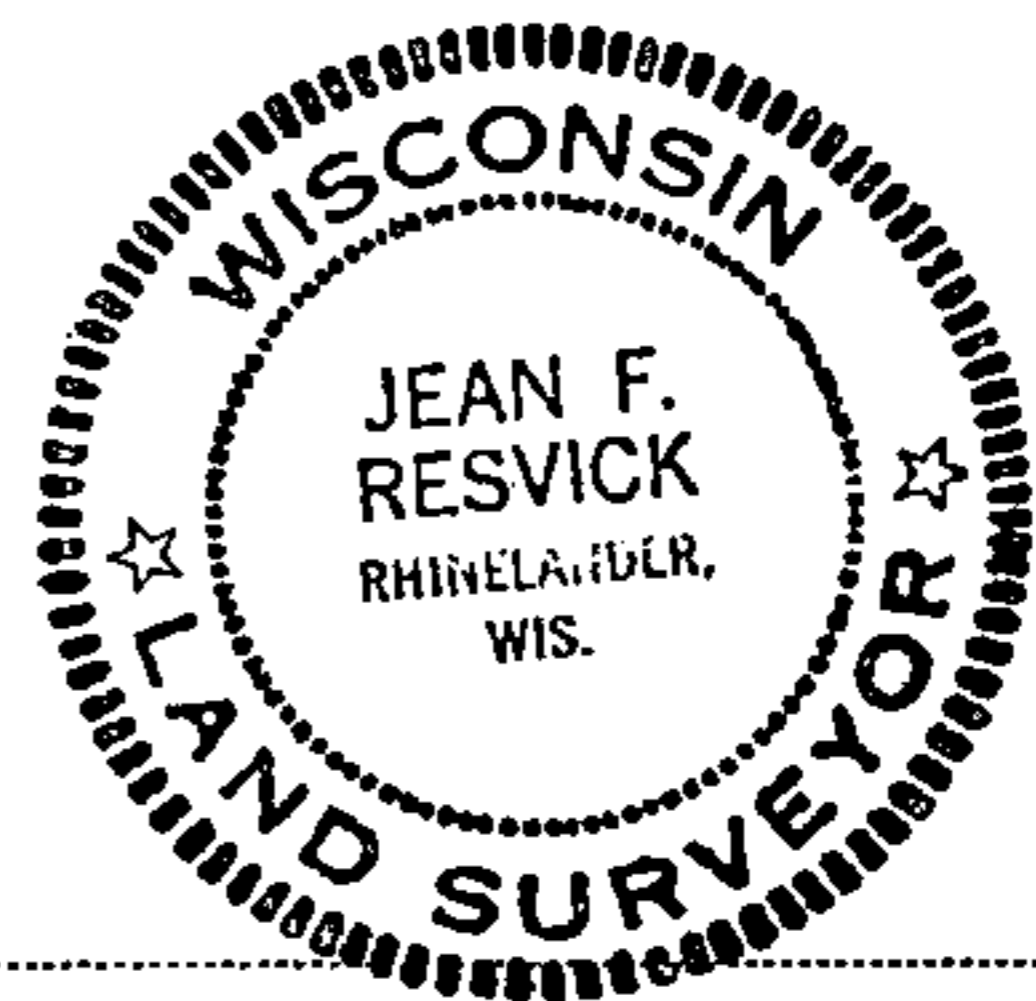

● - Corner monument restored
□ -

Resident witnesses.....

Dated at Rhinelander Wisconsin, this 21 day of July 1977.

Signature Jean F. Resvick Title Land Surveyor
(County Surveyor, Registered Land Surveyor, or other duly authorized official)

Surveyors Registration No. S-802 DOCUMENT NUMBER 113306

Office of Register of Deeds County of Forest

I hereby certify that the within instrument was filed in this office for record on the 13th day of February 1978, and was filed in Book No. Page No. of County Records.

Signature Eugene Stutzman Title Register of Deeds

Township 39 North Range 12 East Section 22 Index No. N-15 Page No.

43912150020

N15