

U.S. PUBLIC LAND SURVEY MONUMENT RECORD


Index No. N-7

State of Wisconsin }
County of Columbia } ss.

I JAMES R. GROTHMAN, do hereby certify that on the 7th day of October, 1986, I found evidence of the One Quarter corner of Sections 17 and 20 Township 39, North, Range 12 East, Fourth Principal Meridian, as described hereon; and that from this evidence I established a new monument and accessories as described hereon to perpetuate the original location of this corner.

Resident witnesses:

None

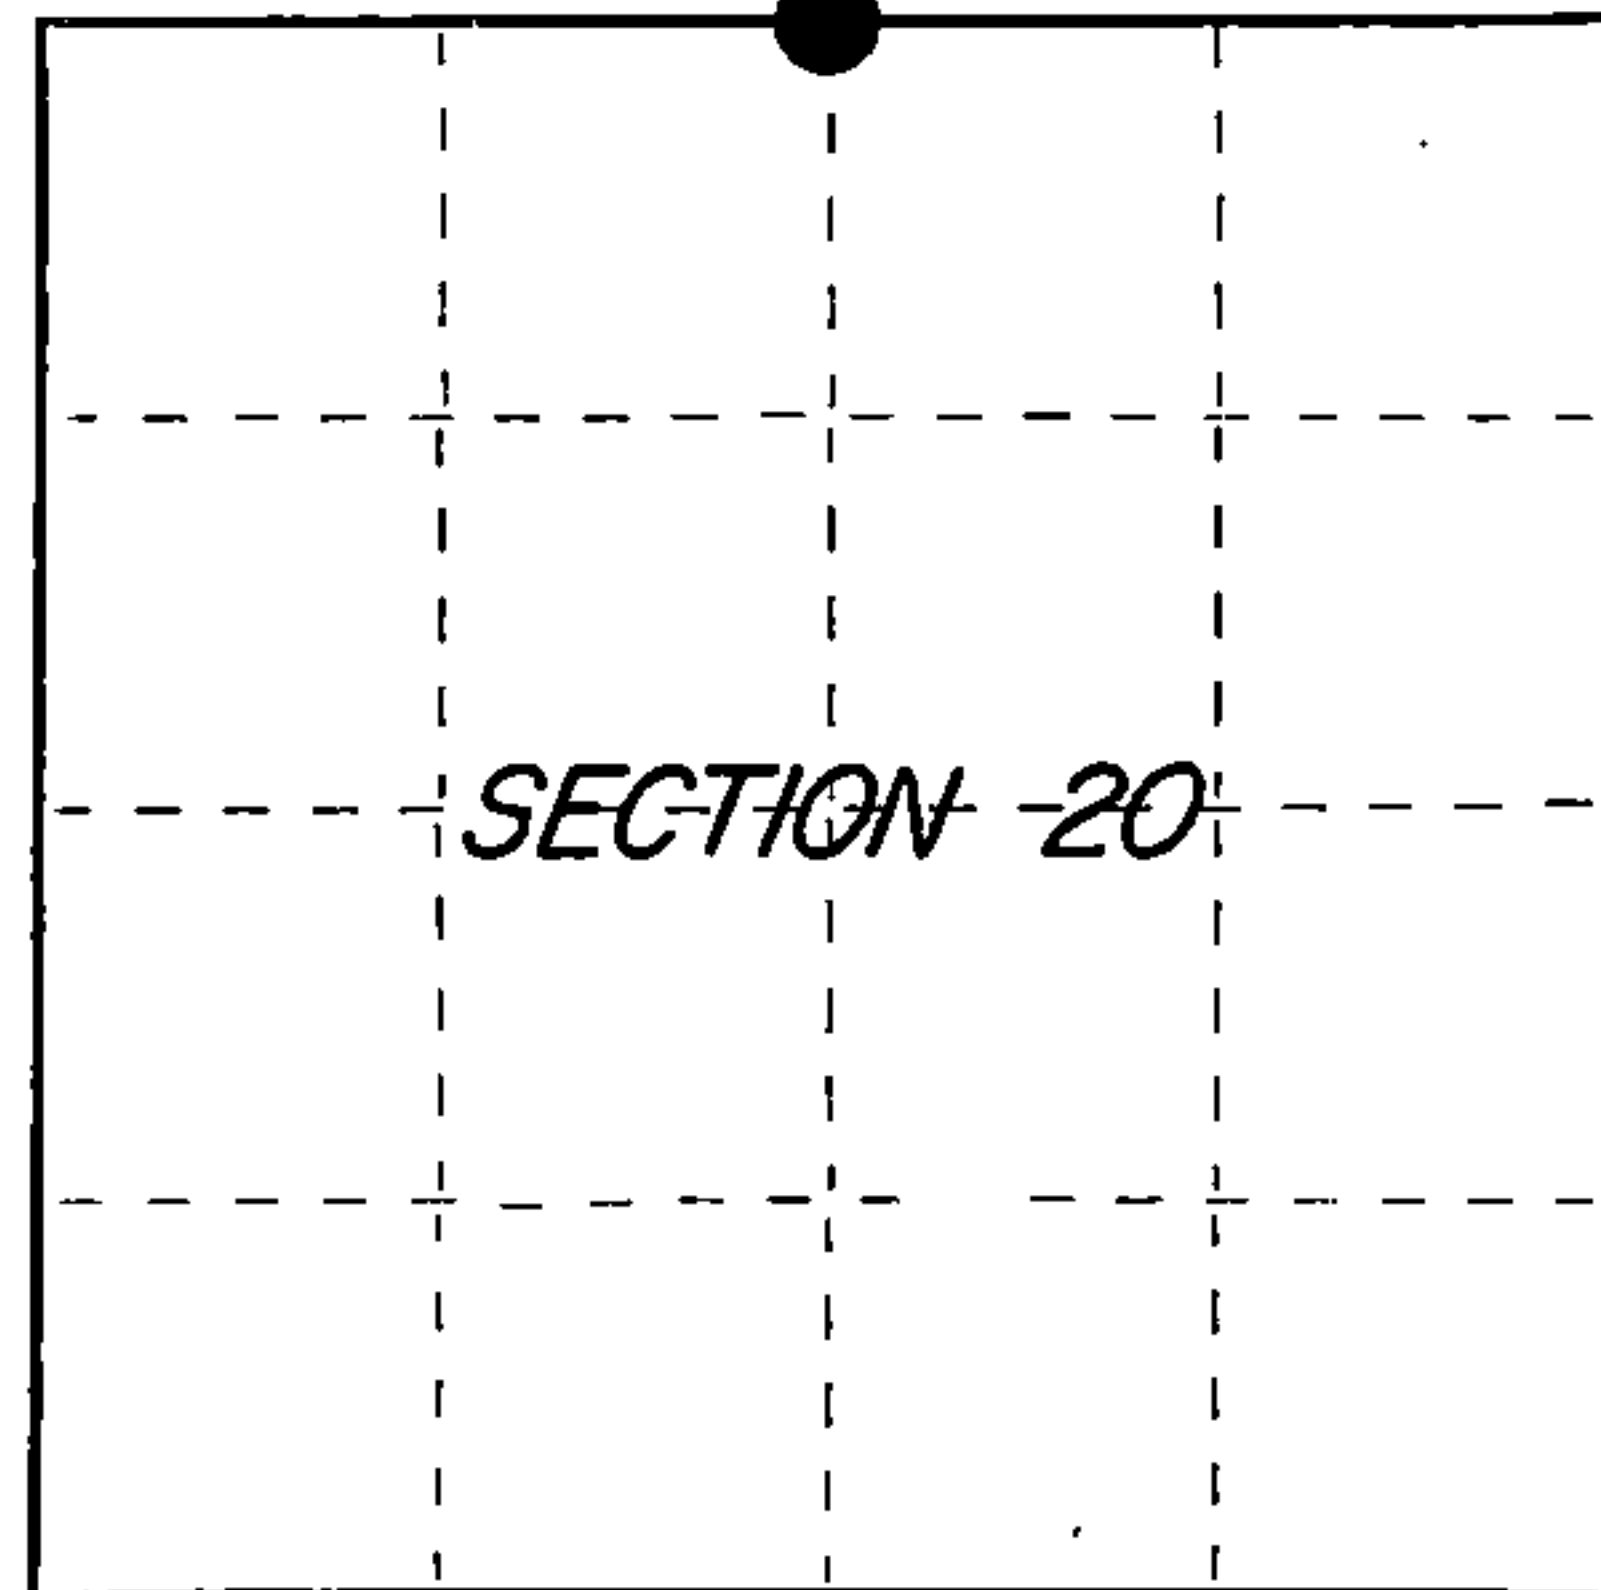

○ = Corner monument restored.

History of original corner establishment: Original survey in 1859 by William E. Daugherty. Dependent resurvey in 1941 by Hal D. Craig and Oscar B. Walsh. At 39.15-1/2 chains set an iron post 3 feet long, 2 inches diameter, 27 inches in the ground with brass cap marked:

1/4	S17	From which the following bear:		
	S20			
1941	Hemlock	9"	N35°W	39 lks.
	Hemlock	7"	S2-1/2°E	42 lks.

Description of corner evidence found:

G.L.O. Monument as described and in place.

Description of monument and accessories I established to perpetuate the original location of this corner.

Corner in good condition. Blazed, scribed, painted and posted the following new bearing trees:

Birch	5"	West	51.00 feet
Maple	6"	N42°E	15.04 feet
Maple	4"	S67°E	18.86 feet
White Oak	8"	S5°W	32.33 feet
Steel Sign Post		West	1.00 foot

Dated at Portage Wis., this 30 day of October, 1986

Signature James R. Grothman Title RLS Registration No. 1321
(County Surveyor, Registered Land Surveyor, or other duly authorized official)

Office of Register of Deeds, County of Forest, I hereby certify that the within instrument was filed in this office for record on the 24th day of February, 1987 at 2:00 clock P. M.

Paul Aschenbrenner
(Register of Deeds)

By _____ Deputy

FORM NO. 985-A

H.C. Miller Company

Stock No. 26273

DOCUMENT NUMBER
132157

FOREST COUNTY

REGISTER'S OFFICE
Forest County, Wis.

Received for record this 24th day of February A.D., 1987 at 2:00 o'clock P. M. and recorded in Vol. CORNER RESTORATIONS page N-7

Register of Deeds

43912170020


(e) Describe any material discrepancy between the location of the corner as restored or reestablished and the location of that corner as previously restored or reestablished by distance and direction. Show the discrepancy on the plan view drawing under (d), above. Show the distances between the corner as previously restored or reestablished and (1) the corner as restored or reestablished, and (2) to at least 2 of the witness monuments shown on the drawing in (d), above.

See drawing below

(f) Was the corner restored through acceptance of (1) an obliterated evidence location, or, (2) a found perpetuated location?

The corner was restored through acceptance of a found perpetuated location.

(g&h) Was the corner reestablished through lost corner proportionate methods? If so, show the method, including the directions and distances to other public land survey corners used as evidence or used for proportioning in determining the corner location?

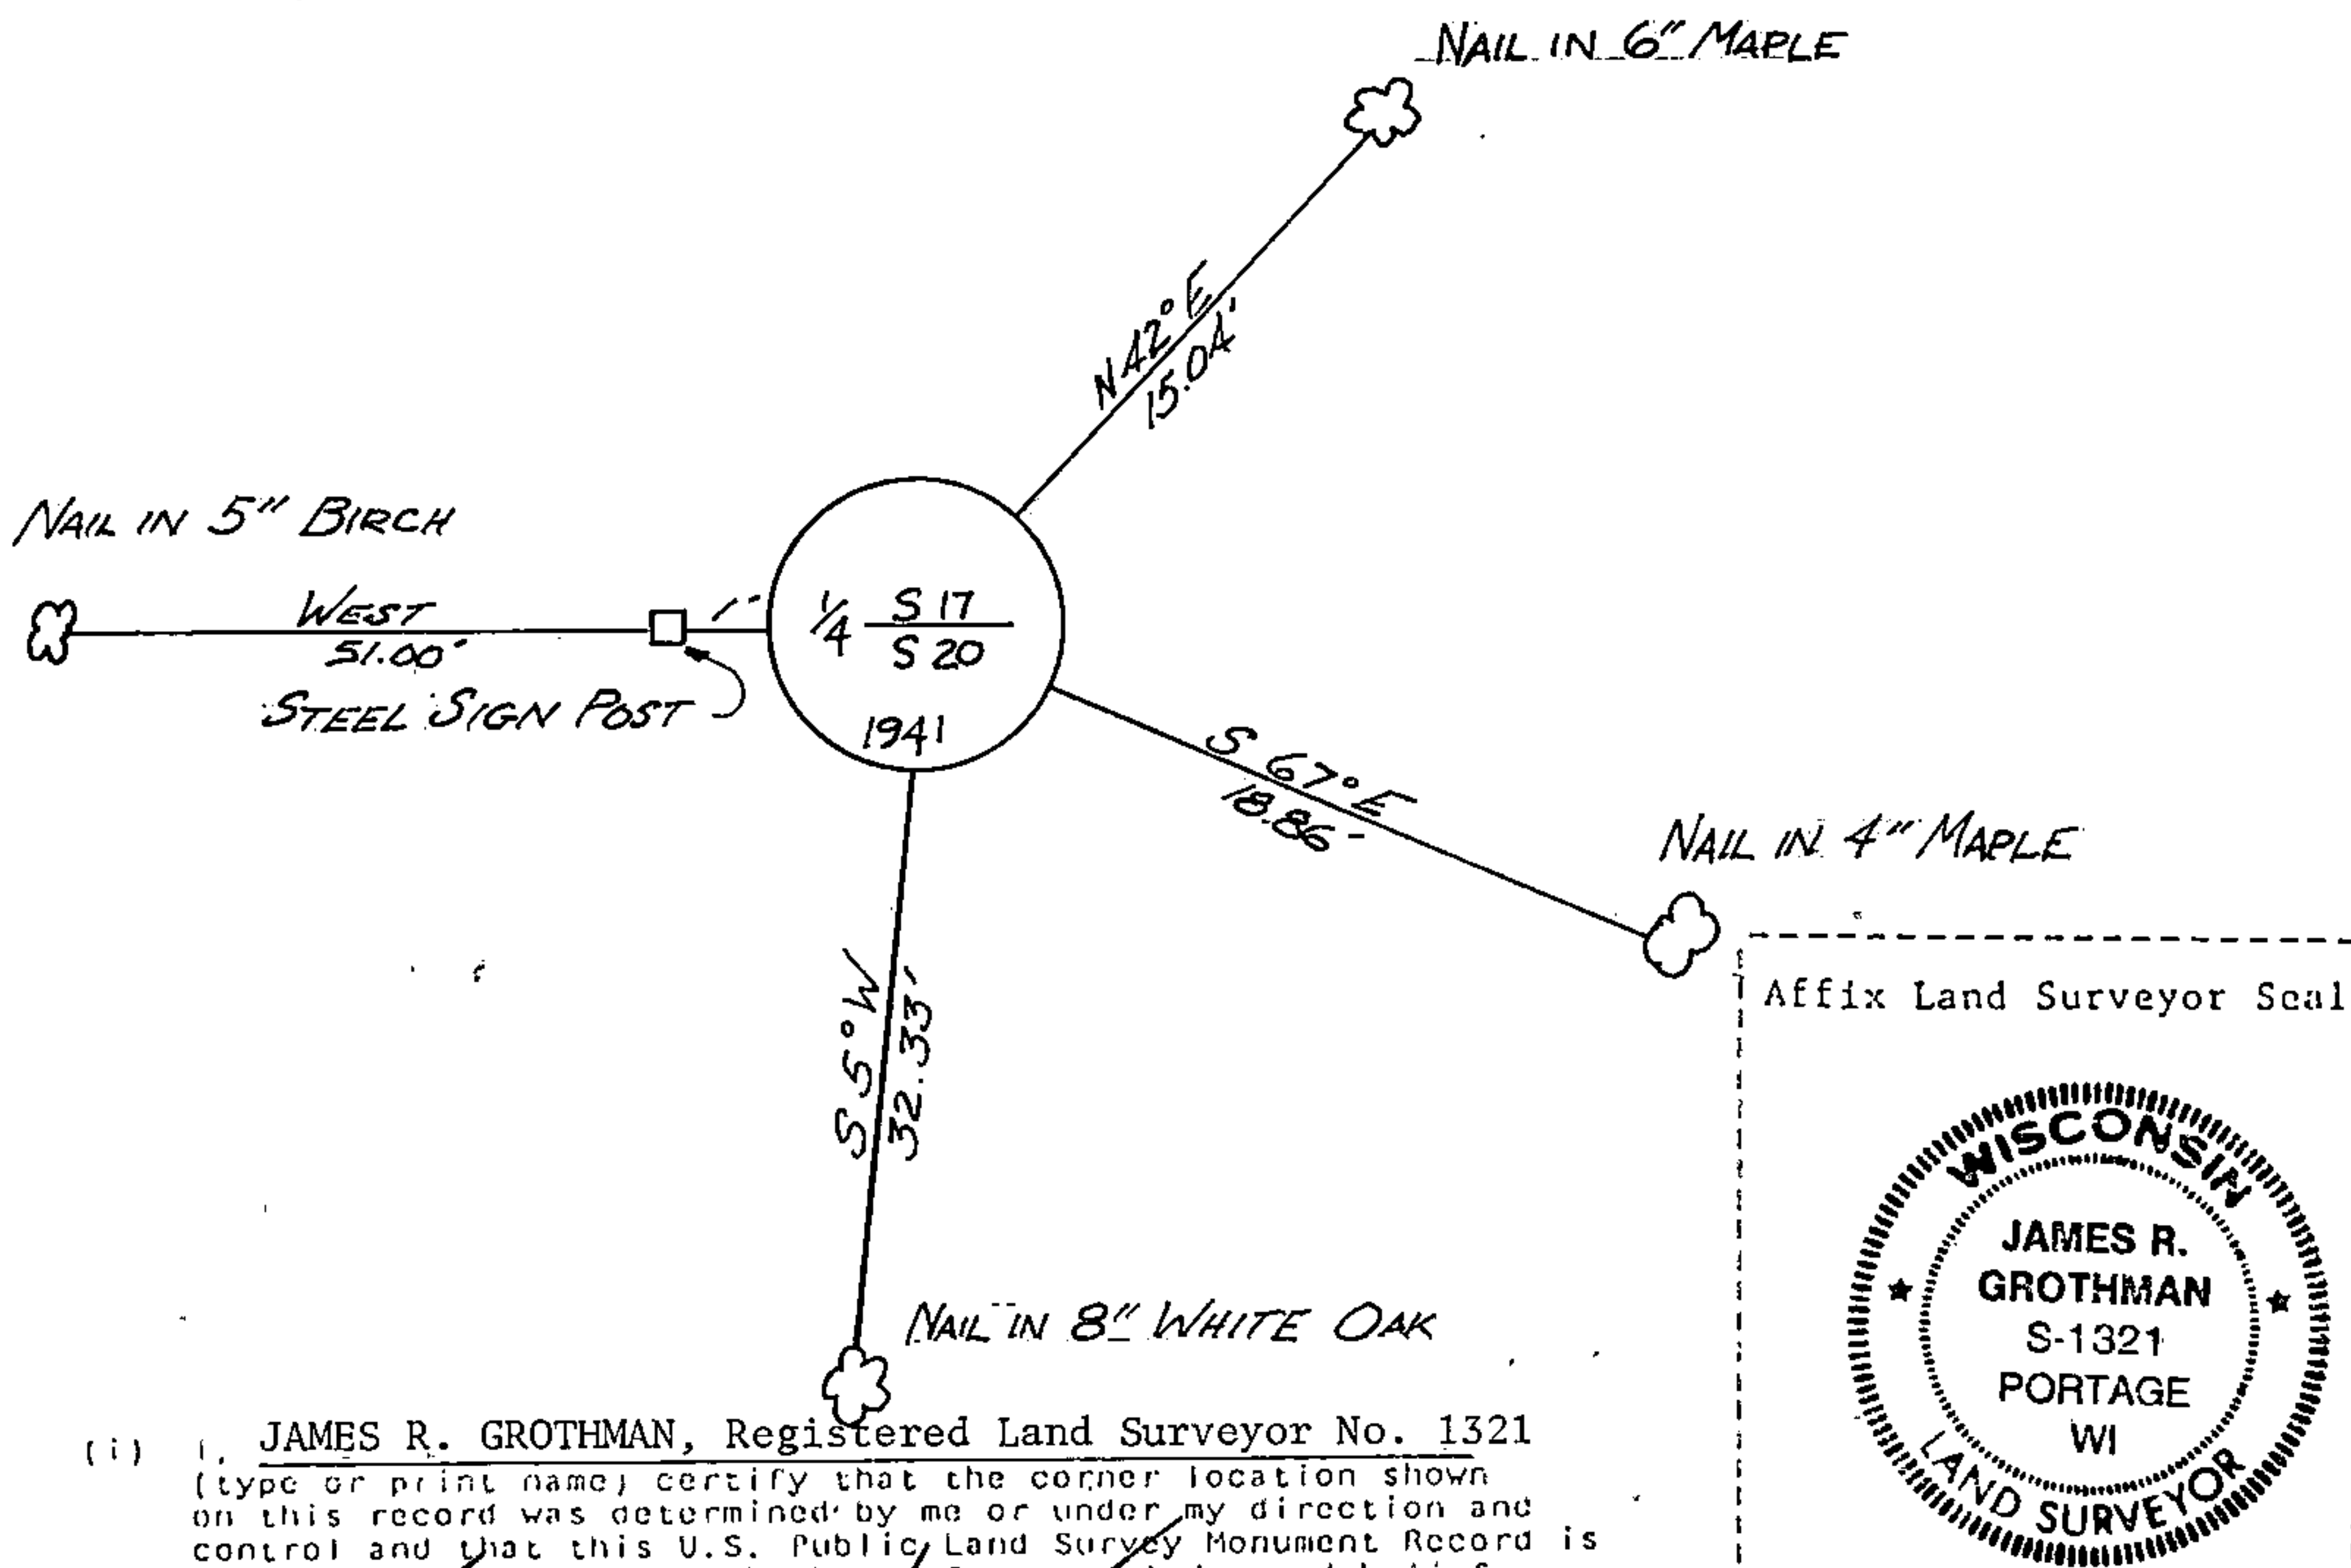

(i) I, JAMES R. GROTHMAN, Registered Land Surveyor No. 1321 (type or print name) certify that the corner location shown on this record was determined by me or under my direction and control and that this U.S. Public Land Survey Monument Record is correct and complete to the best of my knowledge and belief.

Signature

Date

Certificate ready for filing:

District Ranger

Date