

CERTIFIED LAND CORNER RESTORATION

State of Wisconsin }  
County of Forest } ss.

I Jean F. Resvick do hereby certify that on the 20th day of September, 1972, I found evidence of the Northwest corner of Section 33 Township 39 North, Range 12 East, Fourth Principal Meridian, as described hereon; and that from this evidence I established a new ~~corner and~~ accessories as described hereon to perpetuate the original location of this corner:

Description of original monument and accessories and subsequent restorations:



Surveyed in 1859 by William E. Daugherty  
Dependent resurvey in 1941 by Hal D. Craig.  
At proportionate distance set concrete monument, 24 inch. long, 6 inch. diam., 18 inch. in ground, with brass cap marked T39N, R12E, S29, S28, S32, S33, 1941.  
Maple 16, bears N70°30'E, 46 lks.  
Balsam 5, bears S53°30'E, 39 lks.  
Poplar 6, bears S21°W, 11 lks.  
Poplar 10, bears N17°30'W, 42 lks.

Description of corner evidence found:

Concrete monument with brass cap as described above.  
Maple 20", N67E, 46 lks.  
Balsam stump, S57E, 39 lks.  
Poplar stump, scribed, S18W, 11 lks.  
Poplar stump, N18W, 42 lks.  
Bearings do not agree with record, scribing found on all stumps and trees and distances check.

Description of monument and accessories I established to perpetuate the location of this corner:

Blazed and scribed the following new bearing trees.  
White Birch 5" bears S65E, 6.99ft.  
White Birch 7", bears S4W, 12.38ft.  
Maple 8", bears N58W, 28.93ft.

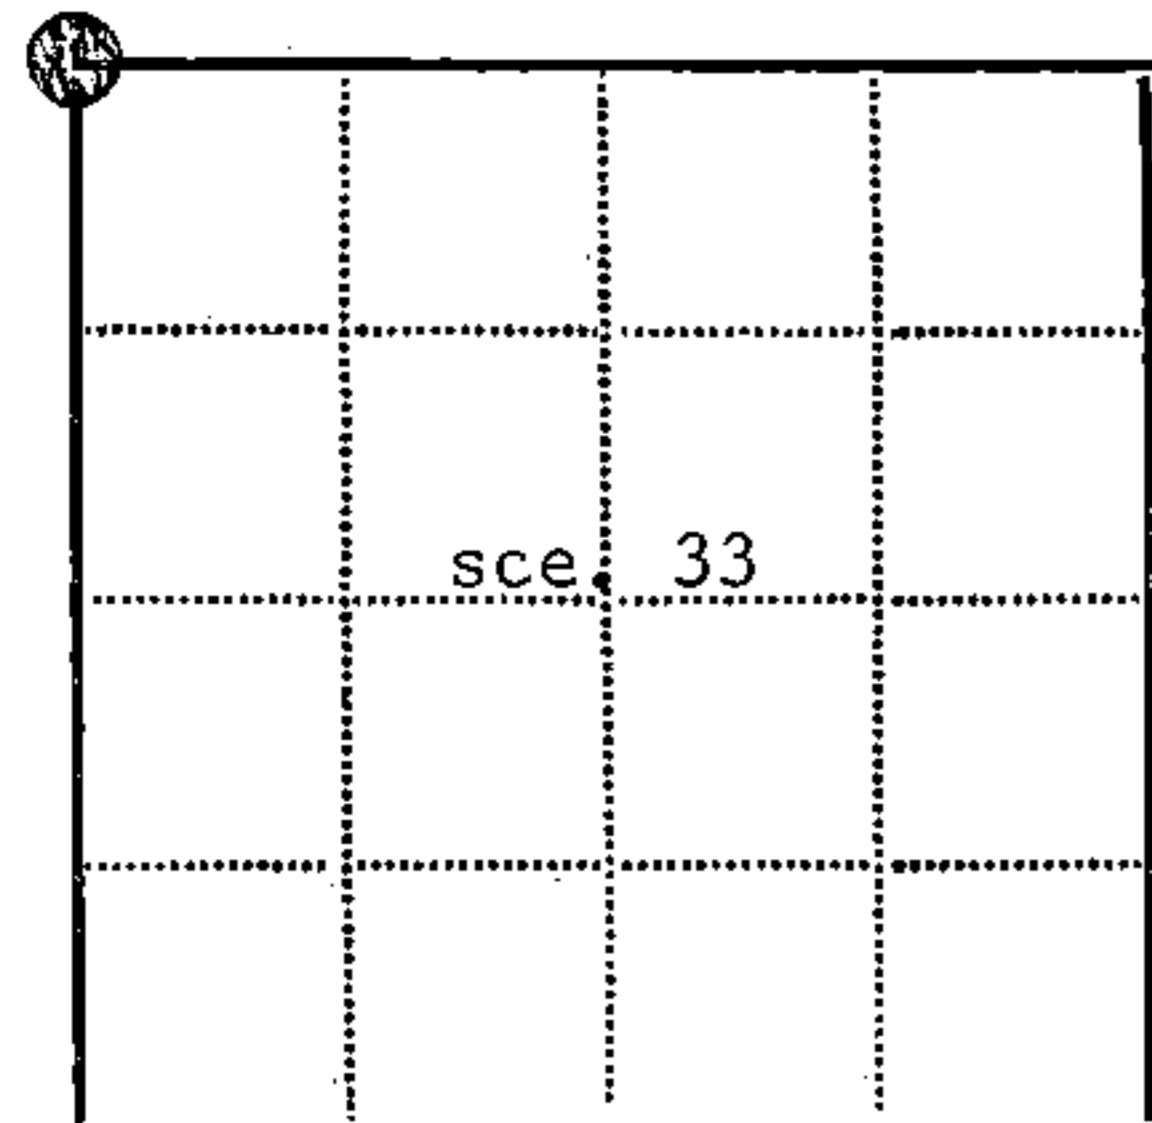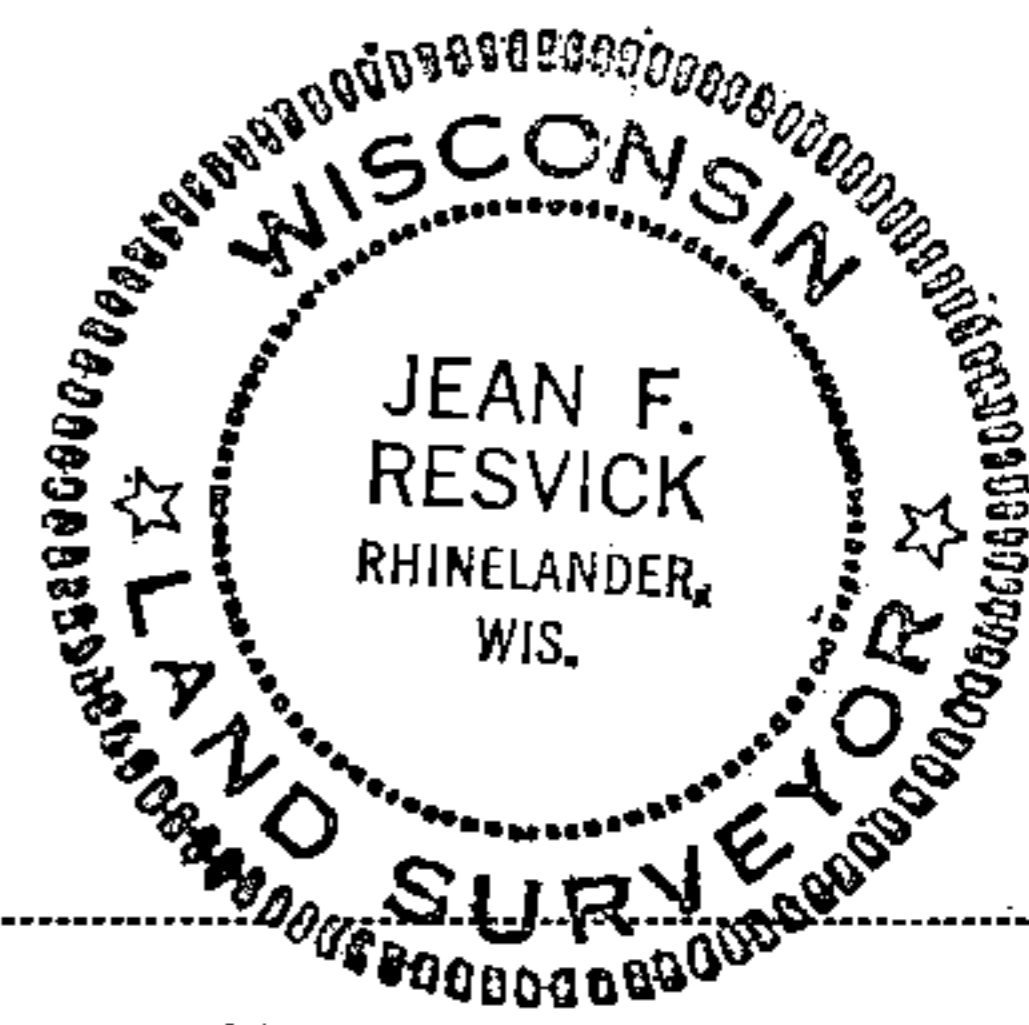

☉ = Corner monument restored  
□ =

Resident witnesses.....

Dated at Rhinelander, Wisconsin, this 14th day of Dec. 1972.

Signature *Jean F. Resvick* Title Land Surveyor  
(County Surveyor, Registered Land Surveyor, or other duly authorized official)

Surveyors Registration No. S-802 DOCUMENT NUMBER 102785

Office of Register of Deeds County of Forest

I hereby certify that the within instrument was filed in this office for record on the 11th day of January 1973, and was filed in Book No. Page No. V-9 of County Records.

Signature *Eugene Staszny* Title Register of Deeds

Township 39 North, Range 12 East, Section 33, Index No. V-9, Page No.

43912 296000