

CERTIFIED LAND CORNER RESTORATION

State of Wisconsin }
County of Forest } ss.

I, Jean F. Resvick, do hereby certify that on the 22nd day of May, 1973, I found evidence of the north quarter corner of Section 2 Township 38 north, Range 12 east, Fourth Principal Meridian, as described hereon; and that from this evidence I established a new monument and accessories as described hereon to perpetuate the original location of this corner:

Description of original monument and accessories and subsequent restorations:

Surveyed in 1858 by Alfred Millard
Dependent resurvey in 1937 by Wesson Cook
From remains of original survey set concrete monument, 6 inch diameter, 24 inches long, with brass cap marked 1/4, S35, S2, 1937
From which the following bear:
Maple stump 14, bears N65E, 35 lks.
Birch stump 28, bears S75W, 30 lks.
Ironwood 6, bears S84°, 30'E, 68 lks.
Hemlock 10, bears N86W, 76 lks.
Graded road S89° 57'E, 1.50 chains.


Description of corner evidence found:

Concrete monument as described above
Hemlock stump, N86W, 76 lks.
Maple stump, N65E, 35 lks.
Road construction and logging probably destroy other bearing trees.

Description of monument and accessories I established to perpetuate the original location of this corner:

Blazed and scribed the following new bearing trees.

Maple 6, S65E, 31.15 feet
Maple 10 S40W, 12.05 feet.
Steel sign post 1.0 foot southwest of monument

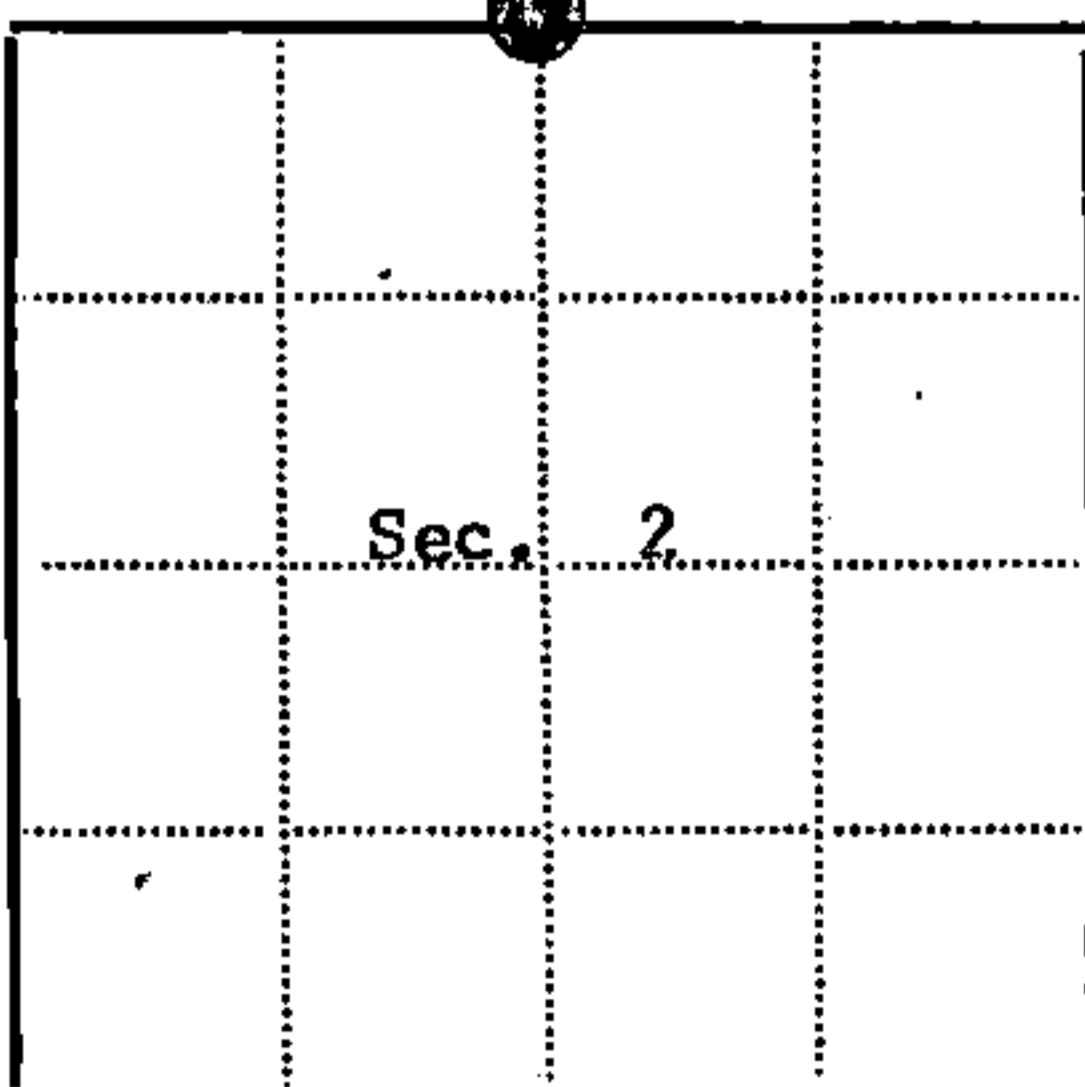

Legend: Circle = Corner monument restored; Square =

Resident witnesses

Dated at Rhinelander Wisconsin, this 30th day of Aug 1973.

Signature of Jean F. Resvick, Title Land Surveyor
(County Surveyor, Registered Land Surveyor, or other duly authorized official)
DOCUMENT NUMBER

Surveyors Registration No. 5-802 104448

Office of Register of Deeds County of Forest

I hereby certify that the within instrument was filed in this office for record on the 13th day of November 1973, and was filed in Book No. of County Records. Page No. A-19 of County Records.

Signature of Eugene Stutzman, Title Register of Deeds

Township 38 north, Range 12 east, Section 2, Index No. A-19, Page No.

4391235 0020

A 19