


CERTIFIED LAND CORNER RESTORATION

State of Wisconsin }
County of Forest } ss.

I, Jean F. Resvick, do hereby certify that on the 24 day of August, 19 67., I found evidence of the West quarter corner of Section 36 Township 39 North, Range 12 East, Fourth Principal Meridian, as described hereon; and that from this evidence I established a new monument and accessories as described hereon to perpetuate the original location of this corner:

Description of original monument and accessories and subsequent restorations:
Surveyed in 1859 by William E. Daugherty. Dependent resurvey in 1941 by Hal D. Craig. Proportionate distance set a concrete monument 24 ins. long, 6 in. dia., 22 ins. in the ground for 1/4 section corner with brass cap marked:

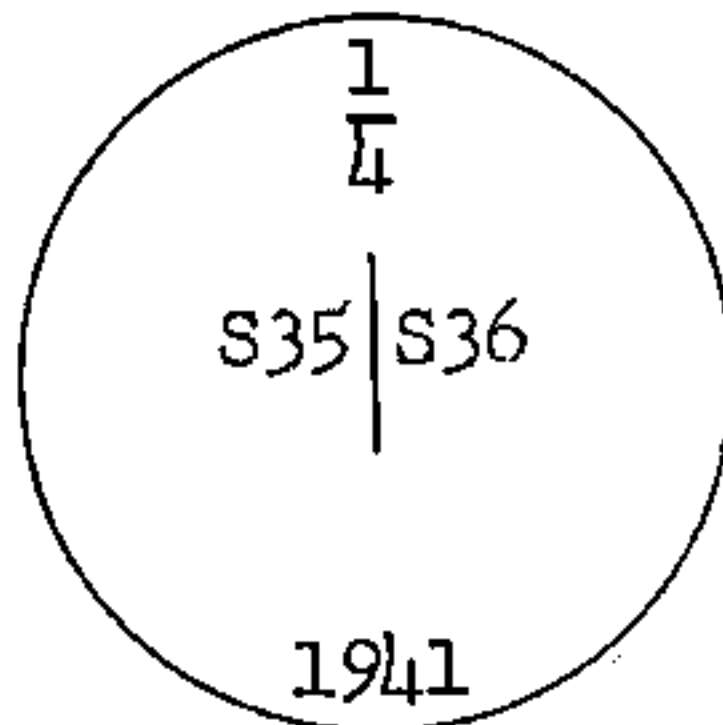


from which:
A poplar, 5 in. dia., bears N15°W, 25 lks.
A poplar, 5 in. dia., bears S80°E, 27 1/2 lks.

Description of corner evidence found:

Monument as described above in place.
A poplar, 10 ins. fallen snag, N25°W, 16.30 ft. bearing recorded as N15°W.
No evidence found of other bearing trees.

Description of monument and accessories I established to perpetuate the original location of this corner:

Blazed and scribed the following new bearing trees:
A maple, 7 in. dia., S57°E, 22.48 ft. or 34.06 lks.
A maple, 5 in. dia., S16°W, 13.62 ft. or 20.63 lks.

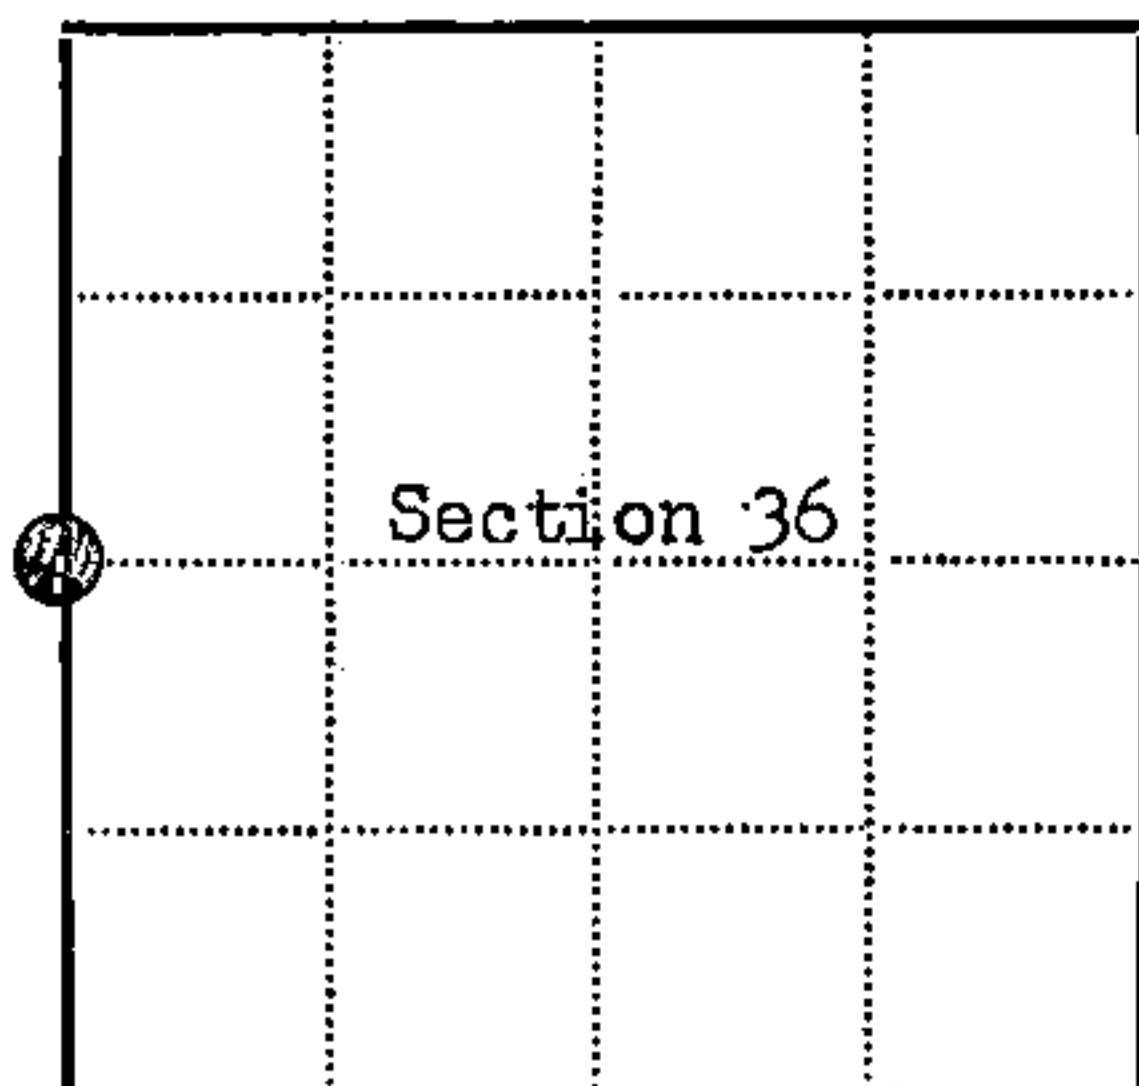

● = Corner monument restored
□ =

Resident witnesses.....

Dated at Rhinelander Wisconsin, this 21st day of Feb. 19 68.

Signature Jean F. Resvick Title Cadastral Surveyor
(County Surveyor, Registered Land Surveyor, or other duly authorized official)

Surveyors Registration No. S-802 DOC. NO. 94232

Office of Register of Deeds County of Forest

I hereby certify that the within instrument was filed in this office for record on the 27th day of February 19 68., and was filed in Book No. I Page No. of County Records.

Signature Eugene Stagny Title Register of Deeds

Township 39 North, Range 12 East, Section 36, Index No. X-21, Page No.

43912352000

X21