

U.S. PUBLIC LAND SURVEY MONUMENT RECORD

Index No. C-5

State of Wisconsin }
County of Forest } ss.

I, William B. Cochran, do hereby certify that on the 23rd day of December, 1988, I found evidence of the East Quarter corner of Section 6 Township 39, North, Range R13E, Fourth Principal Meridian, as described hereon; and that from this evidence I established a new monument and accessories as described hereon to perpetuate the original location of this corner.

Resident witnesses:

Marv Shultz

Lowell Petersen

History of original corner establishment:

Original Government Survey in 1865 by William E. Daugherty. South corrected between Sections 5 and 6, at 38.73 chains, set Quarter Section Post to Sections 5 and 6, from which the following bear;

Birch	6"	S1¼°E	269 lks.
Birch	8"	S14°W	232 lks.

Description of corner evidence found:

Found a 3"x3"x24" squared cedar post in a mound of rock. From cedar post N40°W, 7.70 feet, found a location tag on a 20" Y. Birch stump.


The adjacent property owner, Marv Shultz, had informed Lowell Petersen of the Eagle River Ranger District that he had bought the property from Morris Roberts and that the wood post was always accepted as the corner position.

I accept the wood post as the best available evidence for restoring the corner position.

Description of monument and accessories I established to perpetuate the original location of this corner.

In place of wood post, set a 2½" diameter aluminum pipe monument, 3 feet long, 2½ feet in the ground, with an aluminum cap stamped; T39N, R13E, 1/4, S5, S6, 1988, S-1107. From which the following new blazed and scribed bearing trees bear;

Maple	8"	N50°E	31.56 feet
Maple	6"	N72°W	5.42 feet
Steel Sign Post		South	0.50 feet

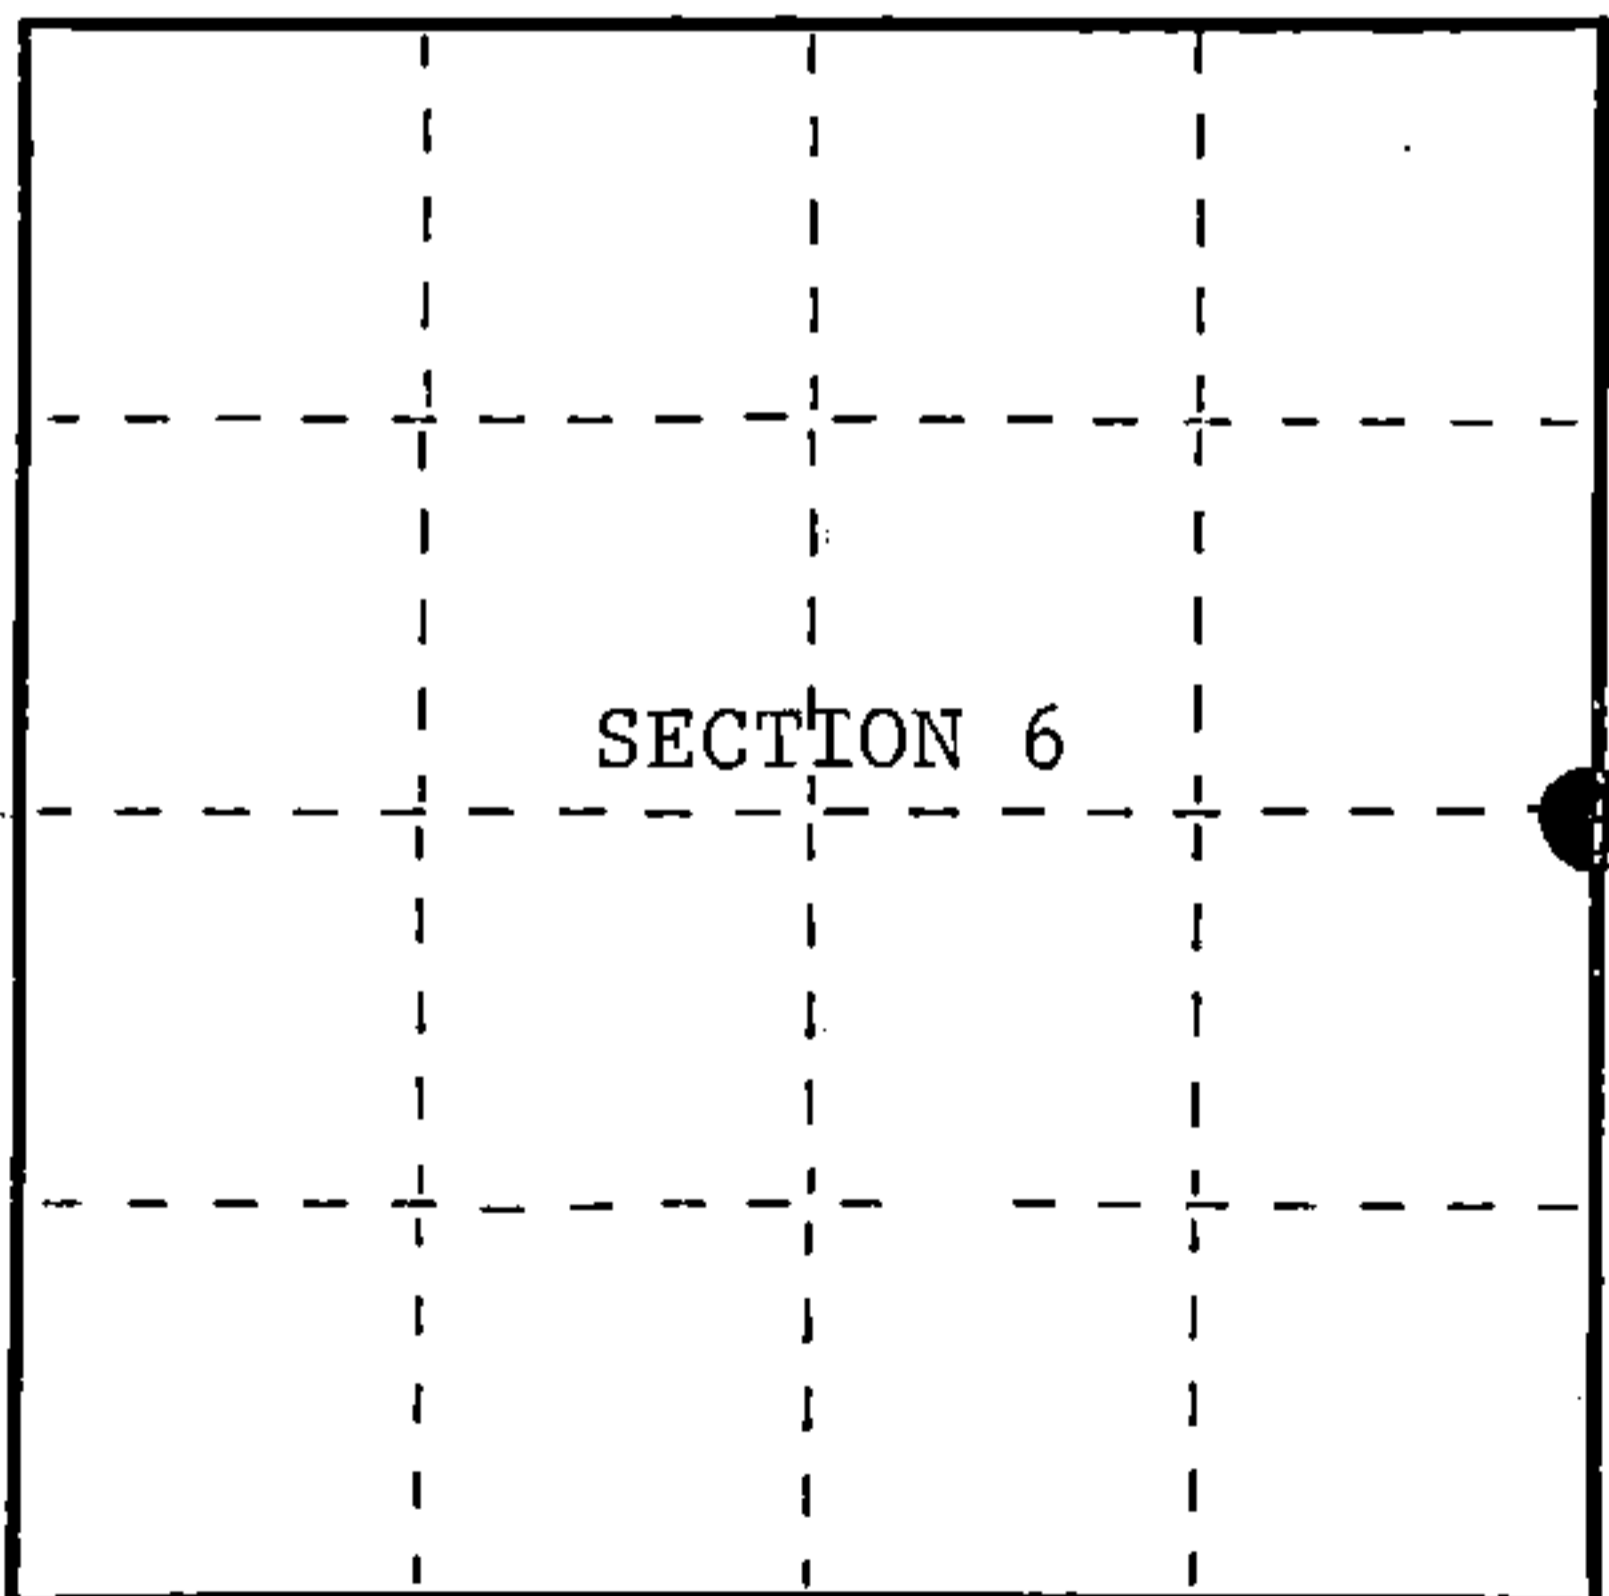

○ = Corner monument restored.

Dated at Hiles, Wis., this 13th day of February, 1989

Signature William B. Cochran, Land Surveyor, Registration No. S-1107
(County Surveyor, Registered Land Surveyor, or other duly authorized official)

Office of Register of Deeds, County of Forest, I hereby certify that the within instrument was filed in this office for record on the 7th day of March, 1989 at 9:55 o'clock A.M.

Paul Aschenbrenner
(Register of Deeds)

By Sandra L. Reddo, Deputy

FORM NO. 985-A

H.C. Miller Company

Stock No. 26273

DOCUMENT NUMBER 137022

43913062000

