

U.S. PUBLIC LAND SURVEY MONUMENT RECORD


Index No. N-19

State of Wisconsin }
 County of Forest } ss.

I, Gary L. Pisoni, do hereby certify that on the 15th day of August, 1990, I found evidence of the South Quarter corner of Section 14 Township 39, North, Range 13 East, Fourth Principal Meridian, as described hereon; and that from this evidence I established a new monument and accessories as described hereon to perpetuate the original location of this corner.

Resident witnesses:

.....

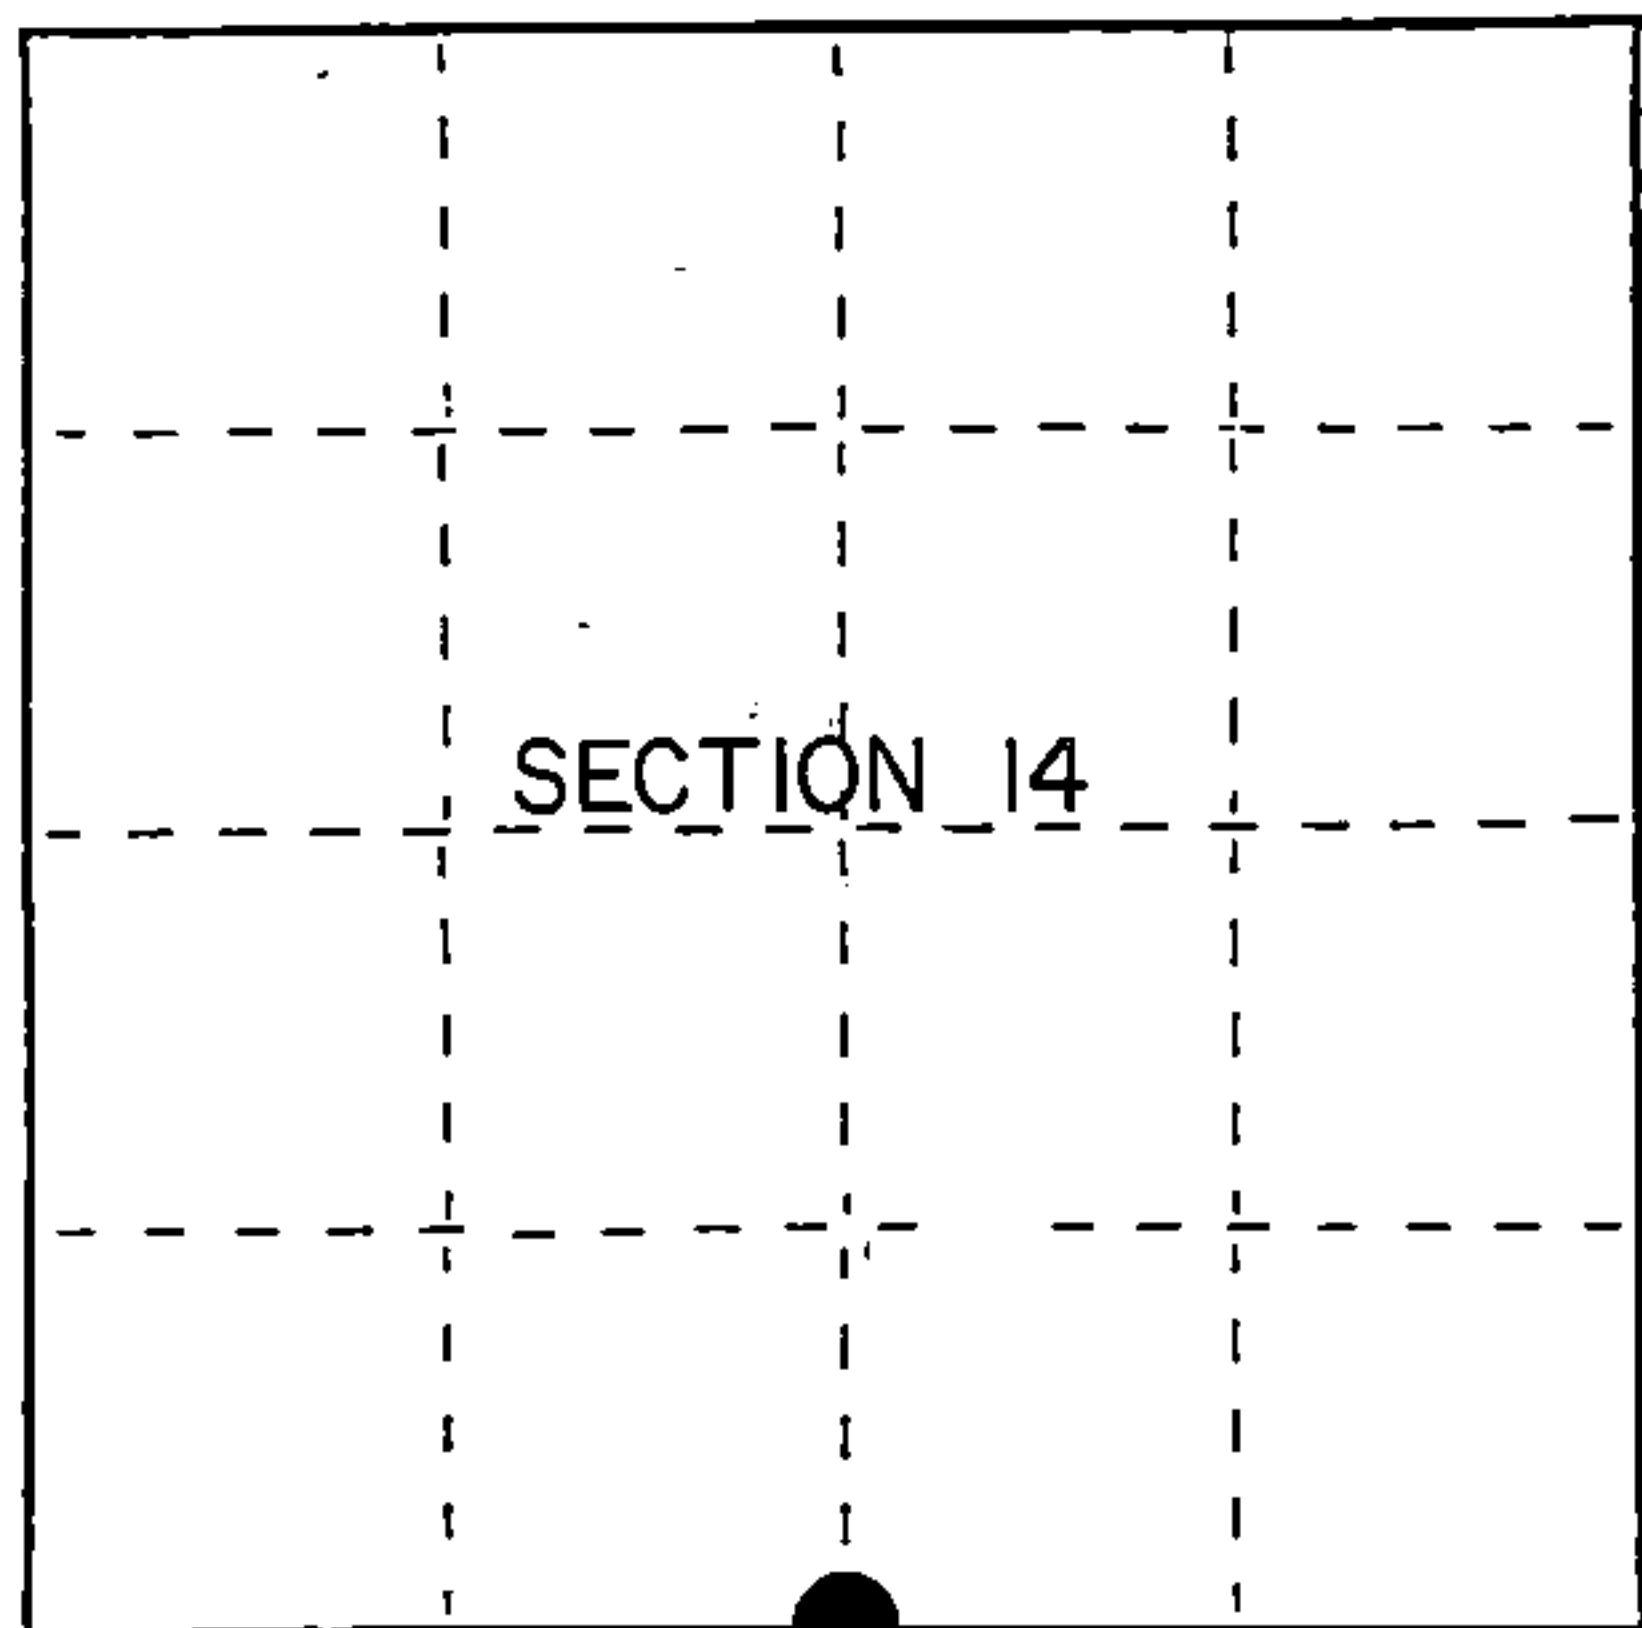

● = Corner monument restored.

History of original corner establishment:

Original Government Survey in 1865 by William E. Daugherty and Alex McDill. West corrected between Sections 14 and 23, at 40.12 chains, set Quarter Section Post to Sections 14 and 23, from which the following bear;

Birch	12"	N02°W	8 lks.
Sugar	8"	S75°W	12 lks.

Description of corner evidence found:

No original corner evidence was recovered.

I restored the corner position at proportionate distance and on line between the Southwest and Southeast Section Corners of Section 14.

Description of monument and accessories I established to perpetuate the original location of this corner.

At the corner position, set a 2½ inch diameter aluminum pipe monument, 3 feet long, 3 inches above the ground surface, with an aluminum cap stamped; T39N, R13E, 1/4; S14, S23, 1990, S-1634. From which the following new blazed and scribed bearing trees bear; (all measurements taken to a nail in side of tree)

S. Maple	7"	N06°W	17.25 feet
S. Maple	8"	S74°E	42.52 feet
Basswood	12"	S19°E	50.91 feet
S. Maple	6"	S70°W	17.42 feet
Steel Sign Post		S25°W	0.54 feet

Dated at Iron River, MI, ~~Wis~~ this 8th day of December, 1990.

Signature Gary L. Pisoni Title Land Surveyor Registration No. S-1634
 (County Surveyor, Registered Land Surveyor, or other duly authorized official)

Office of Register of Deeds, County of Forest, I hereby certify that the within instrument was filed in this office for record on the 10th day of March, 1993 at 10:45 o'clock A M.

Paul Scheepmaker
 (Register of Deeds)

By..... Deputy

FORM NO. 985-A

HCMillerCompany
 Milwaukee, Wisconsin

Stock No. 26273

146920

43913140020

