

State of Wisconsin }
County of Forest } ss.

I, Gary L. Pisoni, do hereby certify that on the 15th day of August, 1990, I found evidence of the West Quarter corner of Section 13 Township 39 North, Range 13 East, Fourth Principal Meridian, as described hereon; and that from this evidence I established a new monument and accessories as described hereon to perpetuate the original location of this corner.

Resident witnesses:

History of original corner establishment:

Original Government Survey in 1865 by William E. Daugherty and Alex McDill. North between Sections 13 and 14, at 40.00 chains, set Quarter Section Post to Sections 13 and 14, from which the following bear;

Sugar	14"	S36°E	26 lks.
Spruce	10"	N20°W	18 lks.

Description of corner evidence found:

No original corner evidence was recovered.


I re-established the corner position at proportionate distance and on line between the West Quarter Corner of Section 24, and the Northwest Section Corner of Section 13.

Corner position falls on the West edge of State Hwy #55.

Description of monument and accessories I established to perpetuate the original location of this corner.

At the corner position, set a Railroad Spike in the blacktop, from which the following new blazed and scribed bearing trees bear; (all measurements taken to a nail in side of tree).

S. Maple	7"	N49°E	64.34 feet
S. Maple	6"	S64°E	62.96 feet
S. Maple	8"	S50°W	37.96 feet
S. Maple	7"	N44°W	40.79 feet
Steel Sign Post		West	23.98 feet
Witness Corner	2"x36"mon.	N85°40'50"E	42.11 feet

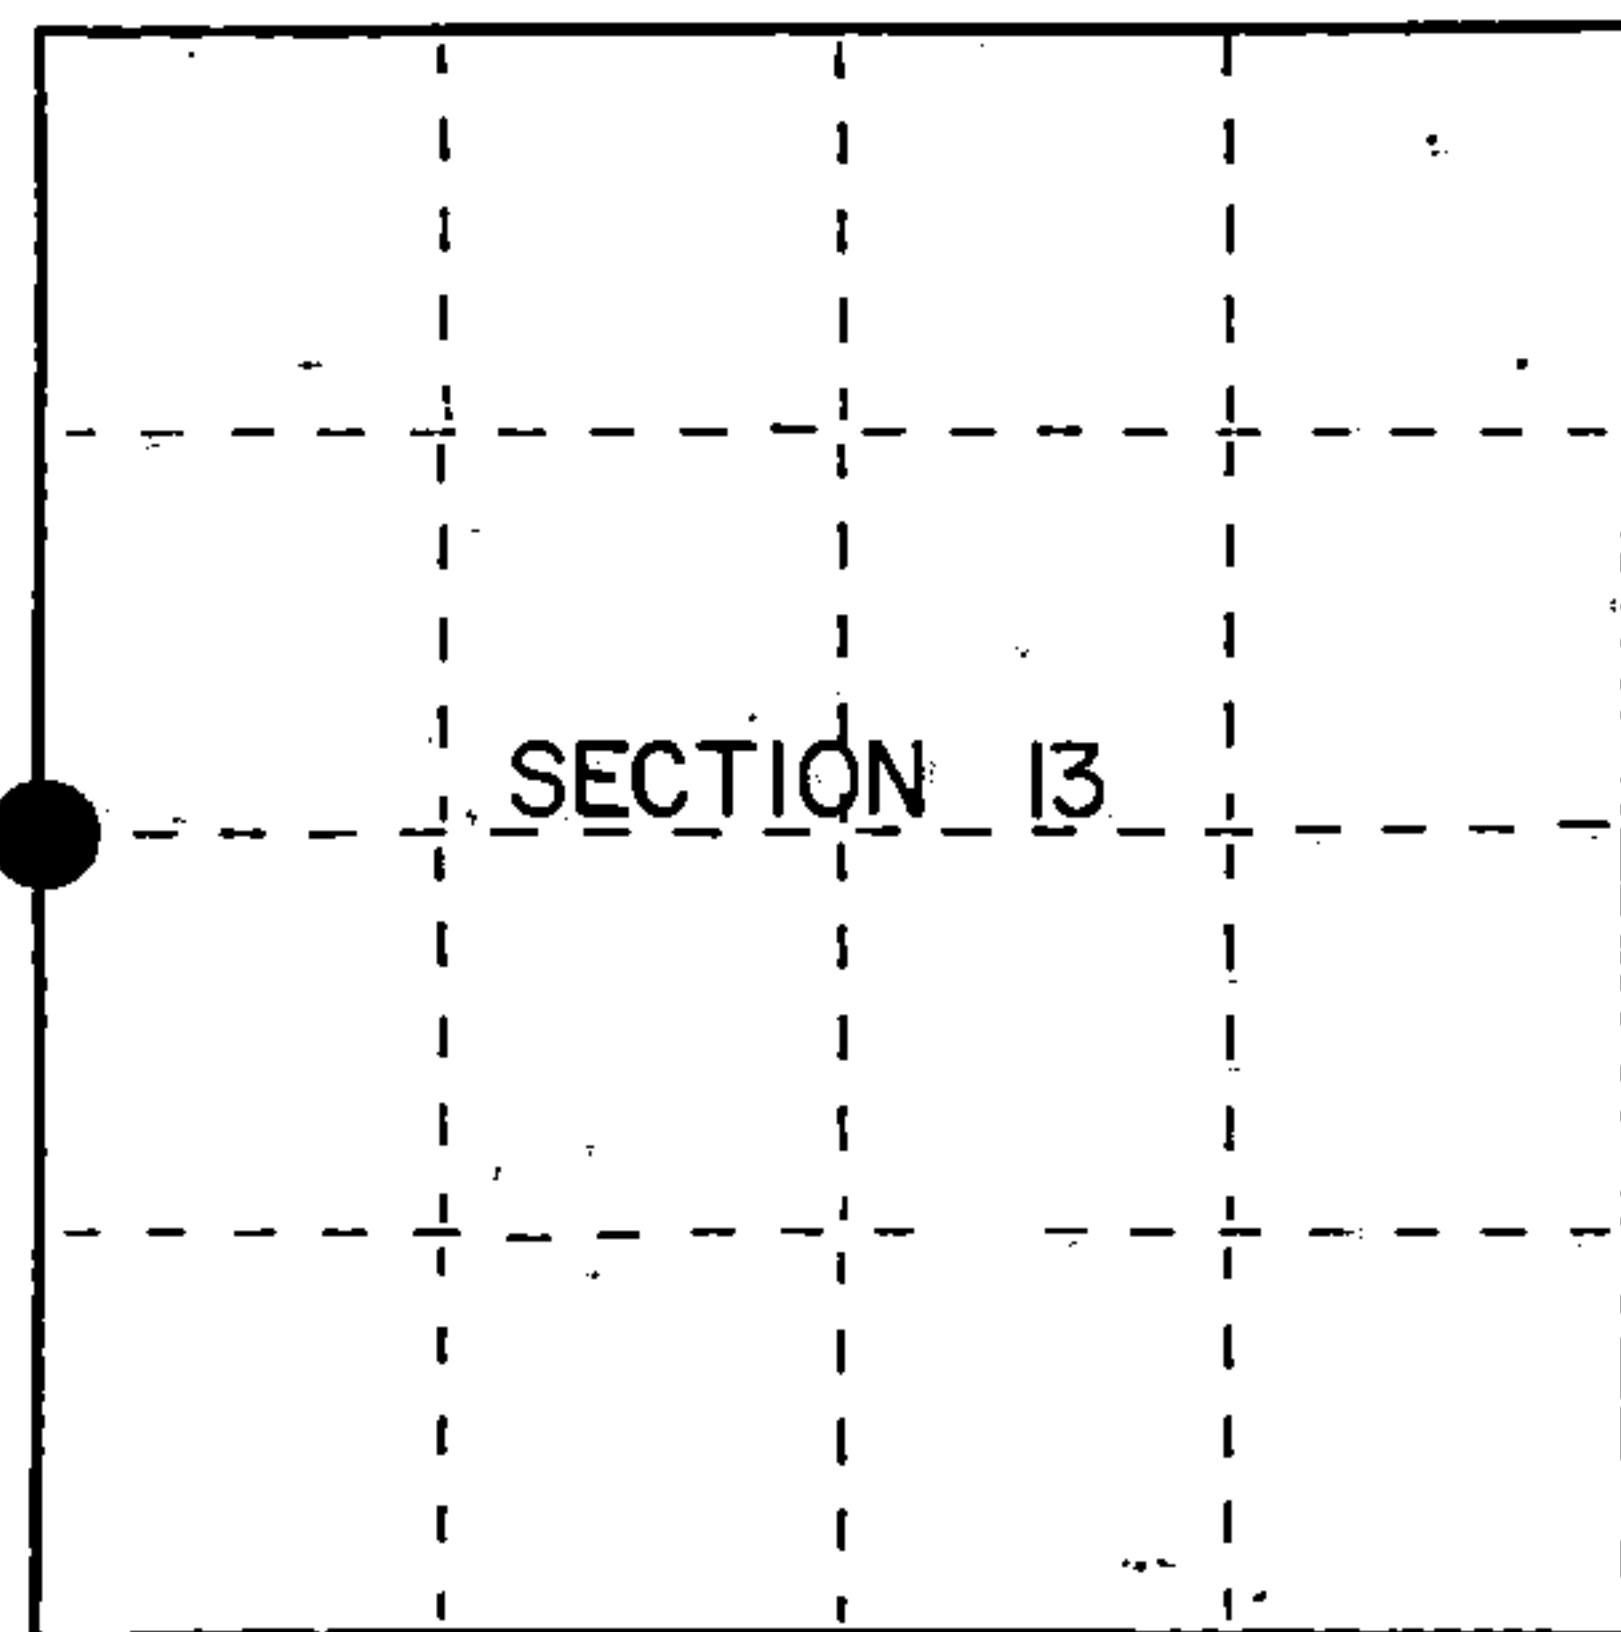

● = Corner monument restored.


Dated at Iron River, MI, Wis., this 8th day of December, 1990.

Signature: Gary L. Pisoni Title: Land Surveyor Registration No. S-1634
(County Surveyor, Registered Land Surveyor, or other duly authorized official)

Office of Register of Deeds, County of Forest, I hereby certify that the within instrument was filed in this office for record on the 12th day of August, 1993 at 1:25 o'clock P. M.

By: [Signature] Deputy (Register of Deeds)

FORM NO. 985-A

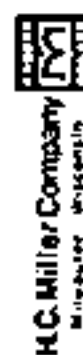

Stock No. 26273
DOCUMENT NUMBER
148135

H 391814200

e) Describe any material discrepancy between the location of the corner as restored or reestablished and the location of that corner as previously restored or reestablished by distance and direction. Show the discrepancy on the plan view drawing under (d), above. Show the distances between the corner as previously restored or reestablished and (1) the corner as restored or reestablished, and (2) to at least 2 of the witness monuments shown on the drawing in (d), above.



See drawing below.

(f) Was the corner restored through acceptance of (1) an obliterated evidence location, or, (2) a found perpetuated location?

Restored through lost corner proportionate methods.

(g&h) Was the corner reestablished through lost corner proportionate methods? If so, show the method, including the directions and distances to other public land survey corners used as evidence or used for proportioning in determining the corner location?

Re-established through lost corner proportionate methods.

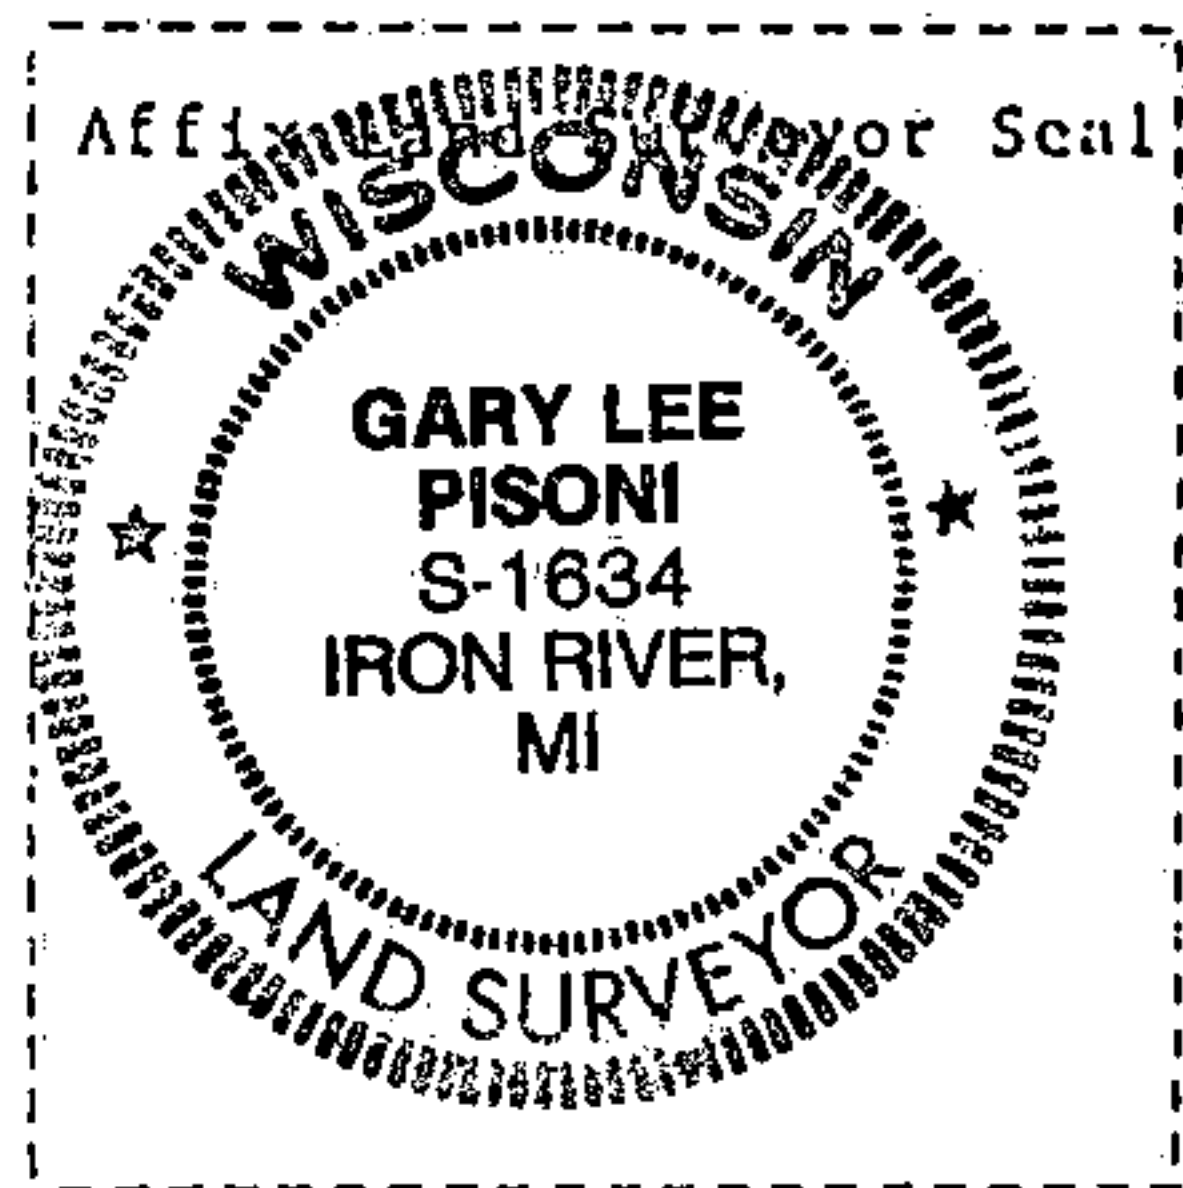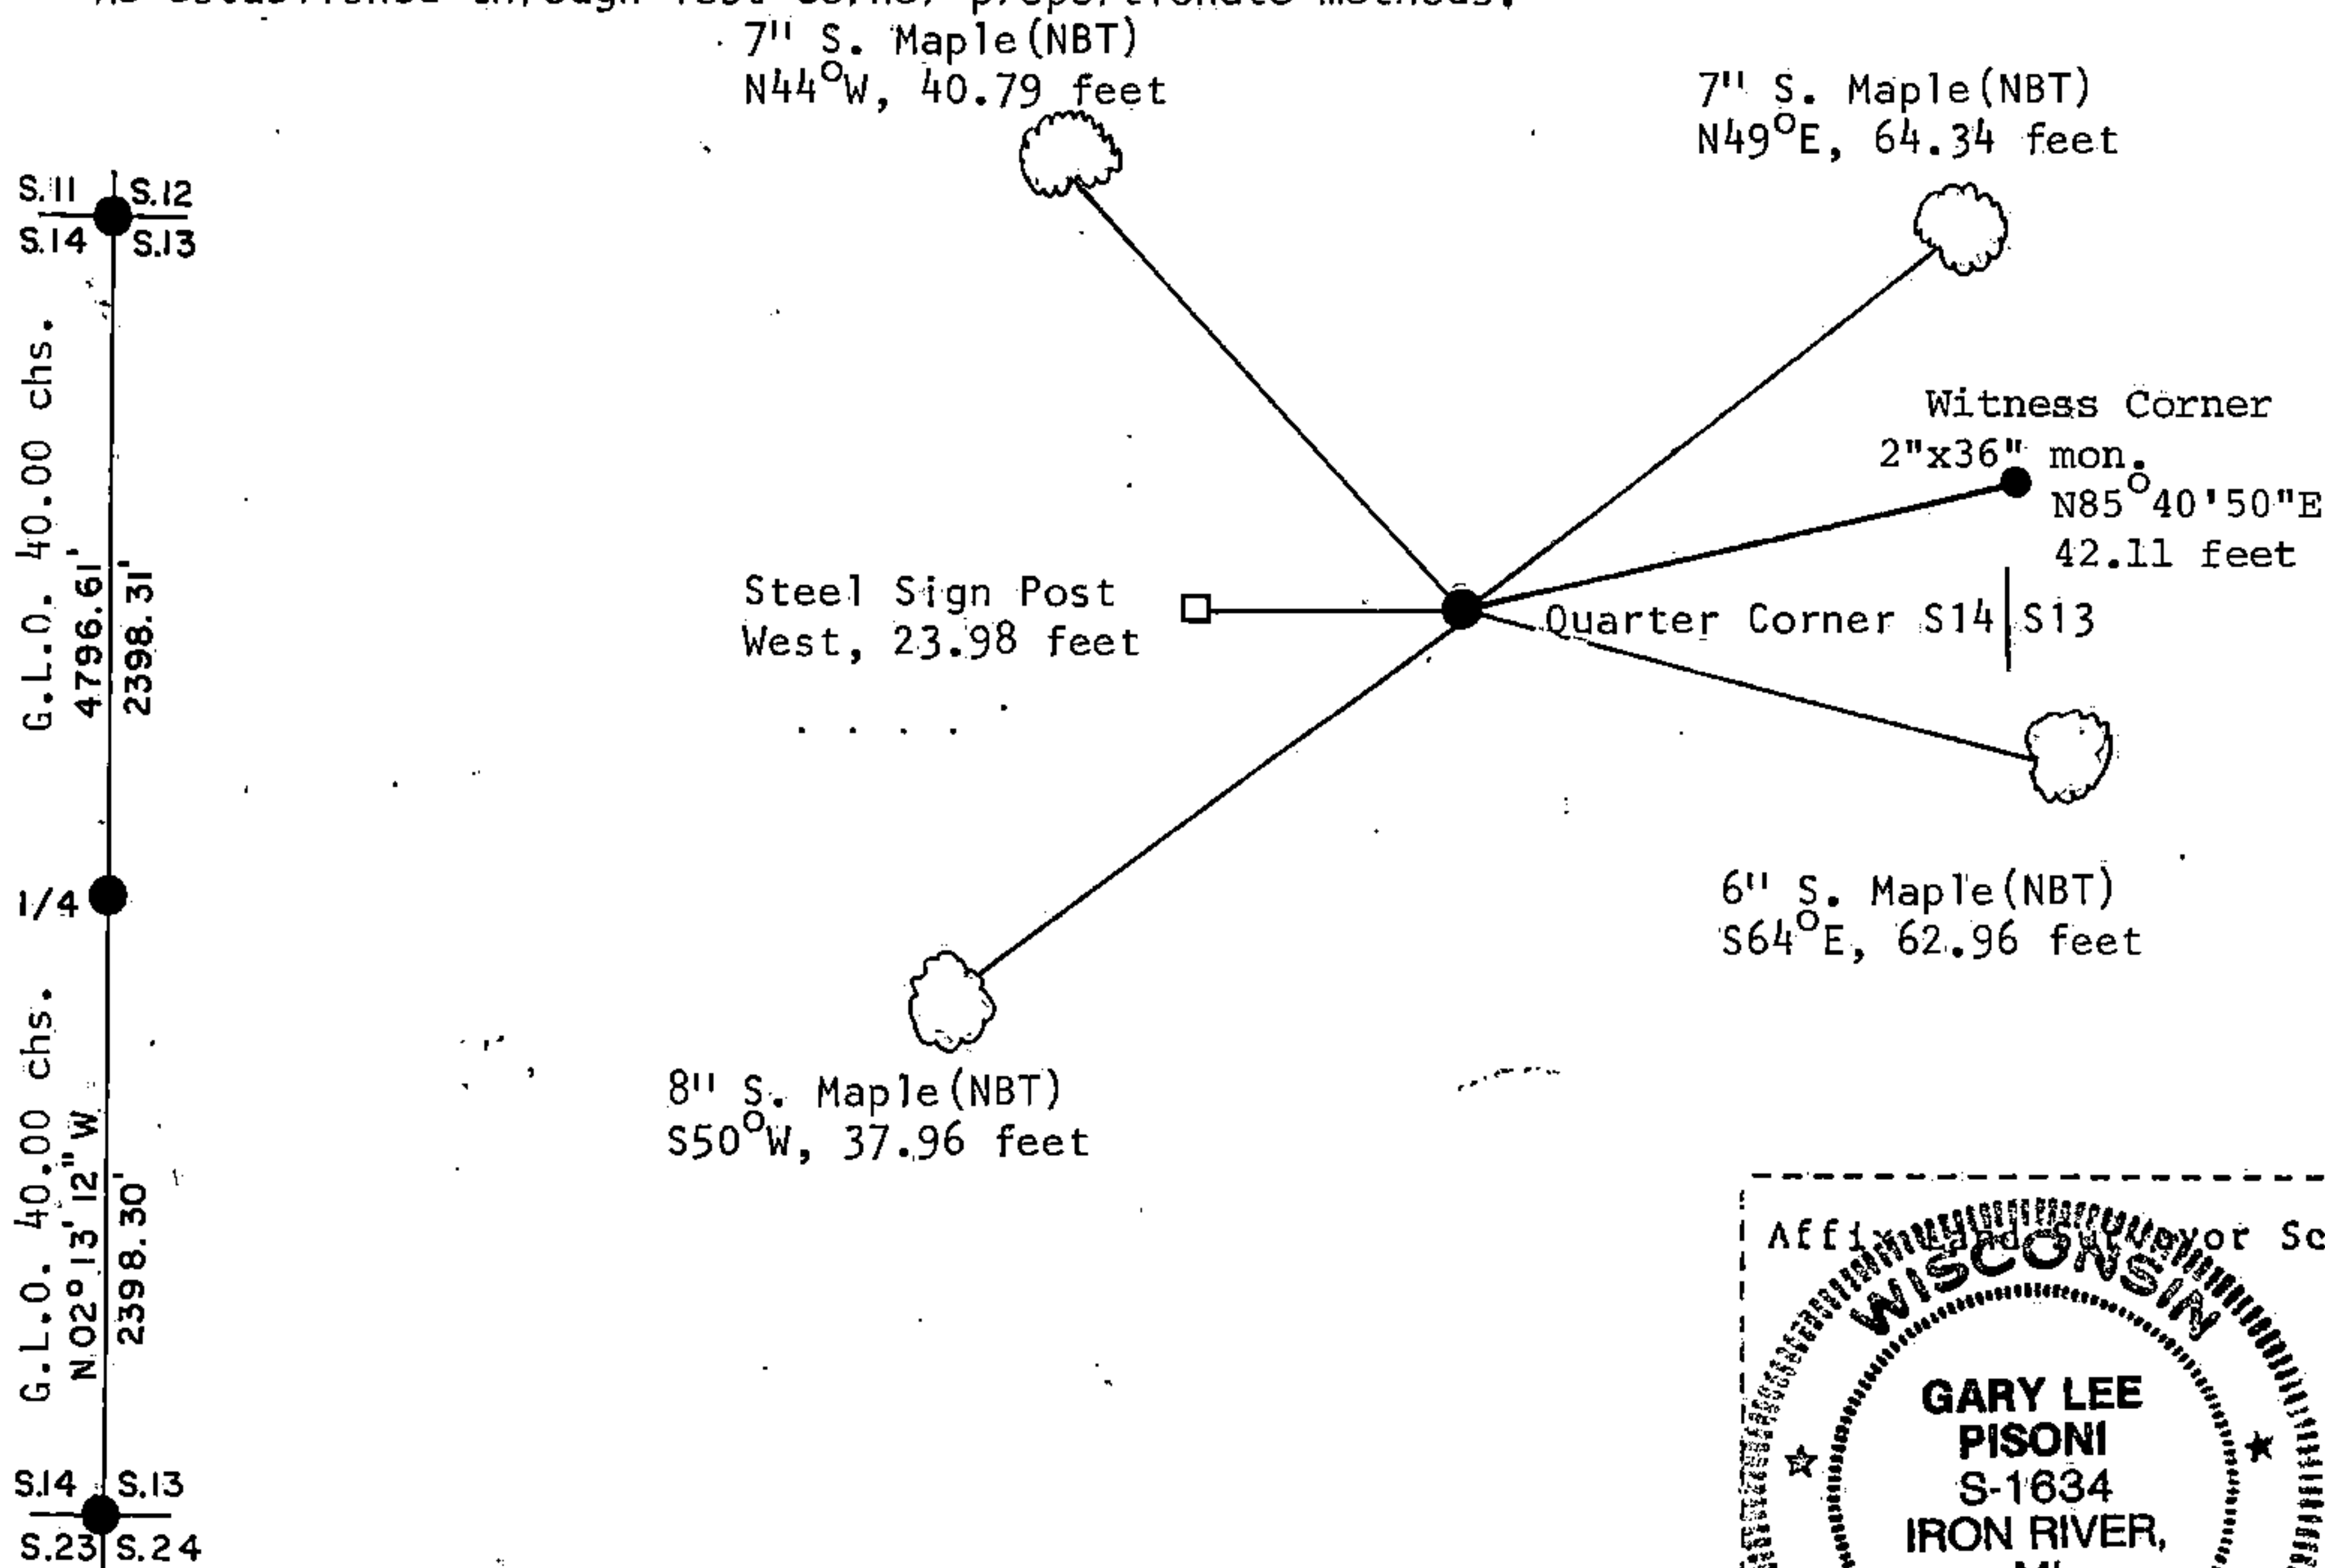

(i) I, Gary L. Pisoni
 (type or print name) certify that the corner location shown on this record was determined by me or under my direction and control and that this U.S. Public Land Survey Monument Record is correct and complete to the best of my knowledge and belief.

Gary L. Pisoni 11/21/91
 Signature Date

Survey requested by: [Signature] 10/2/92
 District Ranger Date