

CERTIFIED LAND CORNER RESTORATION

Index No. R-13

State of Wisconsin }
County of Forest } ss.

I William B. Cochran, do hereby certify that on the 32 th day of May, 1994, I found evidence of the Northeast Section corner of Section 28 Township 39, North, Range 13 East, Fourth Principal Meridian, as described hereon; and that from this evidence I established a new monument and accessories as described hereon to perpetuate the original location of this corner.

Resident witnesses:

.....
.....
.....

History of original corner establishment:


Original Government Survey by William E. Daugherty in 1865.
North between sections 27 and 28, at 80 chains set post from which:
Sugar 14" S40°W 45 lks
Sugar 14" N61°E 39 lks

Description of corner evidence found:

From G. P.S. control and a straight line from 1/4 corner between sections 27 and 28, and N1/16 corner between sections 27 and 28 set corner position. Blazed line running South and a four sided blazed Basswood North 6 ft. Stump hole N61°E 39 lks, Stump hole S40°W 45 Lks.

Description of monument and accessories I established to perpetuate the original location of this corner.

Set a 2½"X36" aluminum pipe monument 2½ feet in the ground with an aluminum cap stamped: T39N, R13E, S21, S22, S27, S28, 1994, s-1107. From which the following bear:
Maple 12" N34°E 26.78 feet
Maple 14" S77°E 20.75 feet
Basswood 11" S42°W 29.40 feet
Maple 13" N80°W 18.36 feet
Steel sign post East 1.00 feet

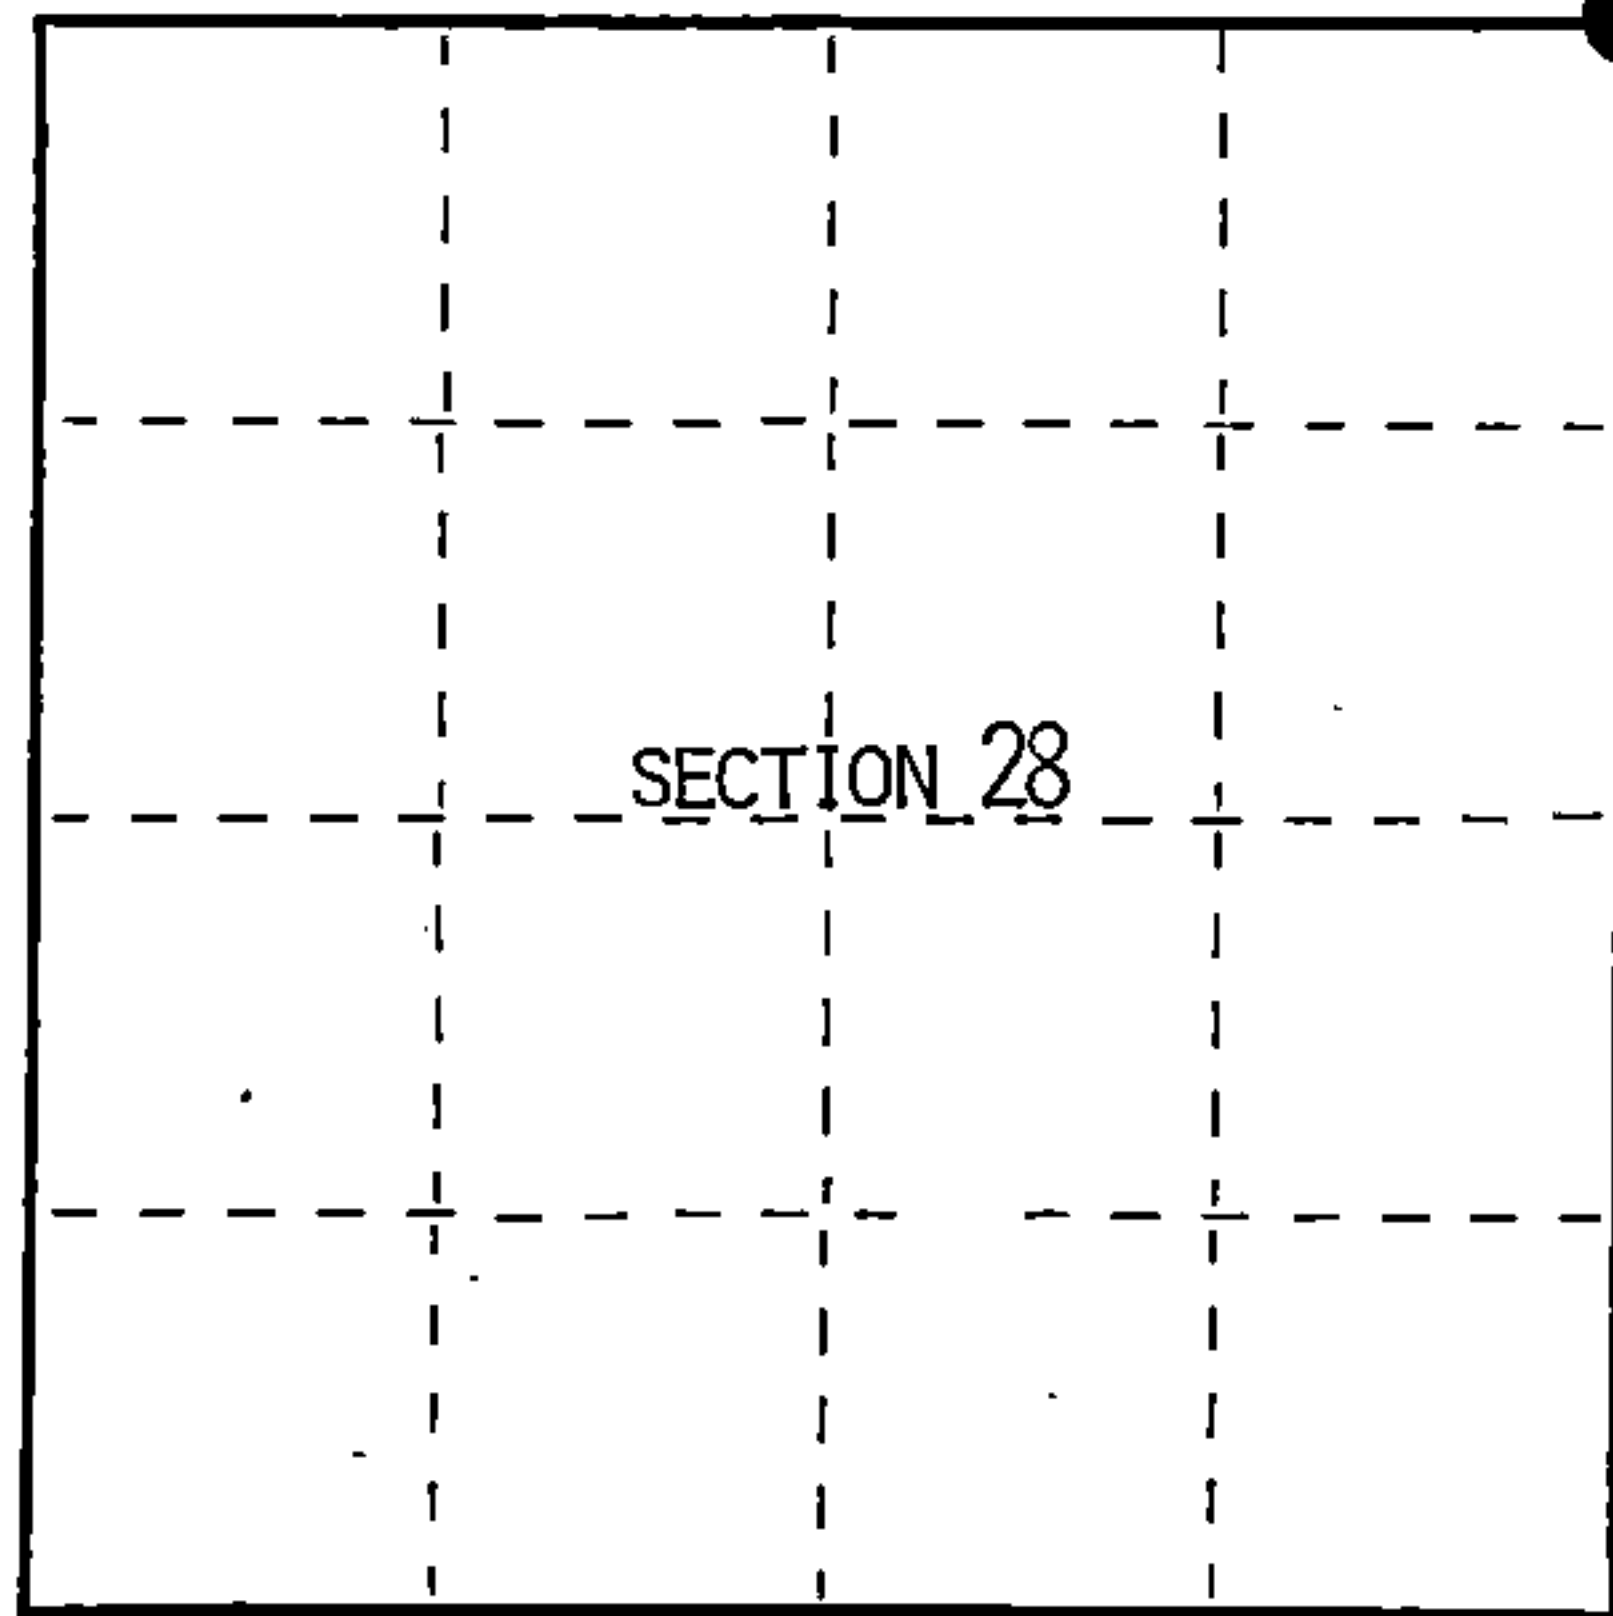

● = Corner monument restored.

Dated at Hiles, Wis., this 13 th day of December, 1994

Signature William B. Cochran Title Land Surveyor Registration No. S-1107
(County Surveyor, Registered Land Surveyor, or other duly authorized official)

Office of Register of Deeds, County of Forest, I hereby certify that the within instrument was filed in this office for record on the 25 day of August, 1994 at 2:30 o'clock P M.

.....
(Register of Deeds)
By Paul Tomkiewicz Deputy

FORM NO. 985-A



Stock No. 26273

156576

43913210000

