


CERTIFIED LAND CORNER RESTORATION

Index No. V-23

State of Wisconsin }
County of Forest } ss.

I William B. Cochran, do hereby
certify that on the 23rd day
of April, 1993, I found
evidence of the North Quarter
corner of Section 36
Township 39 N, North, Range
13 East, Fourth Principal Meridian,
as described hereon; and that from this evidence
I established a new monument and accessories
as described hereon to perpetuate the original
location of this corner.

Resident witnesses:

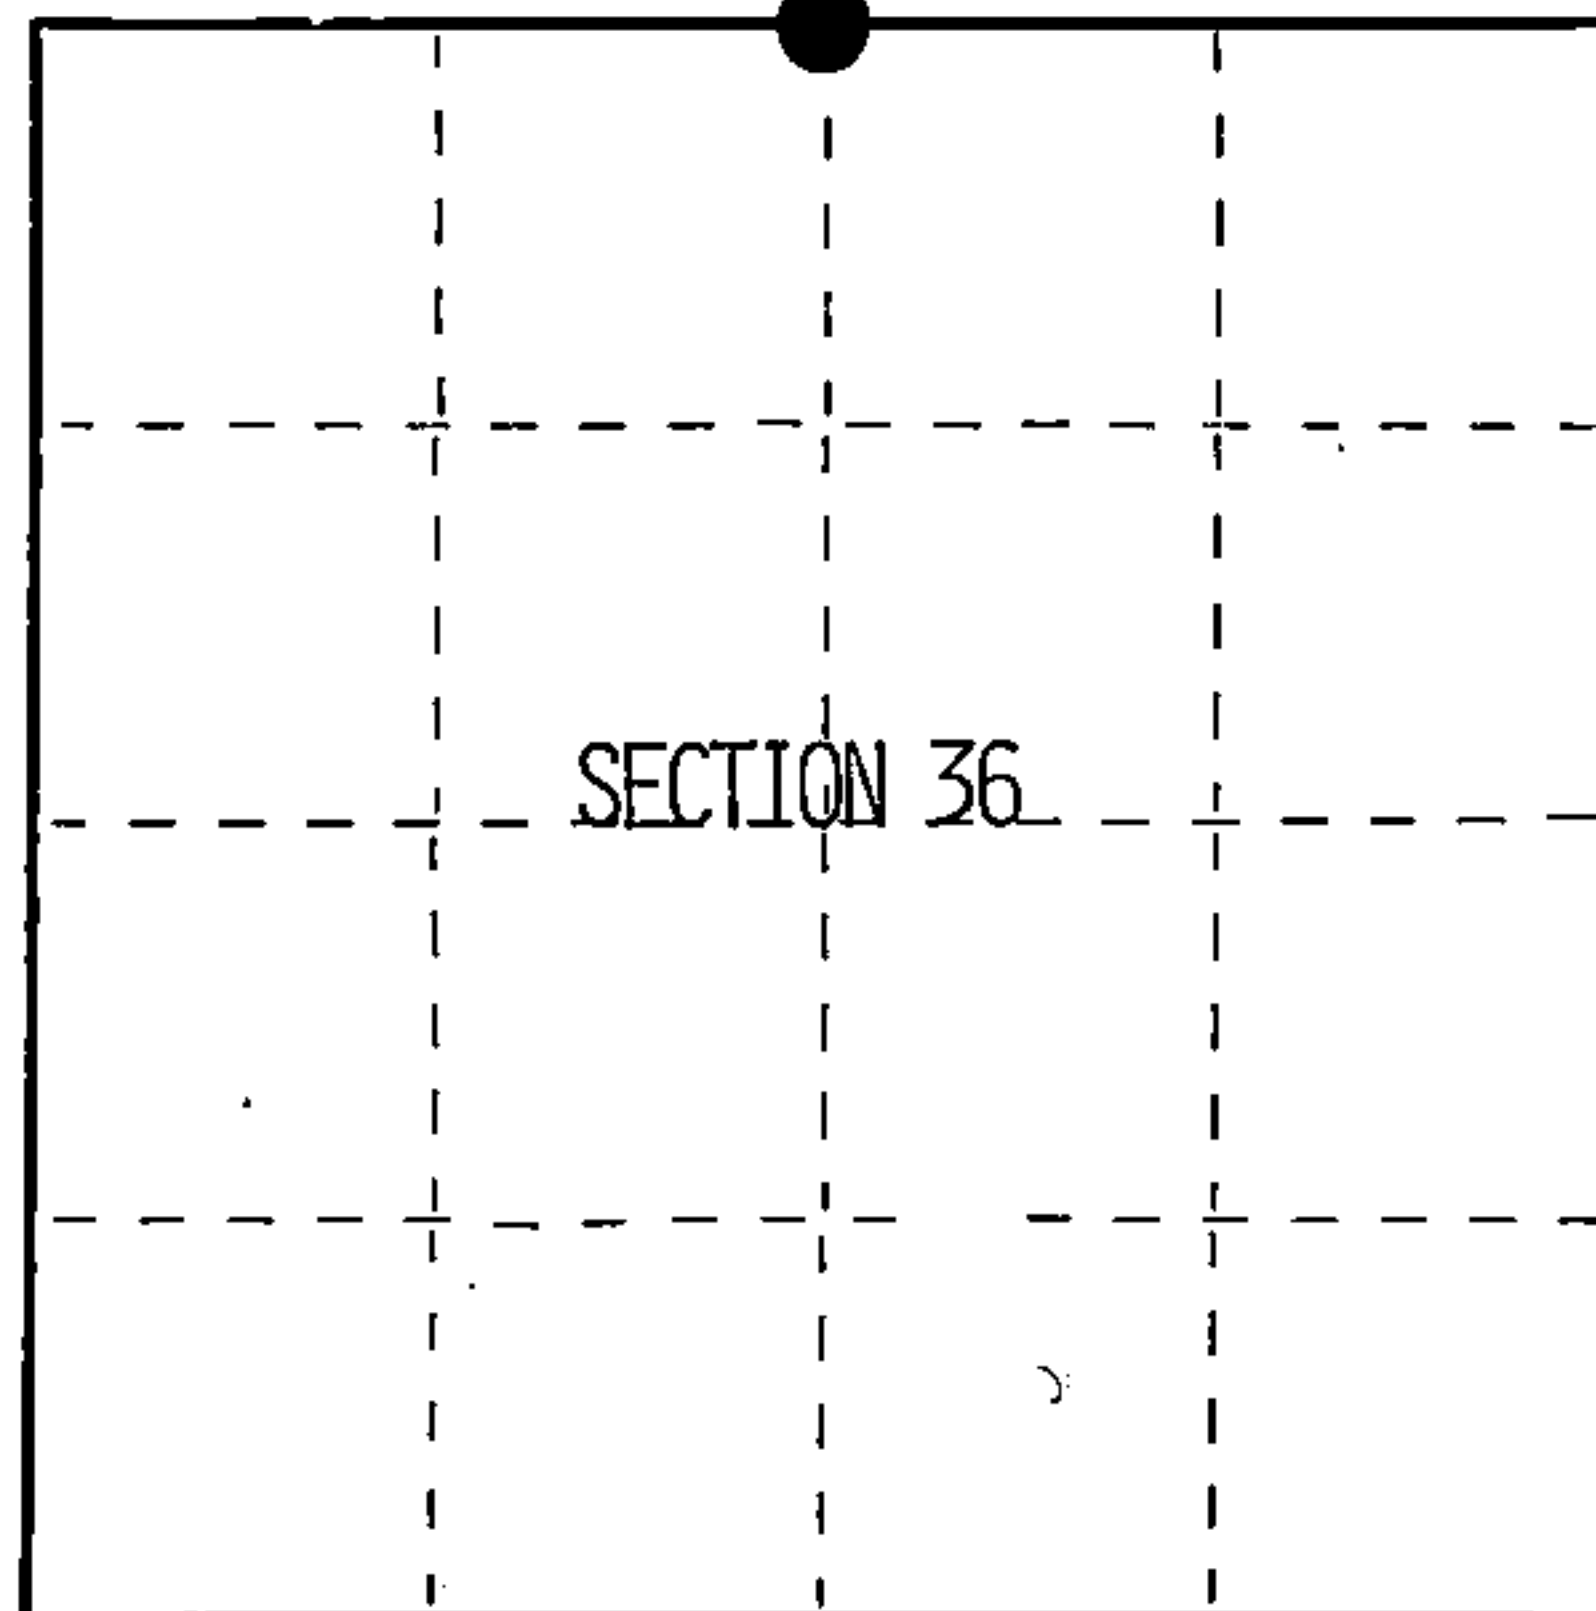

● = Corner monument restored.

History of original corner establishment:

Original Government Survey by William E. Daugherty in 1865.

West corrected between sections 25 and 36 at 40.15 chains set post from which:

Cedar	10"	N07°E	8 lks
Cedar	10"	S26°W	230 lks

Description of corner evidence found:

No corner evidence was found.

Description of monument and accessories I established to perpetuate the original location of this corner.

At the proportionate position between opposing section corners, I set an $2\frac{1}{2}$ " X 36" aluminum pipe monument $2\frac{1}{2}$ feet in the ground with an aluminum cap stamped: T39N, R13E, 1/4, S25, S36, 1993, S-1107. from which the following bear:

Steel sign post North .75 feet
Steel sign post South .75 feet (There are no available bearing trees).
A woods road bears West approximately 50 feet

Dated at Hiles, Wis., this 29 th day of December, 19 94.

Signature William B. Cochran Title Land Surveyor Registration No. S-1107
(County Surveyor, Registered Land Surveyor, or other duly authorized official)

Office of Register of Deeds, County of Forest, I hereby certify that the within
instrument was filed in this office for record on the 23rd day of August, 19 96.
at 2:30 o'clock P. M.

(Register of Deeds)

By John J. Jankiewicz Deputy

- (e) Describe any material discrepancy between the location of the corner as restored or reestablished and the location of that corner as previously restored or reestablished by distance and direction. Show the discrepancy on the plan view drawing under (d), above. Show the distances between the corner as previously restored or reestablished and (1) the corner as restored or reestablished, and (2) to at least 2 of the witness monuments shown on the drawing in (d), above.

See drawing below.

- (f) Was the corner restored through acceptance of (1) an obliterated evidence location, or, (2) a found perpetuated location?

Re-established through lost corner proportionate methods.

- (g) Was the corner reestablished through lost corner proportionate methods? If so, show the method, including the directions and distances to other public land survey corners used as evidence or used for proportioning in determining the corner location?

□ Steel sign post
NORTH .75'
●
□ Steel sign post
South .75'

- (i) I, William B. Cochrane
(type or print name) certify that the corner location shown on this record was determined by me or under my direction and control and that this U.S. Public Land Survey Monument Record is correct and complete to the best of my knowledge and belief.

Signature

William B. Cochrane

Date

12/29/94

