

CERTIFIED LAND CORNER RESTORATION


Index No. V-21

State of Wisconsin }  
County of Forest } ss.

I William B. Cochrane, do hereby certify that on the 5 th day of April, 1993, I found evidence of the Northeast Section corner of Section 36 Township 39, North, Range 13 East, Fourth Principal Meridian, as described hereon; and that from this evidence I established a new monument and accessories as described hereon to perpetuate the original location of this corner.

Resident witnesses:

.....  
.....  
.....

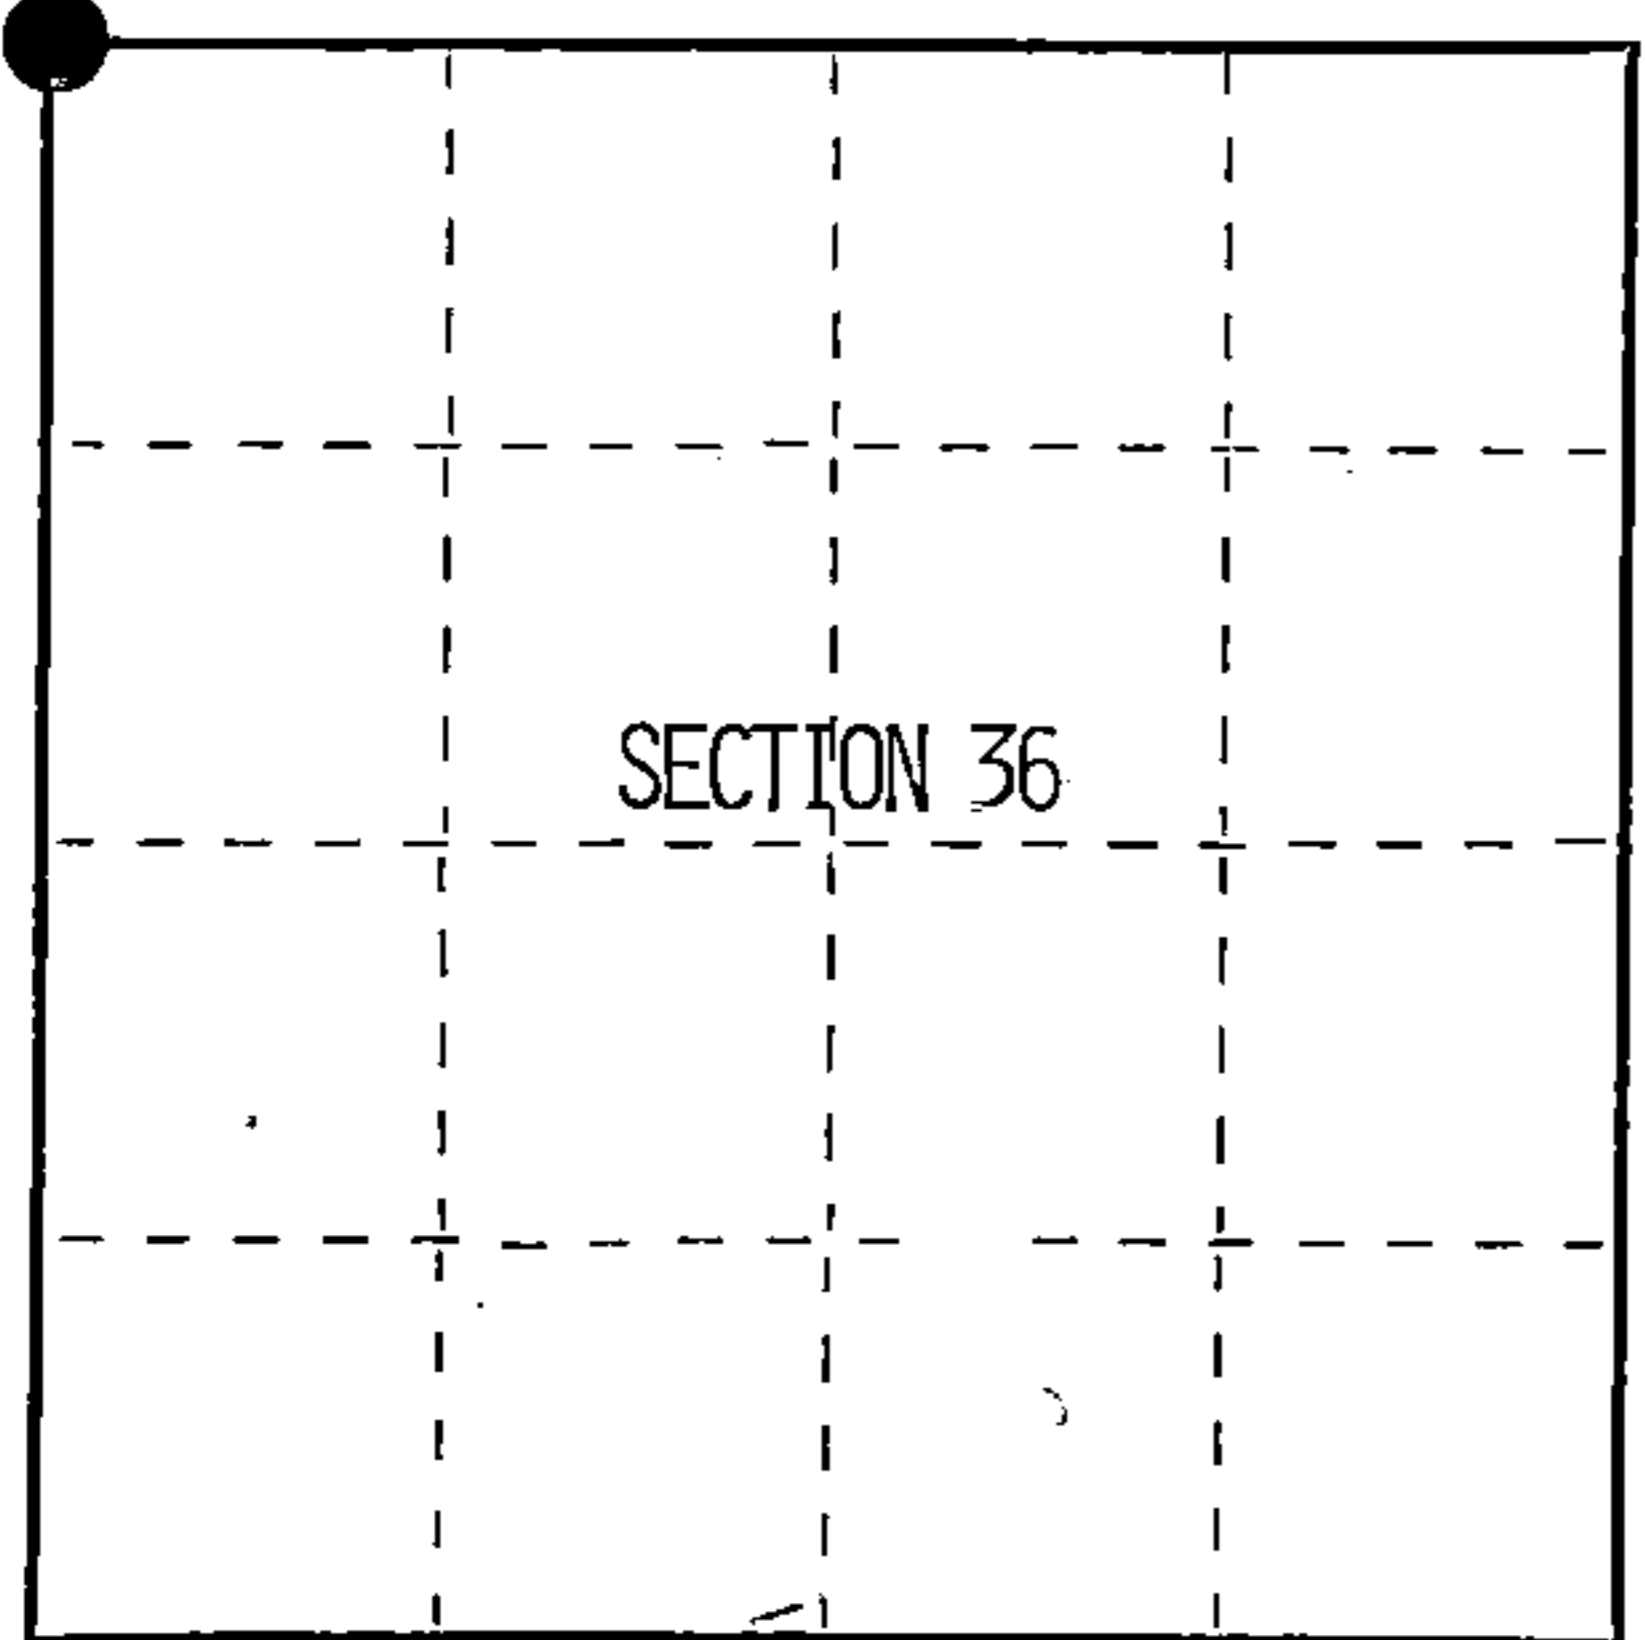

● = Corner monument restored.

History of original corner establishment:  
Original Government Survey by William E. Daugherty in 1865.  
North between sections 35 and 36, at 80 chains set post. From which:  
W. Pine 25" S76°E 18 lks  
Birch 10" N48°W 19 lks

Description of corner evidence found:

No corner evidence was found.

Description of monument and accessories I established to perpetuate the original location of this corner.

At the proportionate distance and in the center-line of State highway 55 between the Southwest section corner of section 36 and the Northwest section corner of section 25. Set a railroad spike flush with road surface. From which the following bear:

Aspen	8"	N46°E	60.43 feet
R. Pine	9"	S74°E	70.39 feet
R. Pine	10"	S74°W	53.48 feet
R. Pine	10"	N70°W	53.61 feet

Aluminum pipe reference monument 2 1/2" X 36" 2 1/2 feet in the ground with an aluminum cap stamped: T39N, R13E, S25, S26, S35, S36, 1993, 33.00ft. S-1107.

Dated at Hiles, Wis., this 29 th day of December, 1994

Signature William B. Cochrane Title Land Surveyor Registration No. S-1107  
(County Surveyor, Registered Land Surveyor, or other duly authorized official)

Office of Register of Deeds, County of Forest, I hereby certify that the within instrument was filed in this office for record on the 23rd day of August, 1994 at 2:30 o'clock P M.

.....  
(Register of Deeds)  
By Paul Zukiewicz Deputy

FORM NO. 985-A  
H.C. Miller Company

Stock No. 26273  
156590

43913260000


(e) Describe any material discrepancy between the location of the corner as restored or reestablished and the location of that corner as previously restored or reestablished by distance and direction. Show the discrepancy on the plan view drawing under (d), above. Show the distances between the corner as previously restored or reestablished and (1) the corner as restored or reestablished, and (2) to at least 2 of the witness monuments shown on the drawing in (d), above.

See drawing below.

(f) Was the corner restored through acceptance of (1) an obliterated evidence location, or, (2) a found perpetuated location?


Re-established through lost corner proportionate methods.

(g&h) Was the corner reestablished through lost corner proportionate methods? If so, show the method, including the directions and distances to other public land survey corners used as evidence or used for proportioning in determining the corner location?

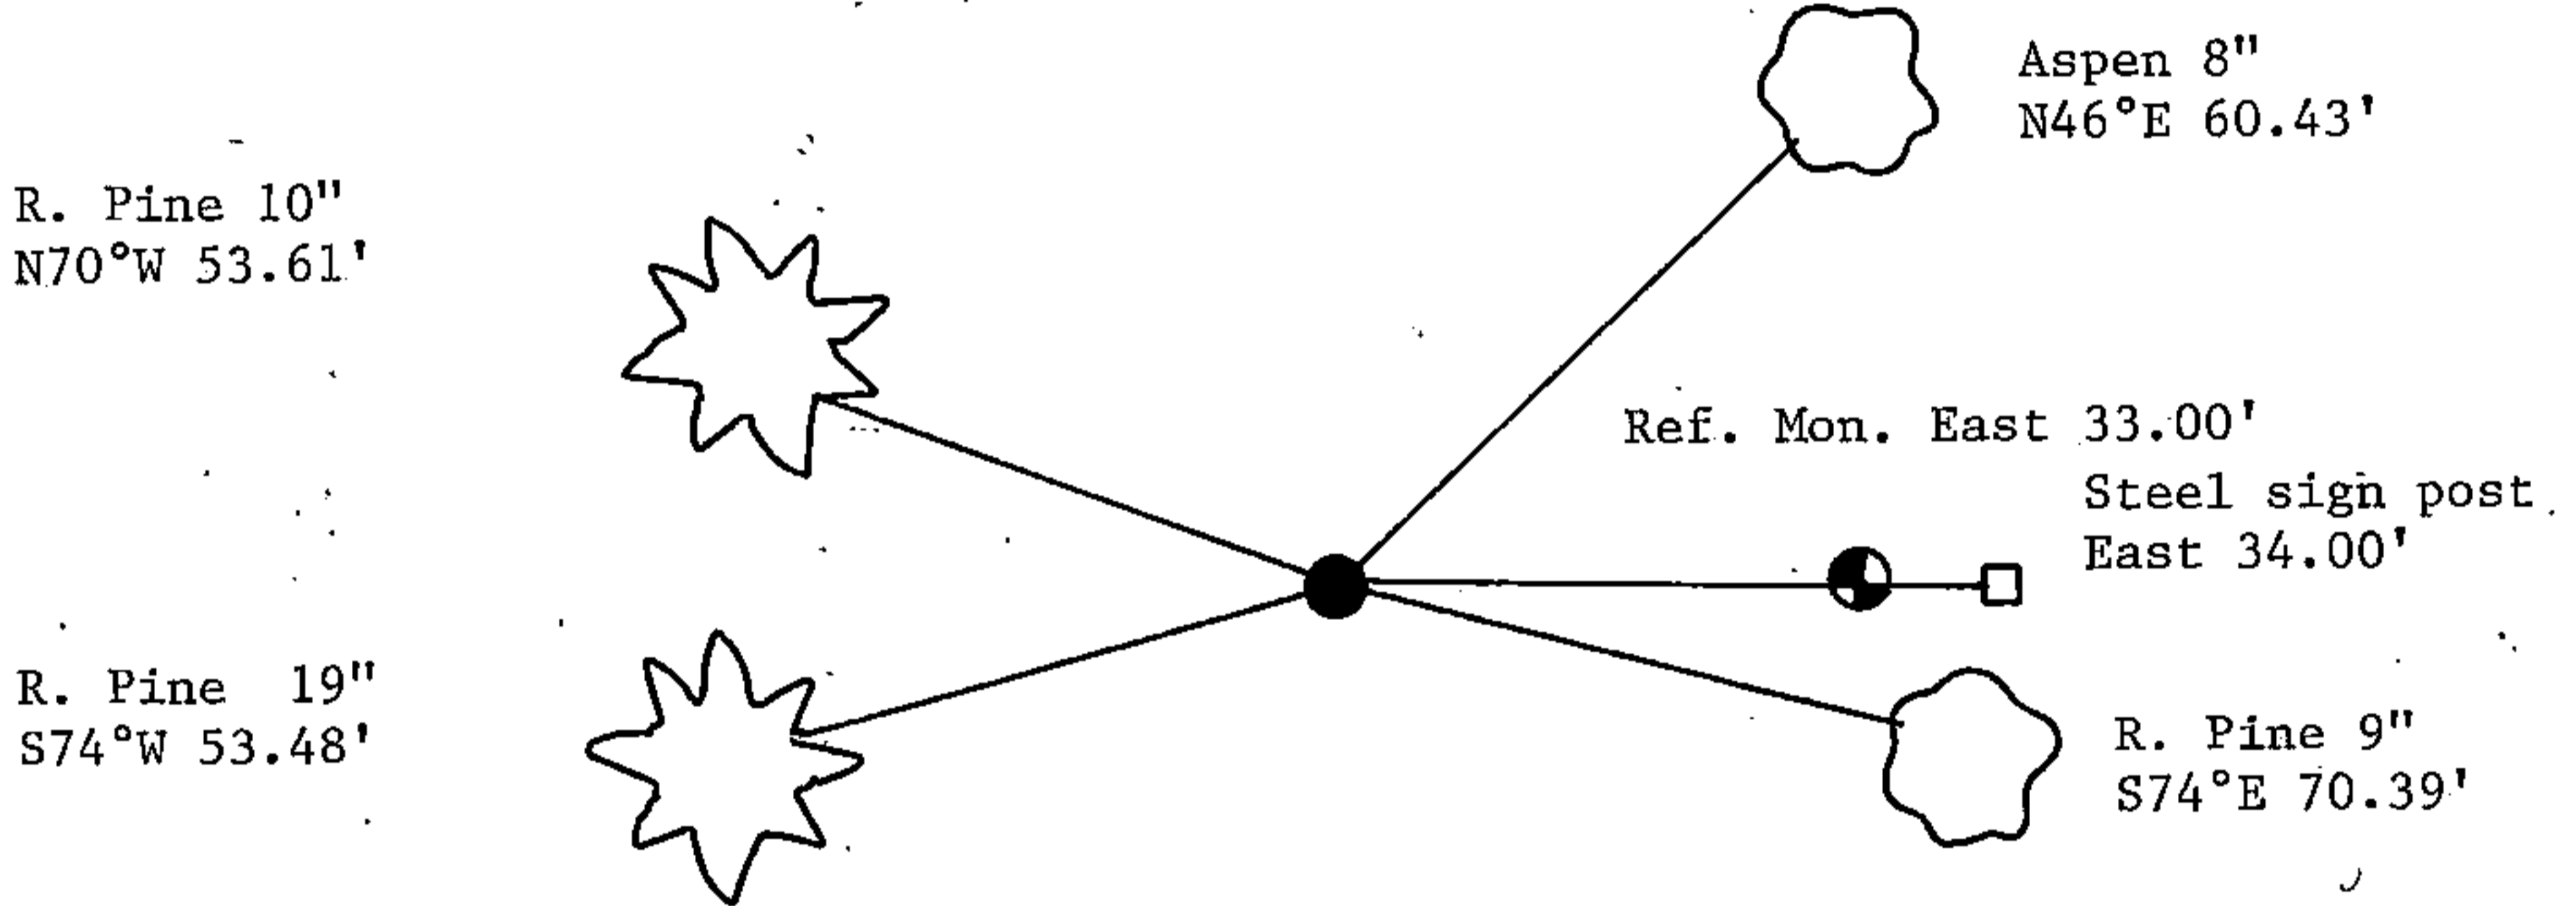

William B. Cochrane

(i) I, William B. Cochrane (type or print name) certify that the corner location shown on this record was determined by me or under my direction and control and that this U.S. Public Land Survey Monument Record is correct and complete to the best of my knowledge and belief.

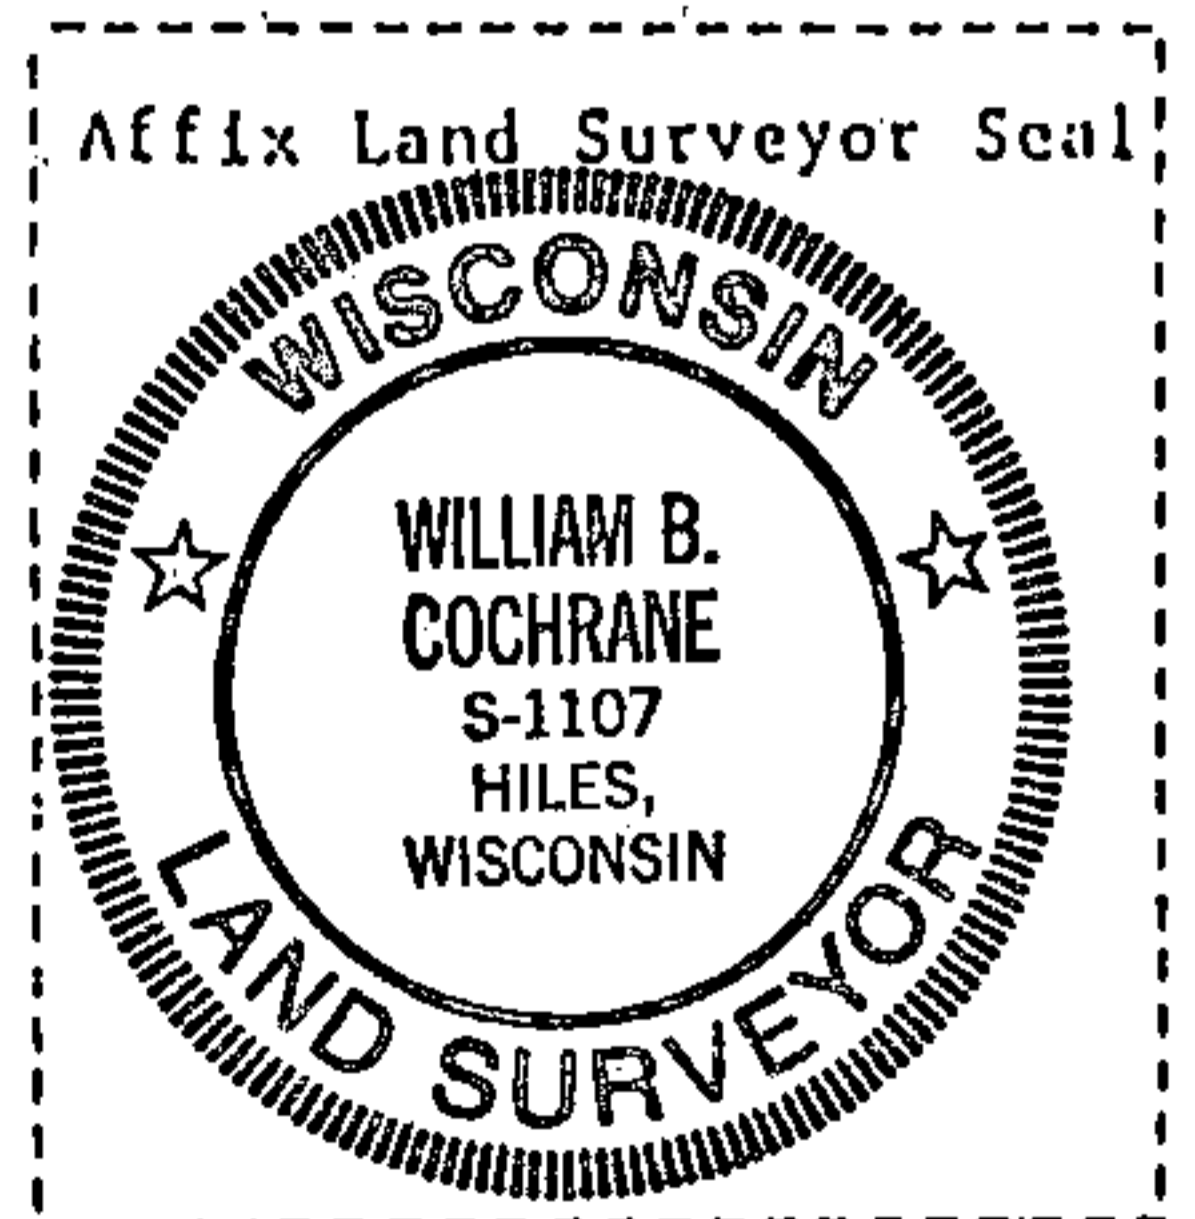

William B. Cochrane  
Signature

12/29/94  
Date