

CERTIFIED LAND CORNER RESTORATION

Index No. V-15

State of Wisconsin }  
County of Forest } ss.

I William B. Cochrane, do hereby certify that on the 31 st day of May, 1994, I found evidence of the North Quarter corner of Section 34 Township 39, North, Range 13 East, Fourth Principal Meridian, as described hereon; and that from this evidence I established a new monument and accessories as described hereon to perpetuate the original location of this corner.

Resident witnesses:

.....  
.....  
.....


History of original corner establishment:  
Original Government Survey by William E. Daugherty in 1865.  
West corrected between section 27 and 34 at 39.93 chains set post from which:  
Tamarack 7" N10°E 36 lks  
Spruce 8" S73°W 23 lks  
44.56 chains creek 7 lks runs north.

Description of corner evidence found:

No original corner evidence found. No other corner evidence found.

Re-establish through lost corner proportionate methods.

Description of monument and accessories I established to perpetuate the original location of this corner.  
At the proportionate position set a 2½"X60" aluminum pipe monument 4 feet in the ground with an aluminum cap stamped: T39N, R13E, 1/4, S27, S34, 1994, S-1107.  
From which the following bear:  
Cedar 10" S71°E 11.70 feet  
B. Ash 8" S27°W 17.12 feet  
Steel sign post South 1.00 feet

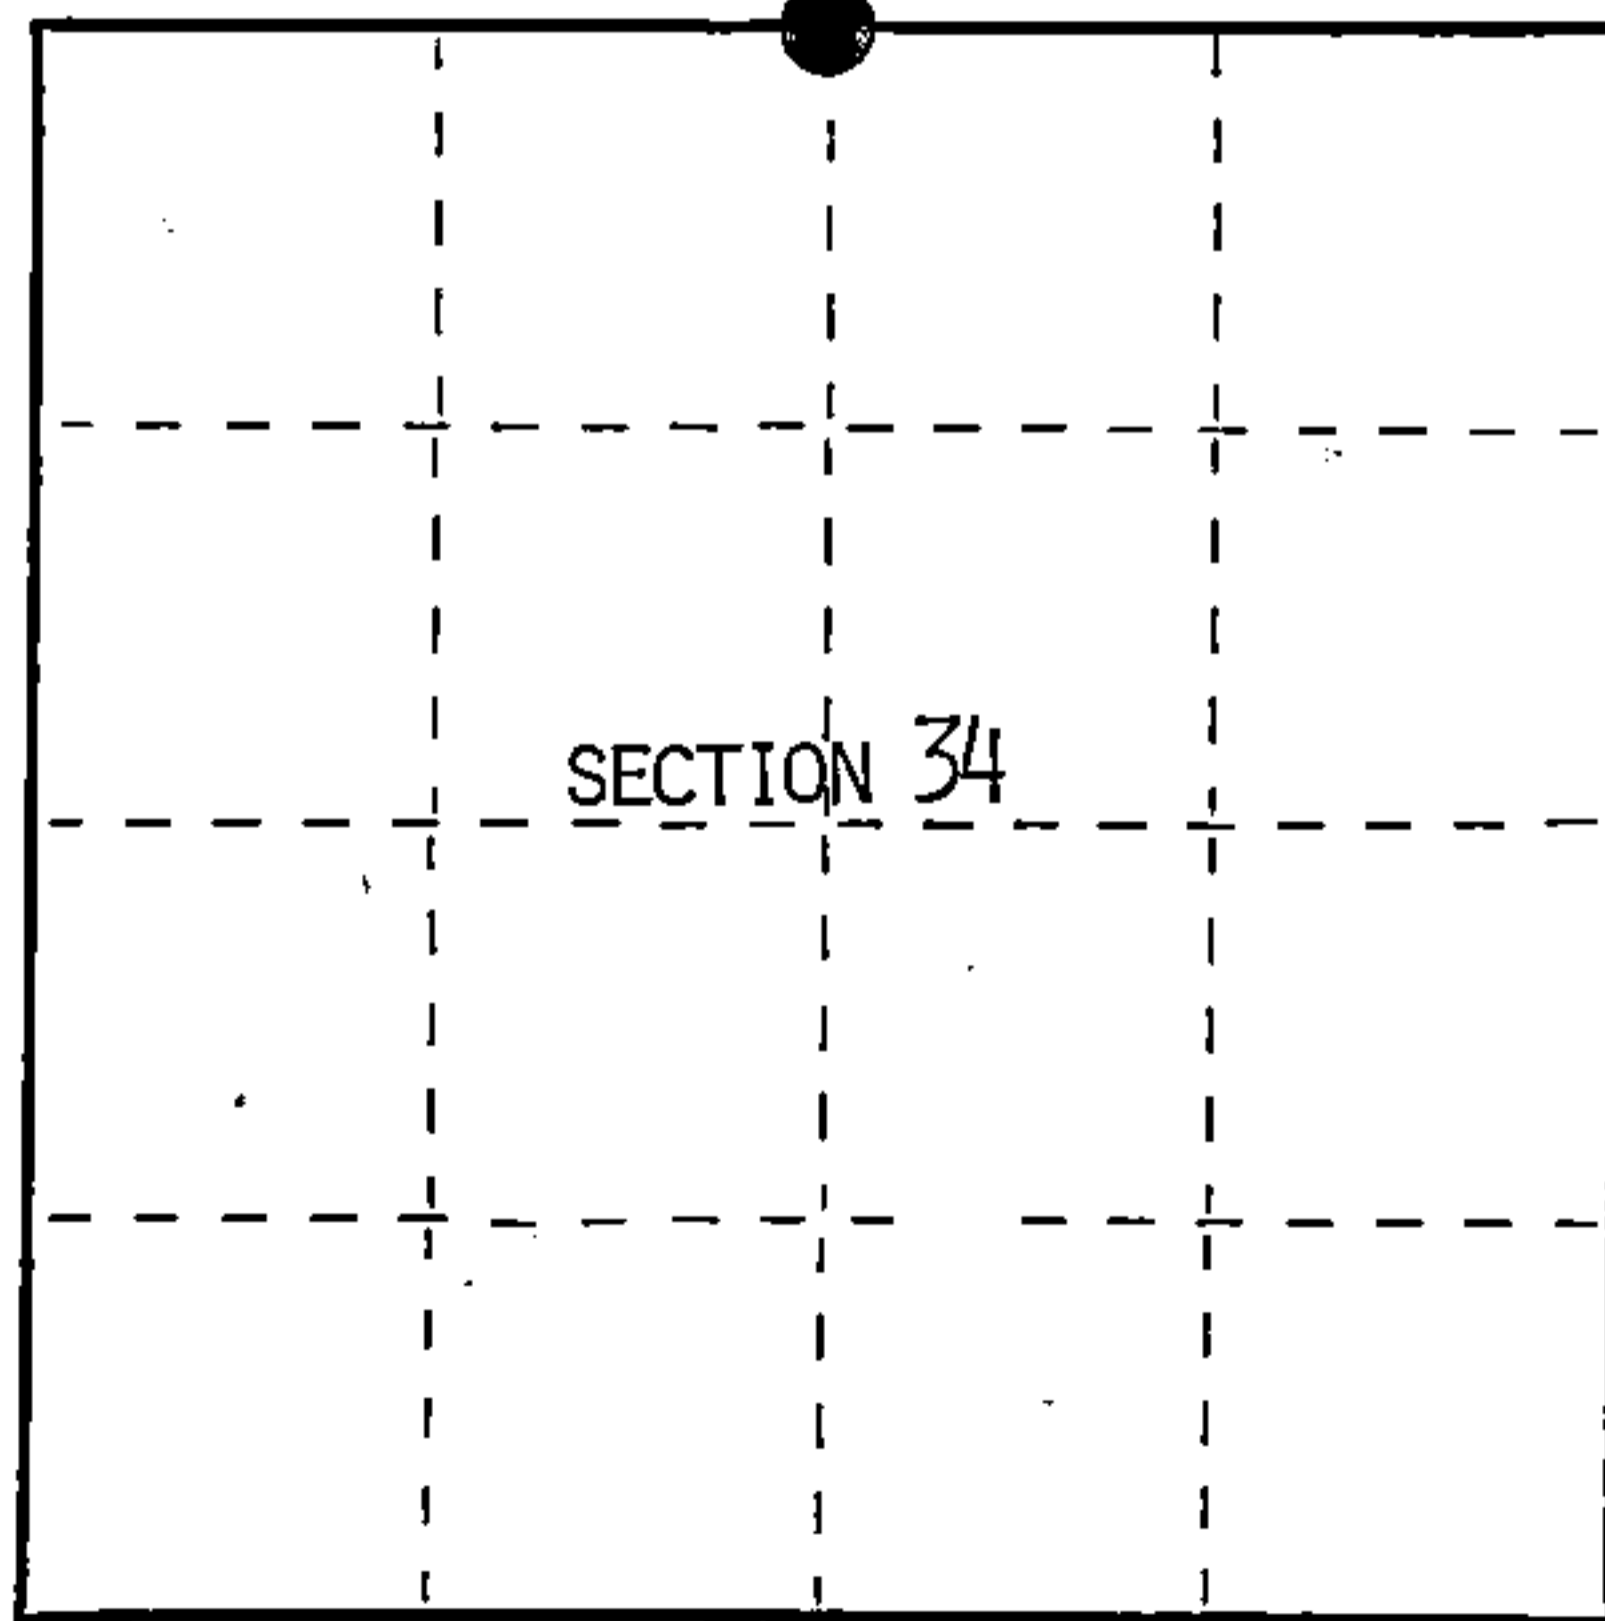

● = Corner monument restored.

Dated at Hiles, Wis., this 21 st day of December, 1994

Signature William B. Cochrane Title Land Surveyor Registration No. S-1107  
(County Surveyor, Registered Land Surveyor, or other duly authorized official)

Office of Register of Deeds, County of Forest, I hereby certify that the within instrument was filed in this office for record on the 23rd day of August, 1994 at 2:30 o'clock P M.

.....  
(Register of Deeds)  
By Paul Jankiewicz Deputy

FORM NO. 985-A



Stock No. 26273

156587

H3913270020

