

CERTIFIED LAND CORNER RESTORATION

Index No. T-17

State of Wisconsin }  
County of Forest } ss.

History of original corner establishment:  
Original Government Survey by William E. Daugherty in 1865.

I, William B. Cochrane, do hereby certify that on the 12th day of March, 1994, I found evidence of the East Quarter corner of Section 27 Township 39 North, Range 13 East, Fourth Principal Meridian, as described hereon; and that from this evidence I established a new monument and accessories as described hereon to perpetuate the original location of this corner.

In 1937 a metal tag was placed on a 18" cedar. Corner bears Northeast 2 1/2 feet. 874 slip states that the corner was reestablished at that time.

Description of corner evidence found:

Found no original corner evidence. at the proportionate position found down large cedar with metal tag, cannot tell exactly where it once stood.


Resident witnesses:

.....  
.....  
.....

Description of monument and accessories I established to perpetuate the original location of this corner.

At the proportionate position set a 2 1/2" X 36" aluminum pipe monument 2 1/2 feet in the ground with an aluminum cap stamped: T39N, R13E, 1/4, S26, S27, 1994, S-1107. From which the following bear:

Maple	7"	S63°E	33.18 feet
Maple	9"	S16°W	8.53 feet
Steel sign post		South	1.00 feet

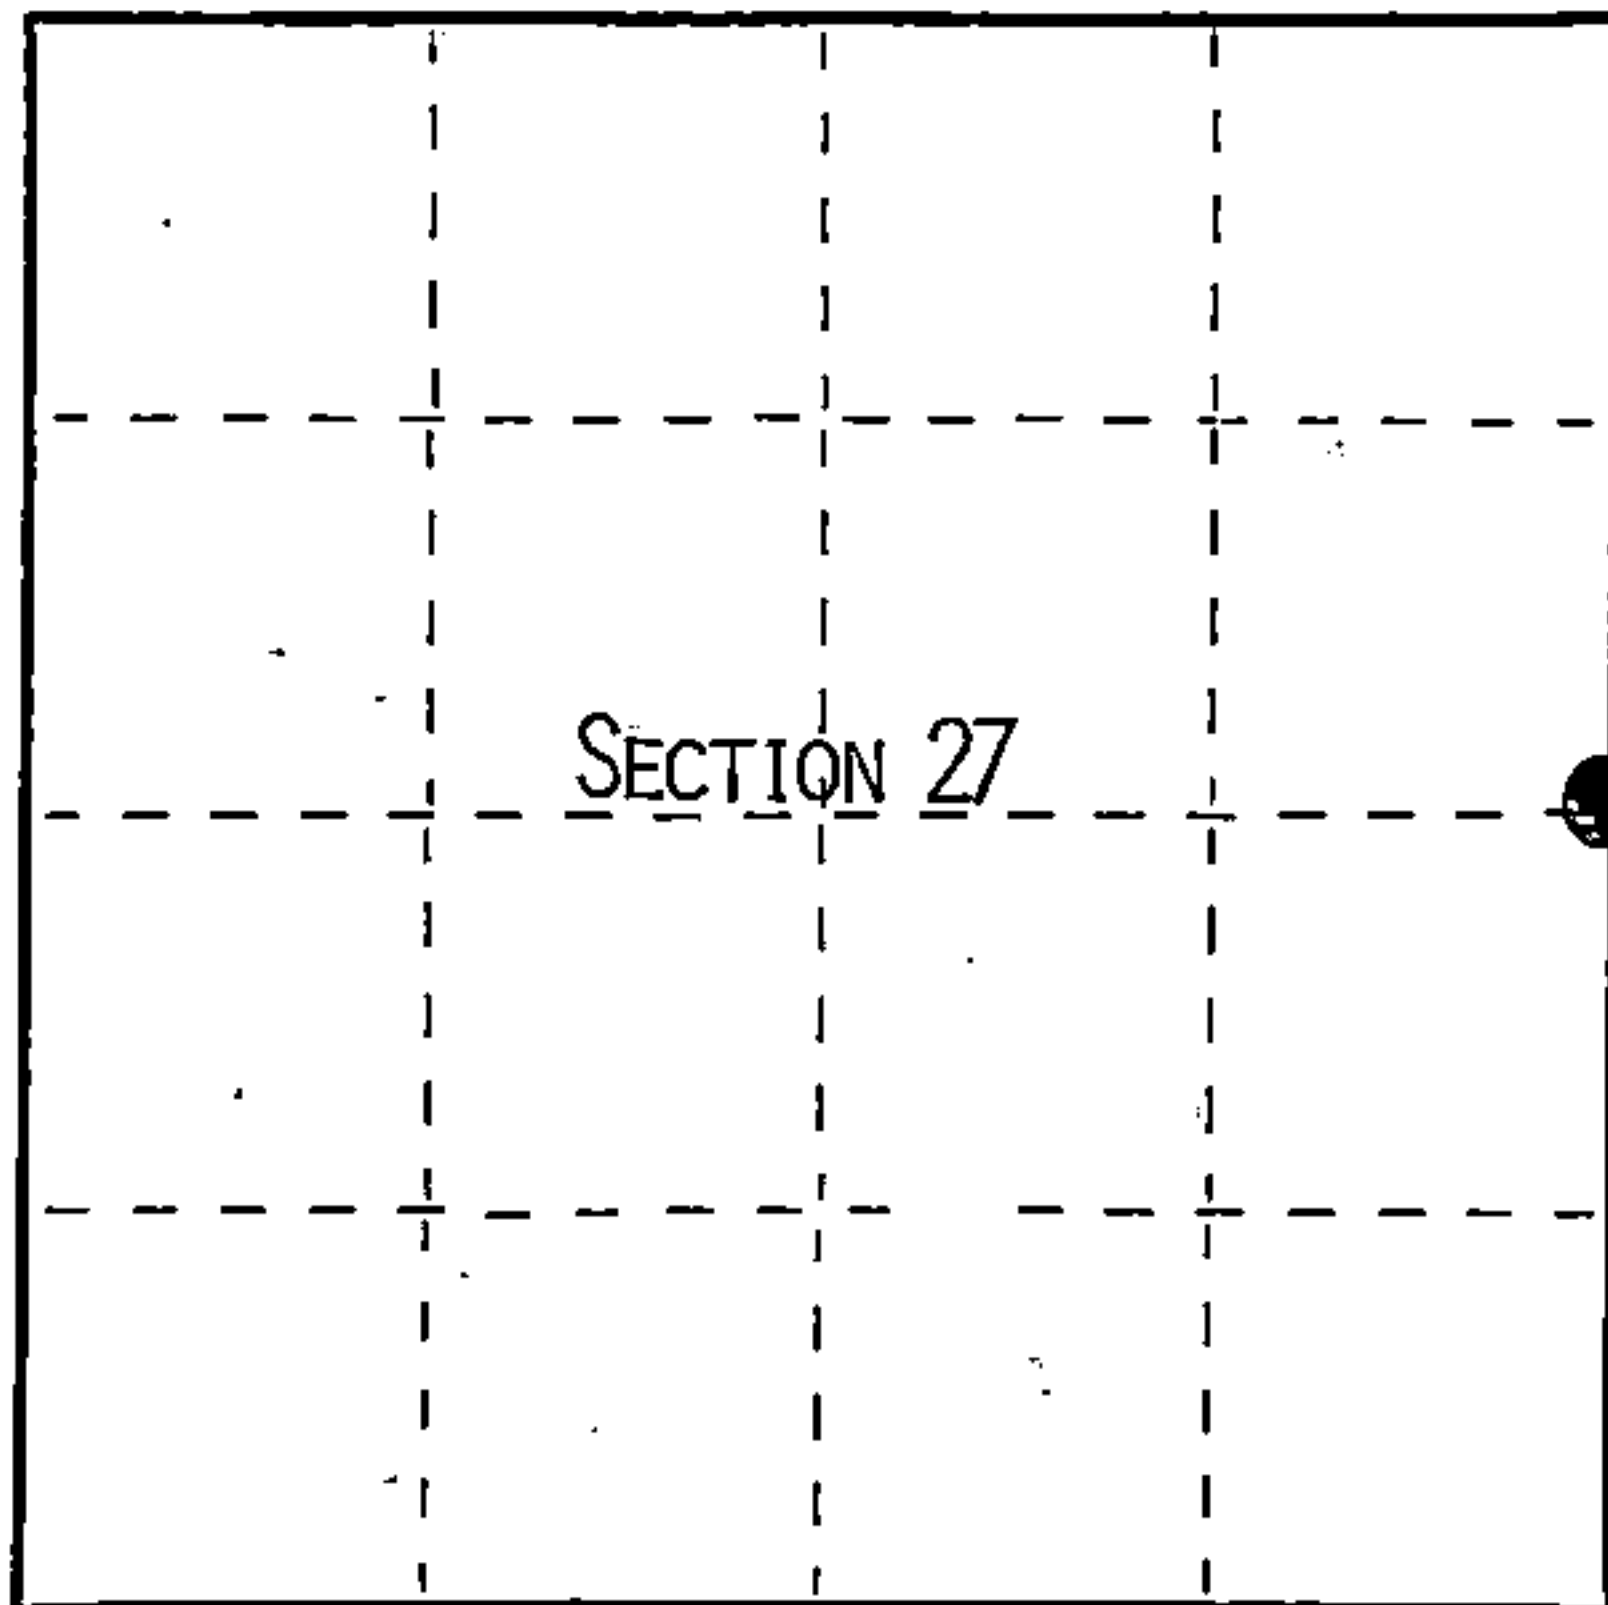

● = Corner monument restored.

Dated at Hiles, Wis., this 20th day of December, 1994

Signature: William B. Cochrane Title: Land Surveyor Registration No. S-1107  
(County Surveyor, Registered Land Surveyor, or other duly authorized official)

Office of Register of Deeds, County of Forest, I hereby certify that the within instrument was filed in this office for record on the 23rd day of August, 1996 at 2:30 o'clock P.M.

.....  
(Register of Deeds)  
By: [Signature] Deputy

FORM NO. 985-A  
H.C. Miller

Stock No. 26273

156582

43913272000

