

CERTIFIED LAND CORNER RESTORATION

State of Wisconsin }
County of Forest } ss.

DOCUMENT NUMBER 99450

I, Jean F. Resvick, do hereby certify that on the 19th day of October, 1970, I found evidence of the Southwest Section corner of Section 1 Township 39 North, Range 14 East, Fourth Principal Meridian, as described hereon; and that from this evidence I established a new monument and accessories as described hereon to perpetuate the original location of this corner:

Description of original monument and accessories and subsequent restorations:


Surveyed in 1865 by Wm. E. Daugherty and Alex McDill
80 chains North between Sections 11 and 12
Set post
Cedar 10", N33W, 6 lks.
Cedar 8", S21E, 10 lks.

Description of corner evidence found:

Found; 1 1/2 inch iron pipe, 2 feet above ground
Cedar with old blaze and ax marks N33W, 4 feet
Cedar has fallen and is rotted
Piece of squared cedar post found lying by the iron pipe

Description of monument and accessories I established to perpetuate the original location of this corner:


Replaced 1 1/2 inch iron pipe with a 2 inch inside diameter iron pipe 5 feet long, filled with concrete, flanged on the bottom. With a brass cap stamped.

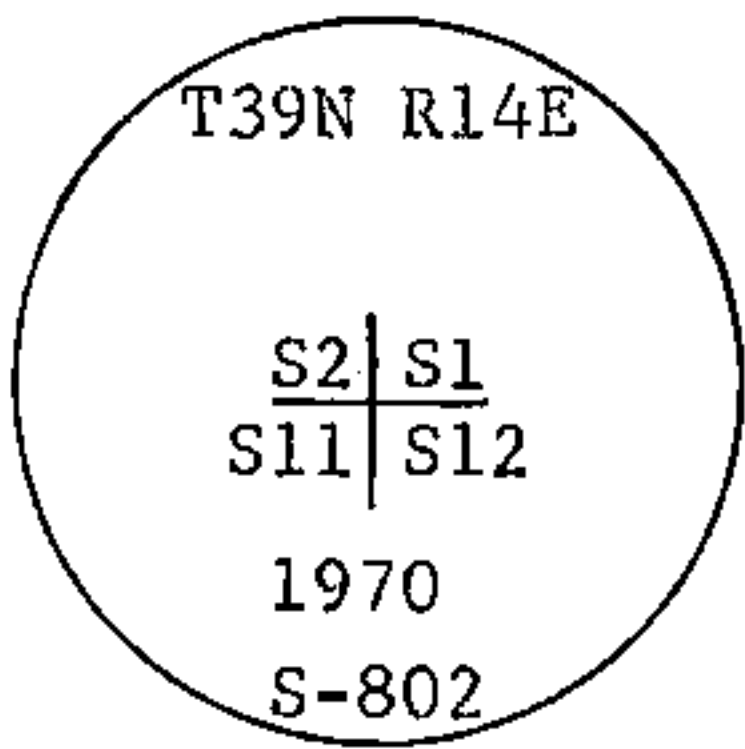

From which the following blazed and scribed new bearing trees bear:
Sugar Maple 12", N11E, 26.81 feet
Sugar Maple 14", S79E, 13.75 feet
Sugar Maple 9", S15W, 33.85 feet
Sugar Maple 11", N67W, 23.17 feet
Steel sign post set 1 foot, NW of monument
1 1/2 inch iron pipe which is 4 1/2 feet long was set on east side of the monument.



43914020000

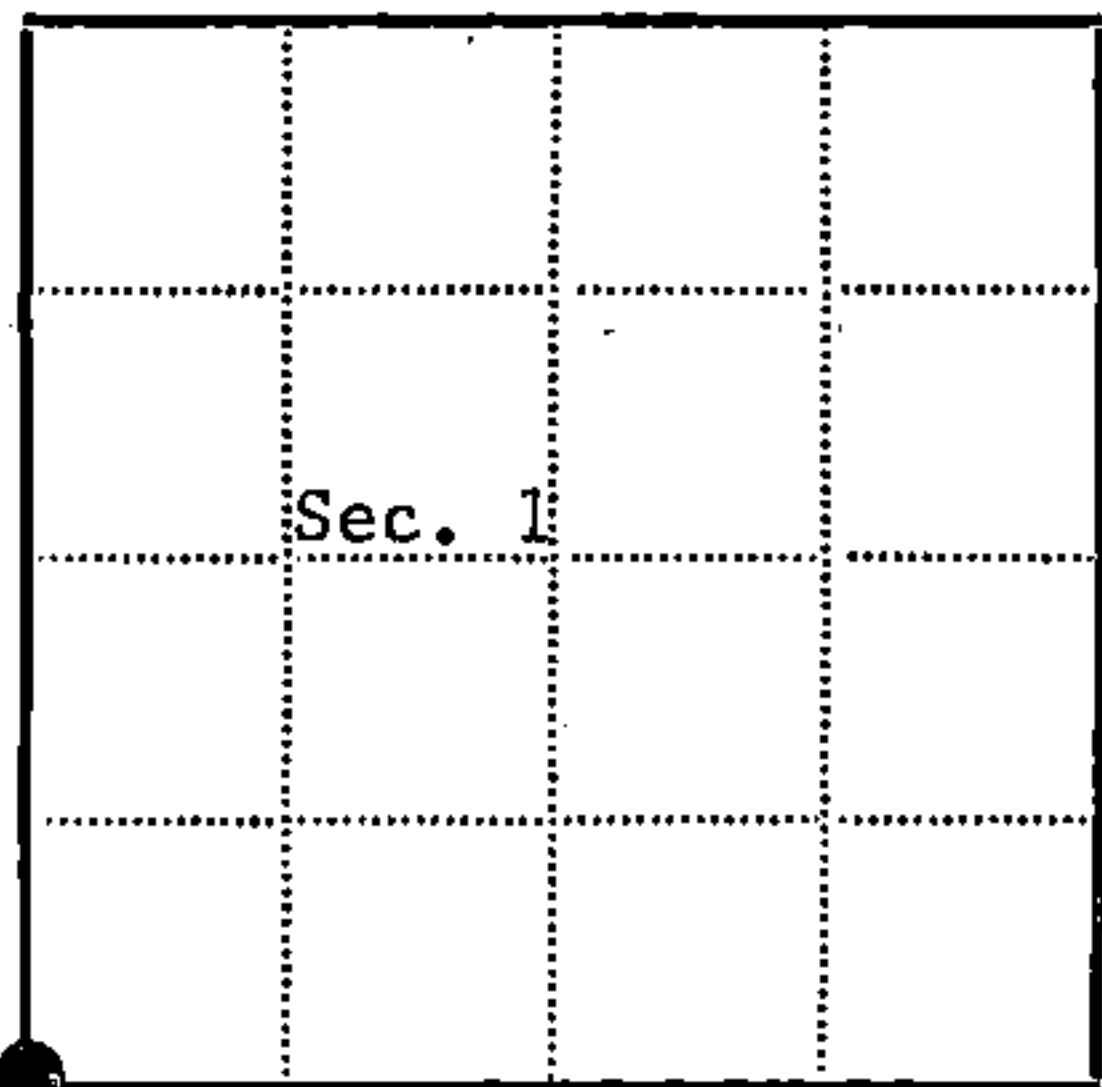

● = Corner monument restored
□ =

Resident witnesses.....

Dated at Rhinelander Wisconsin, this 2nd day of October, 1970.

Signature Jean F. Resvick Title Cadastral Surveyor
(County Surveyor, Registered Land Surveyor, or other duly authorized official)

Surveyors Registration No. S-802

Office of Register of Deeds County of Forest

I hereby certify that the within instrument was filed in this office for record on the 16th day of March, 1971, and was filed in Book No. 1 Page No. E-21 of County Records.

Signature Eugene Stutzman Title Register of Deeds

Township 39 North, Range 14 East, Section 1, Index No. E-21, Page No.

E 21