

U.S. PUBLIC LAND SURVEY MONUMENT RECORD

Index No. J-17


State of Wisconsin }
County of Forest } ss.

I, William B. Cochran, do hereby certify that on the 20th day of August, 1985, I found evidence of the Northwest Section corner of Section 14 Township 39 North, Range 14 East, Fourth Principal Meridian, as described hereon; and that from this evidence I established a new monument and accessories as described hereon to perpetuate the original location of this corner.

Resident witnesses:

Tony Tillman

State Plane Co-ordinates
N- 258,244.6358
E-2,327,007.3750

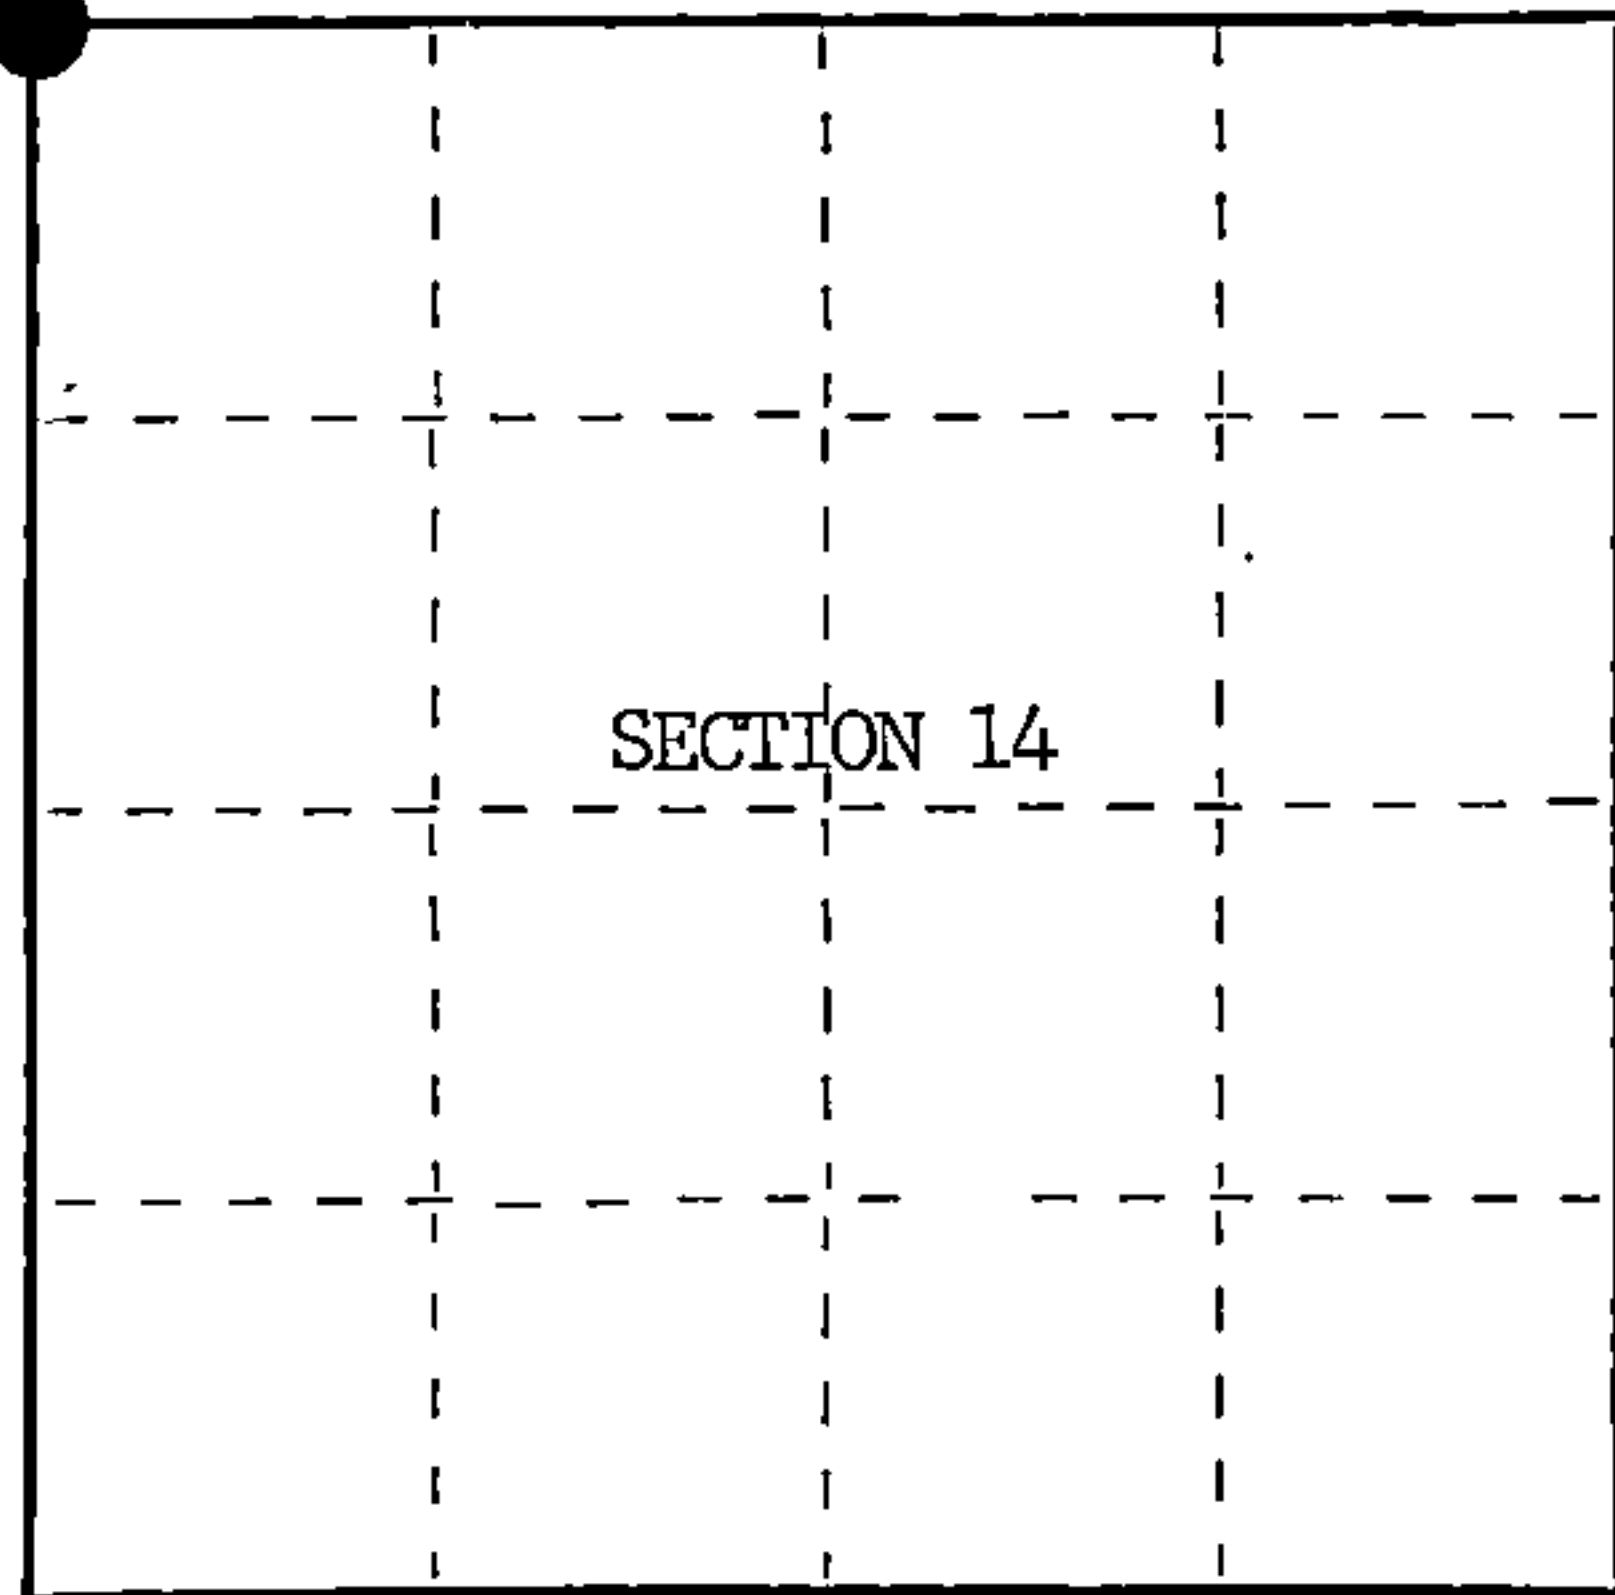

○ = Corner monument restored.

History of original corner establishment:

Original Government Survey in 1865 by William E. Daugherty and Alex McDill. North between Sections 14 and 15, 80.00 chains, set Section Corner Post to Sections 10, 11, 14, and 15, from which the following bear; Hemlock, 10", N31°W, 26 lks., Tamarac, 8", S66°E, 10 lks. In 1928, Melindy, a Local Surveyor, subdivided Section 14. At the corner position he found an Original Hemlock, N31°W, 26 lks. From bearing tree evidence, set a 5"x5" Cedar Post, from which the following bear;

Maple	12"	N57°45'W	50½ lks.	Elm	20"	S24°W	45½lks.
Hemlock	25"	N22°30"E	79 lks.	Birch	18"	S22°E	24½lks.

Description of corner evidence found:

Found 2 inch diameter iron pipe alongside remains of a 6"x6" Wood Post.

I accept the iron pipe and wood post as the best available evidence for restoring the corner position.

No original corner evidence was recovered.

Description of monument and accessories I established to perpetuate the original location of this corner.

In place of iron pipe, set a 2½ inch diameter aluminum pipe monument, 3 feet long, 2½ feet in the ground, with an aluminum cap stamped; T39N, R14E, S10, S11, S14, S15, 1985, S-1107. From which the following bear;

Maple	7"	S86°E	24.26 feet
Maple	5"	S 4°E	8.46 feet
Ironwood	5"	S45°W	16.20 feet
Maple	6"	N40°W	12.47 feet
Steel Sign Post		NW	0.50 feet

Dated at Hiles, Wis., this 18th day of March, 1986

Signature *William B. Cochran* Title Land Surveyor Registration No. S-1107
(County Surveyor, Registered Land Surveyor, or other duly authorized official)

Office of Register of Deeds, County of Forest, I hereby certify that the within instrument was filed in this office for record on the 11th day of March, 1987 at 3:30 o'clock P. M.

Paul Aschenbrenner
(Register of Deeds)

By _____ Deputy

DOCUMENT NUMBER 132349

Stock No. 26273

FORM NO. 985-A
H.C. Miller Company

43914 1000000

